

38'
DESIGNS

The Super
3 Car Tandem
2 Car Garage

GAS LINE FOR
STOVE
ROUGH-IN FOR POT
FILLER

/ Elev. A & B
sq. ft. - includes 530 sq. ft. of finish
area in lower level
q. ft. - includes 748 sq. ft. of finished area in lower level

Provide 8ft wide patio
doors - standard height

rotate the island






add double door entry

add shower seat


provide for wall mount
tv - Cat5, Electrical and
Conduit

Provide room with
storage closet

Relocate std. bathroom
here
size is 5x10
any additional space
between furnace room
and bathroom to into
the furnace room area

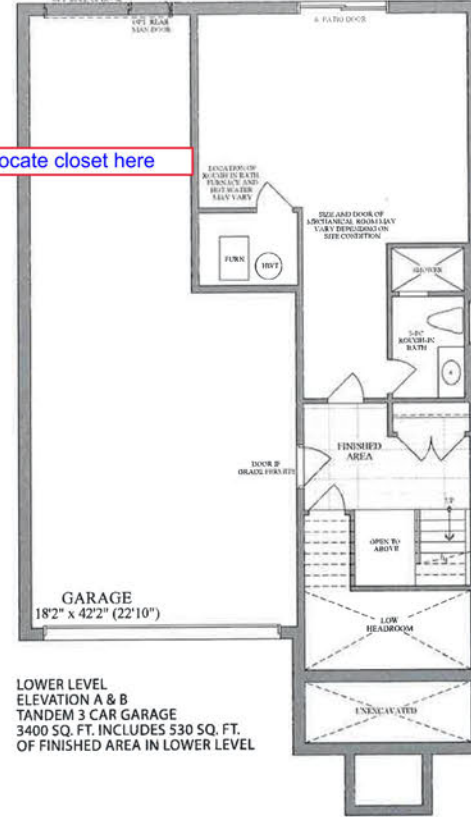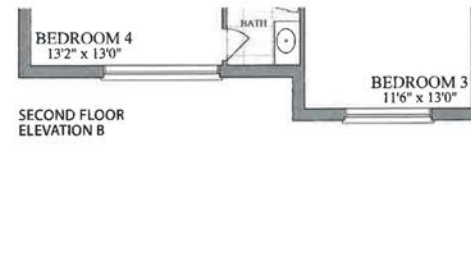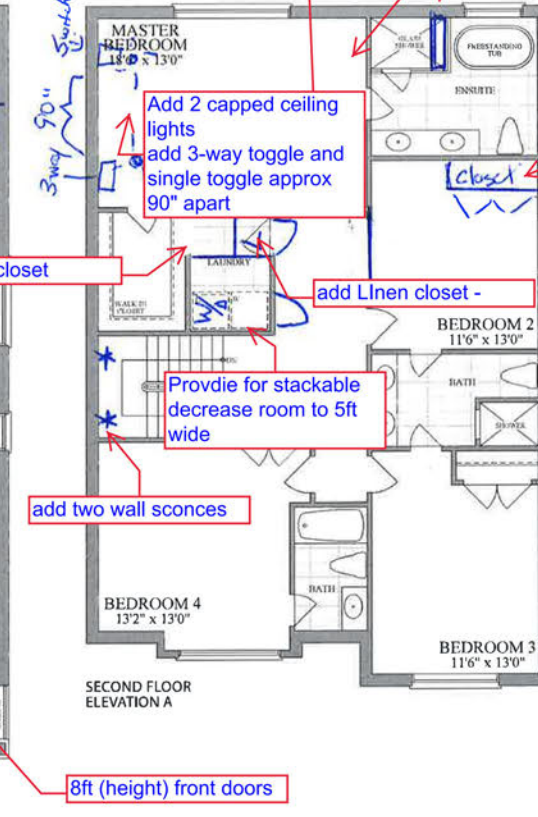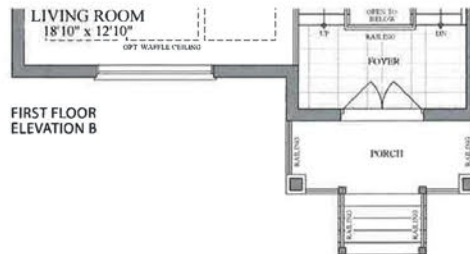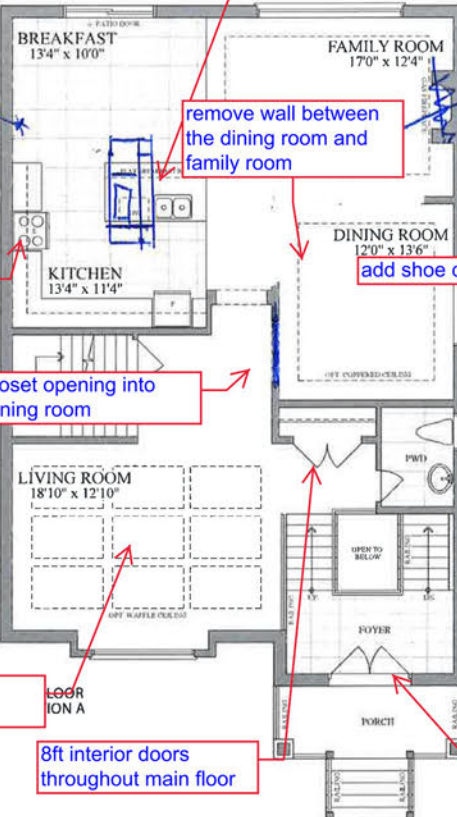

LOWER LEVEL
ELEVATION A & B
TANDEM 3 CAR GARAGE
3400 SQ. FT. INCLUDES 530 SQ. FT.
OF FINISHED AREA IN LOWER LEVEL

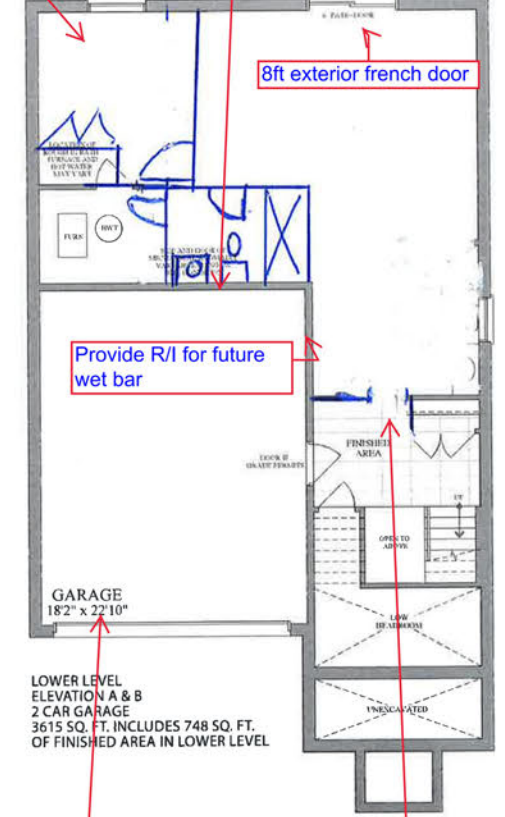

LOWER LEVEL
ELEVATION A & B
2 CAR GARAGE
3615 SQ. FT. INCLUDES 748 SQ. FT.
OF FINISHED AREA IN LOWER LEVEL



Plans and specifications are subject to change without notice. E. & O. E. Actual usable floor space may vary from the stated floor area. All renderings are artist's concept.

LOT 5-14, PH5, PE002, SKETCH

Purchaser: Charles Yenkan (Jul 14, 2022 13:48 EDT)

Purchaser: Candace Yenkan (Jul 11, 2022 09:28 EDT)