


LOT 5-14, PH5, REVISED MAIN FLOOR

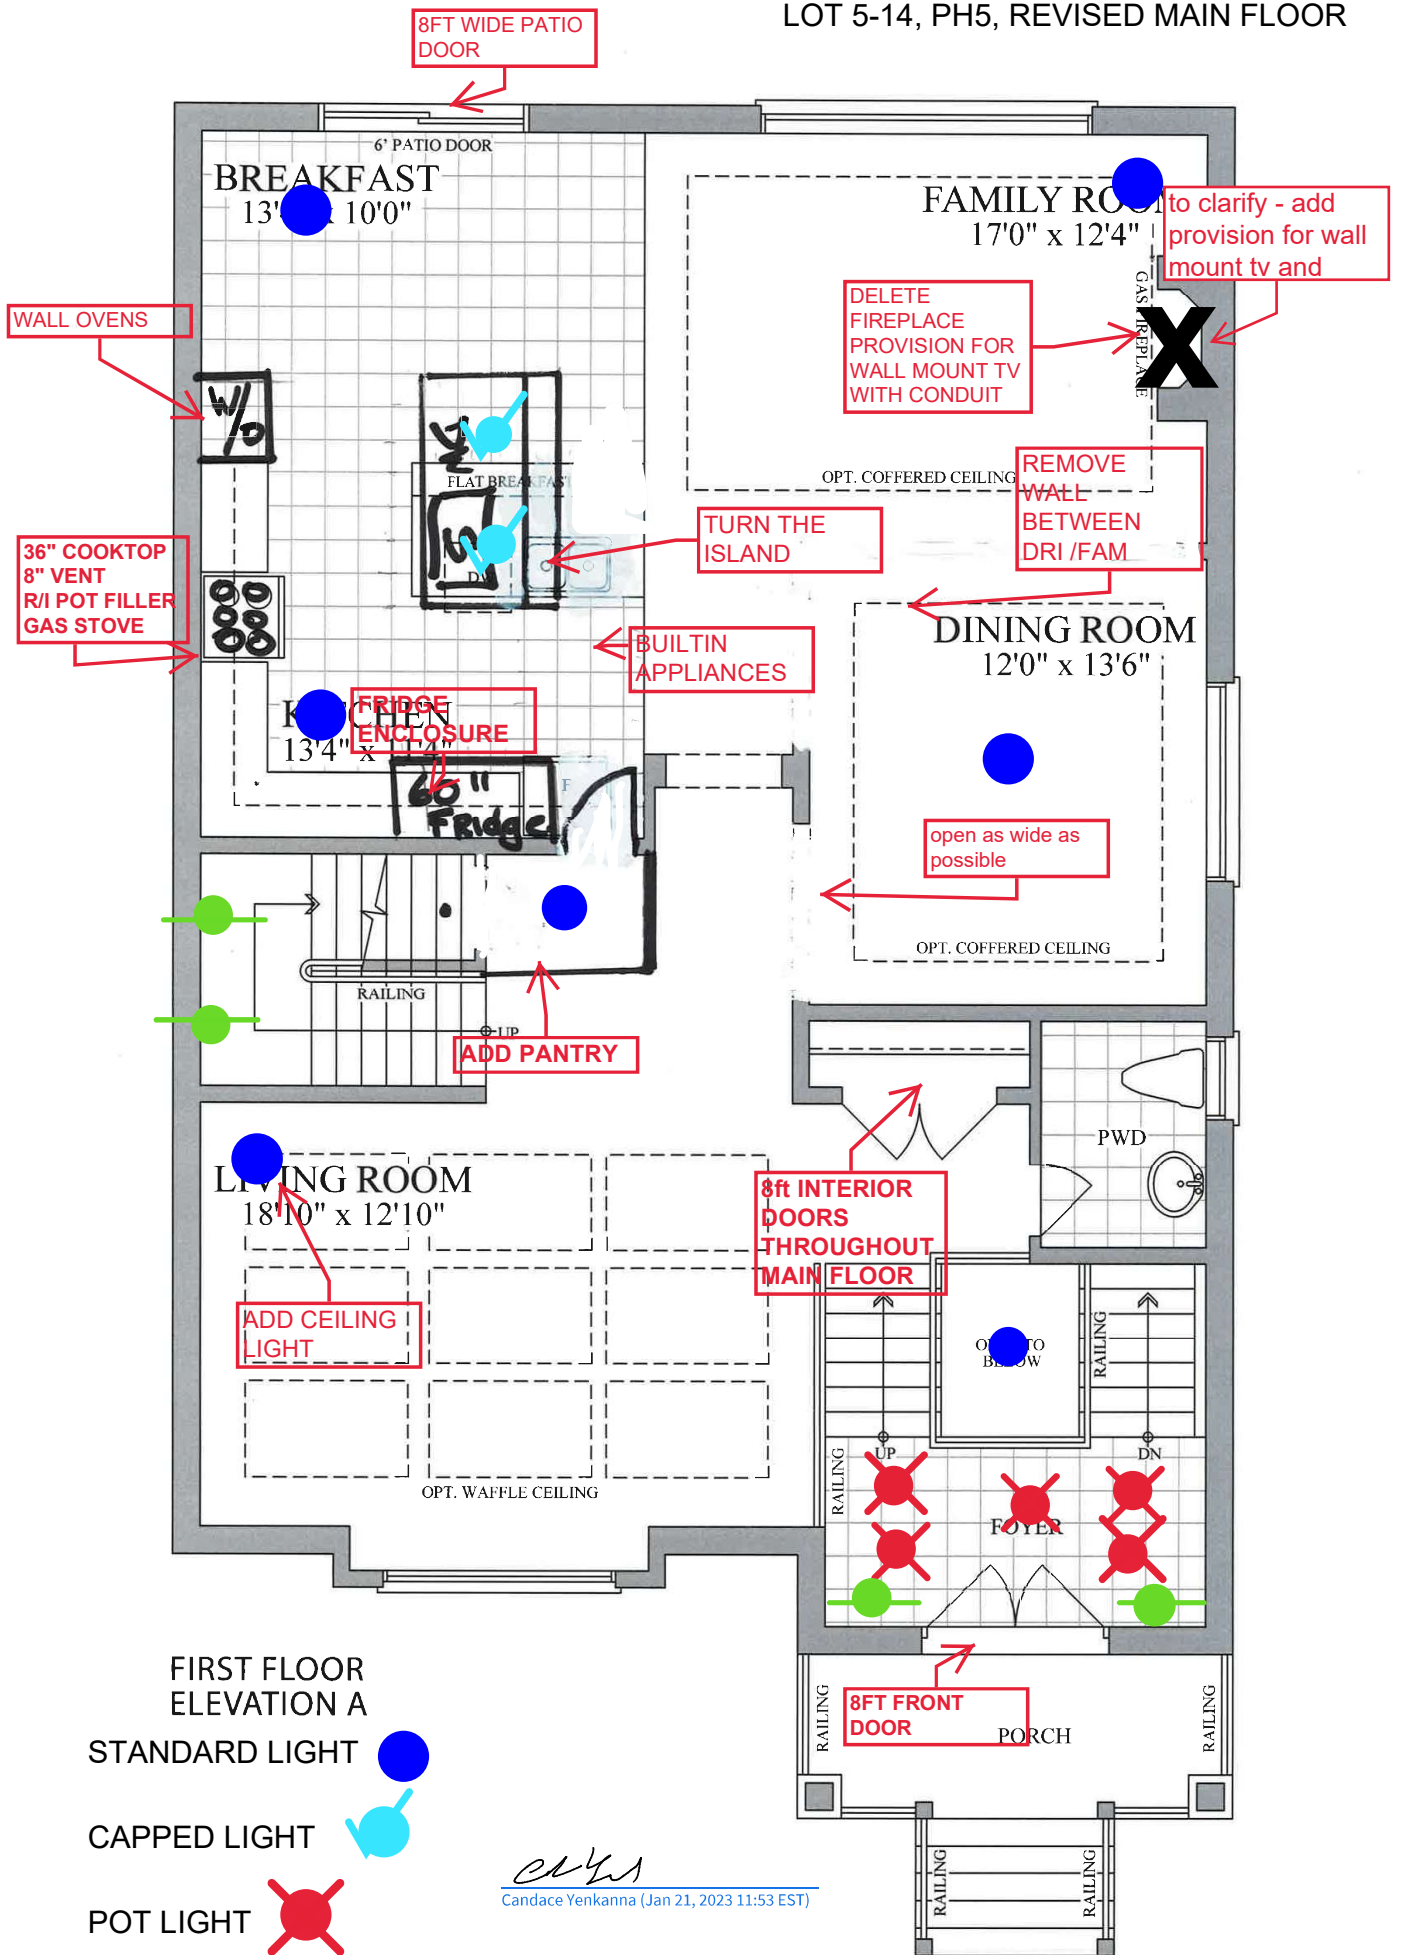

FIRST FLOOR
ELEVATION A

STANDARD LIGHT

CAPPED LIGHT


POT LIGHT

WALL SCNCE

Charles Yenkan
Candace Yenkan (Jan 21, 2023 11:53 EST)

Charles Yenkan
charles.yenkan (Jan 21, 2023 02:12 EST)

LOT 5-14, PH5, REVISED 2ND FLOOR

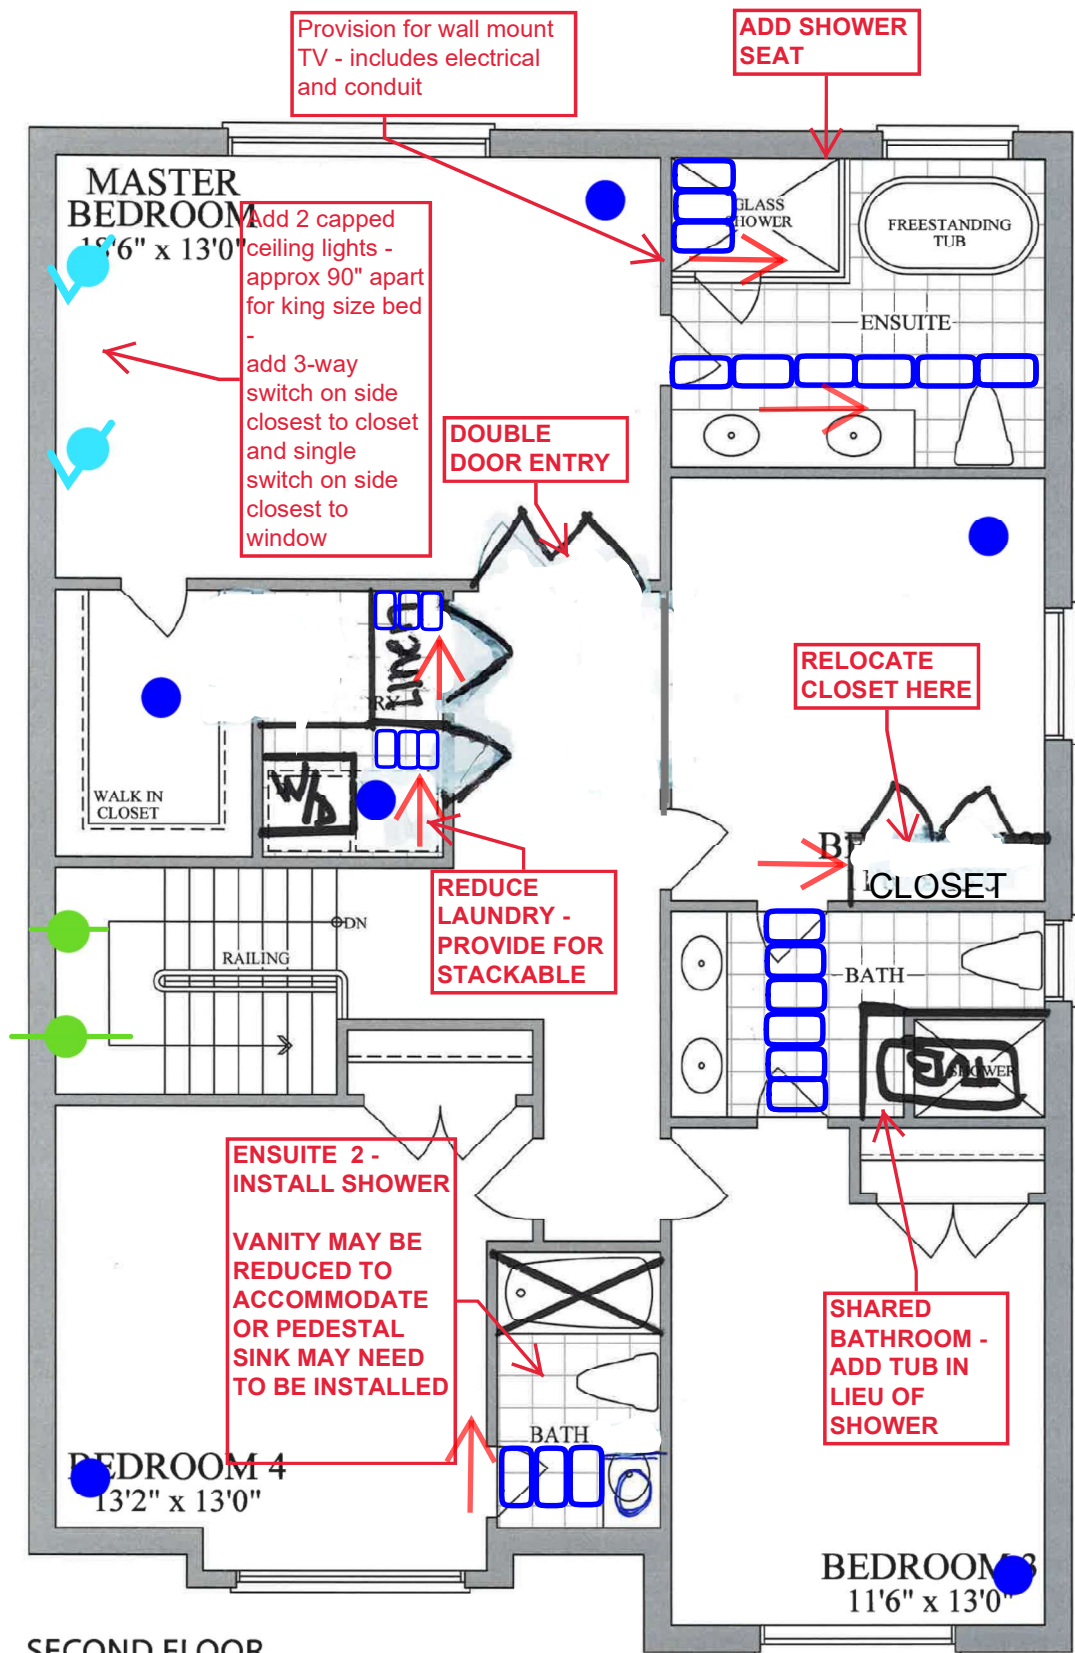


SECOND FLOOR
ELEVATION A

STANDARD LIGHT

WALL SCONSE

CAPPED LIGHT

POTLIGHT

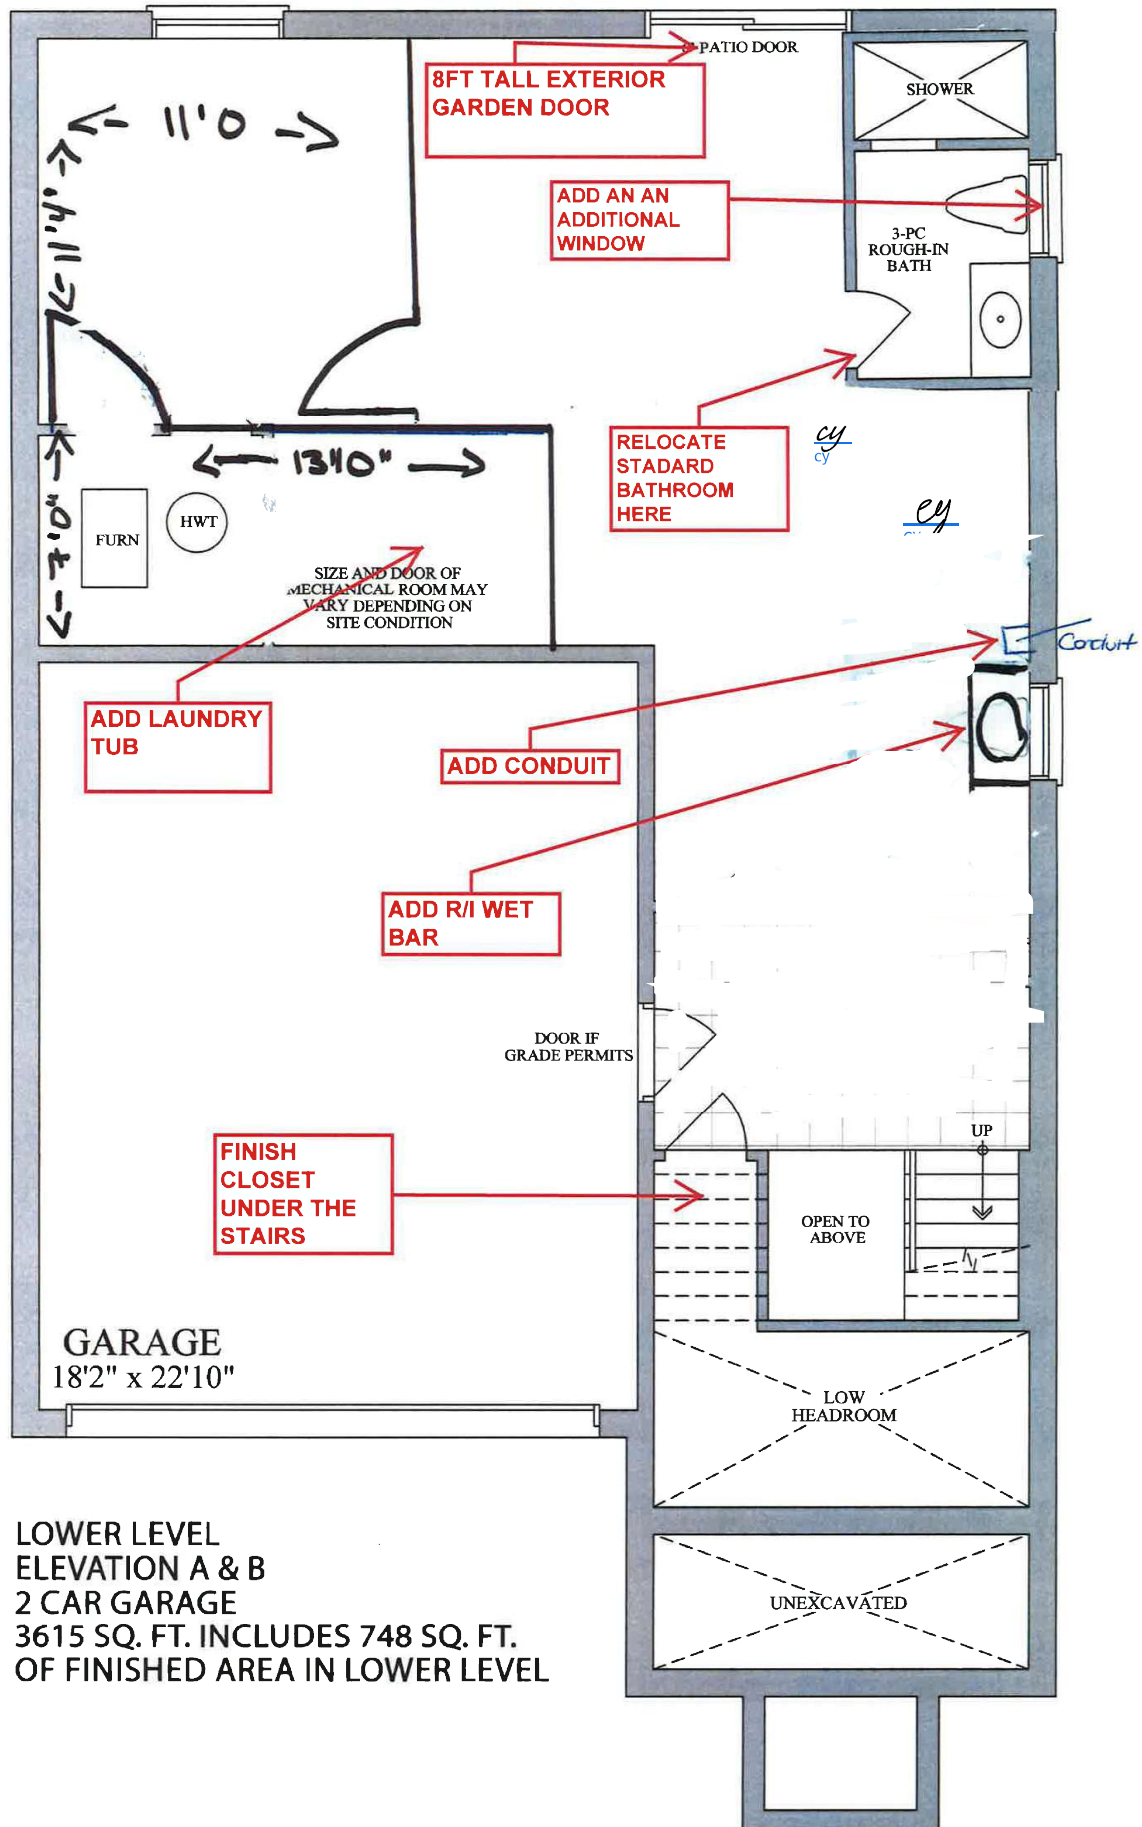

LOWER LEVEL
 ELEVATION A & B
 2 CAR GARAGE
 3615 SQ. FT. INCLUDES 748 SQ. FT.
 OF FINISHED AREA IN LOWER LEVEL

LOT 5-14, PH5, REVISED LOWER LEVEL