



July 21, 2023

LOT GRADING CERTIFICATE

Lot 141, Block 183 and 185, Registered Plan 51M-1014
Block 92, Registered Plan 51M-1099
Town of Innisfil
County of Simcoe

To Whom It May Concern:



I, **Kevin Ertl**, an Ontario Land Surveyor, of the firm, **IBW Surveyors Ltd.**, have conducted a field review of the sites, Lot 141, Block 183 and 185, Registered Plan 51M-1014 and Block 92, Registered Plan 51M-1099, in the Town of Innisfil and hereby certify that the lots/blocks have been graded in general compliance with the approved Site/Lot Grading Plans. Attached with this report are the field measurements for each of the mentioned lots.

Kevin Ertl, OLS

July 21, 2023

Date

cut $10.004 \checkmark$

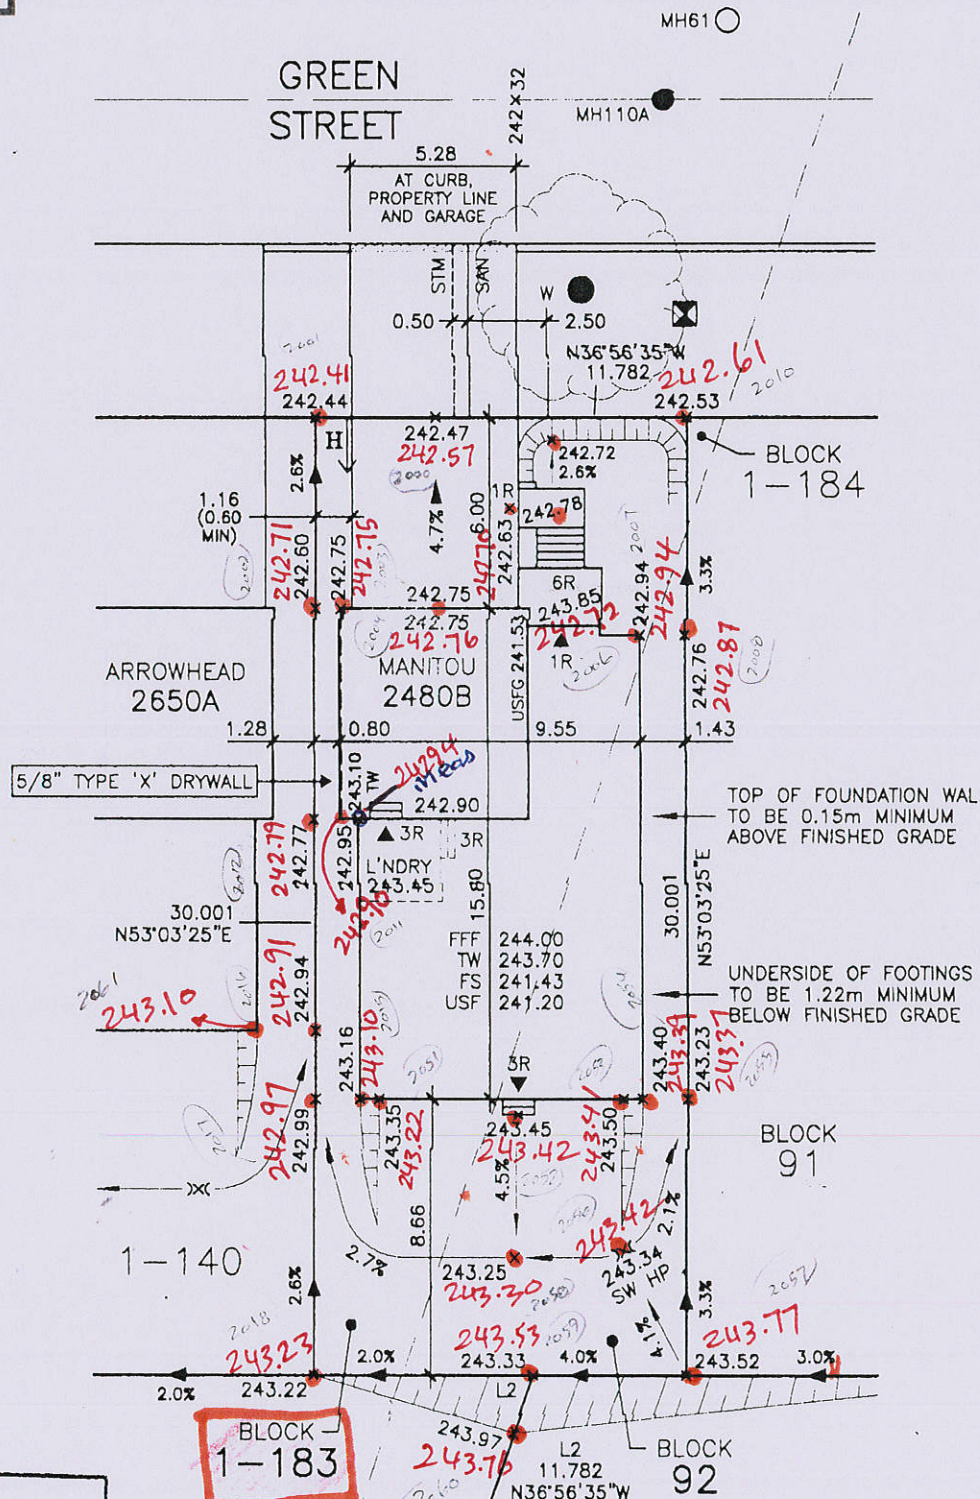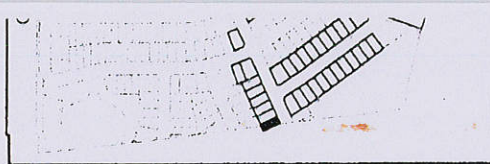


LARTIN
SOCIATES

CP
MCC
△ (151)

MCC
ACP (150)

Top Pin
181

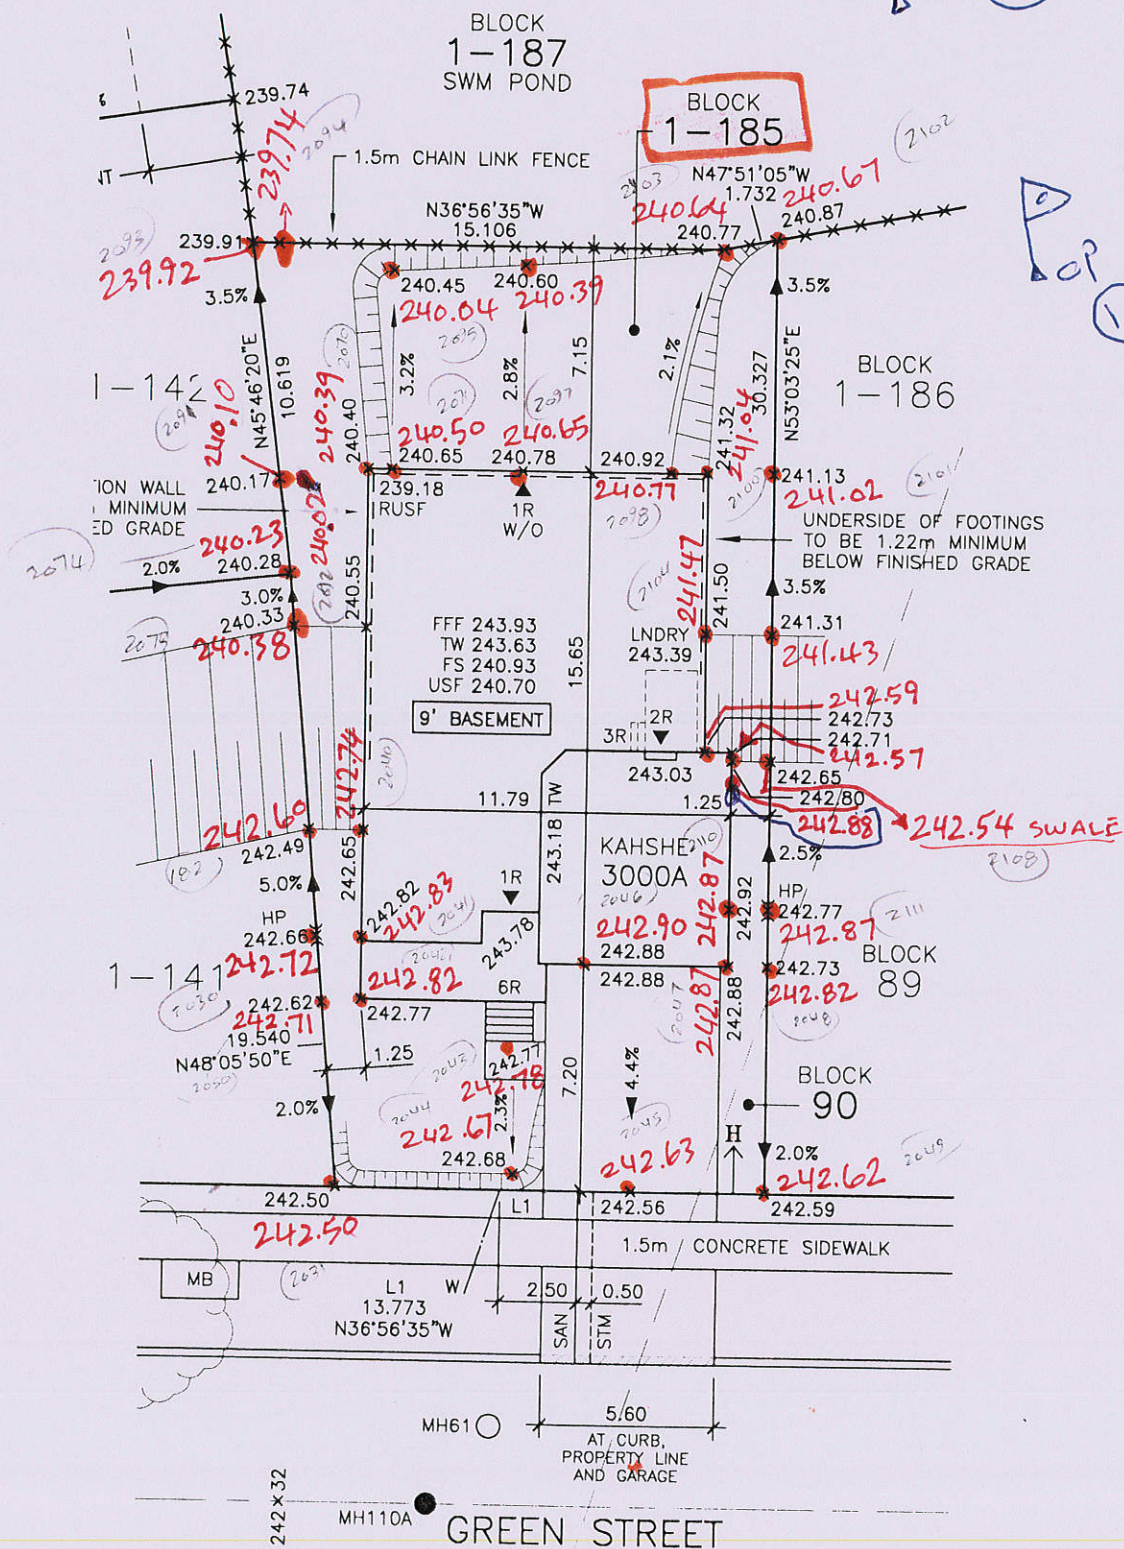

PROFESSIONAL