


Consultants Final Lot Grading Certification Letter

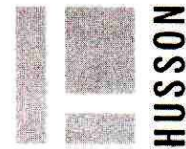

July 11, 2023

File No. 231437

Town of Innisfil

2101 Innisfil Beach Road


Innisfil, ON L9S 1A1

Attention: Fabian Van Romberg, Development Inspector:

Re: Municipal Address: 1031 Green Street
Lot or Block No.: Blk 185
Registered Plan No.: 2021-0275
Certification of building and final lot grading
Bellaire Properties Inc.

I have inspected the complete lot grading and building elevations on the above lot, and do hereby certify that:

1. The lot grading and building elevations on the above referenced lot are:
 - ☐ In conformity with the approved grading and site plans
 - ☒ Not in conformity with the approved plan, but have been constructed in accordance to sound engineering principles and vary from the approved plan as shown on the attached "as-built" plan, signed and stamped by the undersigned, subject to approval by the Town of Innisfil.
2. The water service "curb-stop" is located in the grassed portion of the front yard, is accessible, and is flush with finished grade.

<p>HUSSON Limited Name of Engineering Firm</p> <p>Carmen Sframeli, P. Eng. Professional Engineer's Name</p>	 <p>Stamp and Signature</p>
---	---

ENGINEERING + MANAGEMENT

P 905.709.5825

200 CACHET WOODS COURT, SUITE 204
MARKHAM, ON L6C 0Z8

HUSSON.CA



CONSULTANT'S FINAL LOT GRADING CERTIFICATION LETTER

Date: July 31, 2023

Town of Innisfil
2101 Innisfil Beach Road
Innisfil, ON
L9S 1A1

Attention: Frank Ruffolo, Development Inspector

Dear Sir:


**RE: Municipal Address: 1031 Green Street
Lot or Block No.: Block 185
Registered Plan No.: 51M-1014
Certification of Building and Final Lot Grading**

I have inspected the complete lot grading and building elevations on the above lot, and do hereby certify that:

1. The lot grading and building elevations on the above referenced lot are:
 - o In conformity with the approved grading and site plans
 - o Not in conformity with the approved plan, but have been constructed in accordance with sound engineering principles and vary from the approved plan as shown on the attached "as-built" plan, signed and stamped by the undersigned, subject to approval by the Town of Innisfil.
2. The water service "curb-stop" is located in the grassed portion of the front yard, is accessible, and is flush with finished grade.
3. The driveway conforms with minimum clearances listed in our Engineering Design Standards, Appendix C: Minimum Offset Matrix.


Sincerely,

IBW Surveyors Ltd.

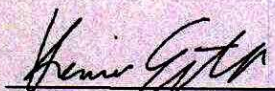
Kevin Ertl, B.Eng, O.L.S.

July 31, 2023

Date

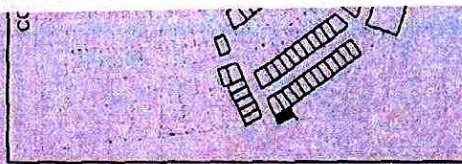

CP
MCC
151

MCC
DCP
150

BLOCK
1-187
SWM POND

BLOCK
1-185

BLOCK
1-186

POP PIN
181

