

## Town of Innisfil

2101 Innisfil Beach Road Innisfil | ON L9S 1A1 Phone: 705-436-3710

Phone: 705-436-3710 Toll Free: 1-888-436-3710

# NOTICE OF COMPLETION (FINAL)

Permit number: 2021-1081

Municipal address: 1044 HARDY WAY

Status of inspection: Completed

Permit type:

Legal address: PLAN 51M1169 LOT 83

Issue date: 2021-11-02

## **Deficiencies**

No deficiencies or remarks noted.

## **Visits**

VISIT DATE	INSPECTOR	VISIT RESULT	COMMENTS
2023-11-27, 11:46 a.m.	Tristan Munro	Passed (Substantially complete)	- The exterior of the building appears complete at the time of inspection. "Notice of Completion" is granted.

Acceptance and approval by a building inspector is required to continue with construction. If deficiencies are identified, you are required to book a re-inspection. Construction must not be concealed until infractions have been inspected by the Town of Innisfil and accepted by the building inspector. Failure to resolve outstanding concerns may result in the issuance of an Order.

## **Parties**

NAME AND COMPANY	CONTACT DETAILS	ROLES
Roberto - Lormel Homes	+1 14166889324	Builder
Bellaire Properties Inc Bellaire Properties Inc	331 Cityview Blvd, Suite 300, Vaughan	Property owner
Zach De Meneghi Lormel Homes	331 Cityview Blvd, Unit 300, Vaughan (416) 576-7587	Applicant



## CONSULTANT'S FINAL LOT GRADING CERTIFICATION LETTER

Date: October 19, 2023

Town of Innisfil 2101 Innisfil Beach Road Innisfil, ON L9S 1A1

Attention: Frank Ruffolo, Development Inspector

Dear Sir:

RE: Municipal Address: 1044 Hardy Way, Innisfil

Lot or Block No.: Lot 83

Registered Plan No.: 51M-1169

Certification of Building and Final Lot Grading

I have inspected the complete lot grading and building elevations on the above lot, and do hereby certify that:


- 1. The lot grading and building elevations on the above referenced lot are:
  - o In conformity with the approved grading and site plans
- 2. The water service "curb-stop" is located in the grassed portion of the front yard, is accessible, and is flush with finished grade.
- 3. The driveway conforms with minimum clearances listed in our Engineering Design Standards, Appendix C: Minimum Offset Matrix.

Sincerely,

IBW Surveyors Ltd.

Kevin Ertl B Eng. O.I. S.

October 19, 2023

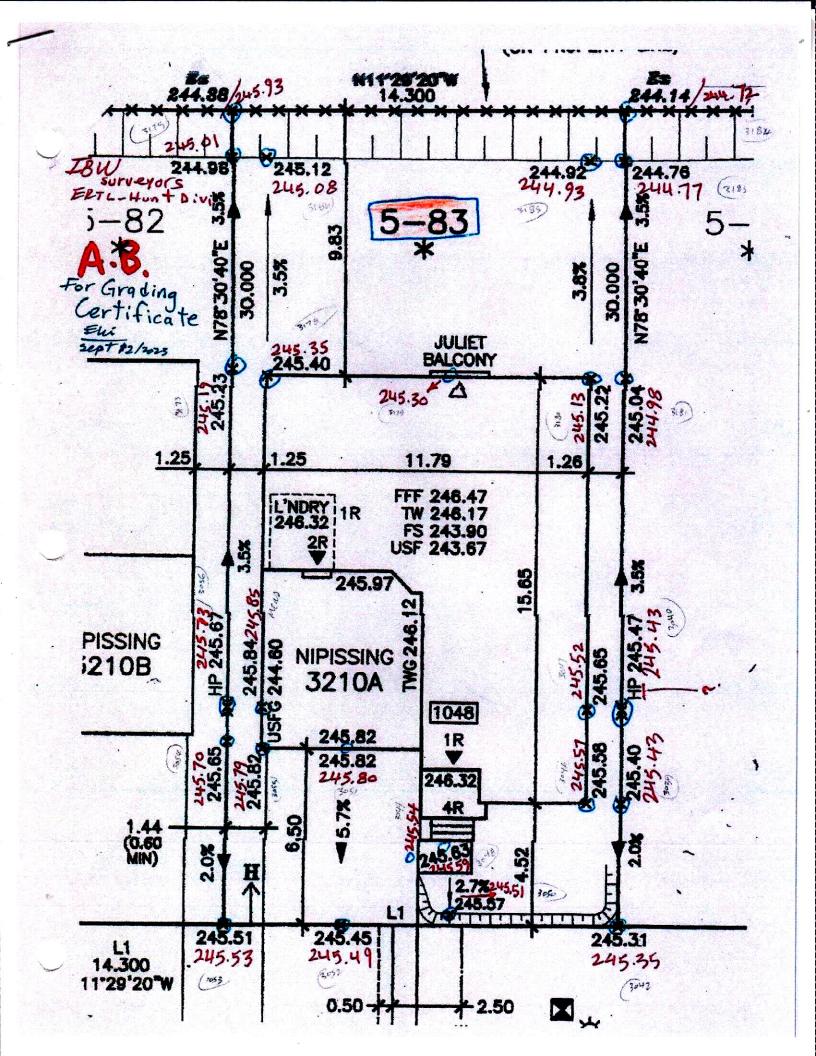

## Consultants Final Lot Grading Certification Letter



September 15, 2023

File No. 231437

Town of Innisfil
2101 Innisfil Beach Road
Innisfil, ON L9S 1A1

Attention: Fabian Van Romberg, Development Inspector:

Re:

Municipal Address:

1044 Hardy Way

Lot or Block No.:

Lot 83

Registered Plan No.:

2021-1081

Certification of building and final lot grading

Bellaire Properties Inc.

I have inspected the complete lot grading and building elevations on the above lot, and do hereby certify that:

- 1. The lot grading and building elevations on the above referenced lot are:
  - In conformity with the approved grading and site plans
  - Not in conformity with the approved plan, but have been constructed in accordance to sound engineering principles and vary from the approved plan as shown on the attached "as-built" plan, signed and stamped by the undersigned, subject to approval by the Town of Innisfil.
- The water service "curb-stop" is located in the grassed portion of the front yard, is accessible, and is flush with finished grade.

**HUSSON Limited** 

Name of Engineering Firm

Carmen Sframeli, P. Eng.

Professional Engineer's Name



ENCINEEDING . MANAGEMENT

P 905.709.5825 200 CACHET WOODS COURT, SUITE 204 MARKHAM, ON L6C 0Z8

HUSSON.CA

#### ZONING INFORMATION ZONE DESIGNATION PERMITTED R1-26 PROVIDED LOT AREA (sq m) 420.00 429.00 LOT FRONTAGE (m) 14,300 14,300 FRONT YARD SETBACK TO DWELLING (m) 4.50 4.52 FRONT YARD SETBACK TO GARAGE (m) 6.00 6.50 ONE INTERIOR SIDE YARD SETBACK (m) 1.20 1.25 OTHER INTERIOR SIDE YARD SETBACK (m) 1.20 1.26 REAR YARD SETBACK (m) 6.00 9.83 LOT COVERAGE (%) 40.00 39.70 BUILDING HEIGHT (m) 10.00 8.45 LANDSCAPED OPEN SPACE (%) 30.00 50.87 FRONT YARD LANDSCAPED OPEN SPACE (%) 40.00 60.84

STRUCTU	RE	
MODEL NO.		NIPISSING 3210A
HOUSE STYLE (i.e. walkout, bungalow etc.)		2 STOREY
ADJACENT MODEL	EAST	NIPISSING 3210B
	WEST	N/A
	NORTH	N/A
	SOUTH	NIPISSING 3210B
FIREBREAK LOT		NO

#### **LEGEND** SINGLE CATCHBASIN DOUBLE CATCHBASIN SANITARY MH O STORM MH SANITARY SERVICE CONNECTION -- STORM SERVICE CONNECTION WATER SERVICE CONNECTION FLOW DIRECTION ROOF DRAIN \* ENGINEERED FILL 000.00 EXISTING ELEVATION 000.00 PROPOSED ELEVATION FFF FINISHED 1ST FLOOR TOP OF FOUNDATION WALL FS FINISHED SLAB USF U/S FOOTING RUSF REAR U/S FOOTING TWG TOP OF GARAGE FOUNDATION WALL USFG U/S FOOTING GARAGE SP) SUMP PUMP VALVE AND BOX HYDRANT AND VALVE BELL PEDESTAL CABLE PEDESTAL UNDERGROUND PEDESTAL HYDRO TRANSFORMER STREETLIGHT STREETLIGHT PEDESTAL P → H HYDRO SERVICE CONNECTION MB SUPER MAILBOX

## **GENERAL NOTES**

1234 MUNICIPAL ADDRESS

TITTE SLOPE 3:1 MAXIMUM

ALL SLOPES TO BE 3:1 MAX

THE BUILDER SHALL BE RESPONSIBLE FOR THE VERIFICATION OF HOUSE TYPE AND ELEVATION, PRIOR TO COMMENCEMENT OF CONSTRUCTION


FOOTINGS LOWERED TO MAINTAIN 1.22m FROST PROTECTION

### **BENCHMARK**

**ELEVATION: 286.399** 

ELEVATION IS BASED ON BENCHMARK No. 0011931U463S HAVING AN ELEVATION OF 286.399 METRES. LOCATION: TOWNSHIP OF CHURCHILL UNITED CHURCH, TABLET IN NORTH STONE FOUNDATION WALL OF TOWER, 23cm FROM NORTHWEST CORNER AND 1.62m BELOW BRICKWORK.

WATER SERVICE AT P/L SANITARY SERVIC	E AT P/L STORM SERVICE AT P/L
DEPTH INVERT DEPTH I	NVERT DEPTH INVERT

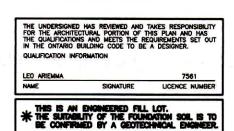






LOT

BLOCK 1-171 BUFFER

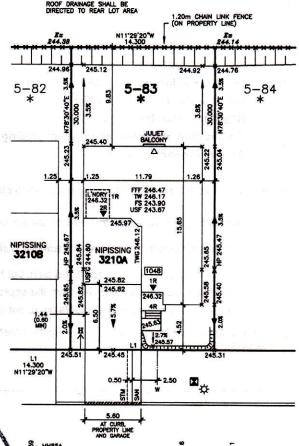

HARDY WAY



REVISIONS	DATE	
ISSUED	00 07 21	TP
AS BUILT	SE 15 23	BJJ
- Anna A		$\vdash$
	ISSUED	ISSUED 0C 07 21

## ARCHITECTURAL DESIGN INC.



56 PENNSYLVANIA AVE. UNIT 1 CONCORD, ONTARIO L4K 3V9

TEL 905 660-9393 FAX 905 660-9419

adci@bellnet.ca



INGS MUST NOT BE SCALED

THE PROPOSED LOT GRADING IS APPROVED AS BEING IN GENERAL CONFORMITY WITH THE OVERALL APPROVED GRADING PLAN FOR THIS

COMPANY NAME: HUSSON ENGINEERING

APPROVED BY: C. SFRAMELI

SIGNATURE SEPTEMBER 15, 2023

1044 HARDY WAY LOT 83, PLAN 51M-1169 PHASE 5, STAGE BELLAIRE PROPERTIES INC. PARCEL P1 - LEFROY TOWN OF INNISFIL

SCALE:	1:250	Г
DATE:	OCT 2021	ı
DRAWN:	T.P.	ı

A-1 DESIGNED: T.P.