Consultants Final Lot Grading Certification Letter



September 15, 2023

File No. 231437

Town of Innisfil 2101 Innisfil Beach Road Innisfil, ON L9S 1A1

Attention: Fabian Van Romberg, Development Inspector:

Re:

Municipal Address:

1032 Hardy Way

Lot or Block No.:

Lot 176

Registered Plan No.:

2021-1075

Certification of building and final lot grading

Bellaire Properties Inc.

I have inspected the complete lot grading and building elevations on the above lot, and do hereby certify that:

- The lot grading and building elevations on the above referenced lot are:
 - In conformity with the approved grading and site plans
 - □ Not in conformity with the approved plan, but have been constructed in accordance to sound engineering principles and vary from the approved plan as shown on the attached "as-built" plan, signed and stamped by the undersigned, subject to approval by the Town of Innisfil.
- The water service "curb-stop" is located in the grassed portion of the front yard, is accessible, and is flush with finished grade.

HUSSON Limited

Name of Engineering Firm


Carmen Sframeli, P. Eng.

Professional Engineer's Name



ENGINEERING + MANAGEMENT

P 905.709.5821 200 CACHET WOODS COURT, SUITE 20-MARKHAM, ON L6C 021

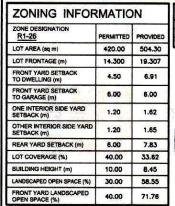

STRUCTU	₹E	-
MODEL NO.		CARLYLE 2950A
HOUSE STYLE (i.e. walkout, bungalow etc.)		2 STOREY
ADJACENT MODEL	EAST	N/A
	WEST	N/A
	NORTH	NIPISSING 32108
	SOUTH	NIPISSING 3210A
TIPE TO THE PARTY OF THE PARTY		

LEGEND

SINGLE CATCHBASIN
DOUBLE CATCHBASIN
SANITARY MH

O STORM MH
SANITARY SERVICE CONNECTION

SANITARY SERVICE CONNECTION
STORM SERVICE CONNECTION
WATER SERVICE CONNECTION

FLOW DIRECTION
ROOF DRAIN

ENGINEERED FILL

000.00 EXISTING ELEVATION

000.00 PROPOSED ELEVATION

FFF FINISHED 1ST FLOOR TW TOP OF FOUNDATION WALL

FS FINISHED SLAB USF U/S FOOTING BUSE PEAR U/S FOOT

RUSF REAR U/S FOOTING
TWG TOP OF GARAGE FOUNDATION WALL

USFG U/S FOOTING GARAGE
SO SUMP PUMP

O VALVE AND BOX
O HYDRANT AND VALVE

DELL PEDESTAL

△ CABLE PEDESTAL

** UNDERGROUND PEDESTAL

HYDRO TRANSFORMER

STREETLIGHT

THE STREETLIGHT PEDESTAL

HYDRO SERVICE CONNECTION

MB SUPER MAILBOX

1234 MUNICIPAL ADDRESS

SLOPE 3:1 MAXIMUM
FOOTINGS LOWERED TO MAINTAIN
1.22m FROST PROTECTION

GENERAL NOTES

ALL SLOPES TO BE 3:1 MAX

THE BUILDER SHALL BE RESPONSIBLE FOR THE VERIFICATION OF HOUSE TYPE AND ELEVATION, PRIOR TO COMMENCEMENT OF CONSTRUCTION

BENCHMARK

ELEVATION: 286.399

ELEVATION IS BASED ON BENCHMARK No. 0011931U463S HAVING AN ELEVATION OF 286.399 METRES. LOCATION: TOWNSHIP OF CHURCHILL UNITED CHURCH, TABLET IN NORTH STONE FOUNDATION WALL OF TOWER, 23cm FROM NORTHWEST CORNER AND 1.62m BELOW BRICKWORK.

SERVICING CHECK BOX WATER SERVICE AT PA. SANITARY SERVICE AT PA. STORM SERVICE AT PA. DEPTH INVERT DEPTH INVERT Min 1.70 Min 244.35 3.075 243.025 3.01 243.09






14.3 m

47 foot

THIS IS AN ENGINEERED FILL LOT. * THE SUITABILITY OF THE FOUNDATION SOIL IS TO BE CONFIRMED BY A GEOTECHNICAL ENGINEER.

BLOCK 1-171 BUFFER

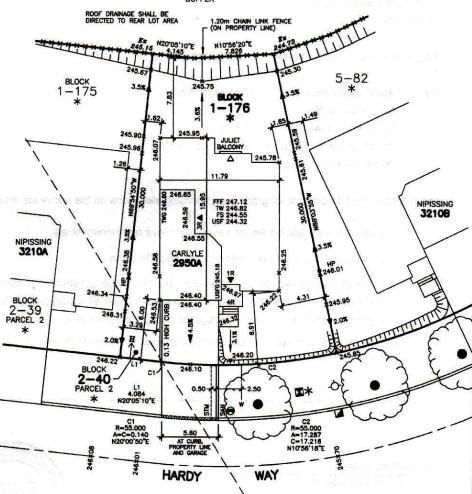

THE UNDERSIGNED HAS REVIEWED AND TAKES RESPONSIBILITY FOR THE ARCHITECTURAL PORTION OF THIS PLAN AND HAS THE QUALIFICATIONS AND MEETS THE REQUIREMENTS SET OUT IN THE ONTRAIO BUILDING CODE TO BE A DESIGNER.

QUALIFICATION INFORMATION

LEO ARIEMMA 7561
NAME SIGNATURE LICENCE NUMBER

	- 7 Wa	15-7	
2	AS: BUILT	SE 15 23	BJJ
1	REVISED PER IBI GROUP REVIEW	OC 12 21	TP
-	ISSUED	OC 05 21	TP
NO.	REVISIONS	DATE	NITAL

ARCHITECTURAL DESIGN INC.



56 PENNSYLVANIA AVE.
UNIT 1
CONCORD, ONTARIO
L4K 3V9
TEL 905 660-9393
FAX 905 660-9419
adci@bellnet.ca

ASSOC OF A ARCHITECTS 2

ALL DRAWINGS AND SPECIFICATIONS ARE THE PROPERTY OF THE ARCHITECT AND CANNOT BE USED OR REPRODUCED WITHOUT HIS APPROVAL THE CONTRACTOR SMALL CHECK AND MEDICAL

THE CONTRACTOR SHALL CHECK AND VERIF ILL DIMENSIONS ON THE SITE AND REPORT MY DISCREPANCIES TO THE ARCHITECT PRAWINGS MUST NOT BE SCALED THE PROPOSED LOT GRADING IS APPROVED AS BEING IN GENERAL CONFORMITY WITH THE OVERALL APPROVED GRADING PLAN FOR THIS SUBDIVISION.

COMPANY NAME: HUSSON ENGINEERING

APPROVED BY: C. SFRAMEU

DATE:

SEPTEMBER 15, 2023

1032 HARDY WAY BLOCK 176, PLAN 51M-1014 PHASE 5, STAGE BELLAIRE PROPERTIES INC. PARCEL P1 - LEFROY TOWN OF INNISFIL

SCALE:	1:250	DRAWING No:
DATE:	OCT 2021	
DRAWN:	T.P.	I A-1
DESIGNED:	T.P.	