


SUITE 214

KAZ-12

MR NW SR


Framed mirrored sliding doors

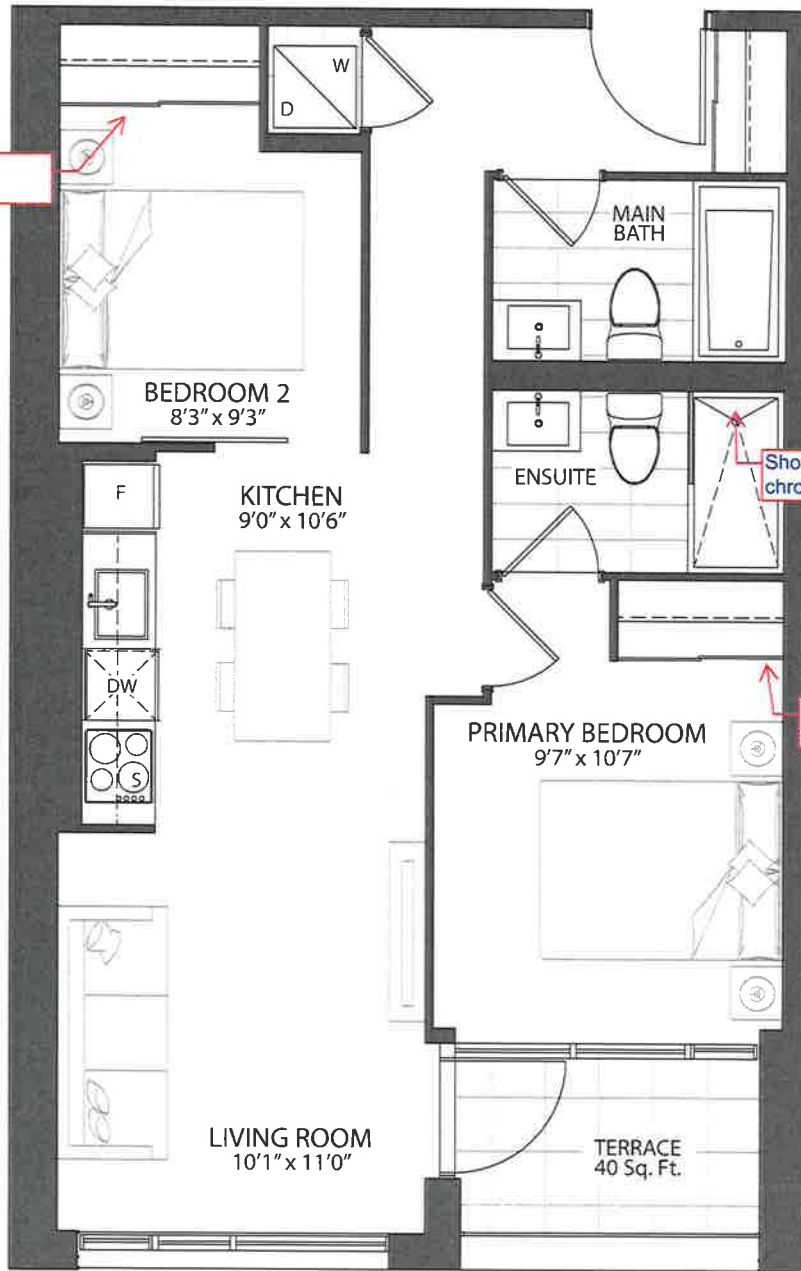


Shower kit opt 4 chrome

Framed mirrored sliding doors


LORMEL
KAZMIR
214-314-412 - 2B (686 SF)

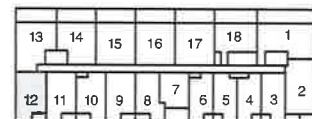

FLOOR 4

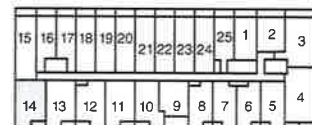

FLOOR 3

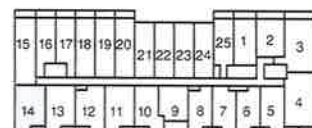

FLOOR 2