

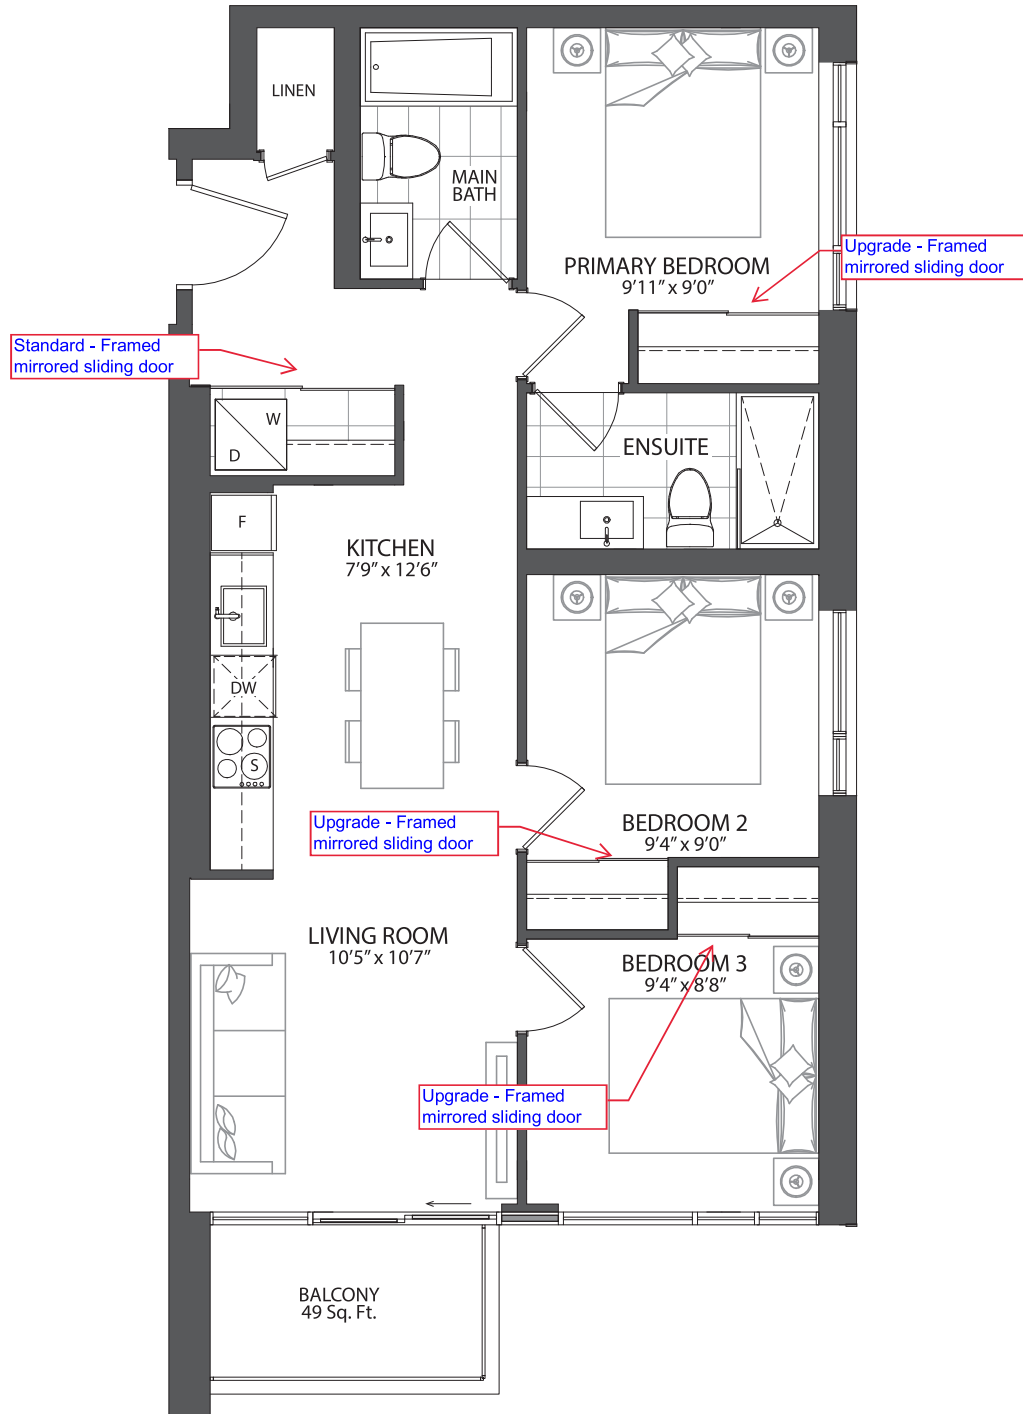


FLOOR 4

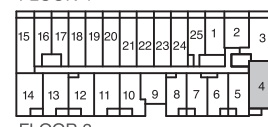

FLOOR 3

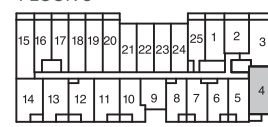

FLOOR 2

