

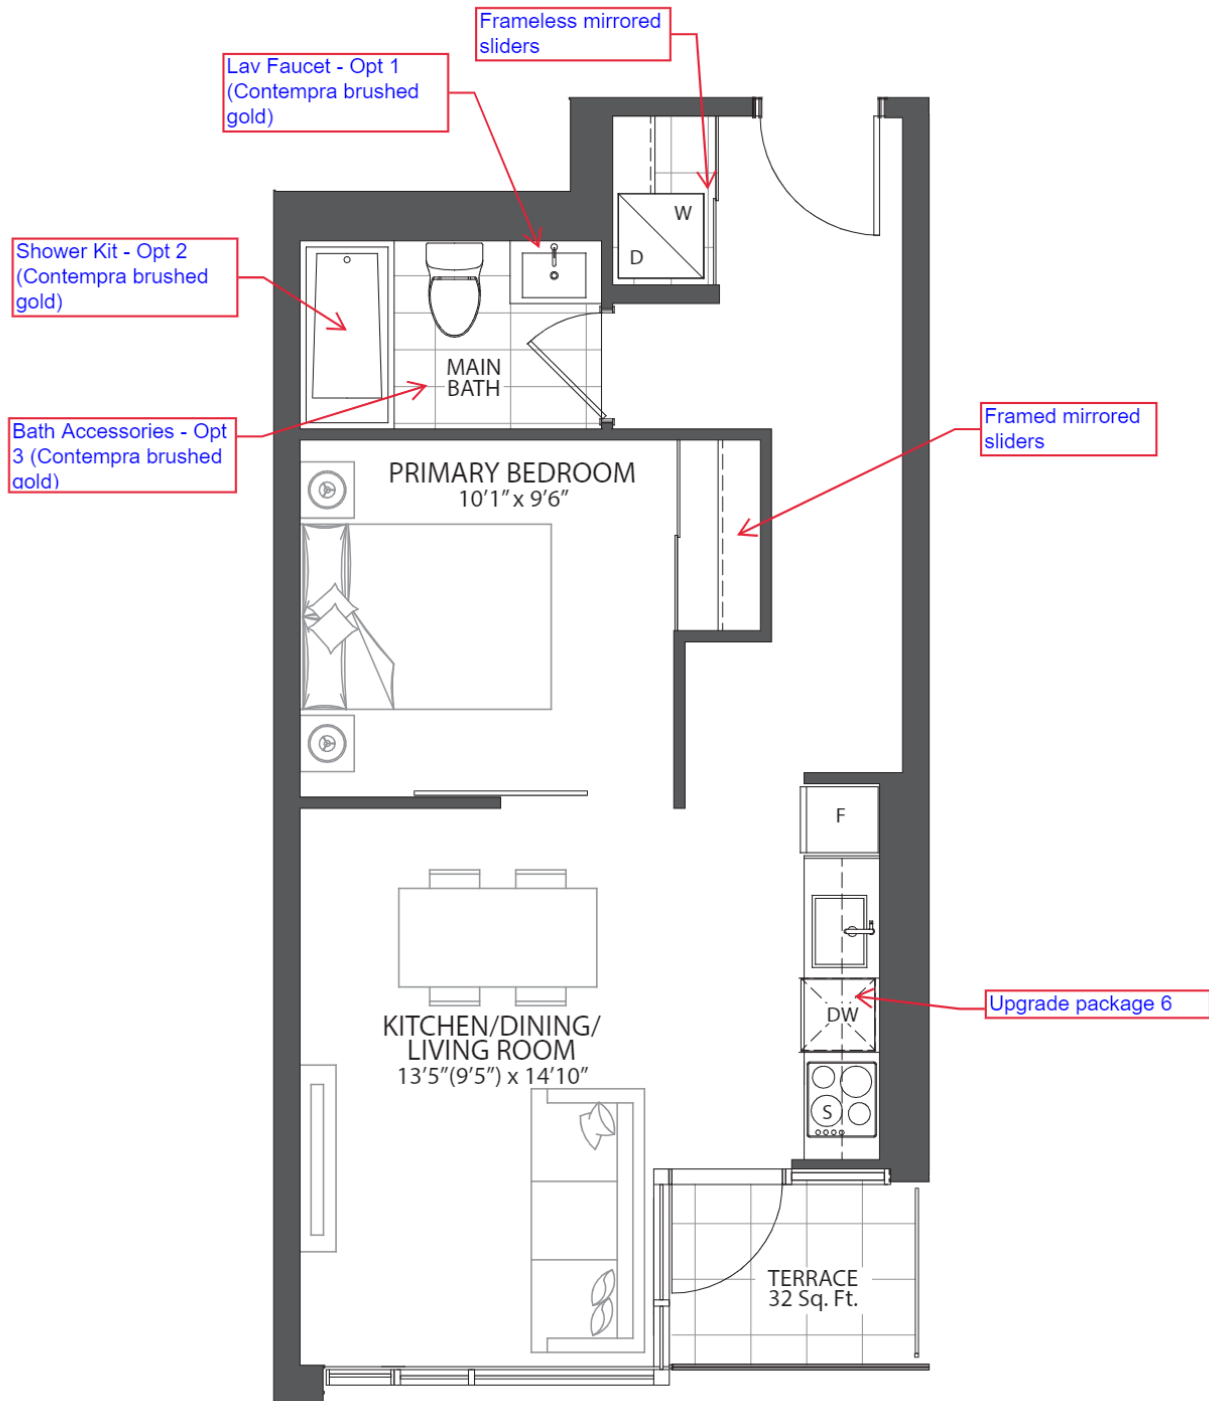
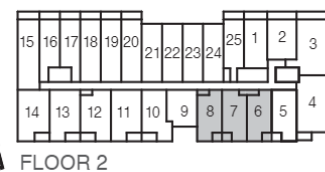
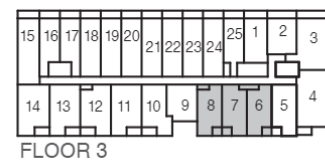
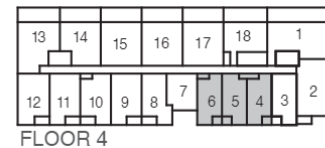


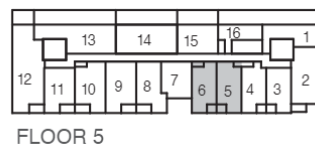

P.M.
PM
MK
MK

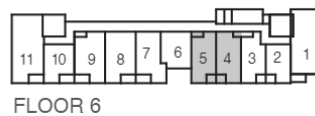

LORMEL

KAZMIR

206, 207, 208, 306, 307, 308, 404, 405, 406,
505, 506, 604, 605 -1B (528 SF)