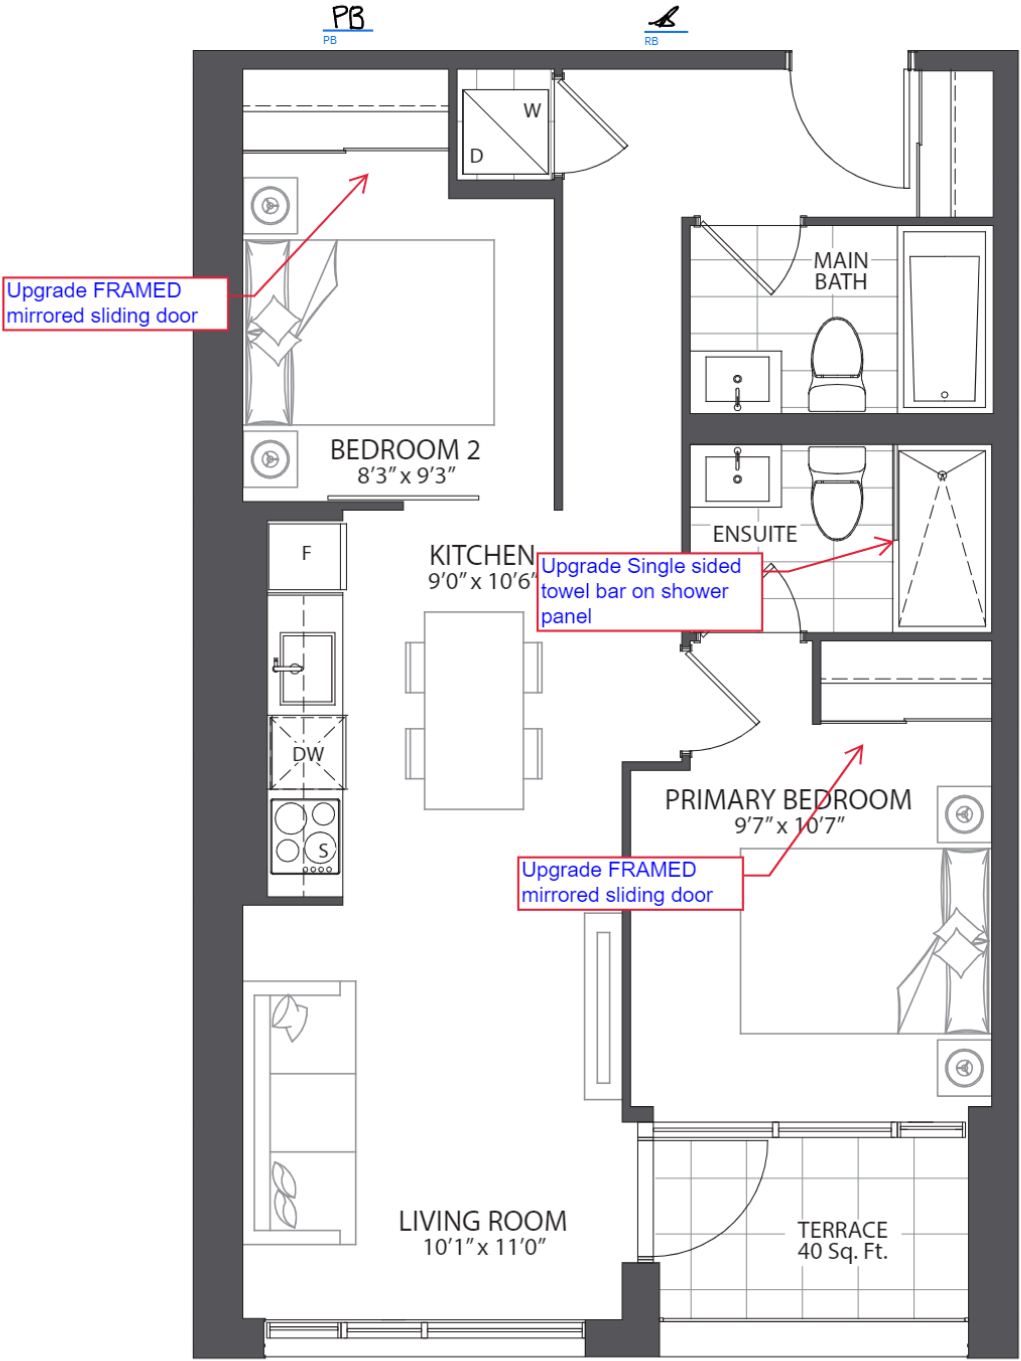


LORMEL
KAZMIR
214-314-412 - 2B (686 SF)