




LORMEL
KAZMIR
415-416-417 - 2B (814 SF)

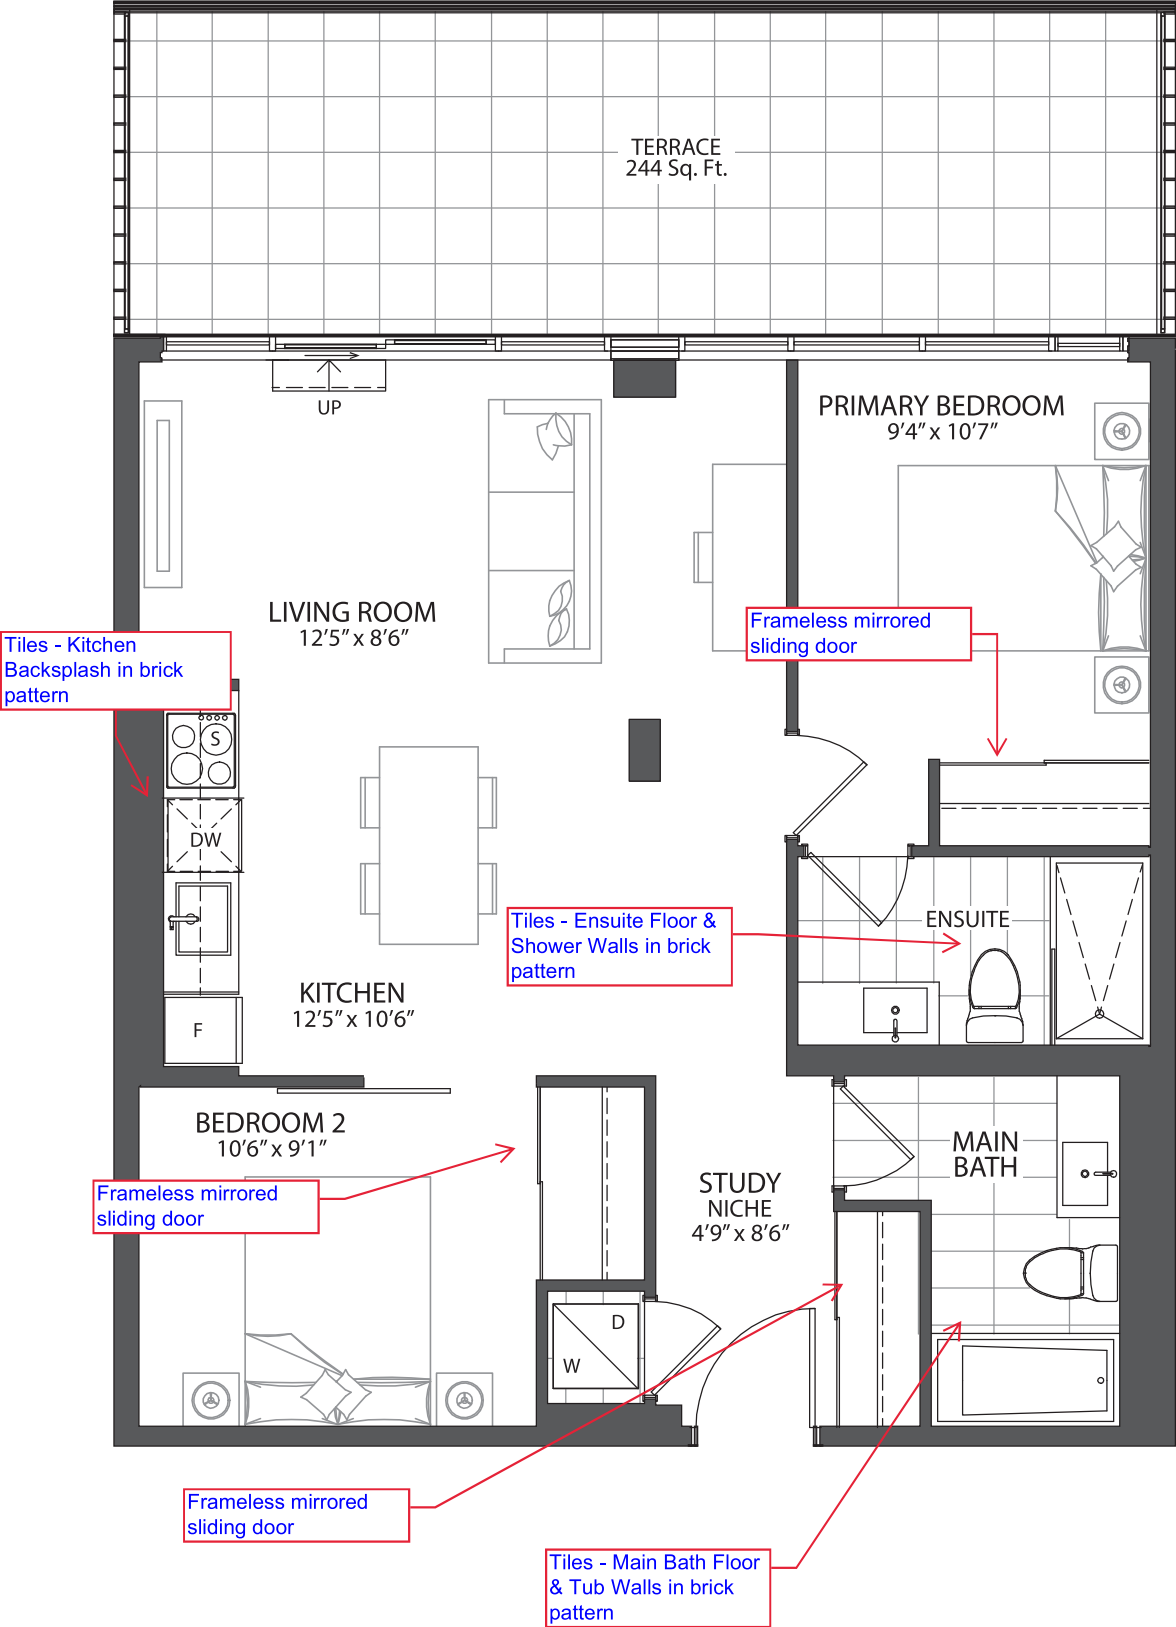