




Purchaser's Initial(s): SS

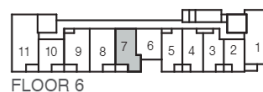


FLOOR 6

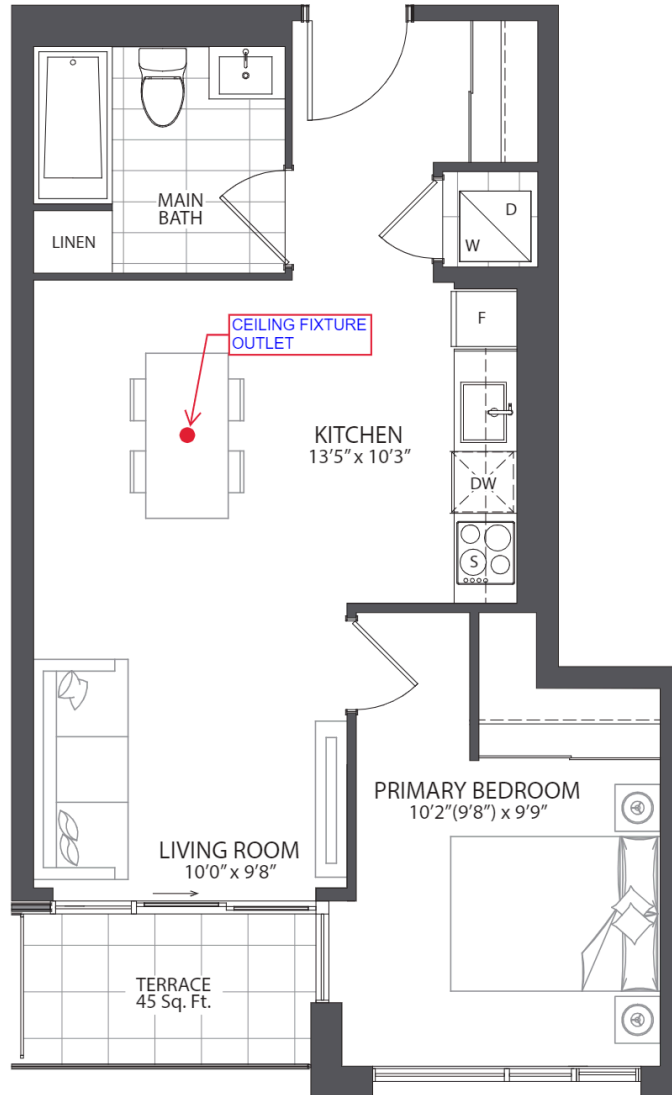

FLOOR 5

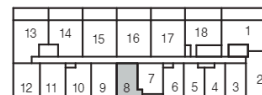

FLOOR 4

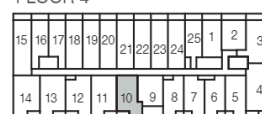

FLOOR 3



FLOOR 2

