
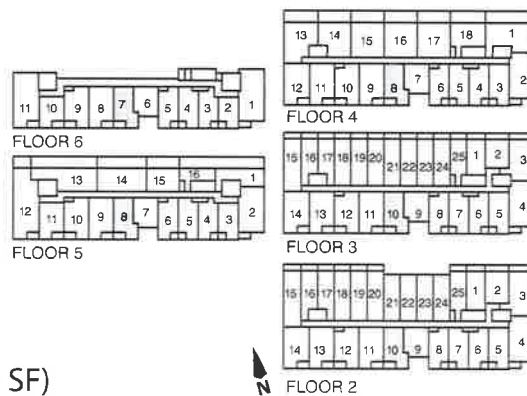


Purchaser's Initial(s): _____

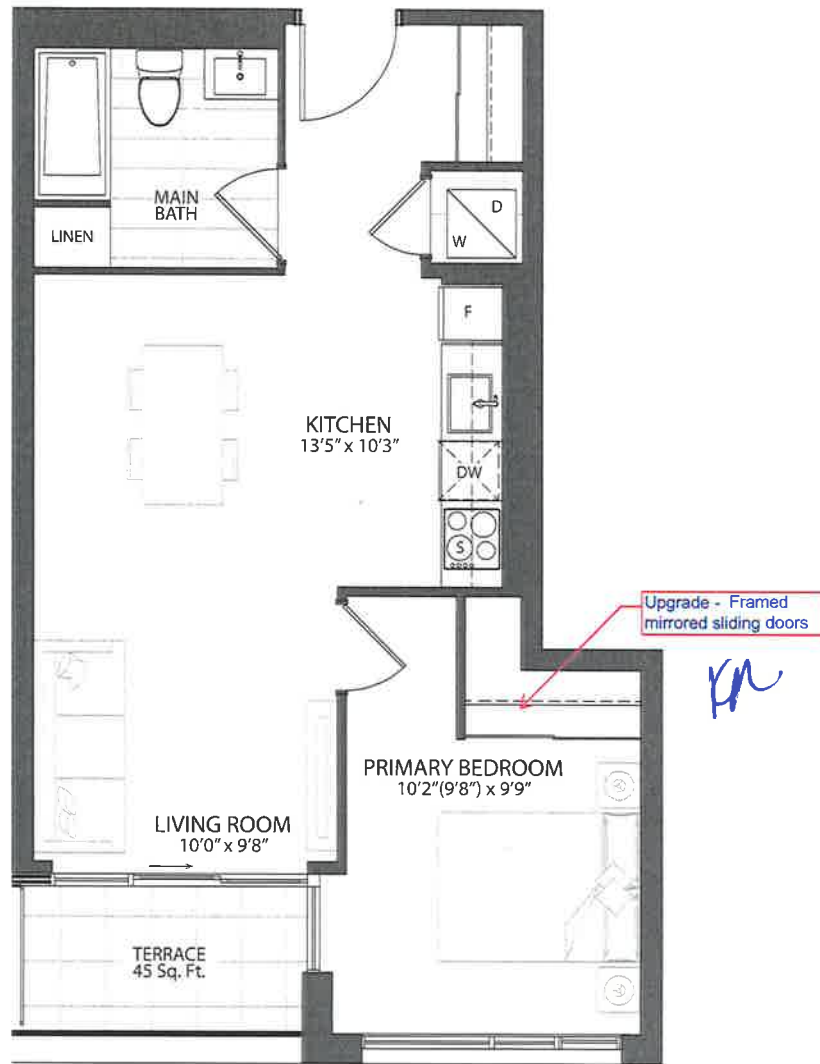

LORMEL
KAZMIR
210-310-408-508-607 - 1B (584 SF)