


SUITE 501

KAZ-31



LORMEL
KAZMIR
501 - 1B + DEN (596 SF)

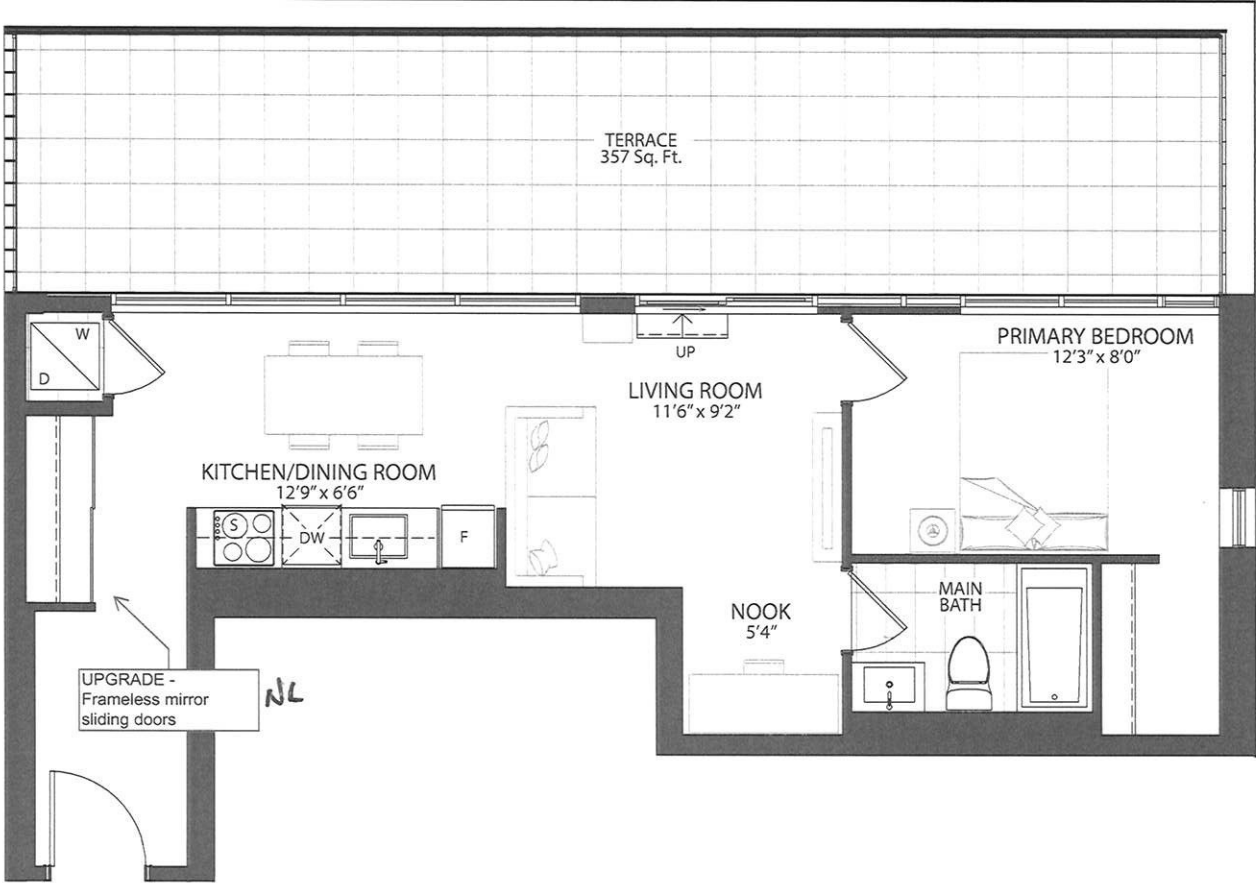