




LORMEL
KAZMIR
201 - 1B (542 SF)

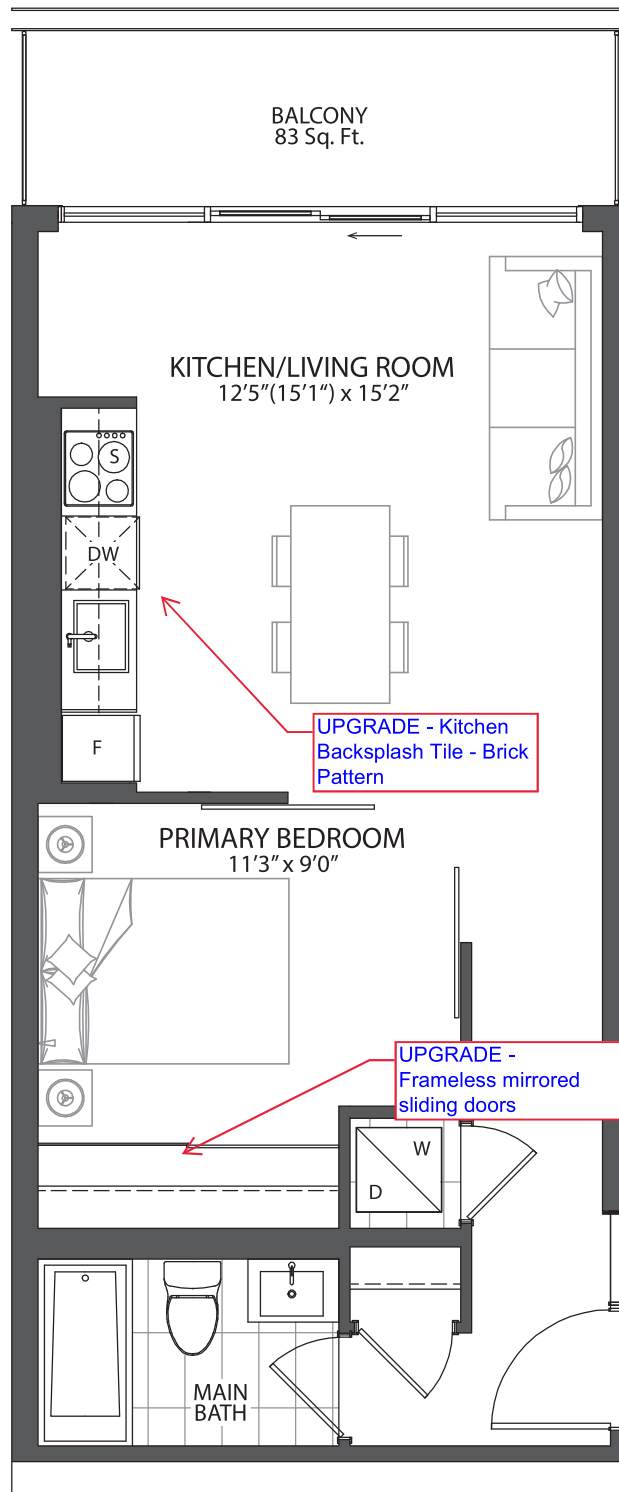