




SECOND FLOOR

LORMEL
KAZMIR
221-222-223-224 - 1B (543 SF)

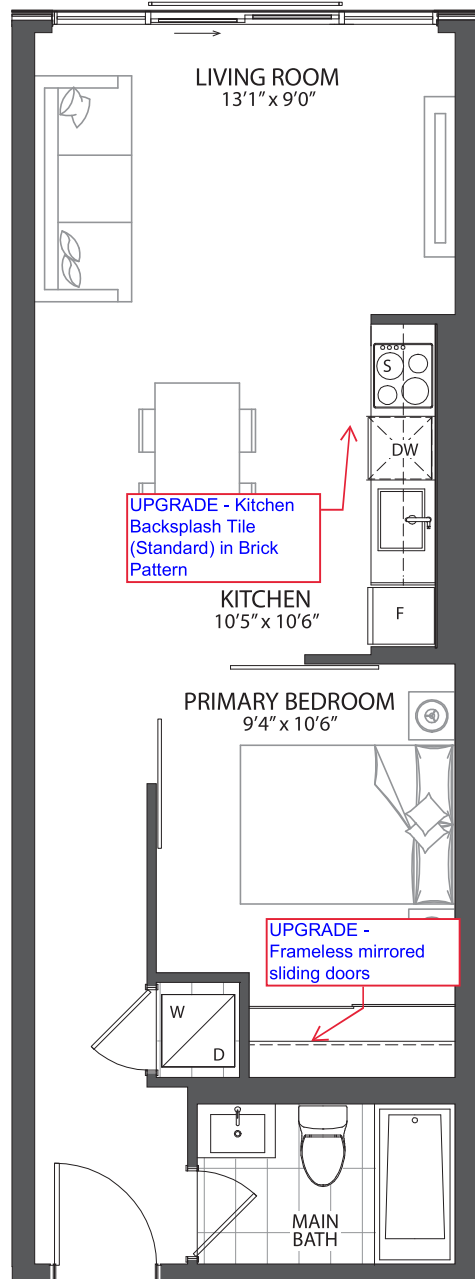