




D.S.

LORMEL
KAZMIR
211-311- 2B (659 SF)

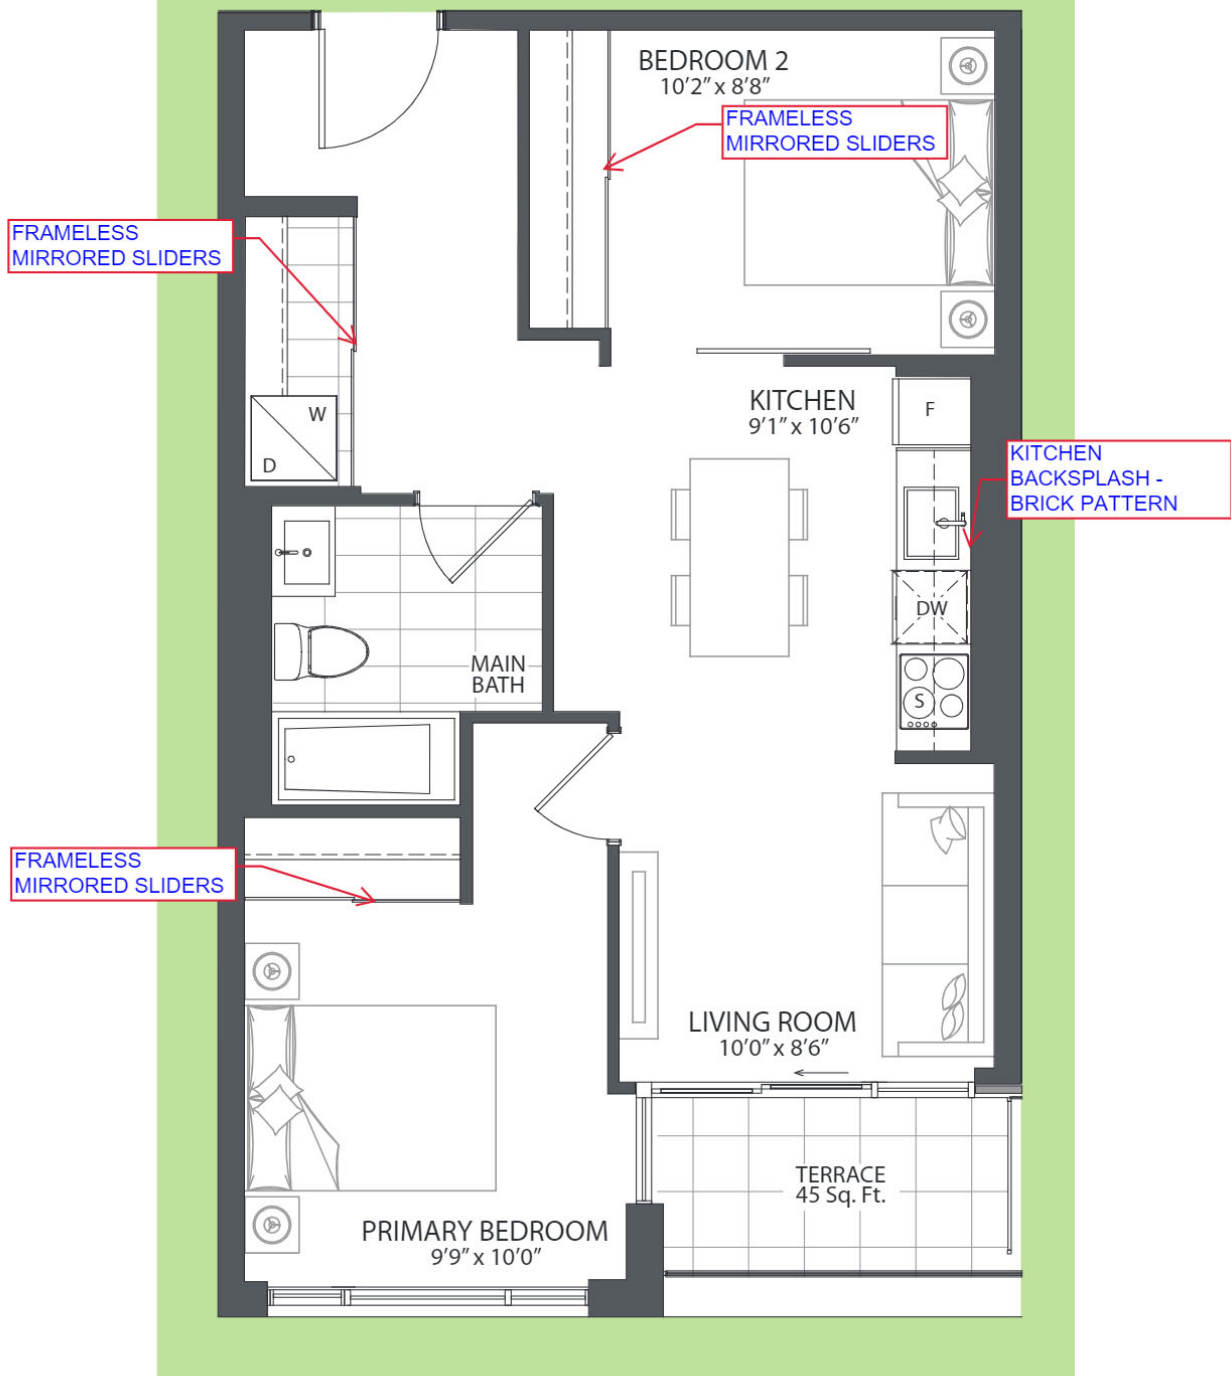