




KITCHEN
BACKSPLASH -
BRICK PATTERN

SINGLE SIDED
TOWEL BAR ON SIDE
PANEL

FRAMELESS
MIRRORED SLIDERS

FRAMELESS
MIRRORED SLIDERS

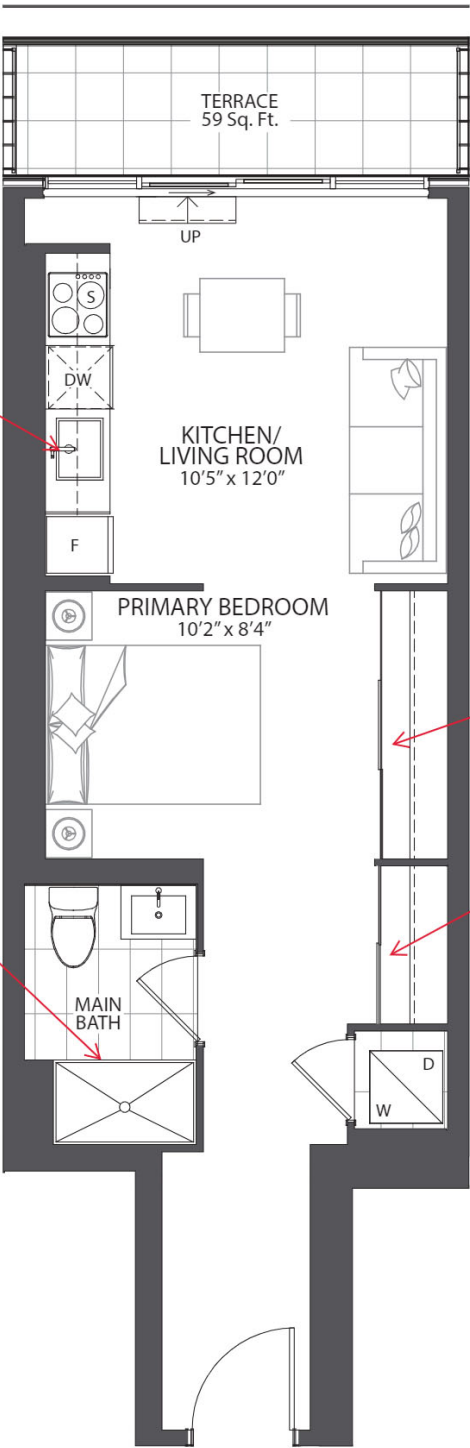

LORMEL
KAZMIR
325 - STUDIO (484 SF)

