




LORMEL  
KAZMIR  
602 - STUDIO (401 SF)

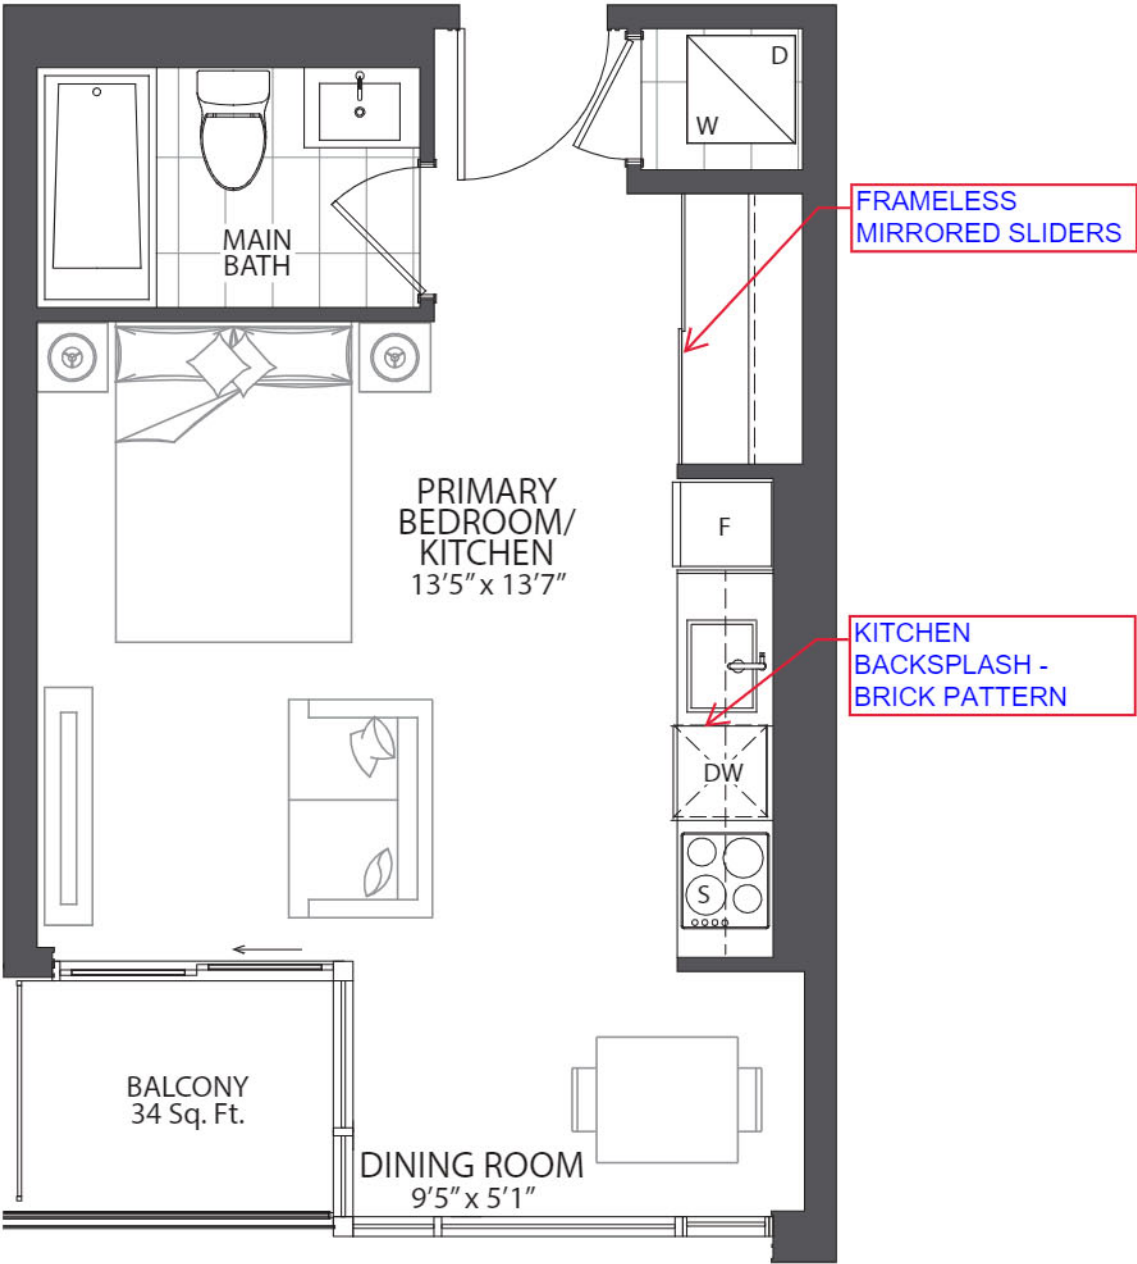