


SUITE 707

KAZ-PH-7

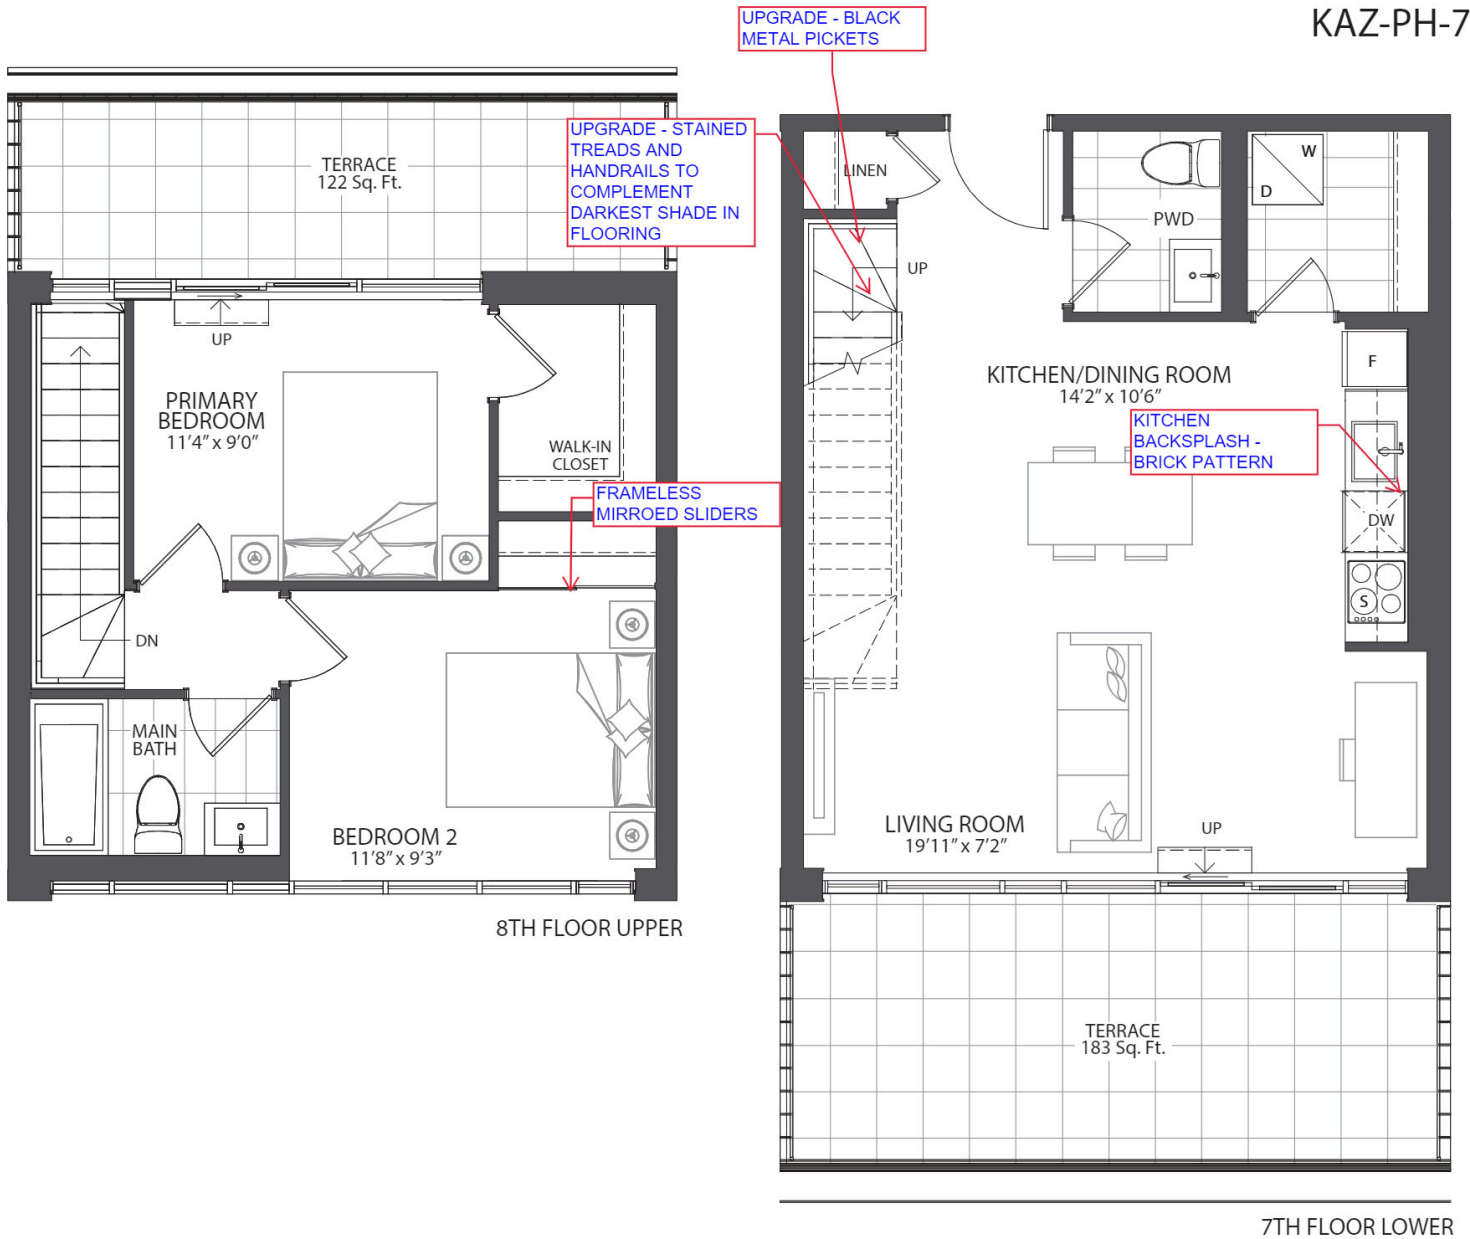

LORMEL
KAZMIR
707 - 2B (920 SF)

