


EDM
EDM



LORMEL
KAZMIR
203 - 2B (854 SF)

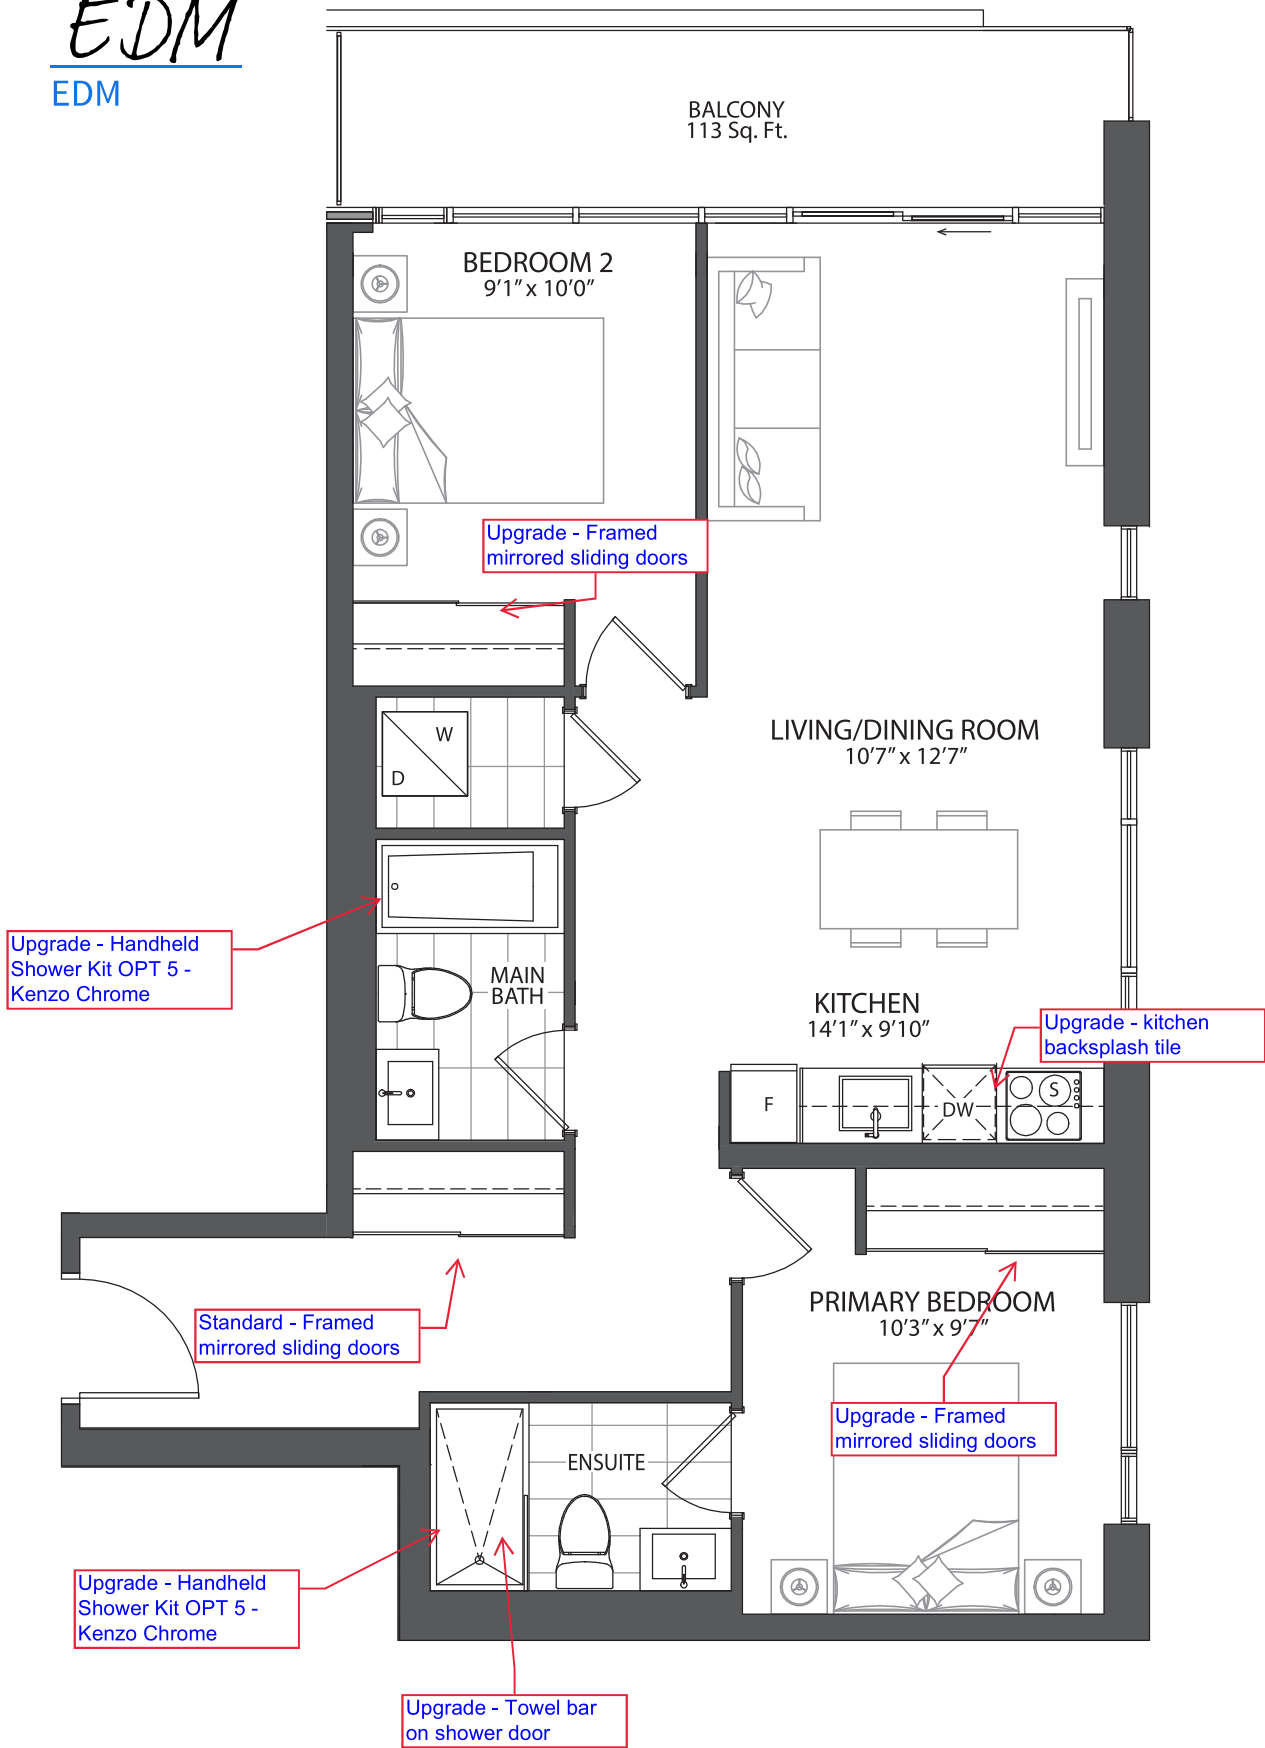