



SUITE 707

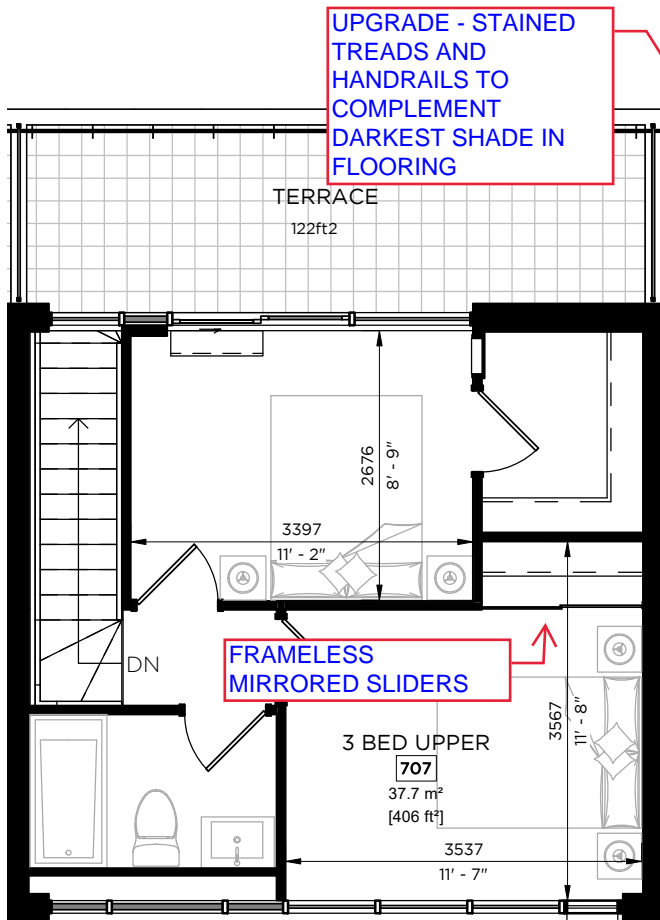


8TH FLOOR - UPPER

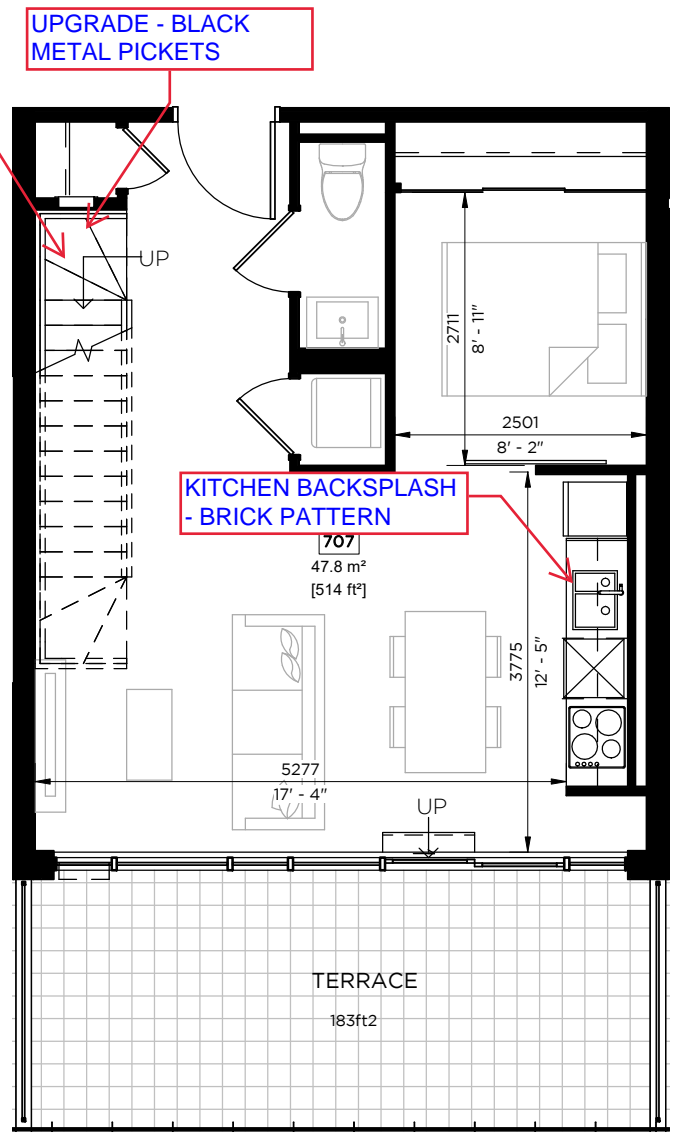

7TH FLOOR - LOWER



8TH FLOOR

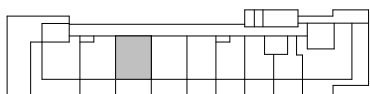

7TH FLOOR

Level #: _____

Unit #: _____

Purchaser Initials: _____ Date: _____

Vendor Initials: _____ Date: _____

3 BED
707

920ft² Indoor
+ 305ft² Outdoor

Dimensions, specifications, layouts and materials are approximate only and are subject to change without notice. Plans may be mirror image. Tile patterns may vary. Window size and location may vary. Actual usable floor space may vary from stated floor area. Bulkheads required for mechanical purposes such as kitchen and washroom exhausts and heating and cooling ducts have not been indicated.