
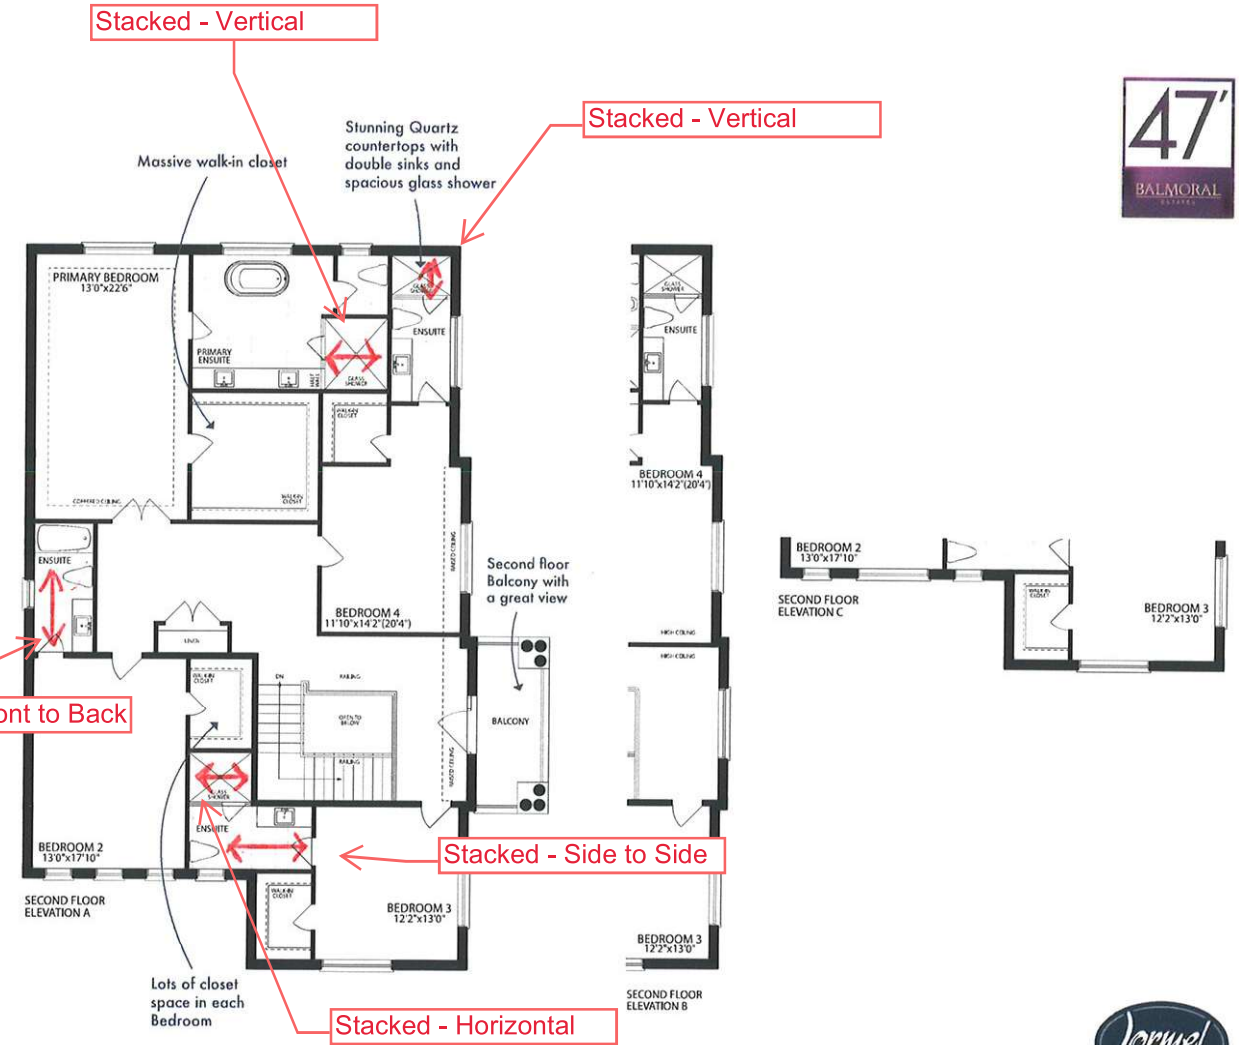


LOT 12, MANOR

TILE DIRECTION SKETCH

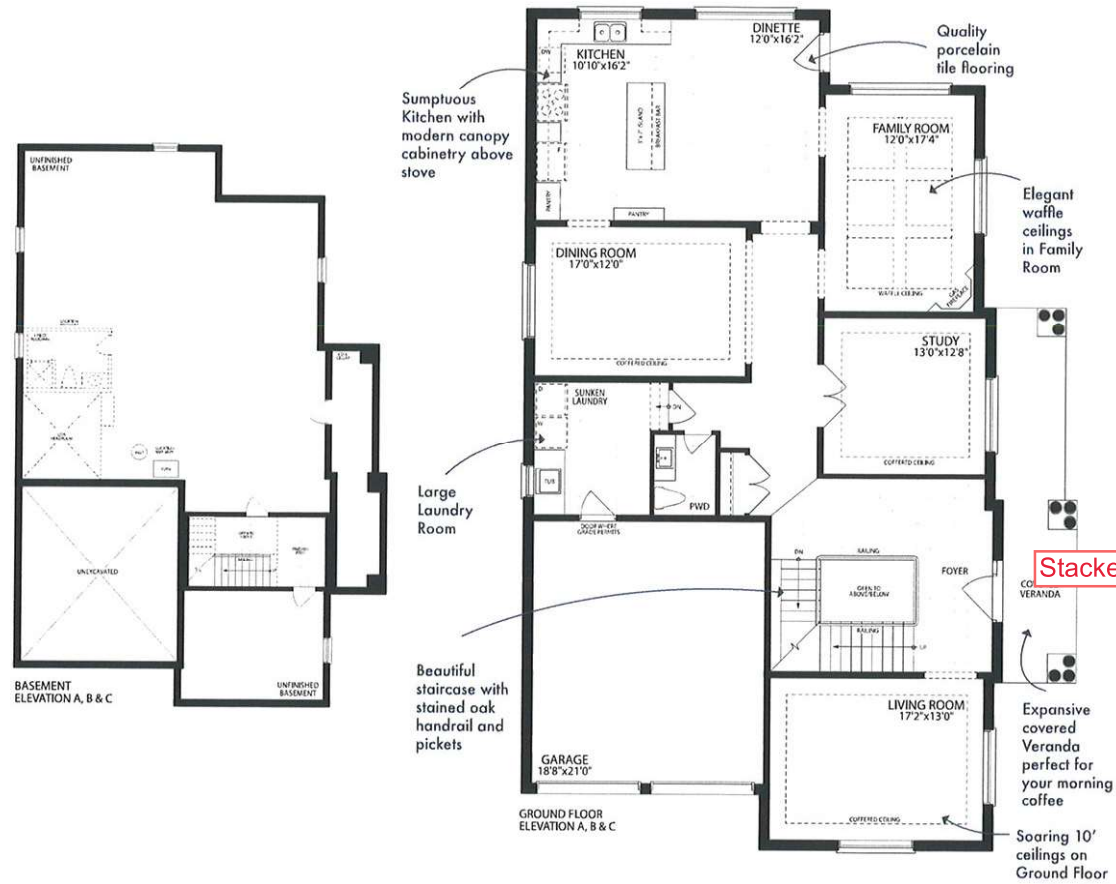

Note, standard areas that do not have a notation of directions, do not require any specific details - could be 24x24 or 8x8