


TILE DIRECTION SKETCH

LOT 11, CHATEAU MODEL

THE CHATEAU

ELEVATION C
4389 SQ-FT
with 53 sq. ft. of finished area in basement

ELEVATION A & B
4370 SQ-FT
with 53 sq. ft. of finished area in basement

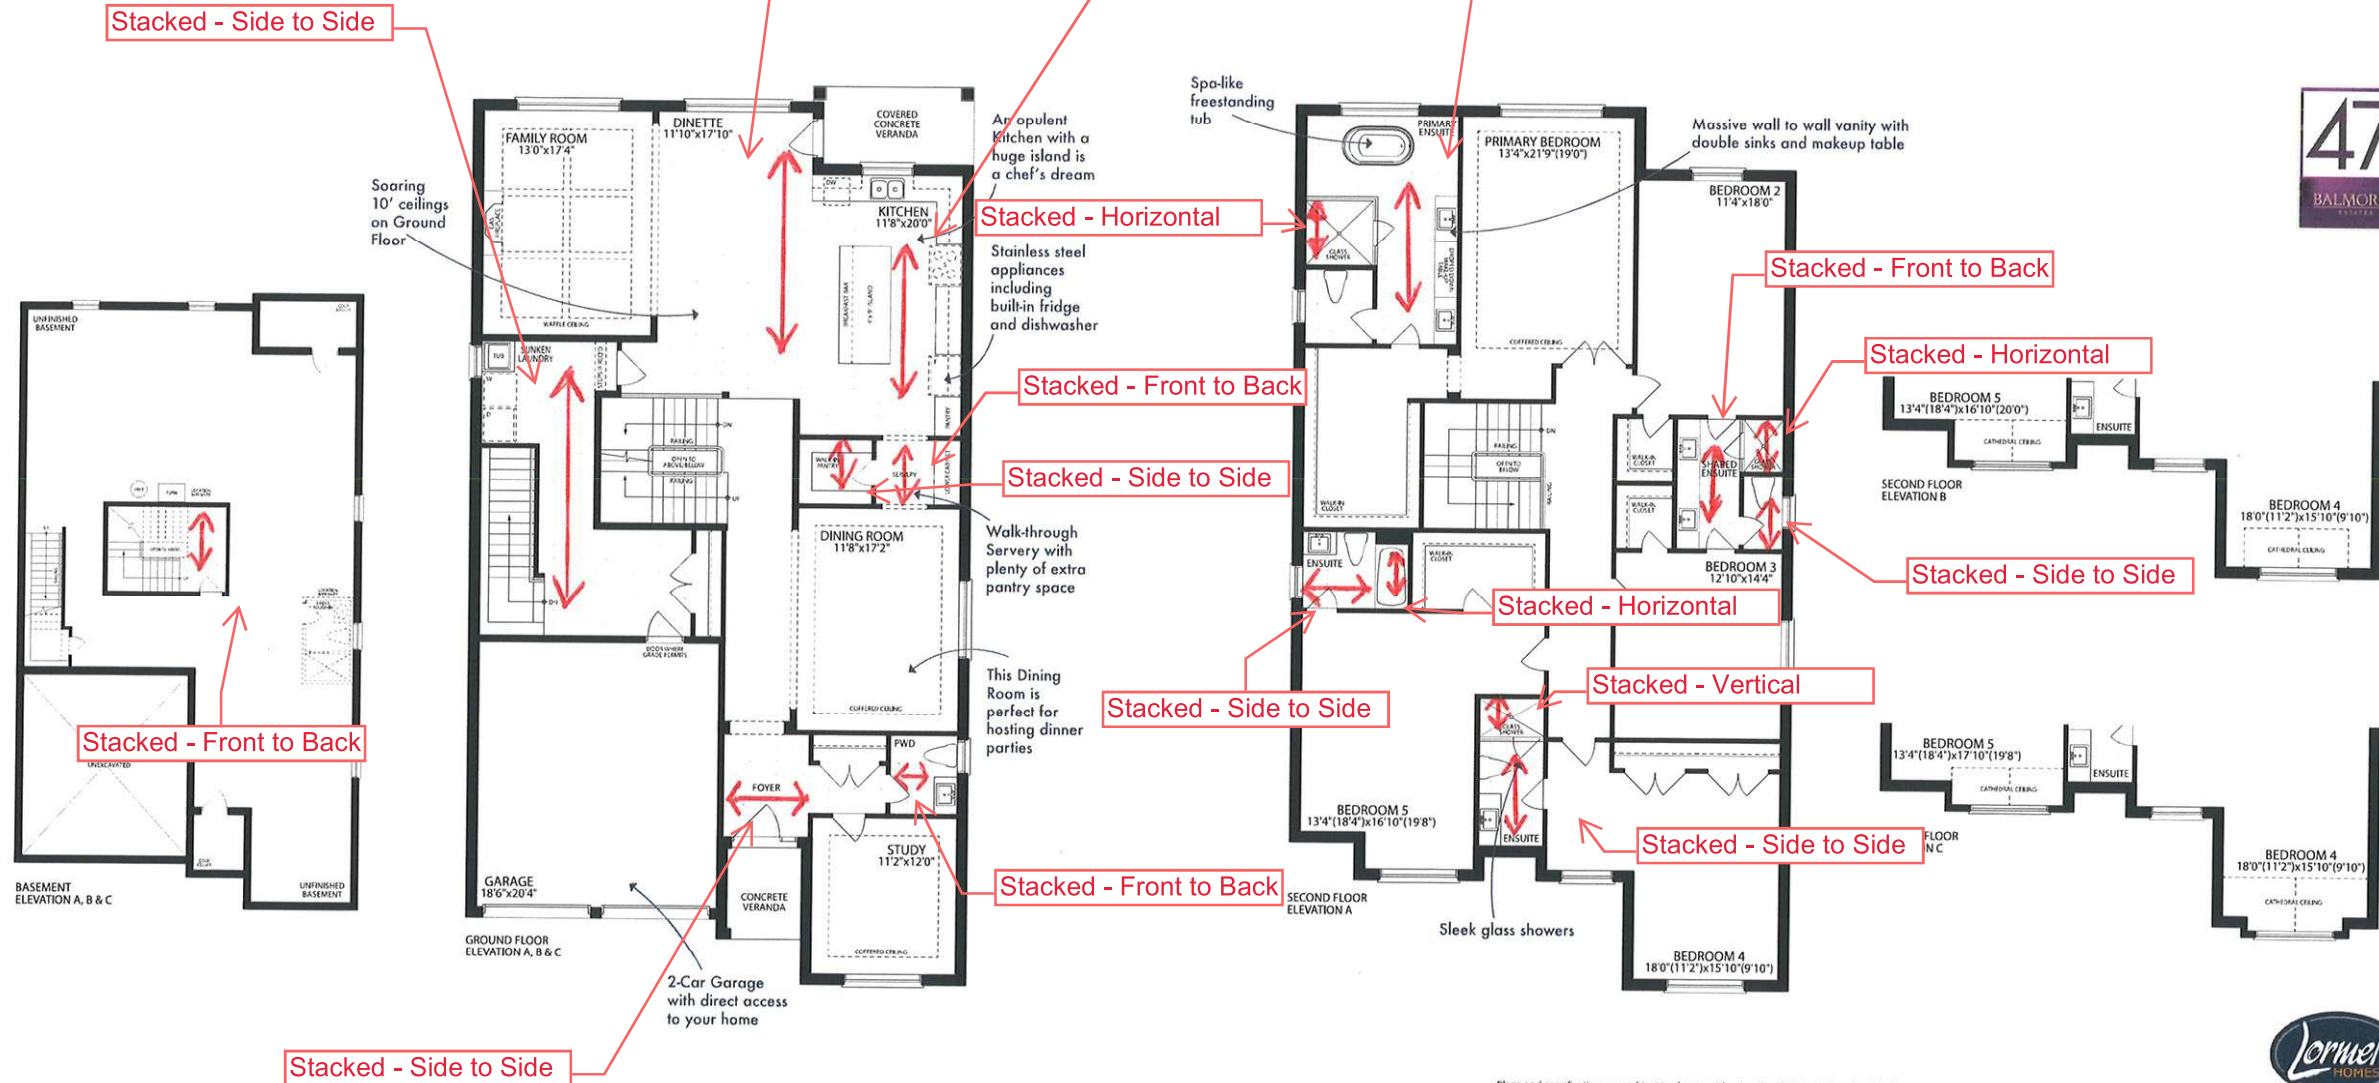

Plans and specifications are subject to change without notice. E. & O. E. Actual usable floor space may vary from the stated floor area. All renderings are artist's concept.