
KITHERY BASISPIAST LOT SO FC

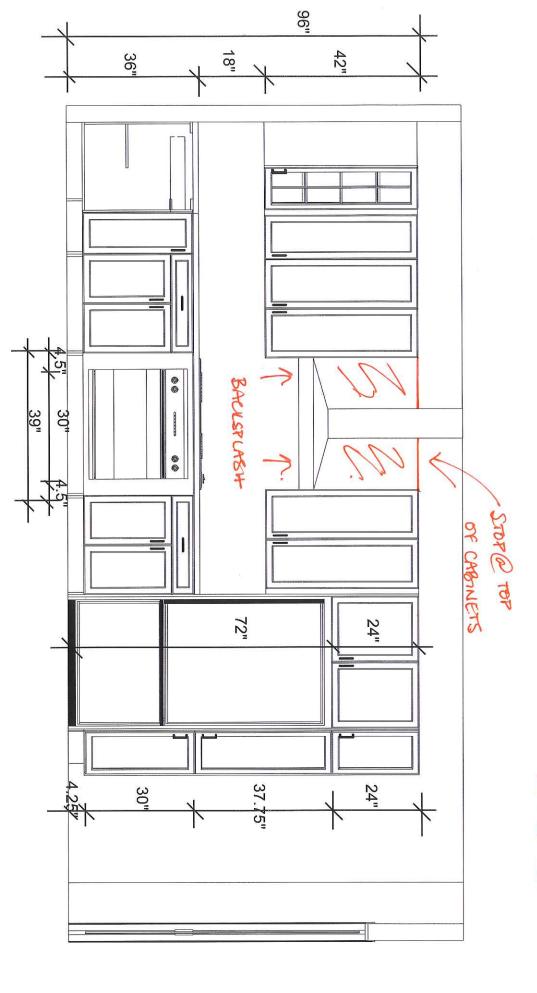

I have reviewed these drawings and understand the details of the layout and the Cartier Kitchens specifications.

Signature

CUSTOMER APPROVAL

STOVE / FRIDGE WALL ELEVATION

Drawn By: Lori D Saverio, B.I.D appearance of the design. It is not meant to be an exact rendition. interpretation of the general Note: This drawing is an artistic

20 20 Designed: 21/05/2014 Printed: 20/07/2014

חרם אלחבר מחפבועובמב מיייליי עובעום וייי Cartier Kitchens Ottawa

V 11