


AREA CHART ON PAGE 9

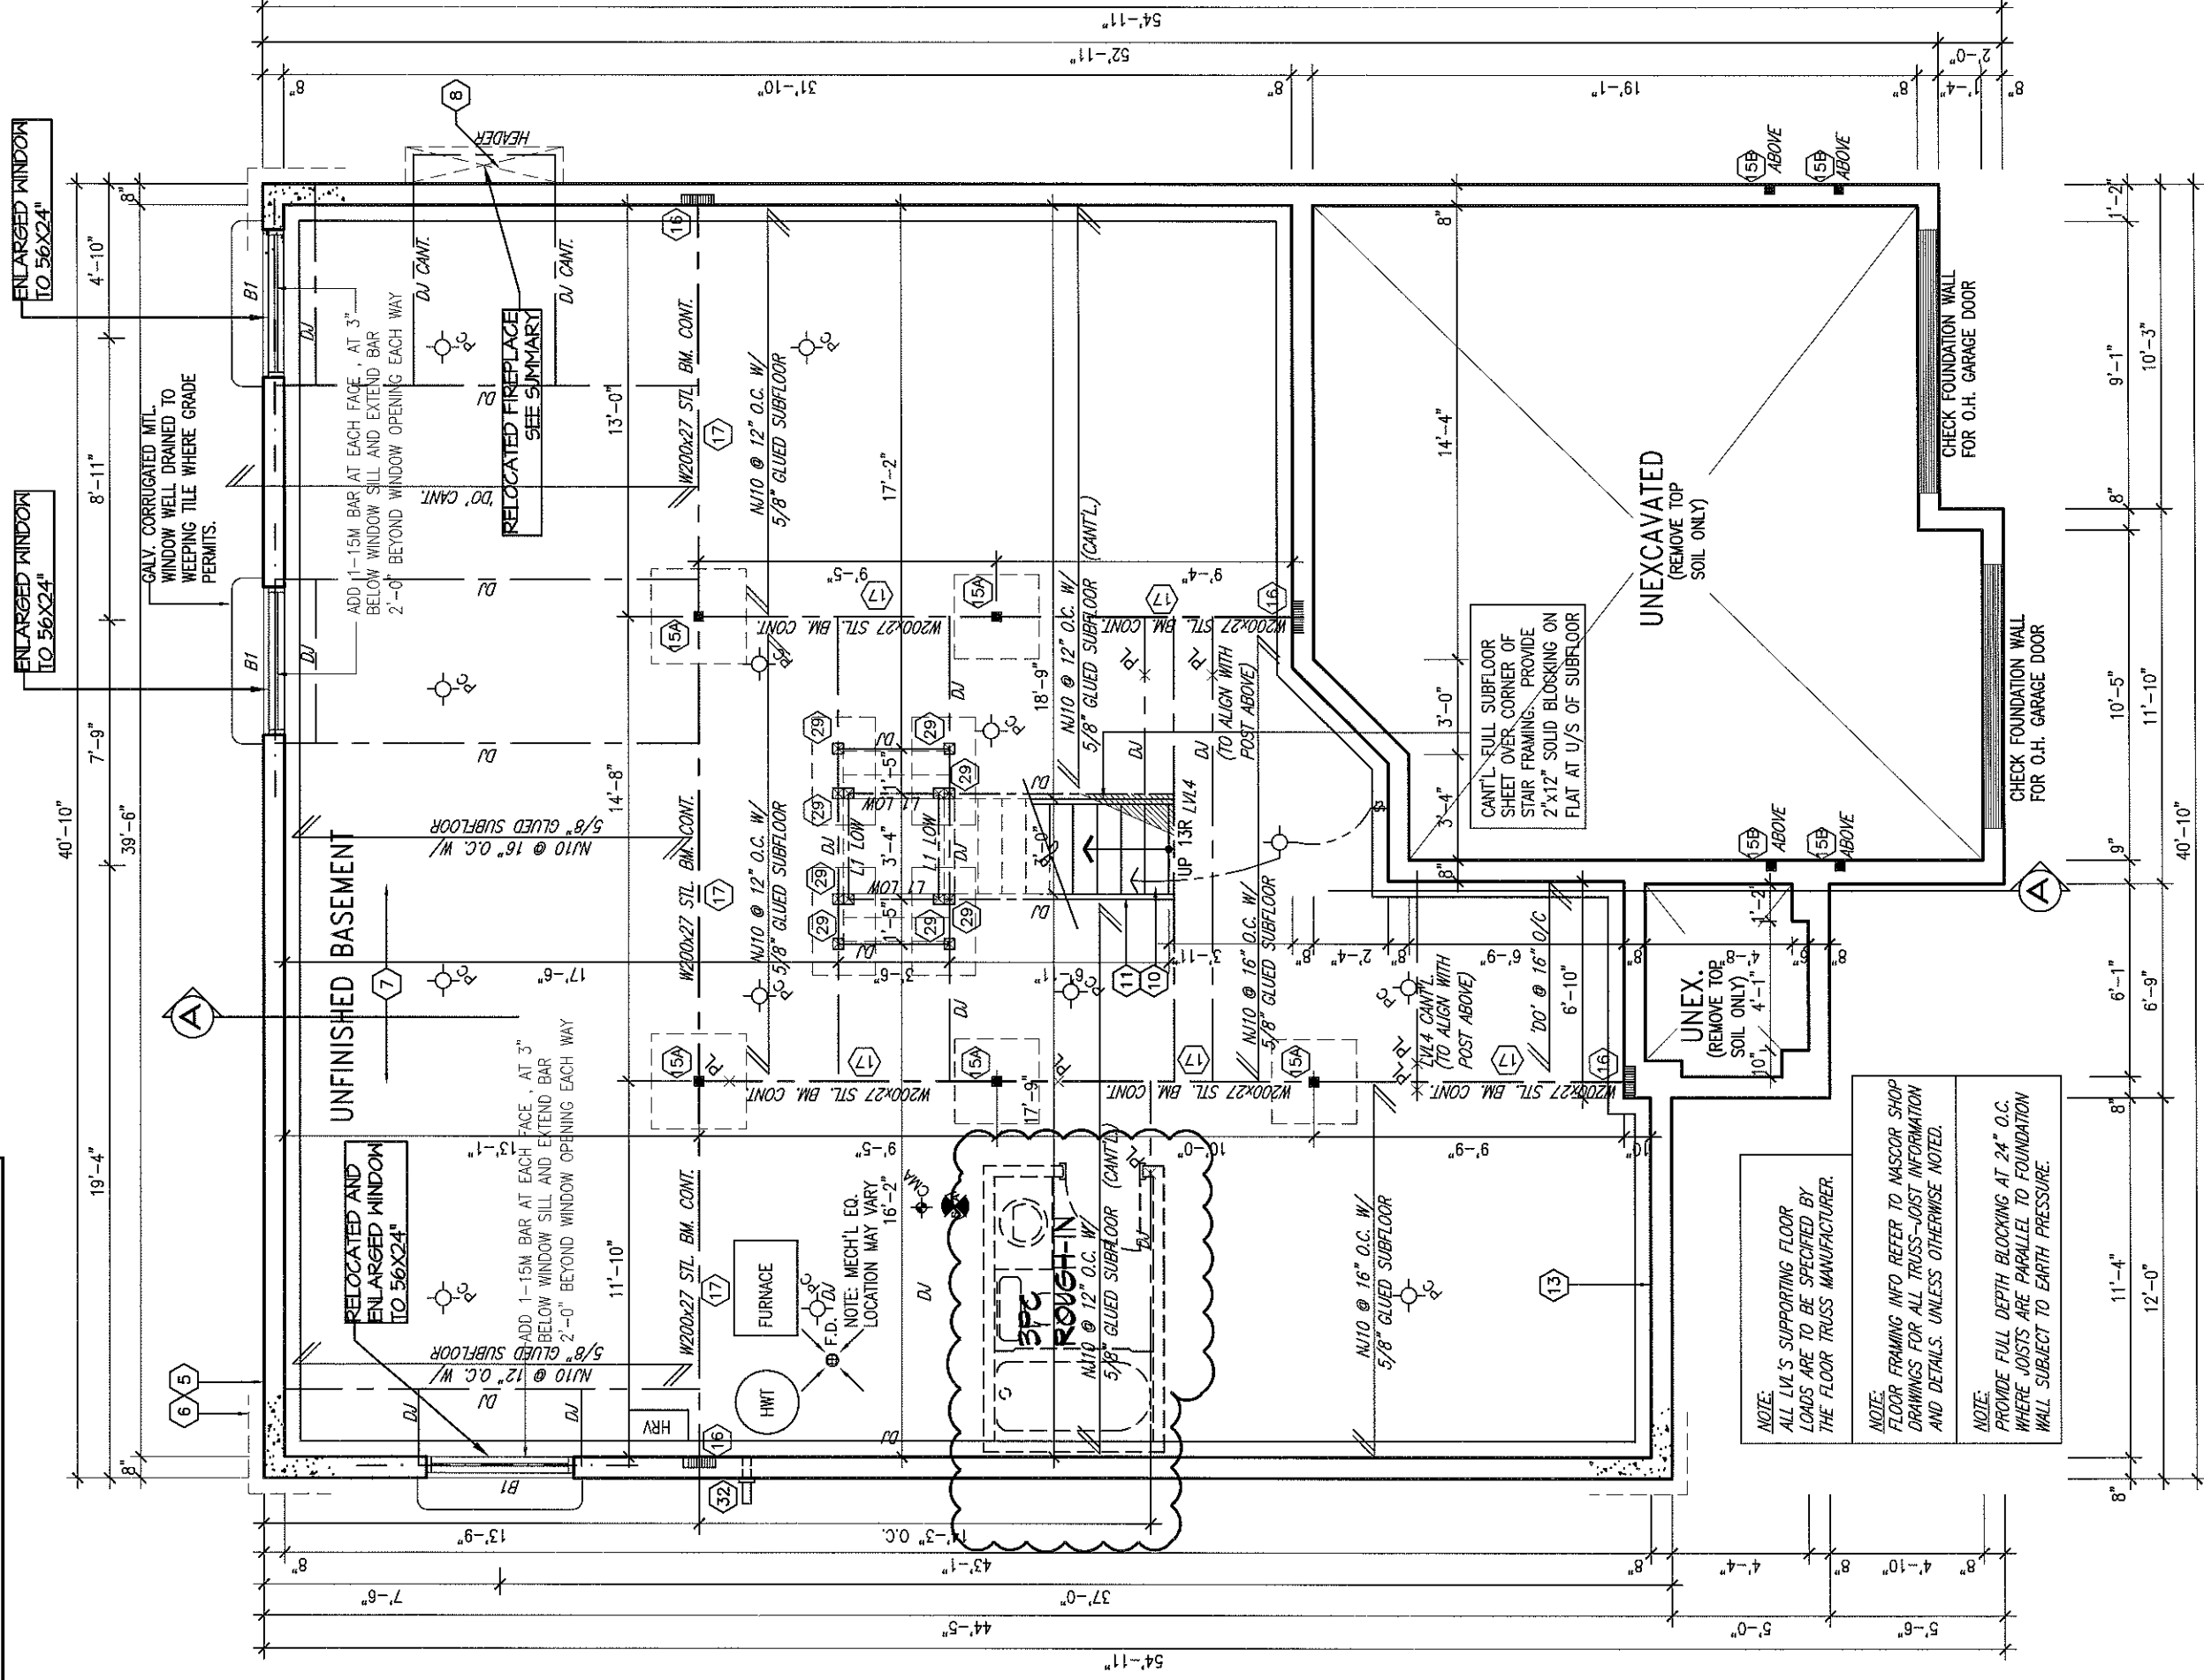


FOR B.E.P. ONLY

NOTE:
FLOOR JOIST LAY OUT WAS
REVISED TO MATCH NASCOR'S
LAYOUT FOR UNIT 511,
NASCOR JOB #. 006-00762
/ 63 DATED 02-03-06.

NOTE: PROVIDE 2-TOP TOP AND BOTTOM
BARS ALL AROUND FOUNDATION WALLS
(UNLESS NOTED OTHERWISE)

BASEMENT PLAN "B"

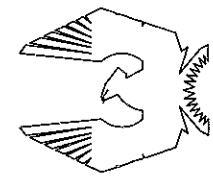

PHOENIX HOMES

Viljoen
Architect
Inc.

300 A Wilson Avenue
North York, Ontario
M3H 1S8
TEL: (416) 630-2255
FAX: (416) 630-4782

SITE: FERNBANK

LOT NUMBER: 103

CIVIC ADDRESS:
68 GINSENG TERRACE

YARMOUTH-2007-B

2 ISSUED FOR B.E.P. ONLY
1 ISSUED FOR B.E.P. ONLY

JUL16-14
JUL17-14

SD
SD

No. Description
Date

By

REVISIONS

footprint:	511
site title:	BASEMENT PLAN-B
drawn by:	PT
checked by:	VC/EM
date:	SEPT. 2005
scale:	3/16"=1'
sheet no:	2B
total sheets:	9