

DCR PHOENIX HOMES

LOT 136

HAMILTON 43-7

KITCHEN & VANITIES

MOUNTING HT: 90



- CABINETS: CARTIER LINE 3
- HARDWARE: STD & 1ST UPGRADE
- STD WHITE INTERIORS
- METAL DRWR BOX
- 4 PCS - 5/8" KICK
- 2 PCS LOOSE FILLER
- 2 PCS C MOULD
- 1 PC T MOULD
- 4 PCS LARGE VENEER CROWN

CUSTOMER APPROVAL


I have reviewed these drawings and understand the details of the design and the Cartier Kitchens specifications

Signature 

Date Oct. 22/15

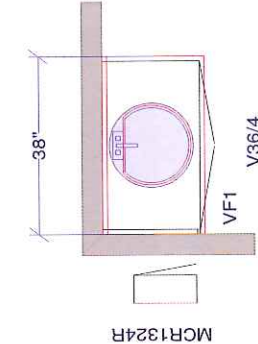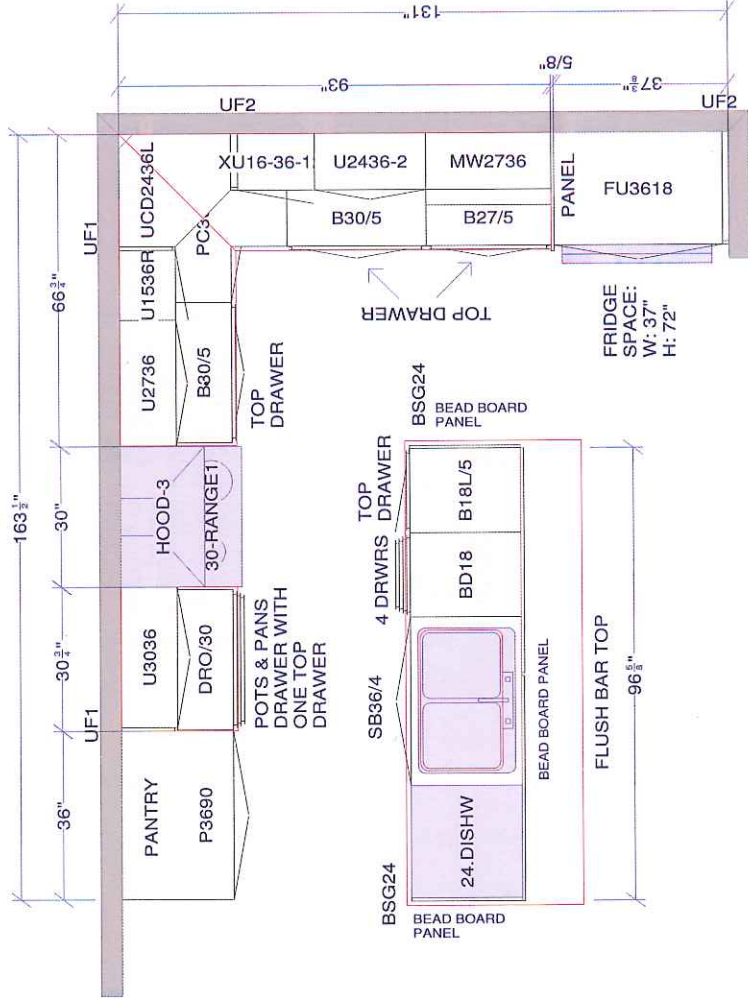

MAIN BATHROOM

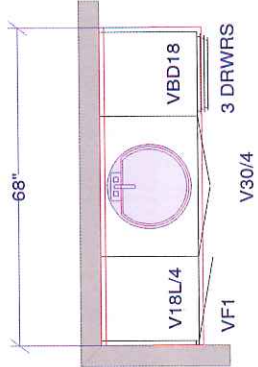

ENSUITE BATHROOM

All dimensions, size designations given are subject to verification on job site and adjustment to fit job conditions.	 	Spectrum Kitchen Bath Design 430 Hazeldean Rd. Unit 2 P:613-521-6966 F:613 521-1617	Designed: 10/19/2015 Printed: 10/19/2015
Lot 136 - DCR FC	All	Drawing #: 1	No Scale

3D KITCHEN VIEW #1 DCR PHOENIX - LOT 136 FERNBANK CROSSING

Note: This drawing is an artistic interpretation of the general appearance of the design. It is not meant to be an exact rendition.




Designed: 10/19/2015
Printed: 10/19/2015

I have reviewed these drawings and understand the details of the design and the Carter Kitchens specifications

CUSTOMER APPROVAL


Signature *fu*

Date *04.22/15*

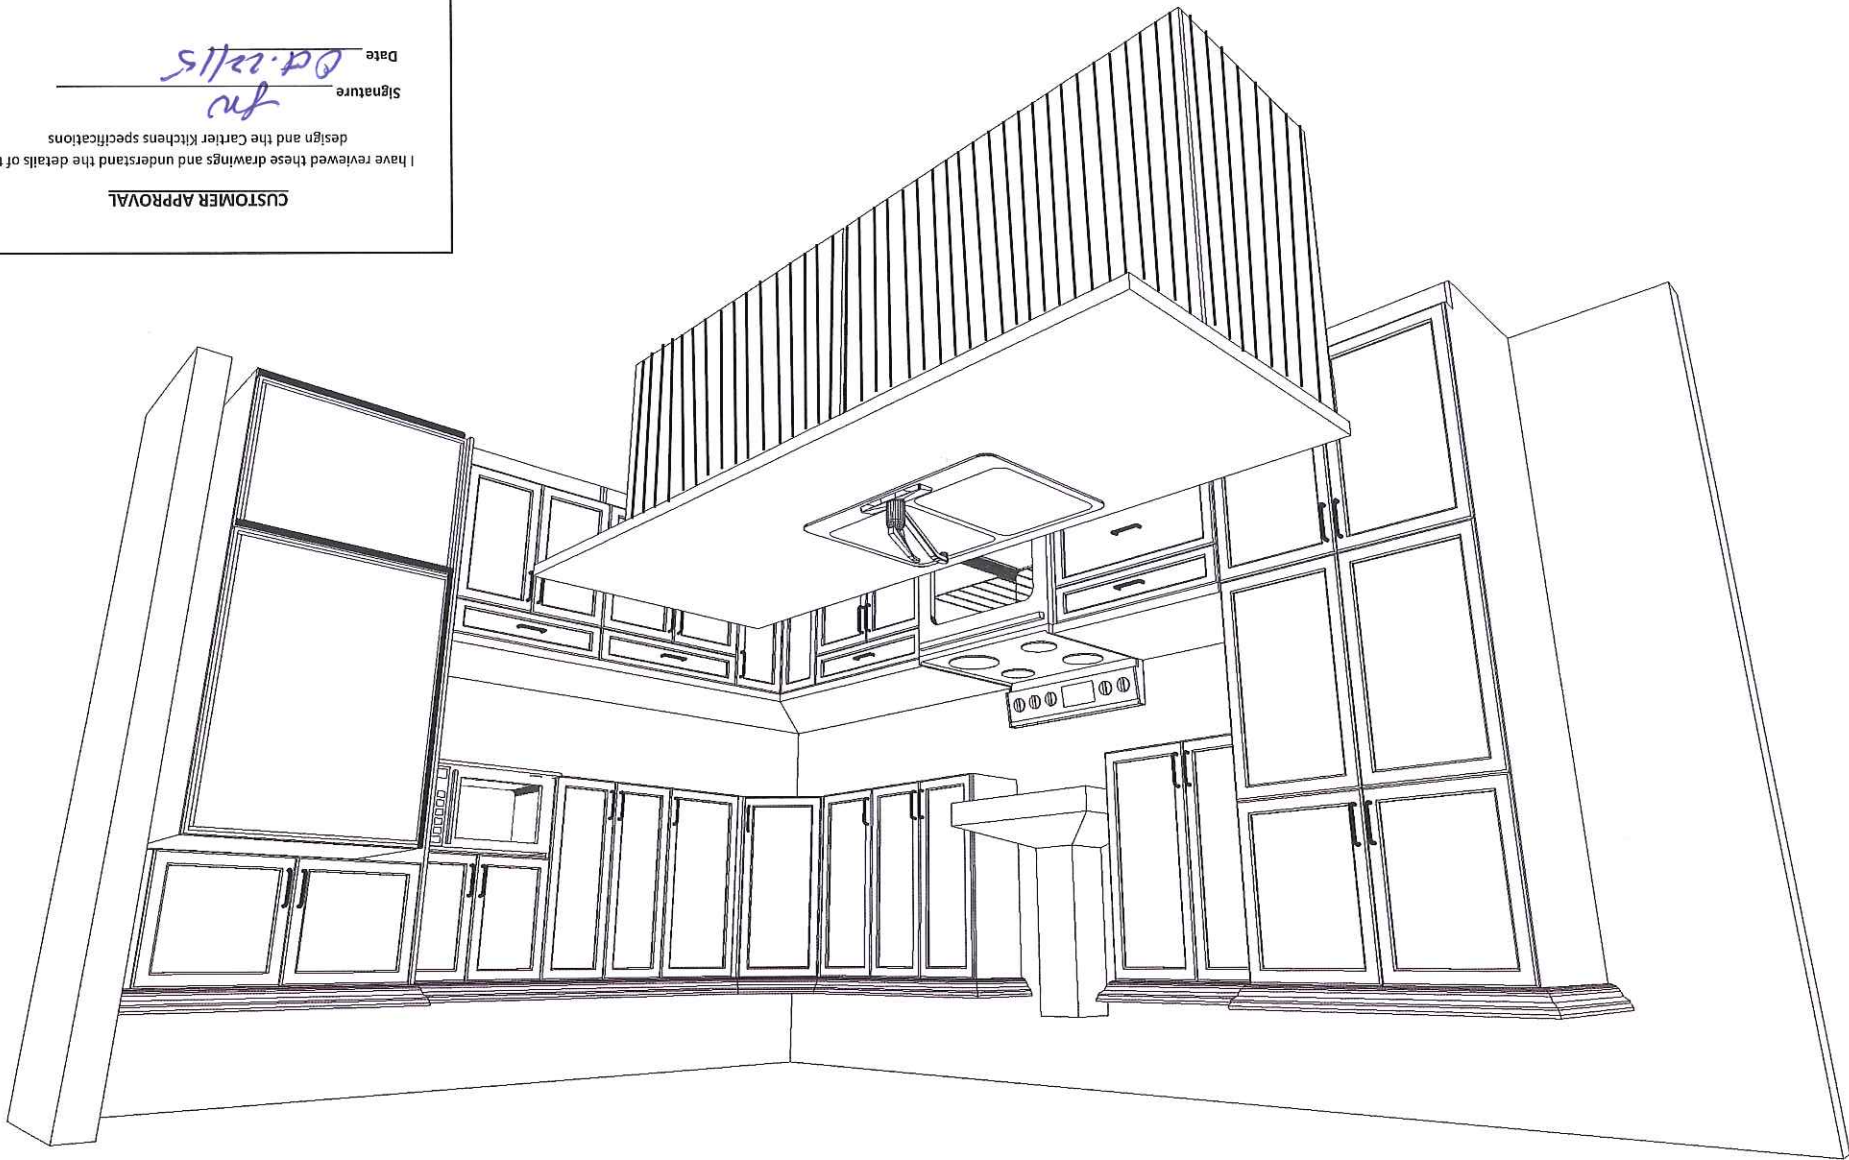

3D KITCHEN VIEW #2

DCR PHOENIX - LOT 136 FERNBANK CROSSING

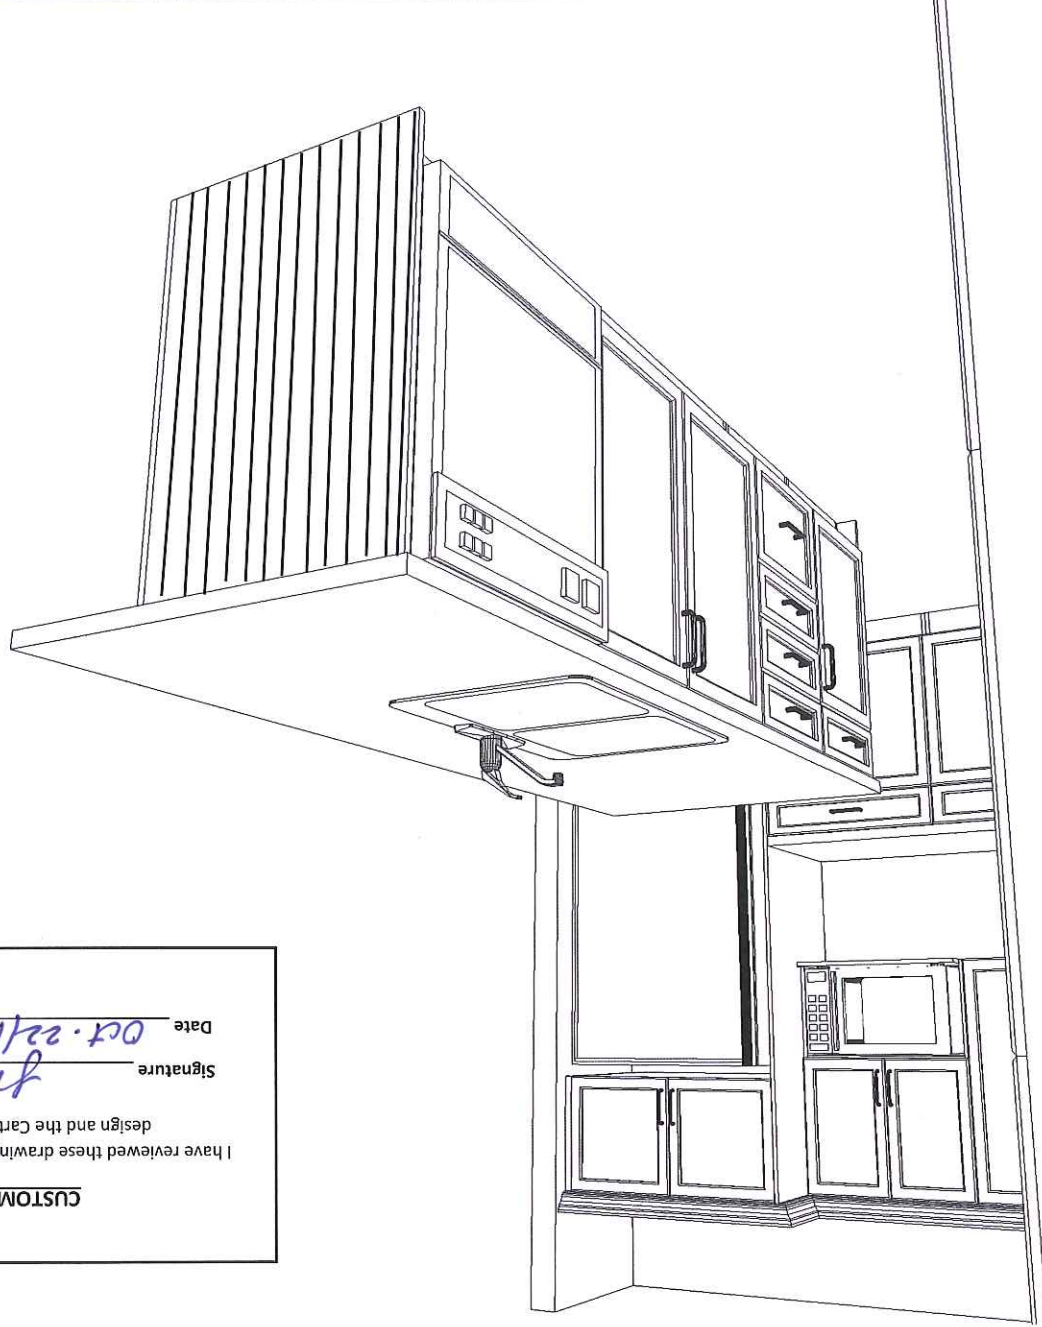

Note: This drawing is an artistic interpretation of the general appearance of the design. It is not meant to be an exact rendition.




Designed: 10/19/2015
Printed: 10/19/2015

CUSTOMER APPROVAL

I have reviewed these drawings and understand the details of the design and the Cartier kitchens specifications

Signature *fu*
Date *Oct. 22/15*

DCR PHOENIX - LOT 136 FERNBANK CROSSING
3D KITCHEN VIEW #3

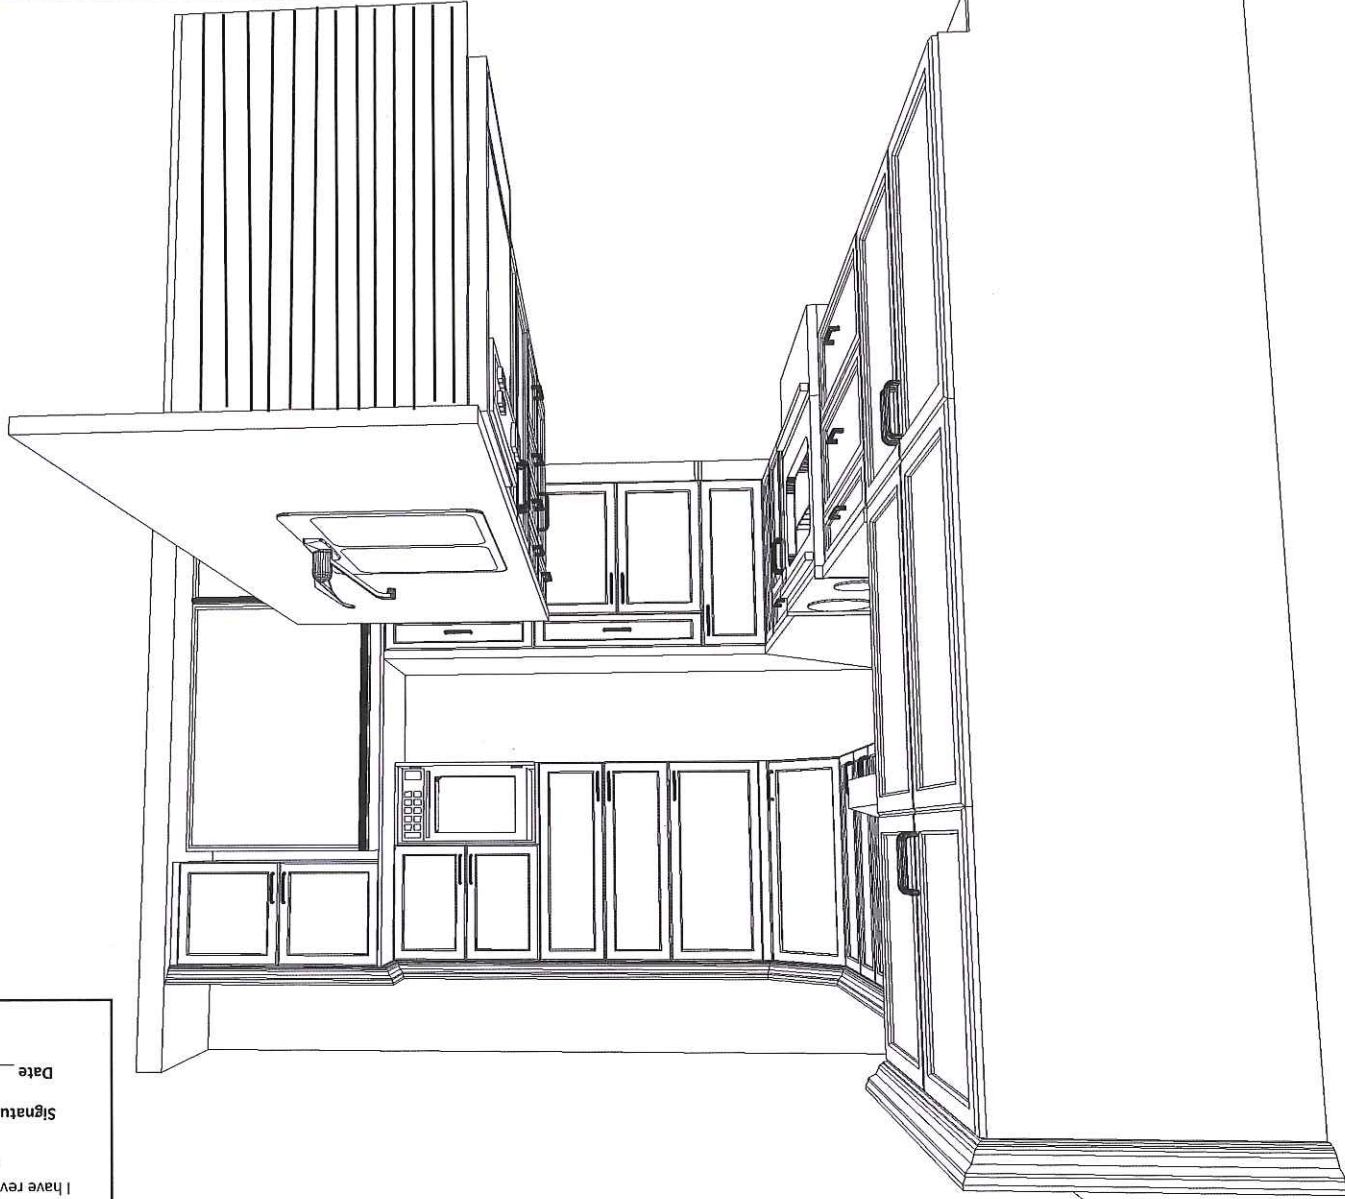

Note: This drawing is an artistic interpretation of the general appearance of the design. It is not meant to be an exact rendition.



Designed: 10/19/2015
Printed: 10/19/2015

CUSTOMER APPROVAL

I have reviewed these drawings and understand the details of the design and the Cartier Kitchens specifications

Signature *fw*


Date *07.22.15*

CUSTOMER APPROVAL

I have reviewed these drawings and understand the details of the design and the Carter Kitchens specifications

Signature for Date Oct. 22/15

STOVE WALL ELEVATION
DCR PHOENIX - LOT 136 FERNBANK CROSSING

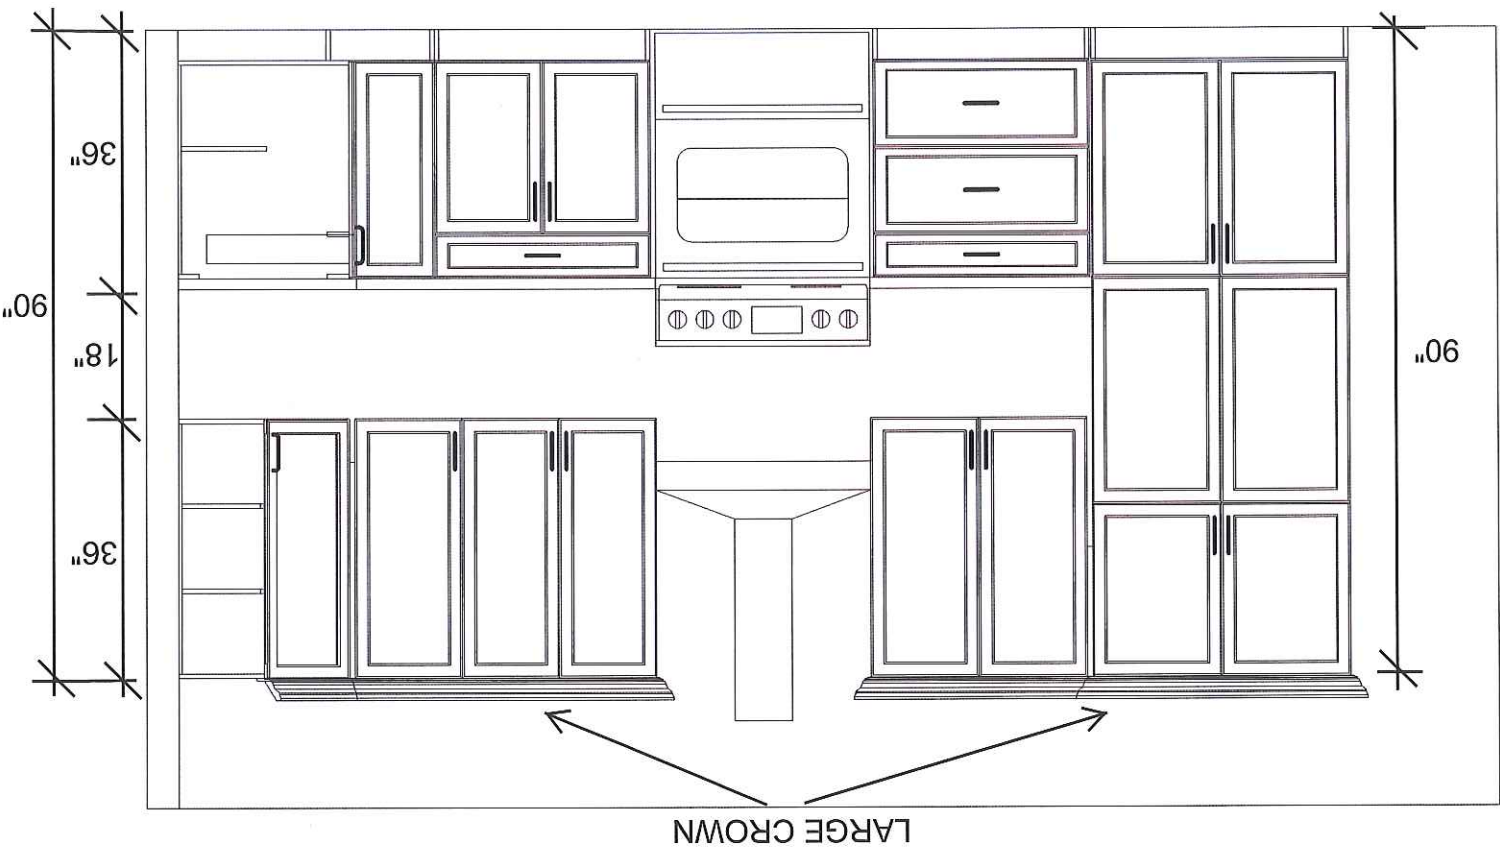

Note: This drawing is an artistic interpretation of the general appearance of the design. It is not meant to be an exact rendition.



CUSTOMER APPROVAL

I have reviewed these drawings and understand the details of the design and the Carter Kitchens specifications

Signature fu Date 04.22/15

Note: This drawing is an artistic interpretation of the general appearance of the design. It is not meant to be an exact rendition.


2020 TECHNOLOGIES

SPECTRUM SPECIAL SERVICES

Designed: 10/19/2015
Printed: 10/19/2015

DCR PHOENIX - LOT 136 FERNBANK CROSSING

FRIDGE WALL ELEVATION

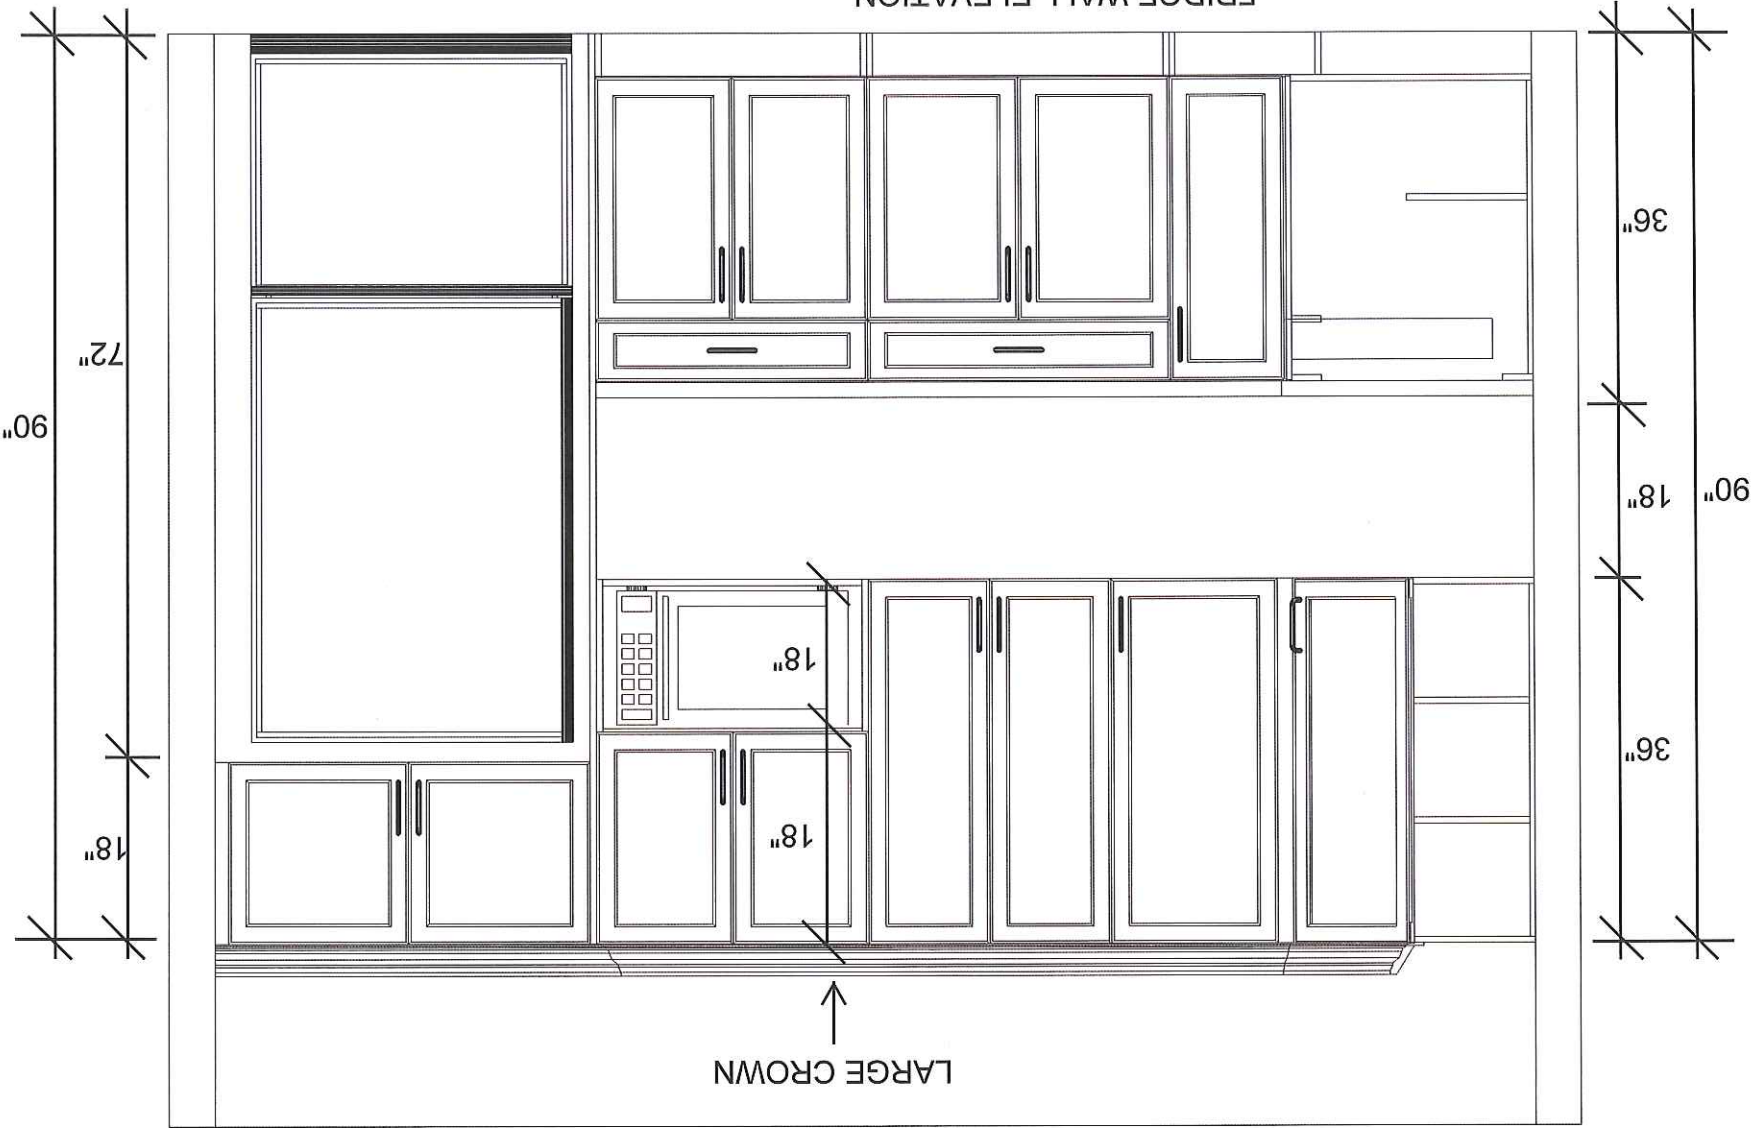


CUSTOMER APPROVAL

I have reviewed these drawings and understand the details of the design and the Cartier Kitchens specifications

Signature fu Date Oct. 22/15

ISLAND ELEVATION
DCR PHOENIX - LOT 136 FERNBANK CROSSING

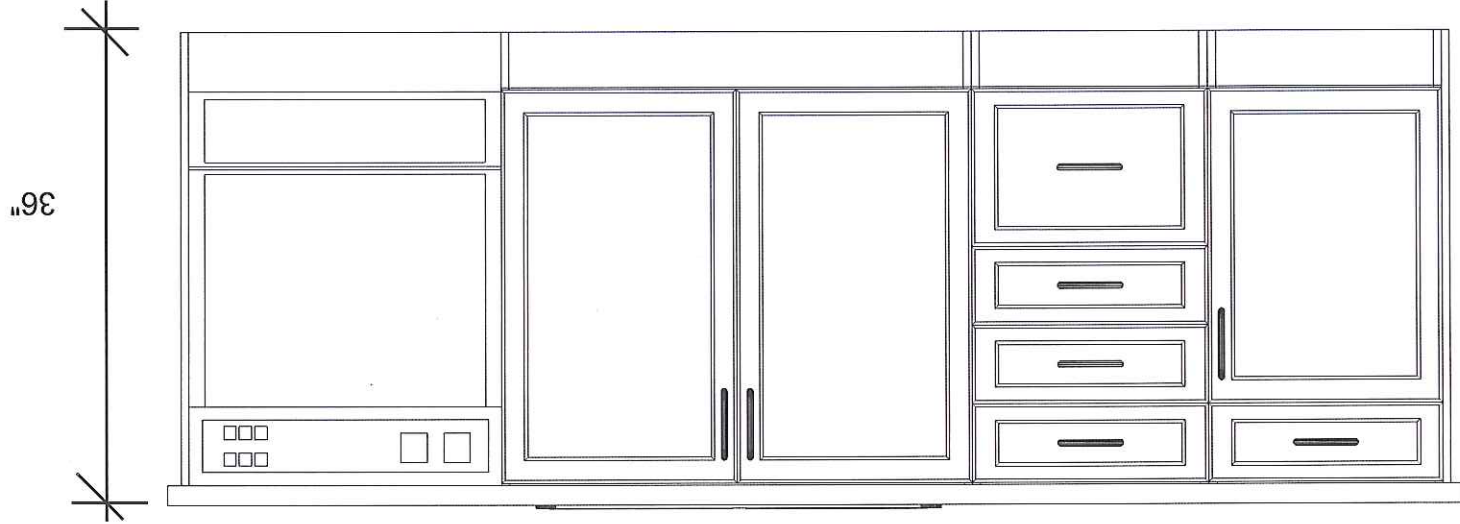

~~ENSUITE~~ **MAN BATH**

DCR PHOENIX - LOT 136 FERNBANK CROSSING

1 of 136 - DCR EC

All


Drawings # - 1

Note: This drawing is an artistic interpretation of the general appearance of the design. It is not meant to be an exact rendition.



Designed: 10/19/2015
Printed: 10/19/2015

for
08.22/15

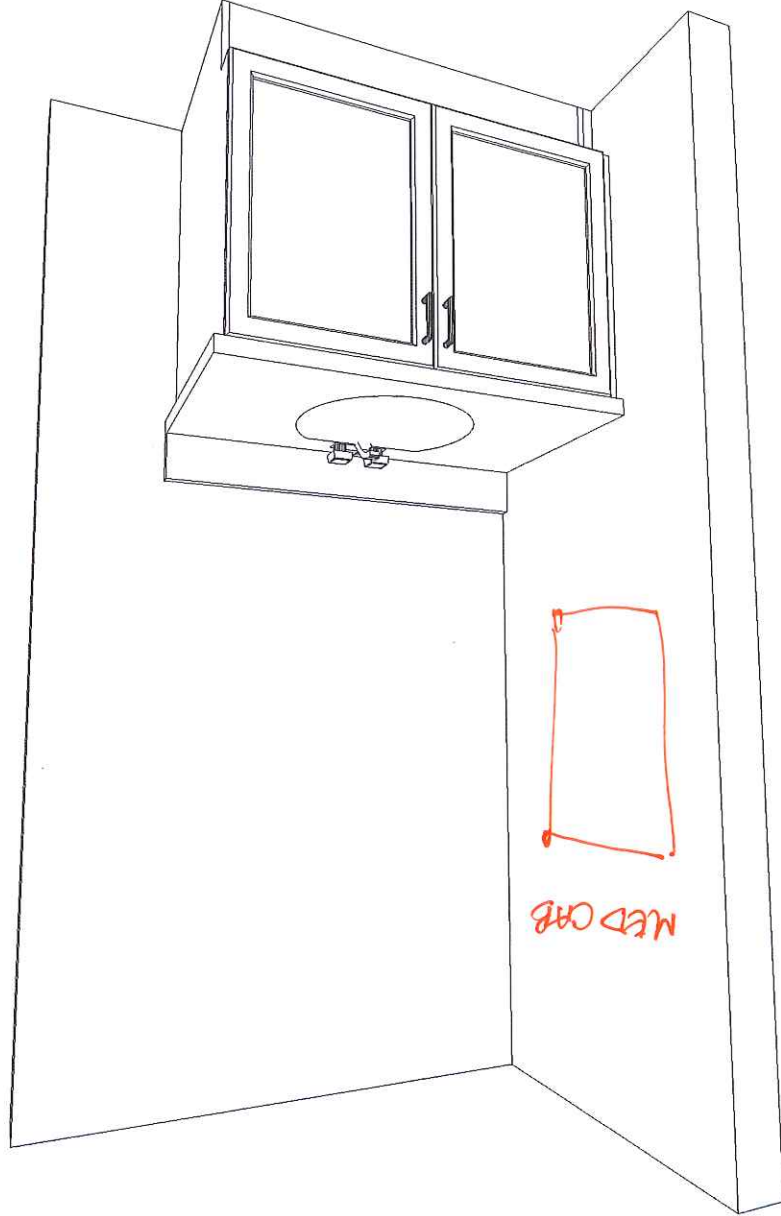

ENSUITE

DCR PHOENIX - LOT 136 FERNBANK CROSSING



Note: This drawing is an artistic interpretation of the general appearance of the design. It is not meant to be an exact rendition.



Designed: 10/19/2015
Printed: 10/19/2015

Drawings # - 1

All

1 of 136 - DCR EC

CUSTOMER APPROVAL

I have reviewed these drawings and understand the details of the design and the Cartier Kitchens specifications

Signature *fw*

Date *Oct. 22/15*