


DCR PHOENIX HOMES

LOT 126
FERNBANK CROSSING
MODEL - PLATINA (512)

KITCHEN

MOUNTING HEIGHT = 96

- LINE -
- HARDWARE -
- STANDARD WHITE INTERIOR
- METAL DRAWER BOX
- 4 PCS - KICK
- 2 PCS - 90 DEG. CORNER MOULD
- 1 PCS T-MOULD
- ~~5 PCS LARGE CROWN~~
- ~~SOFT CLOSE DOORS & DRAWERS~~

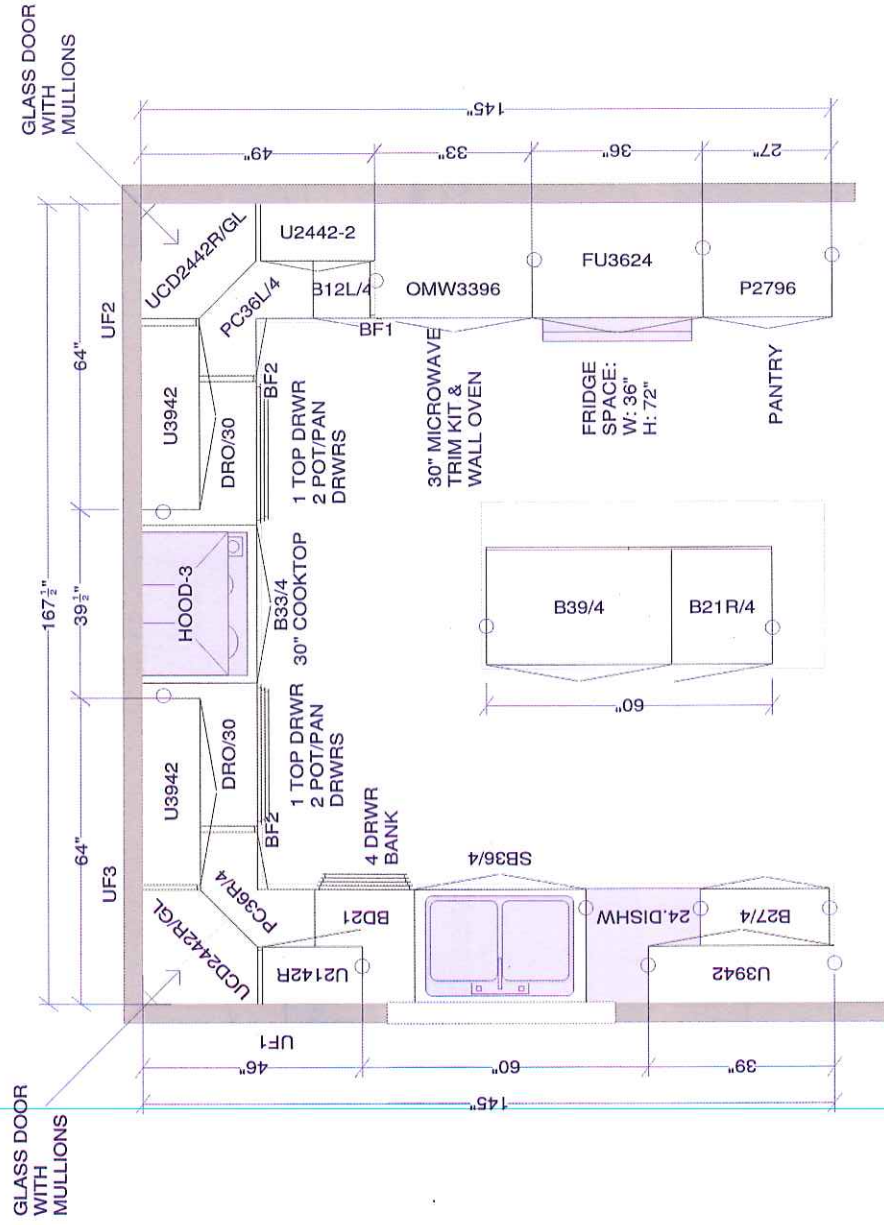

CUSTOMER APPROVAL

I have reviewed these drawings and understand the details of the design and the Cabinet/Kitchen specifications.

Signature: *[Signature]*
Date: *Sep. 9/15*

All dimensions, size designations given are subject to verification on job site and adjustment to fit job conditions.



SPECTRUM KITCHENS
430 HAZELDEAN RD UNIT 2
613 521-6966

Designed: 7/8/2015
Printed: 7/8/2015

DCR - LOT 126 FERNBANK CROSSING

ALL

Drawing #: 1 | No Scale.

CUSTOMER APPROVAL

I have reviewed these drawings and understand the details of the design and the Cartier Kitchens specifications

Signature [Signature] Date Sep 9/15

Drawing #: 1	All	DCR - LOT 126 FERNBANK CROSSING
Designed: 7/8/2015 Printed: 7/8/2015	 	SPECTRUM KITCHENS Note: This drawing is an artistic interpretation of the general appearance of the design. It is not meant to be an exact rendition.

DCR LOT 126 FERNBANK CROSSING
3D KITCHEN VIEW #1



No Crown

DCR - LOT 126 FERNBANK CROSSING		All	Drawing #: 1
Note: This drawing is an artistic interpretation of the general appearance of the design. It is not meant to be an exact rendition. SPECTRUM KITCHENS			Designed: 7/8/2015 Printed: 7/8/2015

DCR LOT 126 FERNBANK CROSSING
3D KITCHEN VIEW #2

CUSTOMER APPROVAL

I have reviewed these drawings and understand the details of the design and the kitchen specifications

Signature _____

Date Sept. 5/15

NO crown



I have reviewed these drawings and understand the details of the design and the Carrier Kitchen's specifications

Signature [Signature] Date Sep. 9/15

CUSTOMER APPROVAL

DCR LOT 126 FERNBANK CROSSING
3D KITCHEN VIEW #3



Note: This drawing is an artistic interpretation of the general appearance of the design. It is not meant to be an exact rendition.

SPECTRUM KITCHENS



Drawing #: 1


All


DCR - LOT 126 FERNBANK CROSSING

Designed: 7/8/2015
Printed: 7/8/2015

CUSTOMER APPROVAL

I have reviewed these drawings and understand the details of the design and the Carter Kitchens specifications

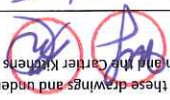Signature  Date Sep. 9/15

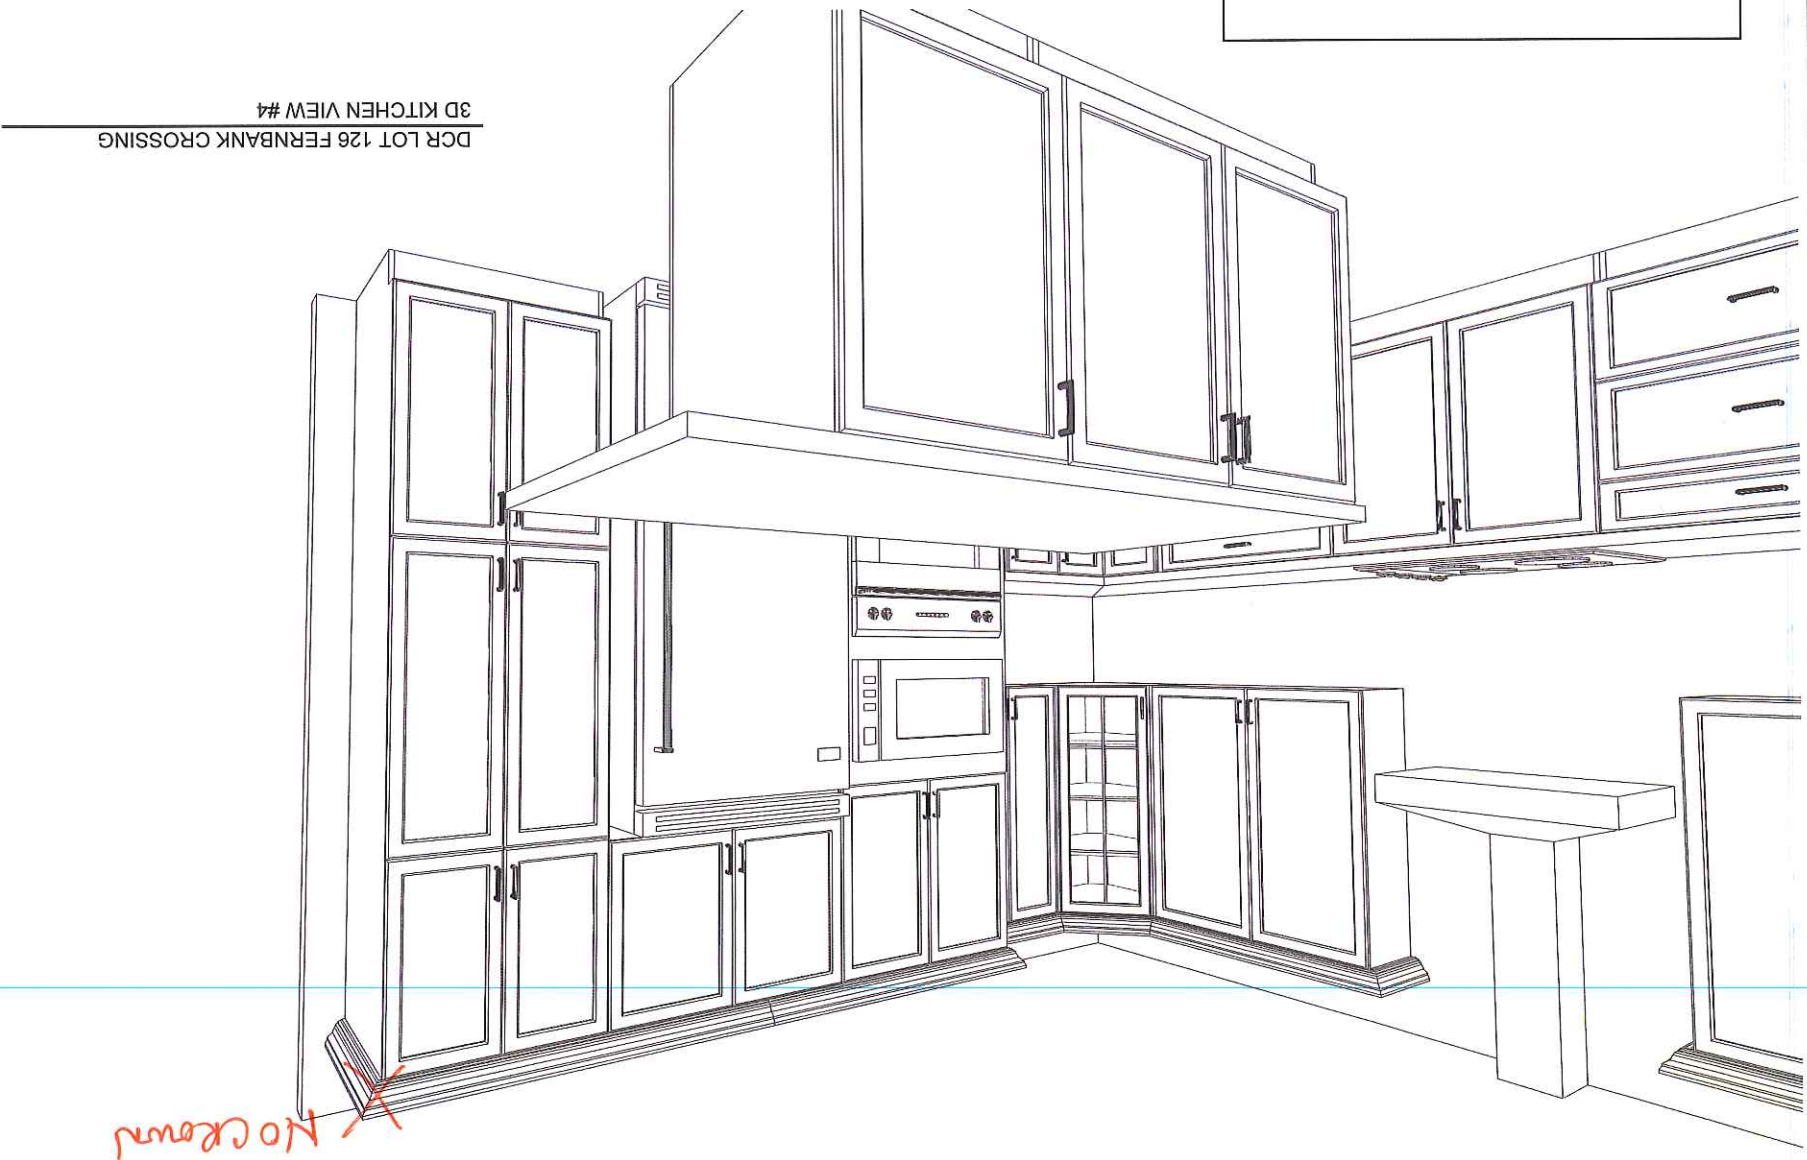

DCR LOT 126 FERNBANK CROSSING
3D KITCHEN VIEW #4

No Crown

I have reviewed these drawings and understand the details of the design and the Carrier Kitchens specifications

Signature _____

Date Sept. 9/15

CUSTOMER APPROVAL

DCR - LOT 126 FERNBANK CROSSING

SPECTRUM KITCHENS

Note: This drawing is an artistic interpretation of the general appearance of the design. It is not meant to be an exact rendition.




Designed: 7/8/2015

Printed: 7/8/2015

Drawing #: 1

DCR LOT 126 FERNBANK CROSSING

SINK WALL ELEVATION

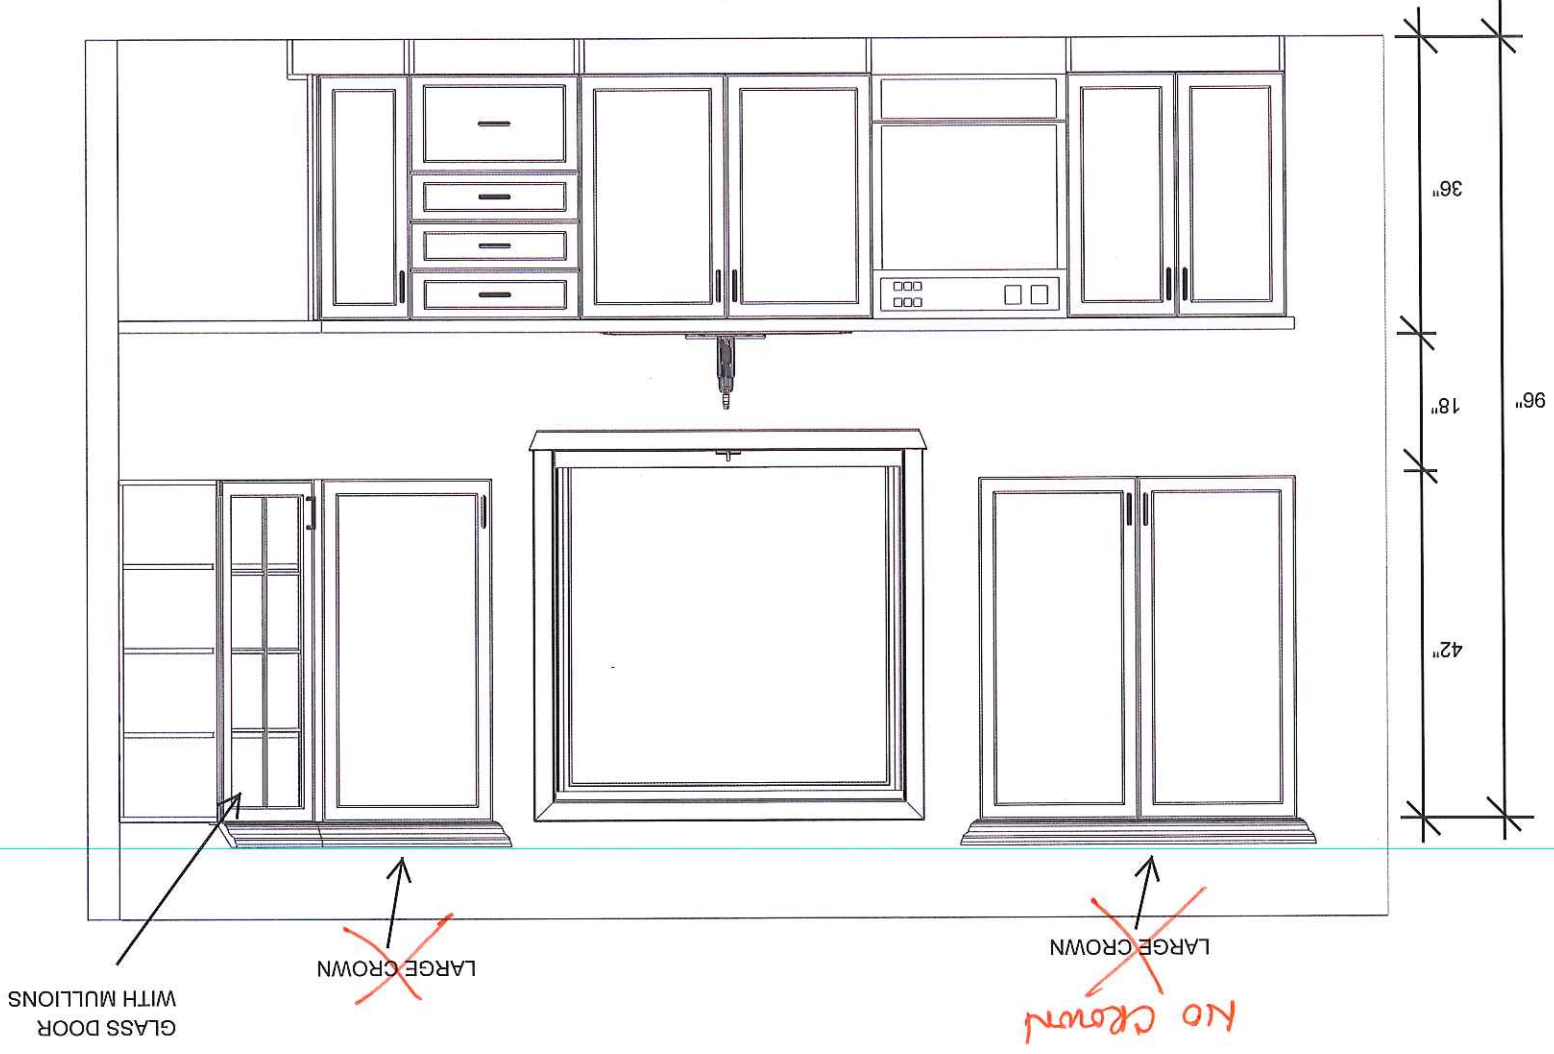


I have reviewed these drawings and understand the details of the design and the Carver Kitchen specifications

Signature [Signature] Date 8/9/15

CUSTOMER APPROVAL

DCR LOT 126 FERNBANK CROSSING
COOKTOP WALL ELEVATIONS

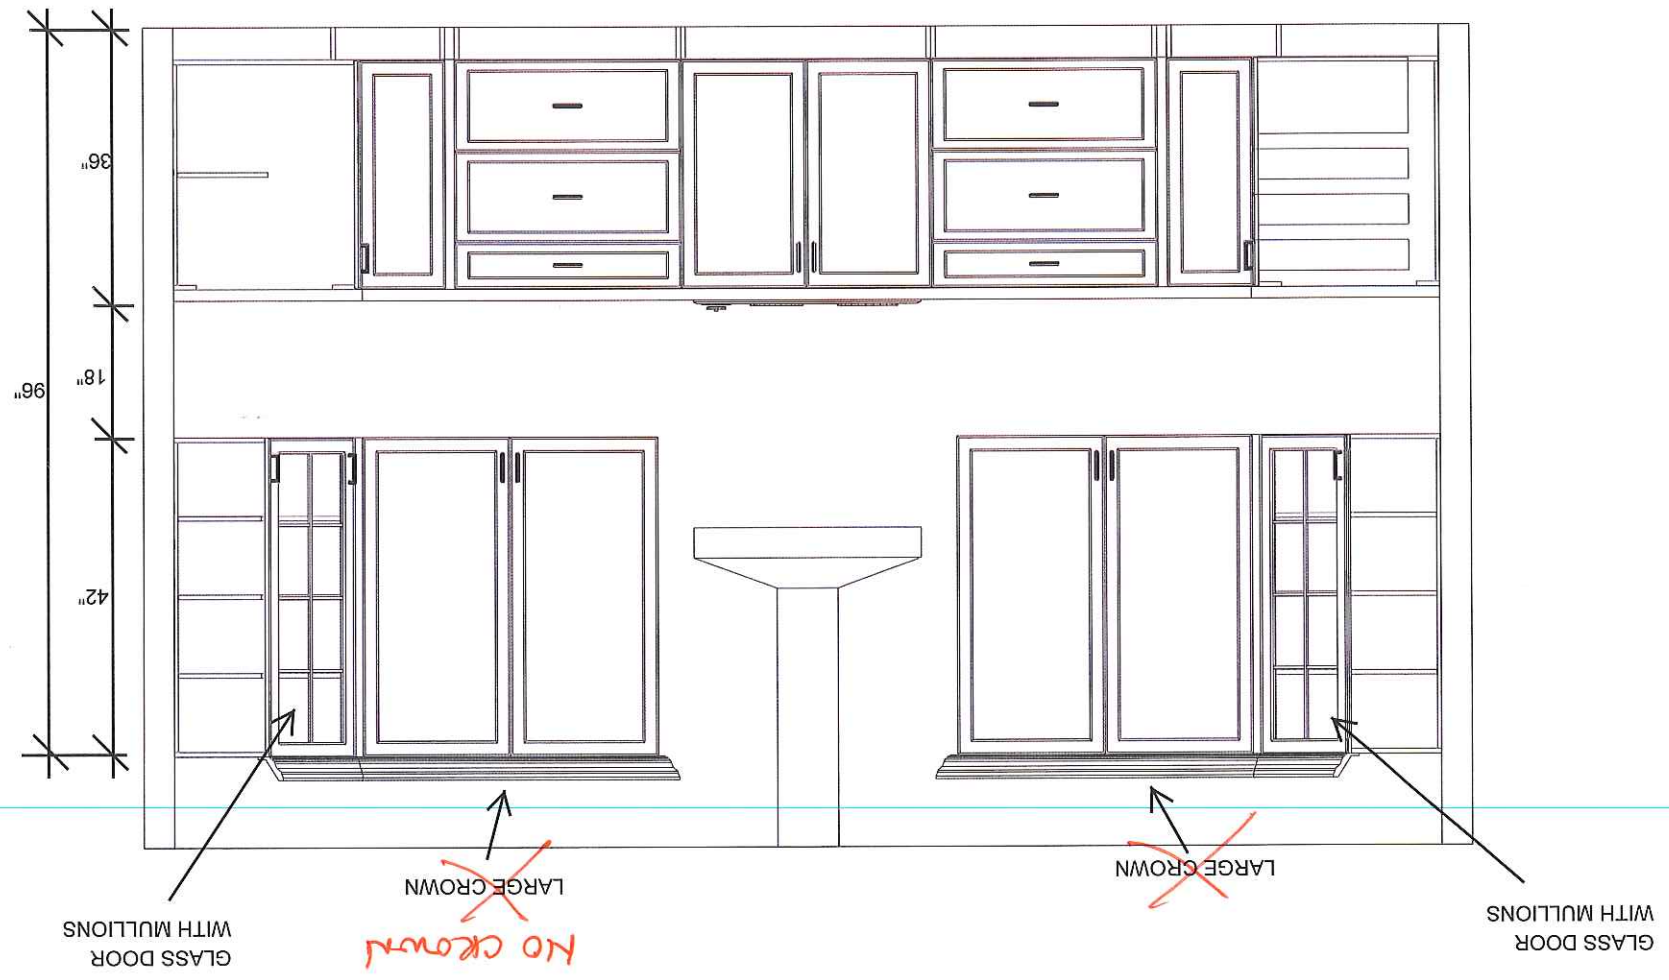

Note: This drawing is an artistic interpretation of the general appearance of the design. It is not meant to be an exact rendition.

SPECTRUM KITCHENS




I have reviewed these drawings and understand the details of the design and the Carter Kitchen's specifications

Signature *[Signature]*

Date *Sep 9/15*

CUSTOMER APPROVAL

DCR LOT 126 FERNBANK CROSSING
FRIDGE / OVEN WALL ELEVATION

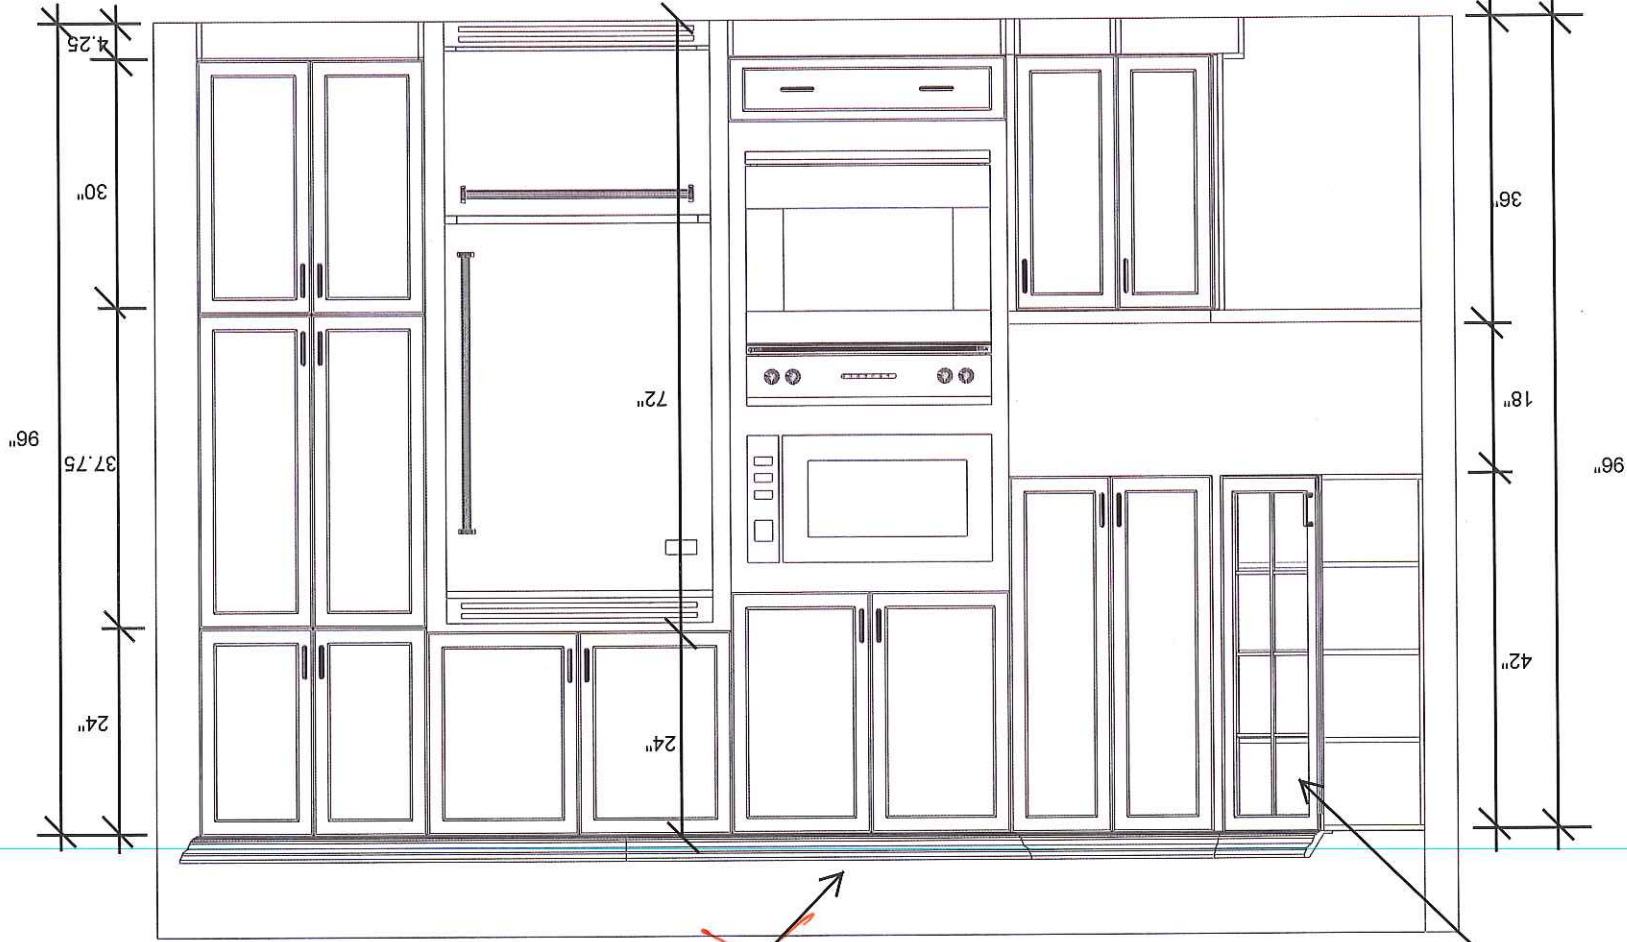

GLASS DOOR
WITH MULLIONS

LARGE CROWN

No crown

Note: This drawing is an artistic interpretation of the general appearance of the design. It is not meant to be an exact rendition.

SPECTRUM KITCHENS



Drawing #: 1

All

DCR - LOT 126 FERNBANK CROSSING

Designed: 7/8/2015
Printed: 7/8/2015