


(ONE EACH SIDE OF DINING)

5' 1'-10" 4' 1'-10" 5'

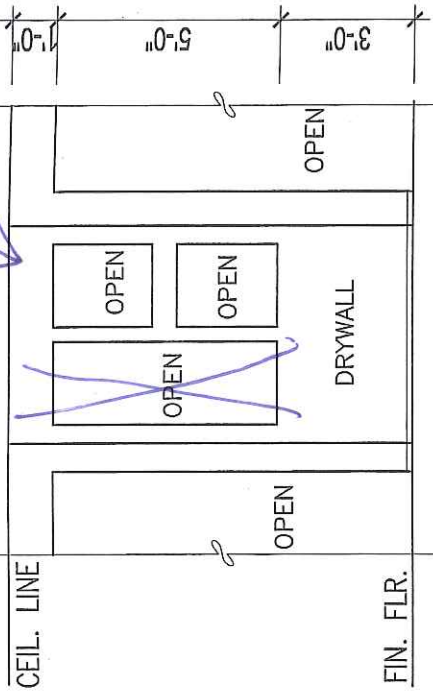

ELEV. @ FEATURE WALL

1
9-9

TOP OF PLATE

TOP OF WINDOW

BEDROOM 2

2.
SIM

GARAGE

18.

6'-10"

FIN. SECOND FLOOR

TOP OF WINDOW

9'-9"

7'-10"

FIN. GROUND FLOOR

FIN. GRADE

5'-0"

MIN.

8'-5"

U/S GARAGE FOOTING

TOP OF SLAB

HT INSU
L AND I
I BUILD
TO 611
(4") STL
INSULATC
REQUIRED.
0") O.C
KR GROU
100mm
OLTS 20
SILL PL
RDS: 10
9.2.8.
R NEW
(2") MIN
ET. HAN
mm (4