


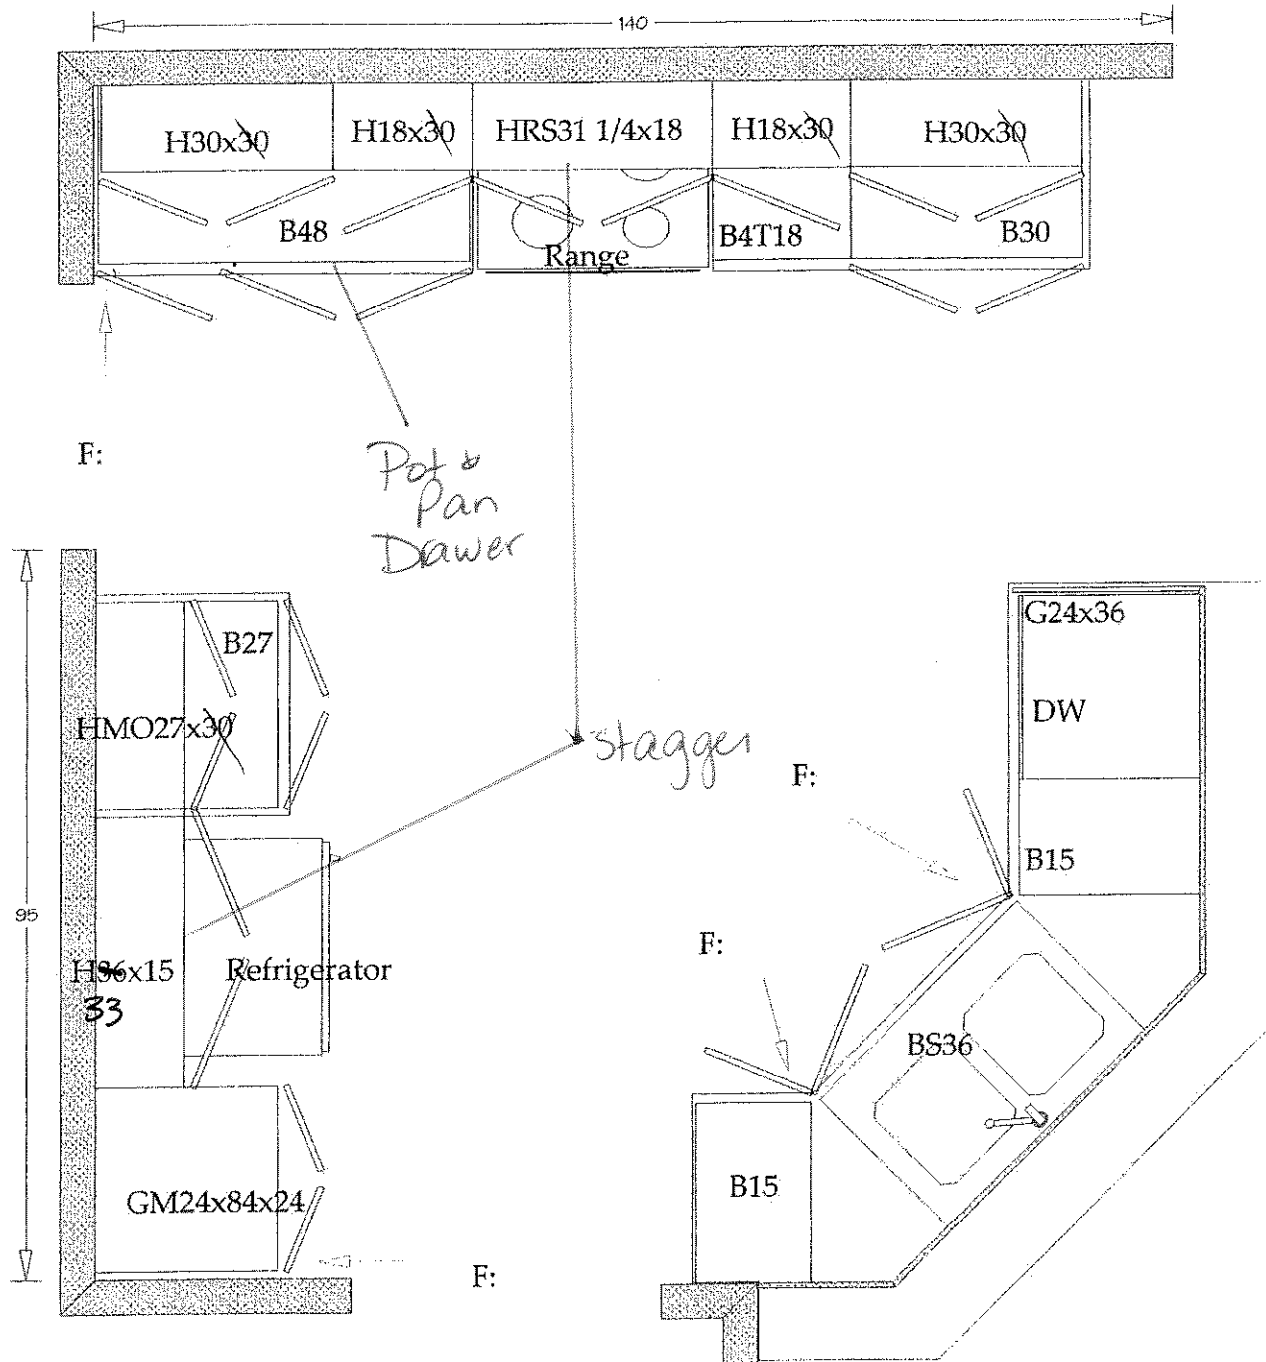

Kitchen:

Doors: W211-OAK
 Finish: 650-Sesame
 Counter: N/A
 Style:
 Handles: 2971-C

Upgrades

- ① Soft Close Doors / Drawers
- ② Stagger Stove, fridge uppers
- ③ 36" High Uppers
- ④ Pot & Pan Drawer
- ⑤ Large Crown Moulding
- ⑥ Accomodate for OTR.

Gord Downes & Shellie Persi

MR kitchens

Contractor:

Phoenix Homes

Designer:

G.B.

Job Number:

Date:

Notes:

Robson

Heritage Hills


Lot # 10

Scale:

1/2" = 1'

Page:

1 of 6

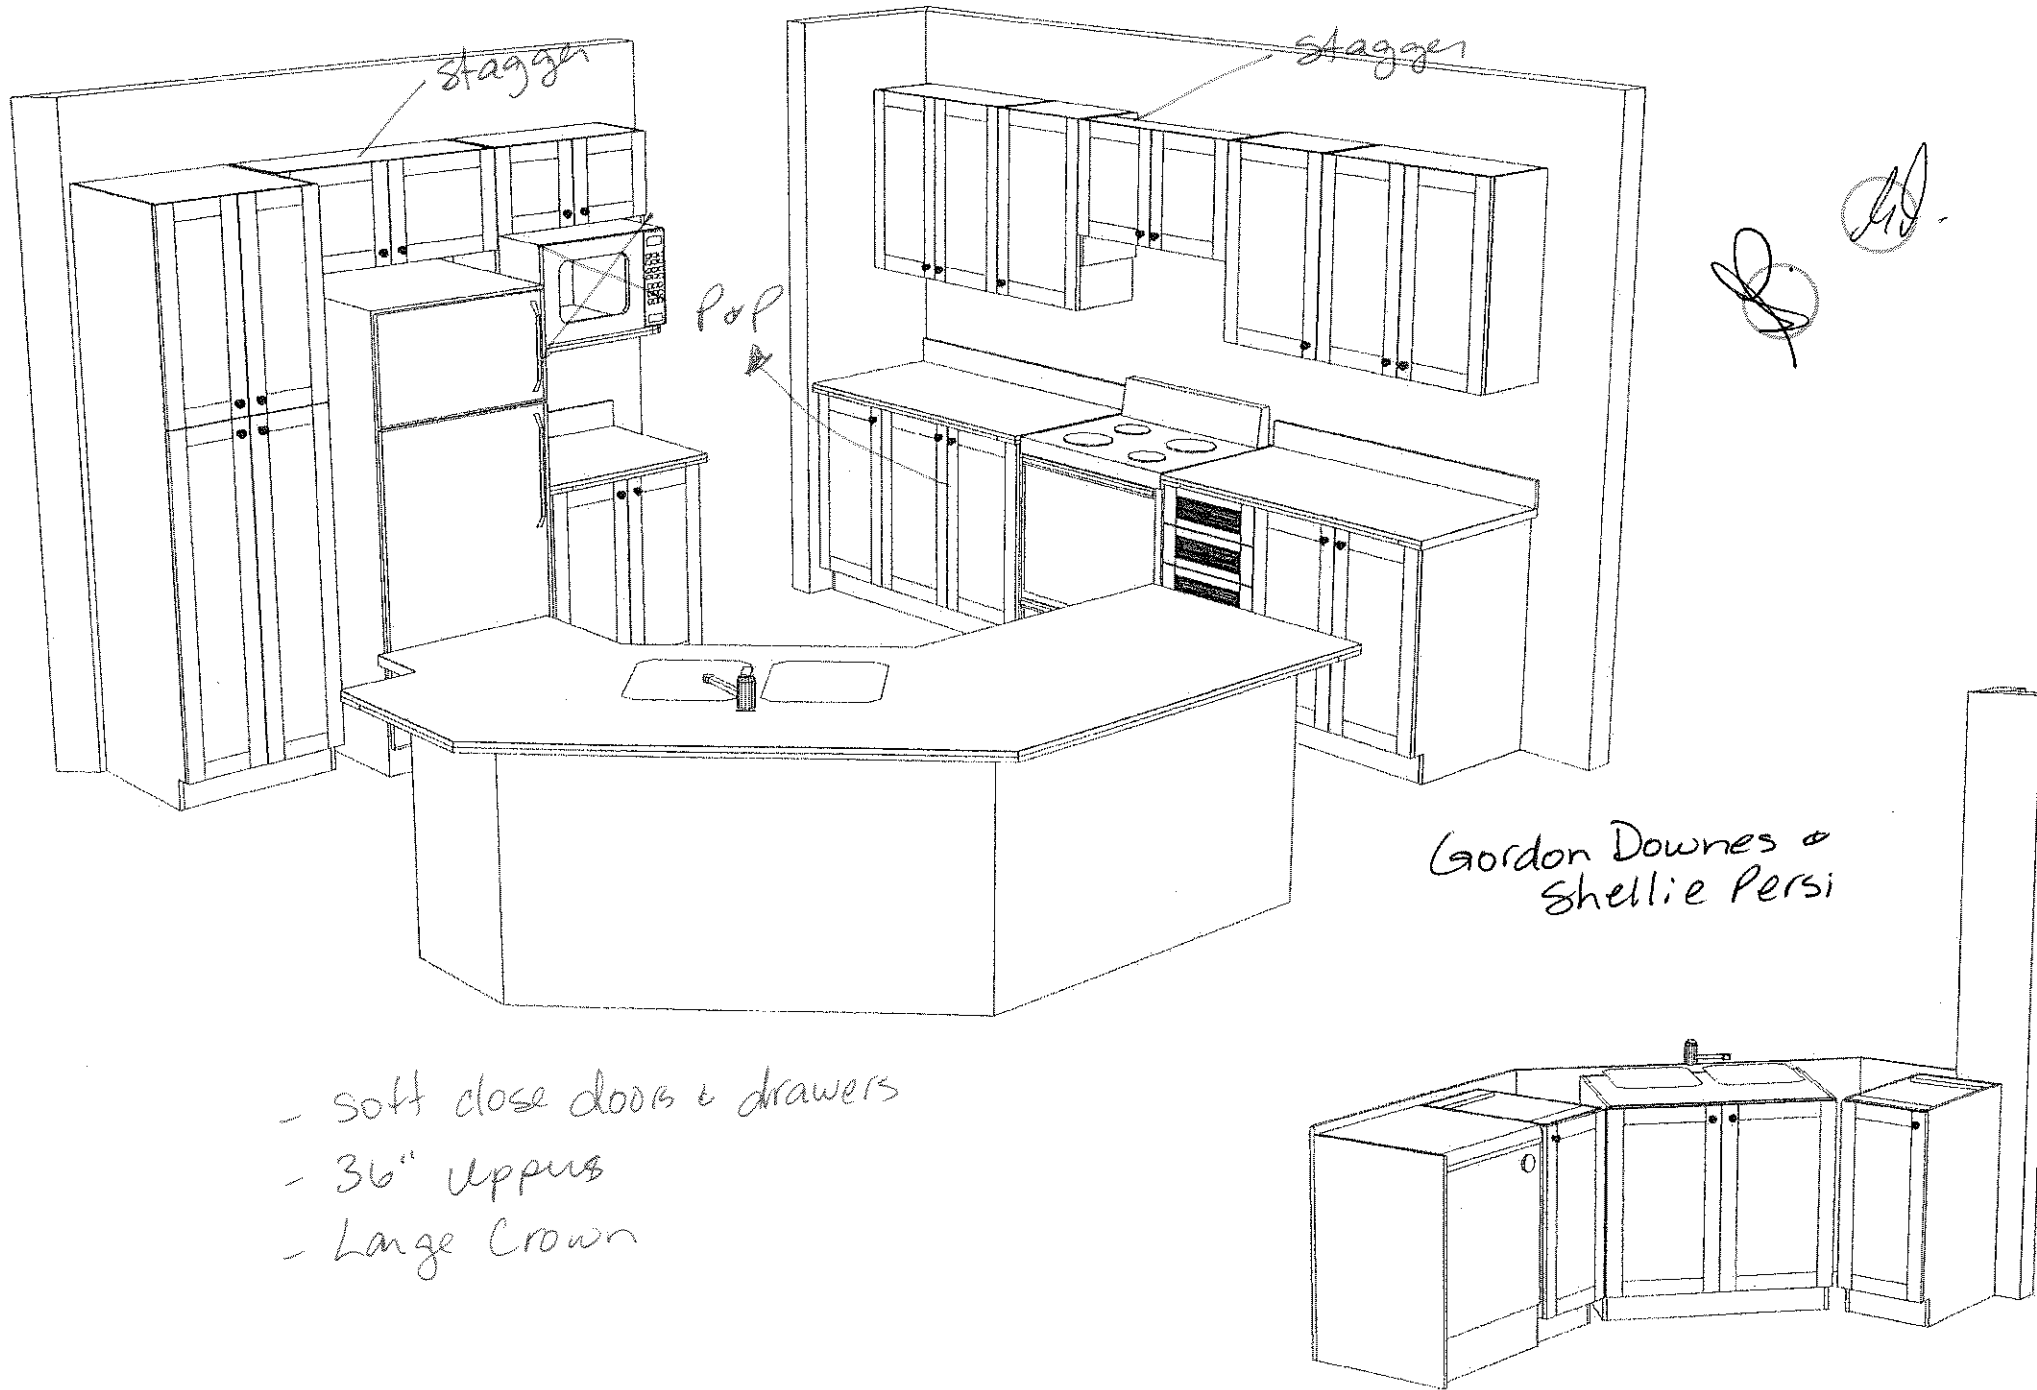

MR kitchens

Contractor:

Phoenix Homes

Designer:

G.B.

Job Number:

Date:

06/28/10

Notes:

Robson

Heritage Hills

Lot # 10

Scale:

7/8" = 1'

Page:

2 of 6