


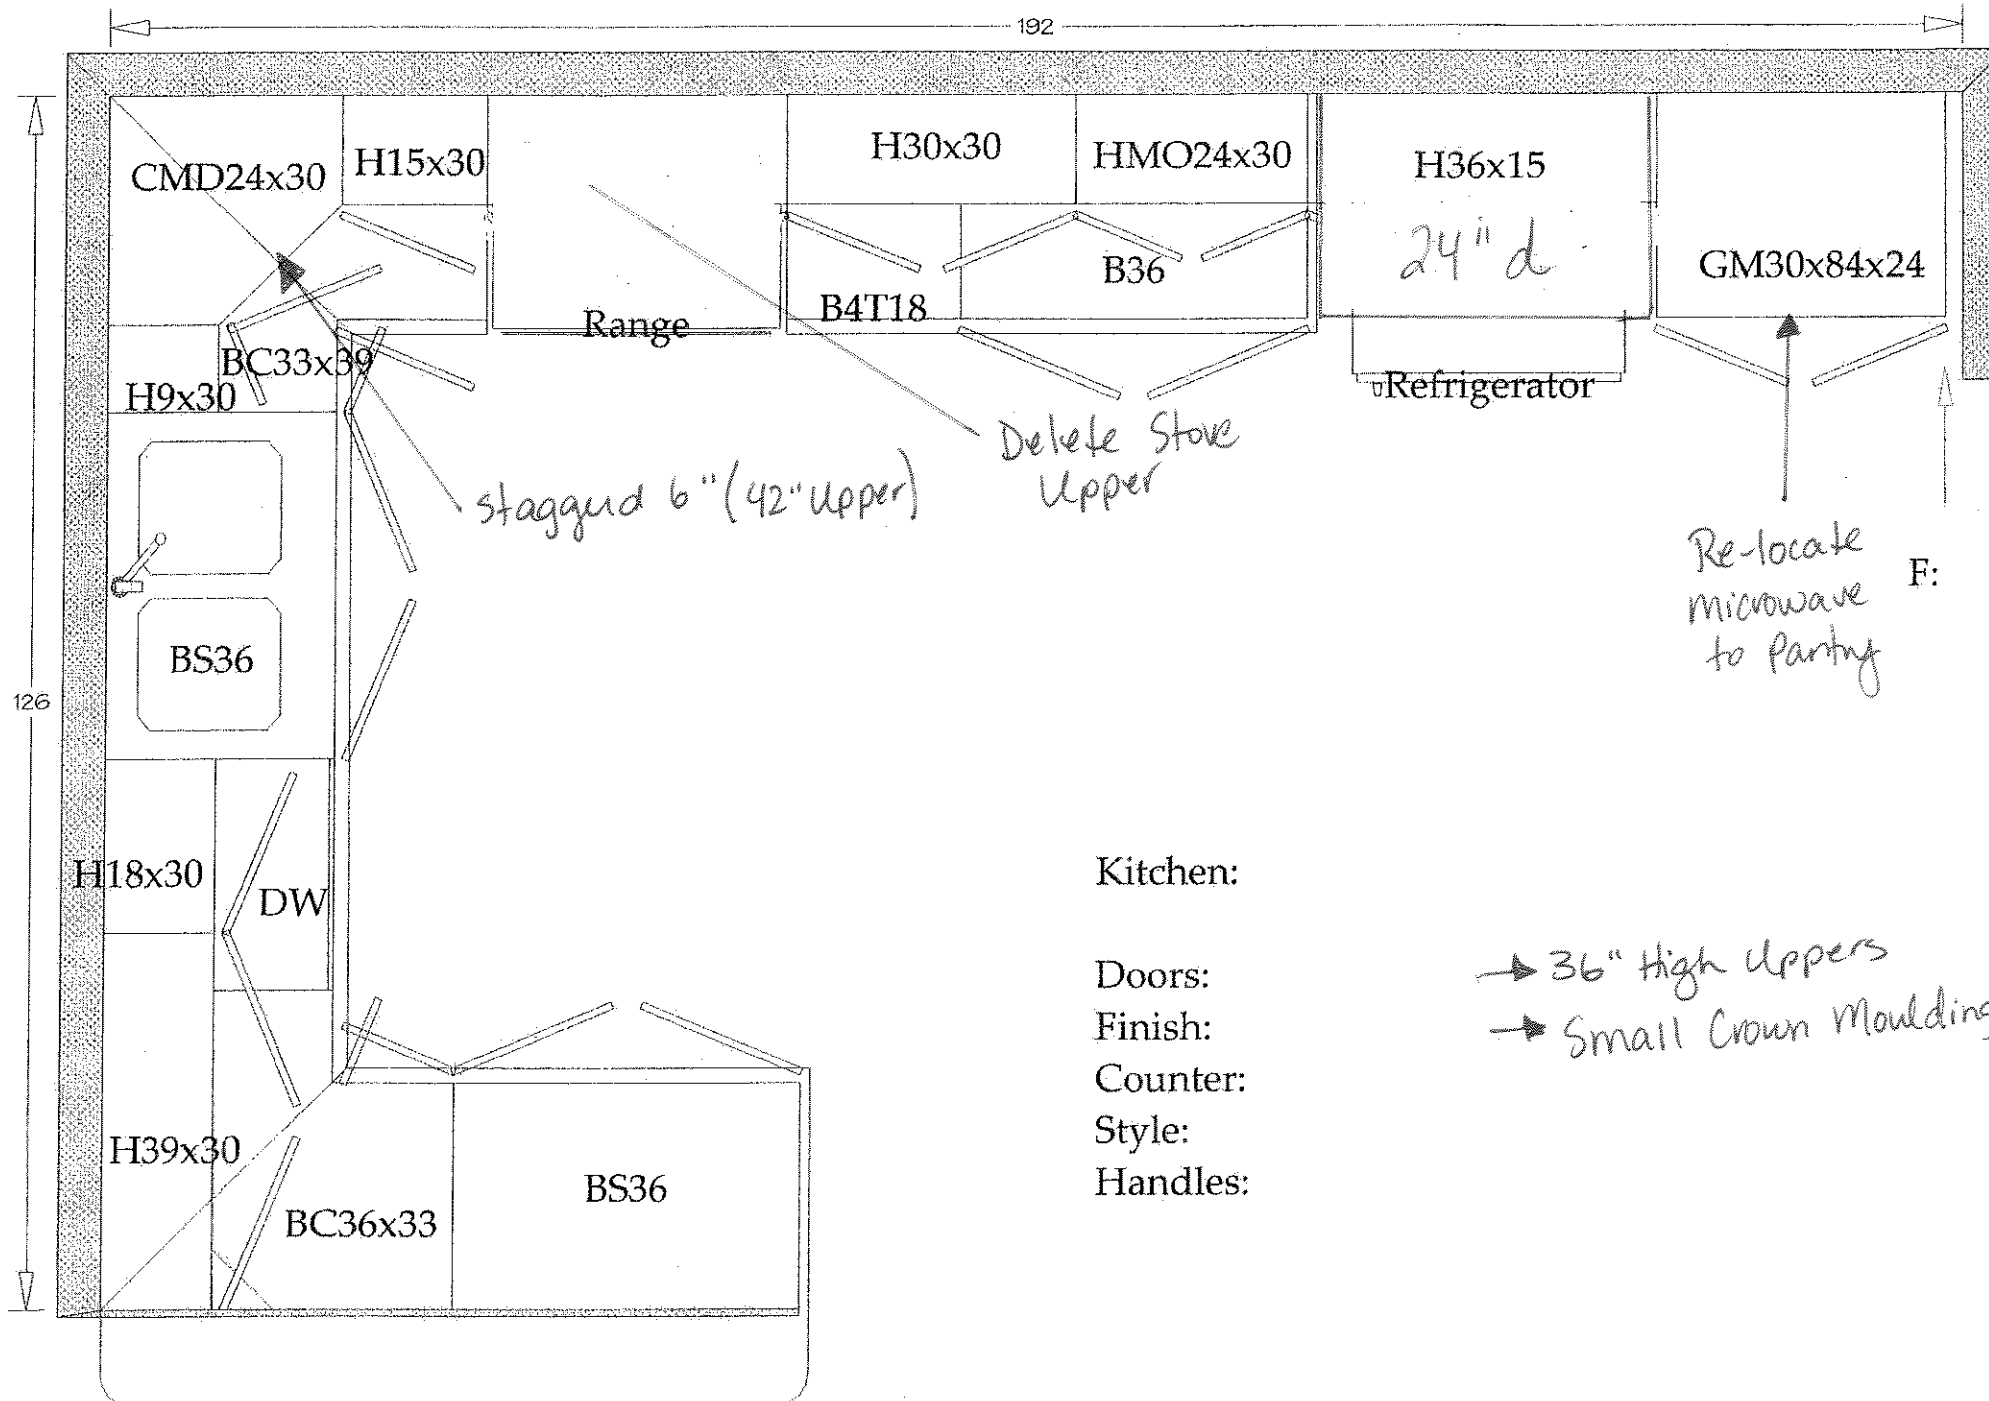

Kitchen:

Doors:

Finish:

Counter:

Style:

Handles:

→ 36" High Uppers
→ Small Crown Moulding

MR kitchens

Contractor:

Phoenix Homes

Designer:

G.B.

Job Number:

Date:

06/24/10

Notes:

Blackcomb 35-1

Heritage Hills

Lot # 9

Scott McLaren
Lindsay Hamilton

SM

LH

Scale:

5/8" = 1'

Page:

1 of 9