





PHOENIX HOMES

LINGTON

1,662 Square Feet*

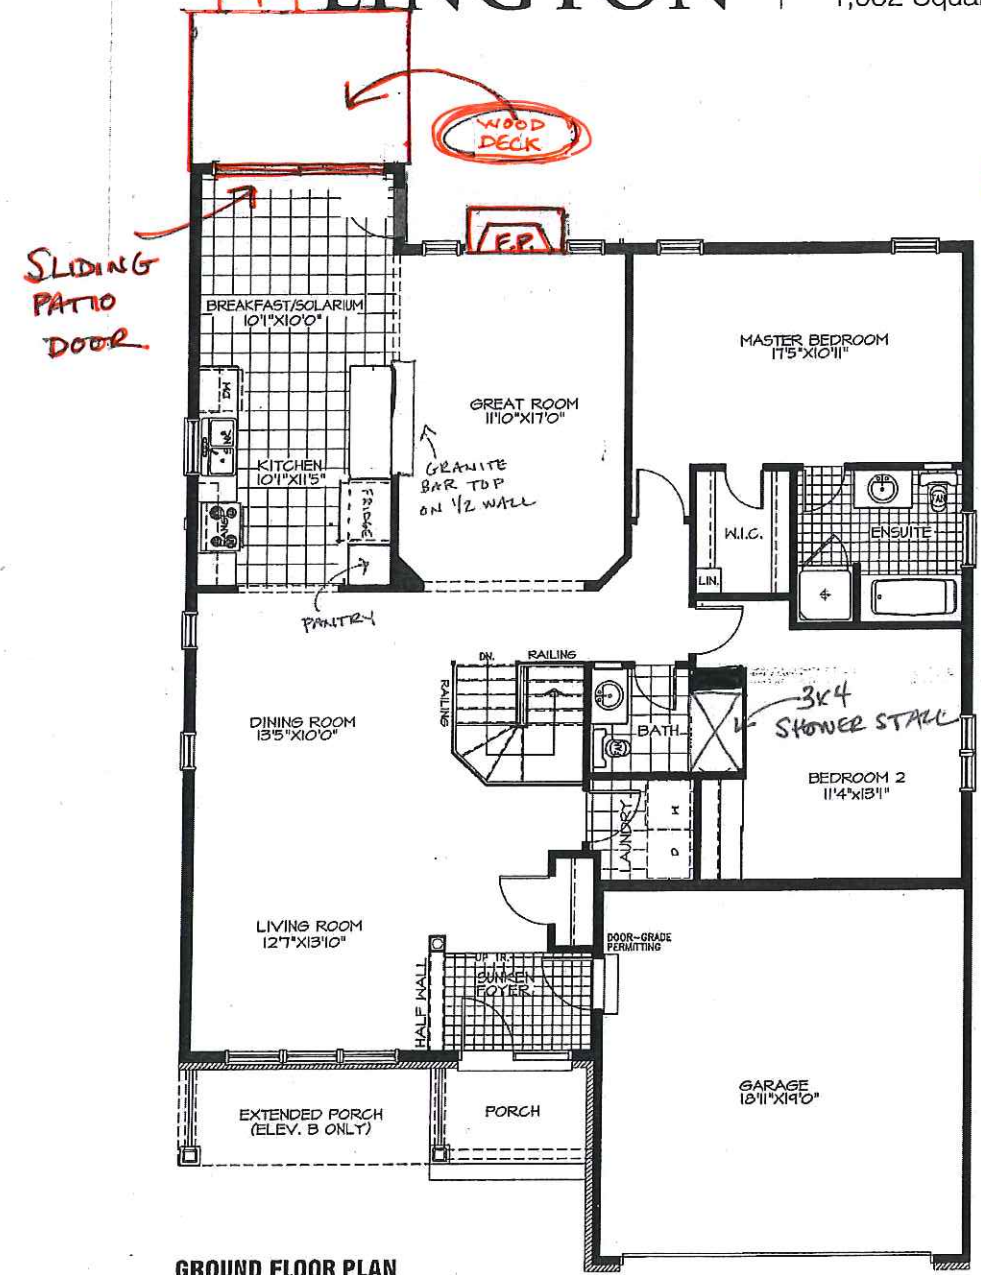

GROUND FLOOR PLAN

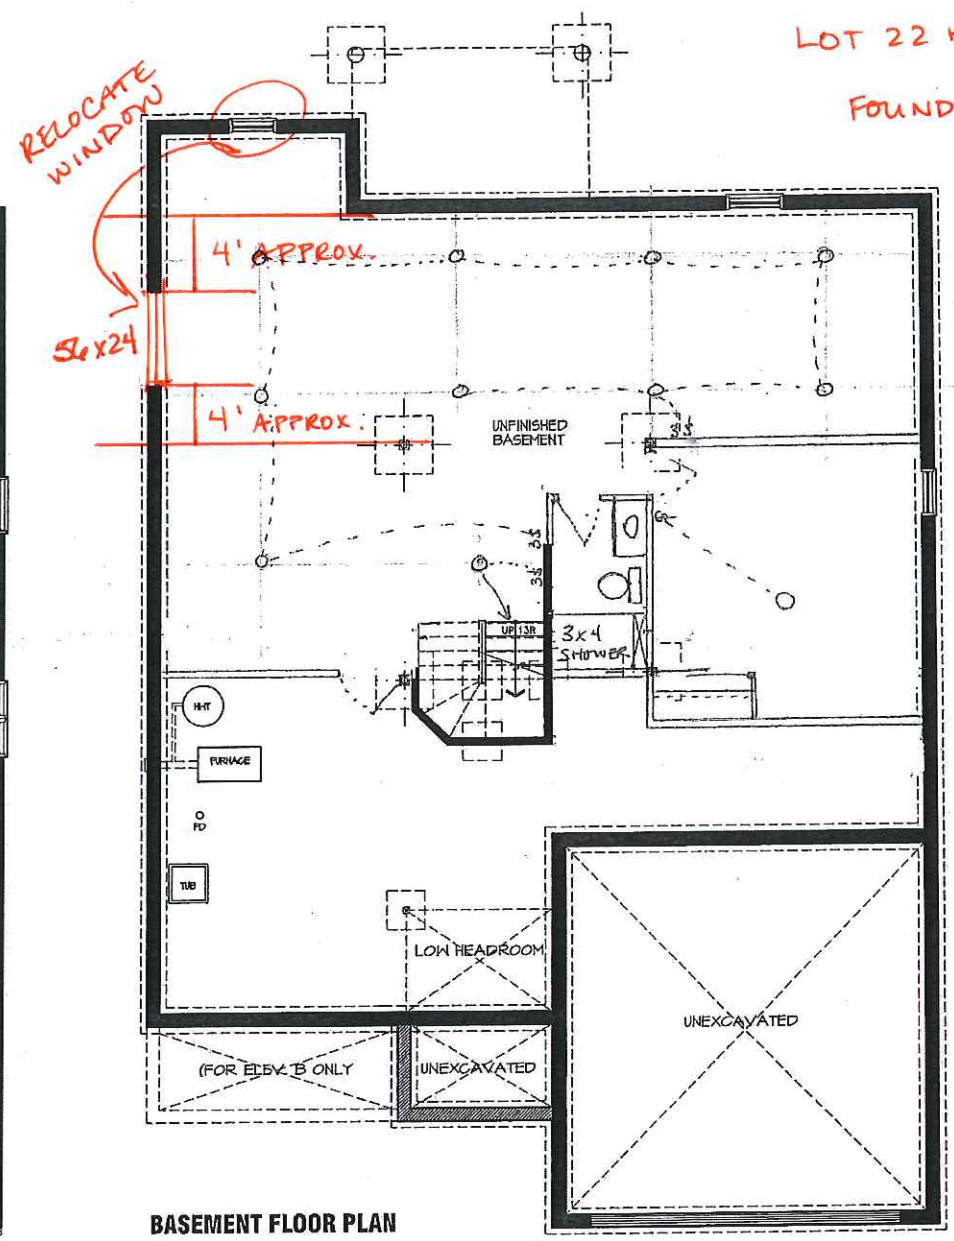

BASEMENT FLOOR PLAN

LOT 22 H.H. S | + CUFF | BAKER
FOUNDATION CHANGE - RELOCATED WINDOW DUE TO DECK



*Total square footage includes 37 sq. ft. in the basement foyer.
Rendering artist's concept only. Specifications and floor plans subject to change without notice.
Utility, furnace and H.W.T. locations may vary. Appliances not included. E. & O.E.