


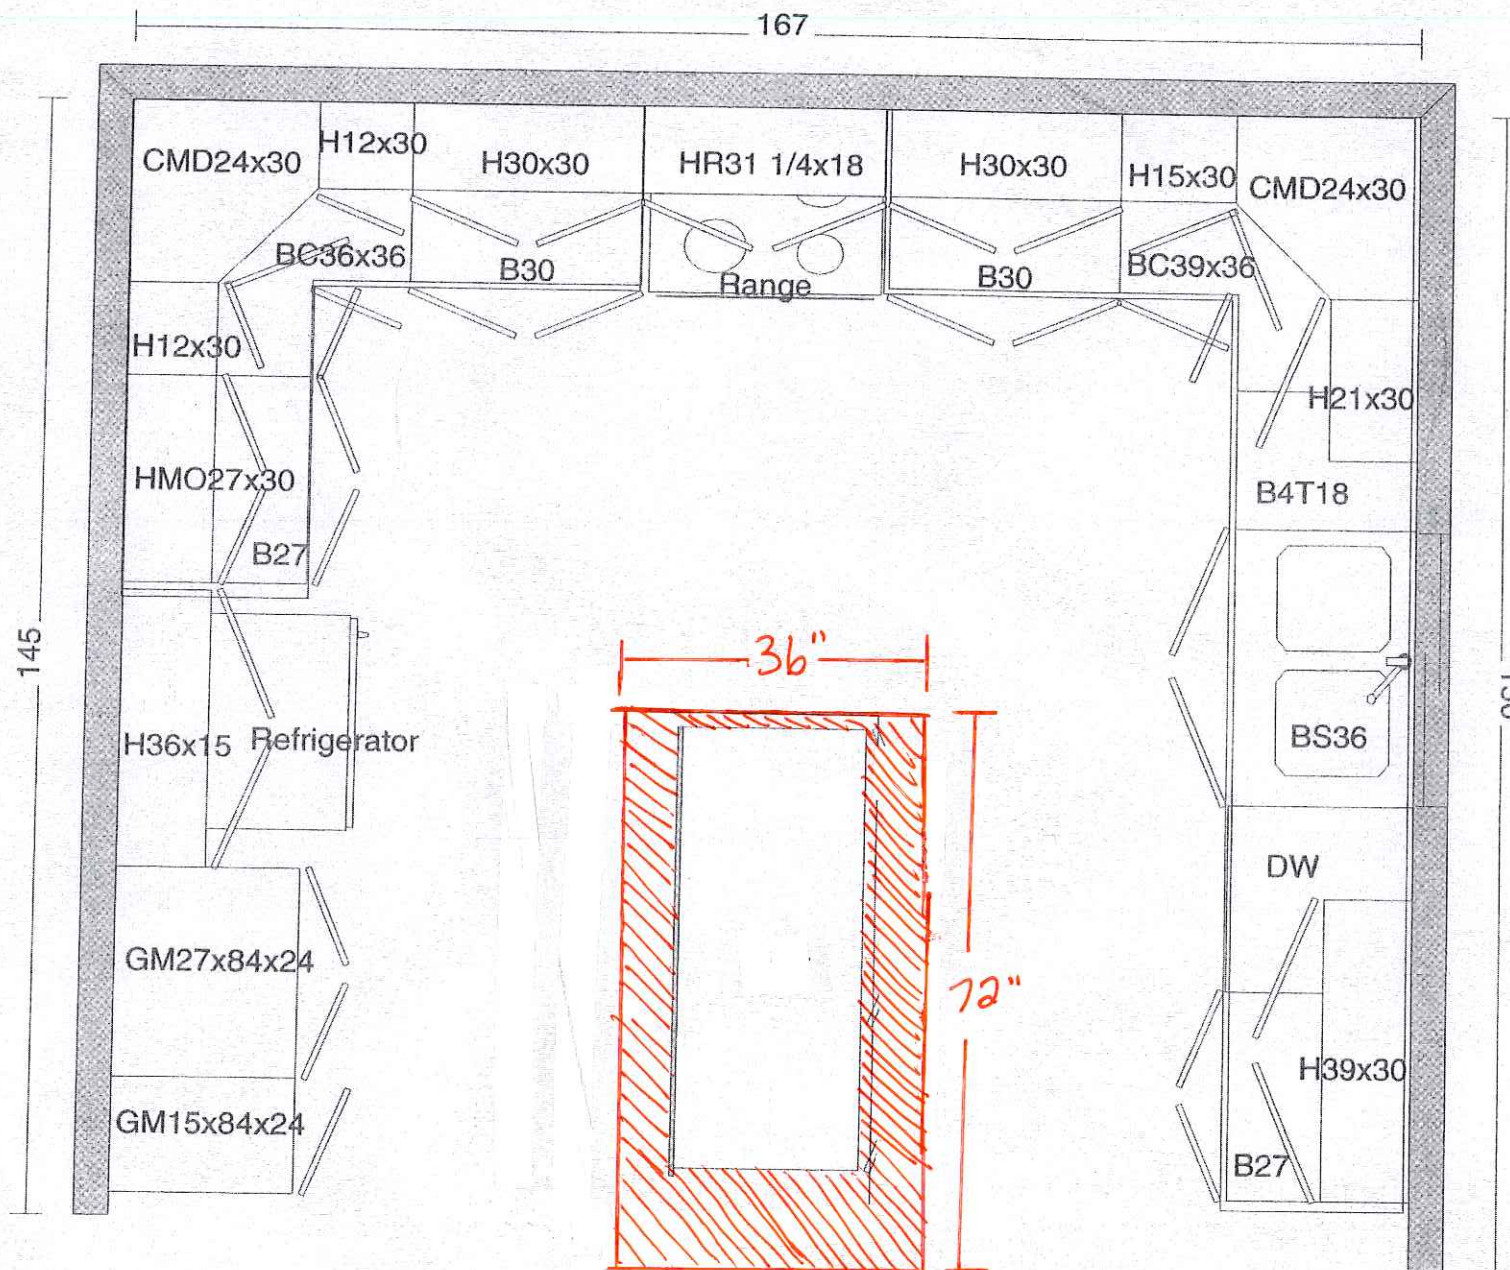

* stone
Design
Concepts

Kitchen

Doors:
Finish:
Counter:
Style:
Handles:

Lot 23 H.H.
Jieying Zeng*
Pengyan Zhang

pro *mr*

Feb. 2/13

Date

MR kitchēns

Contractor:

Phoenix Homes

Designer

GB

Job Number:

Date:

12/16/08

Notes:

Platina
(512)

Page:

Contractor:

Phoenix Homes

Designer

Job Number:


Date:

Notes:

Handwritten signature

Page:

4 of 9

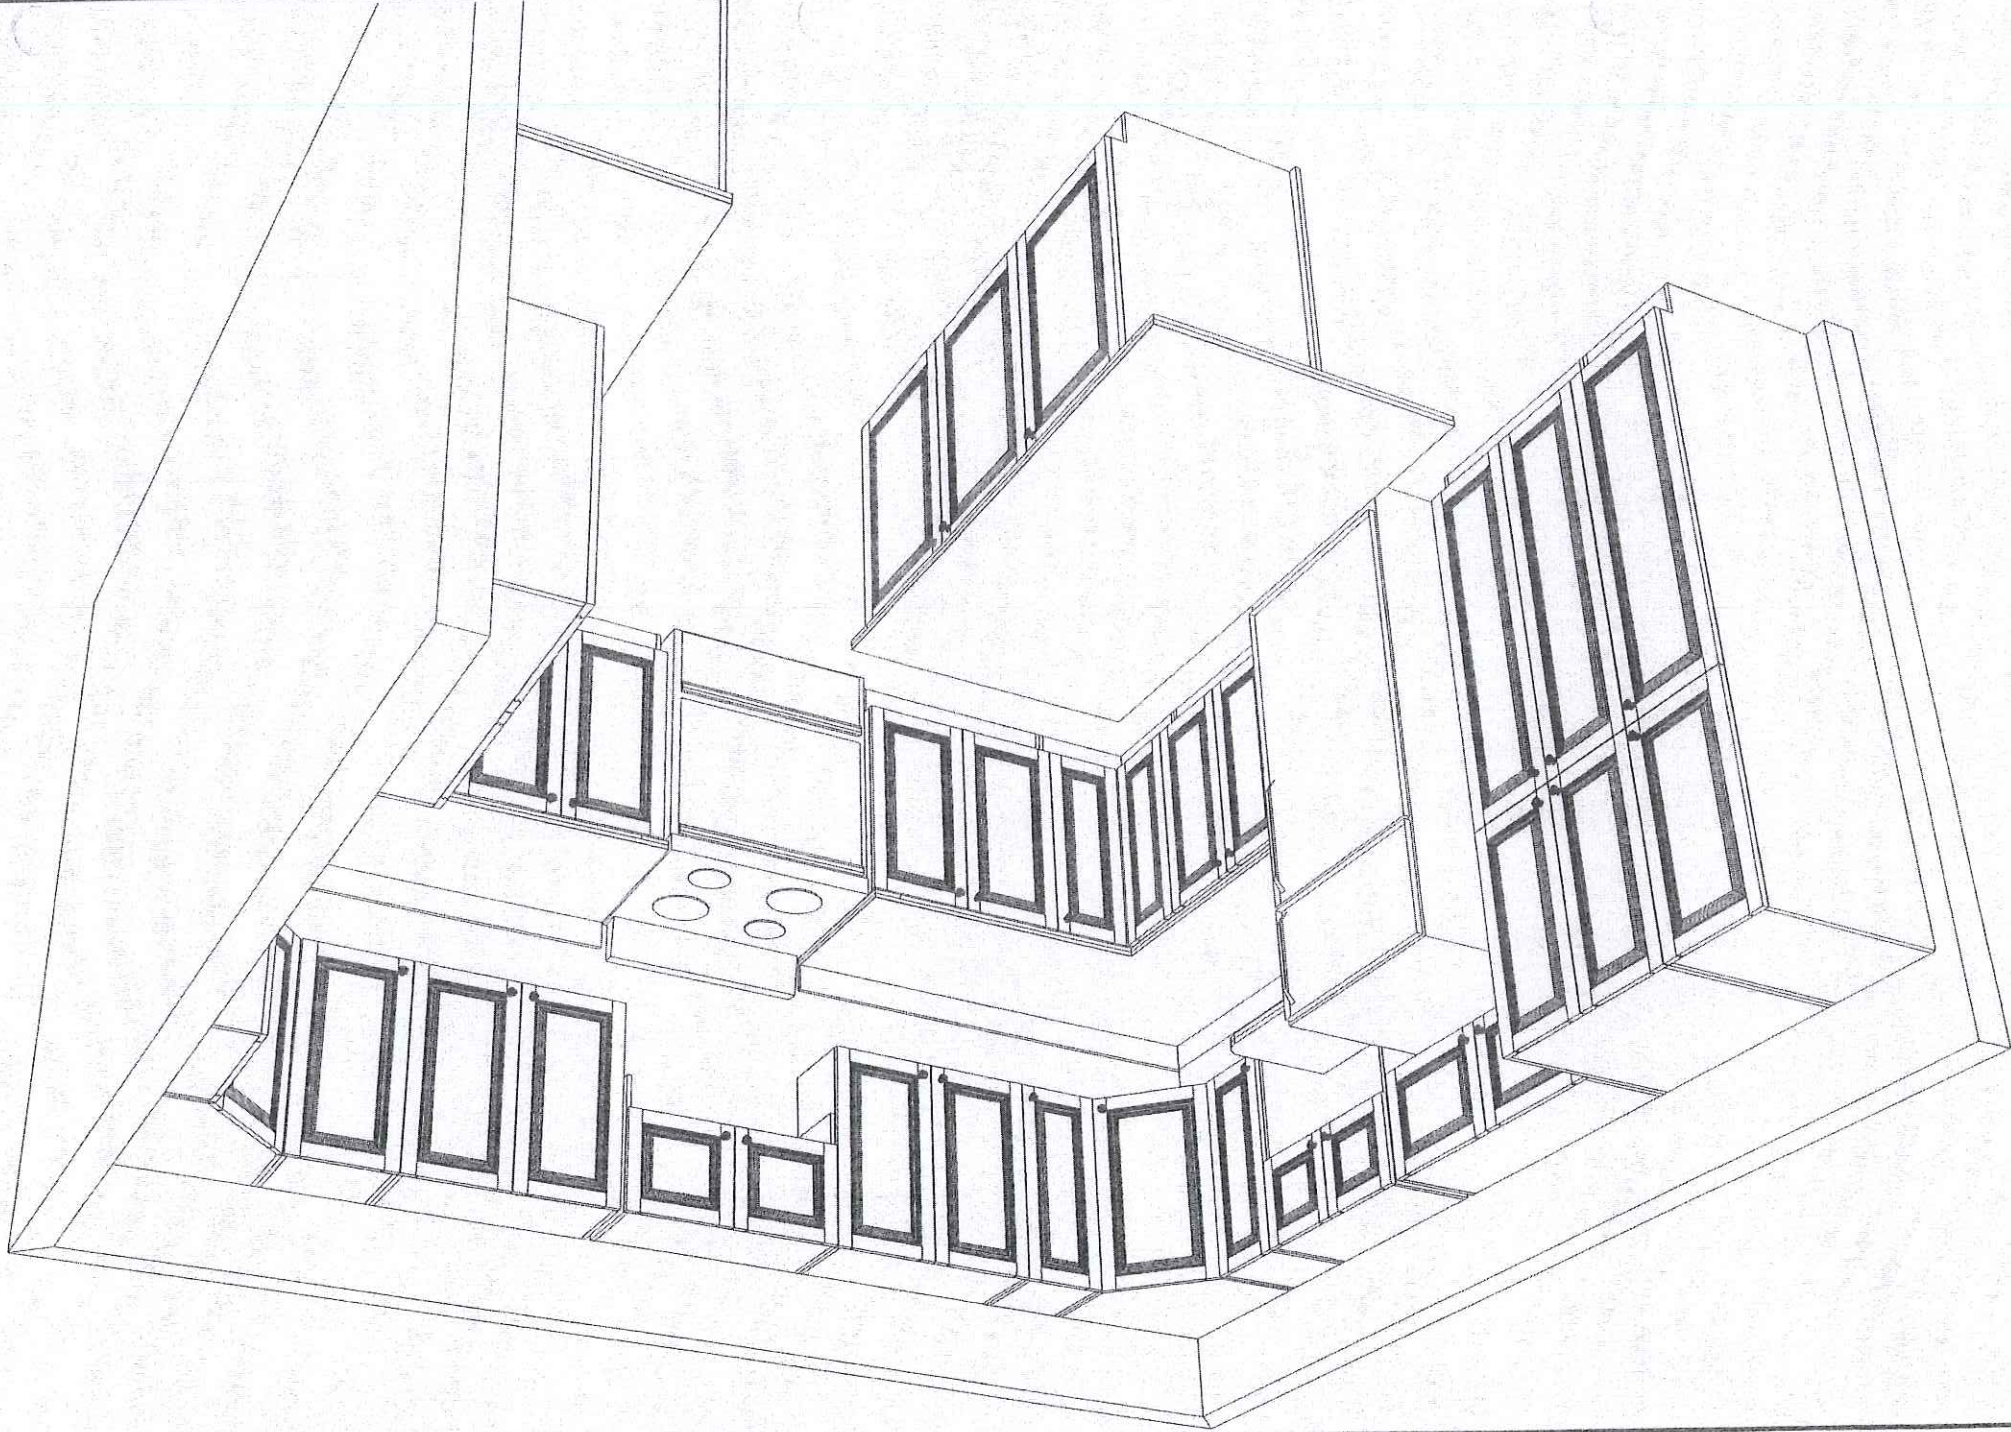

Contractor:

Phoenix Homes

Designer

Job Number:

Date:

Notes:

Handwritten initials and a red circle mark.

Page:

