


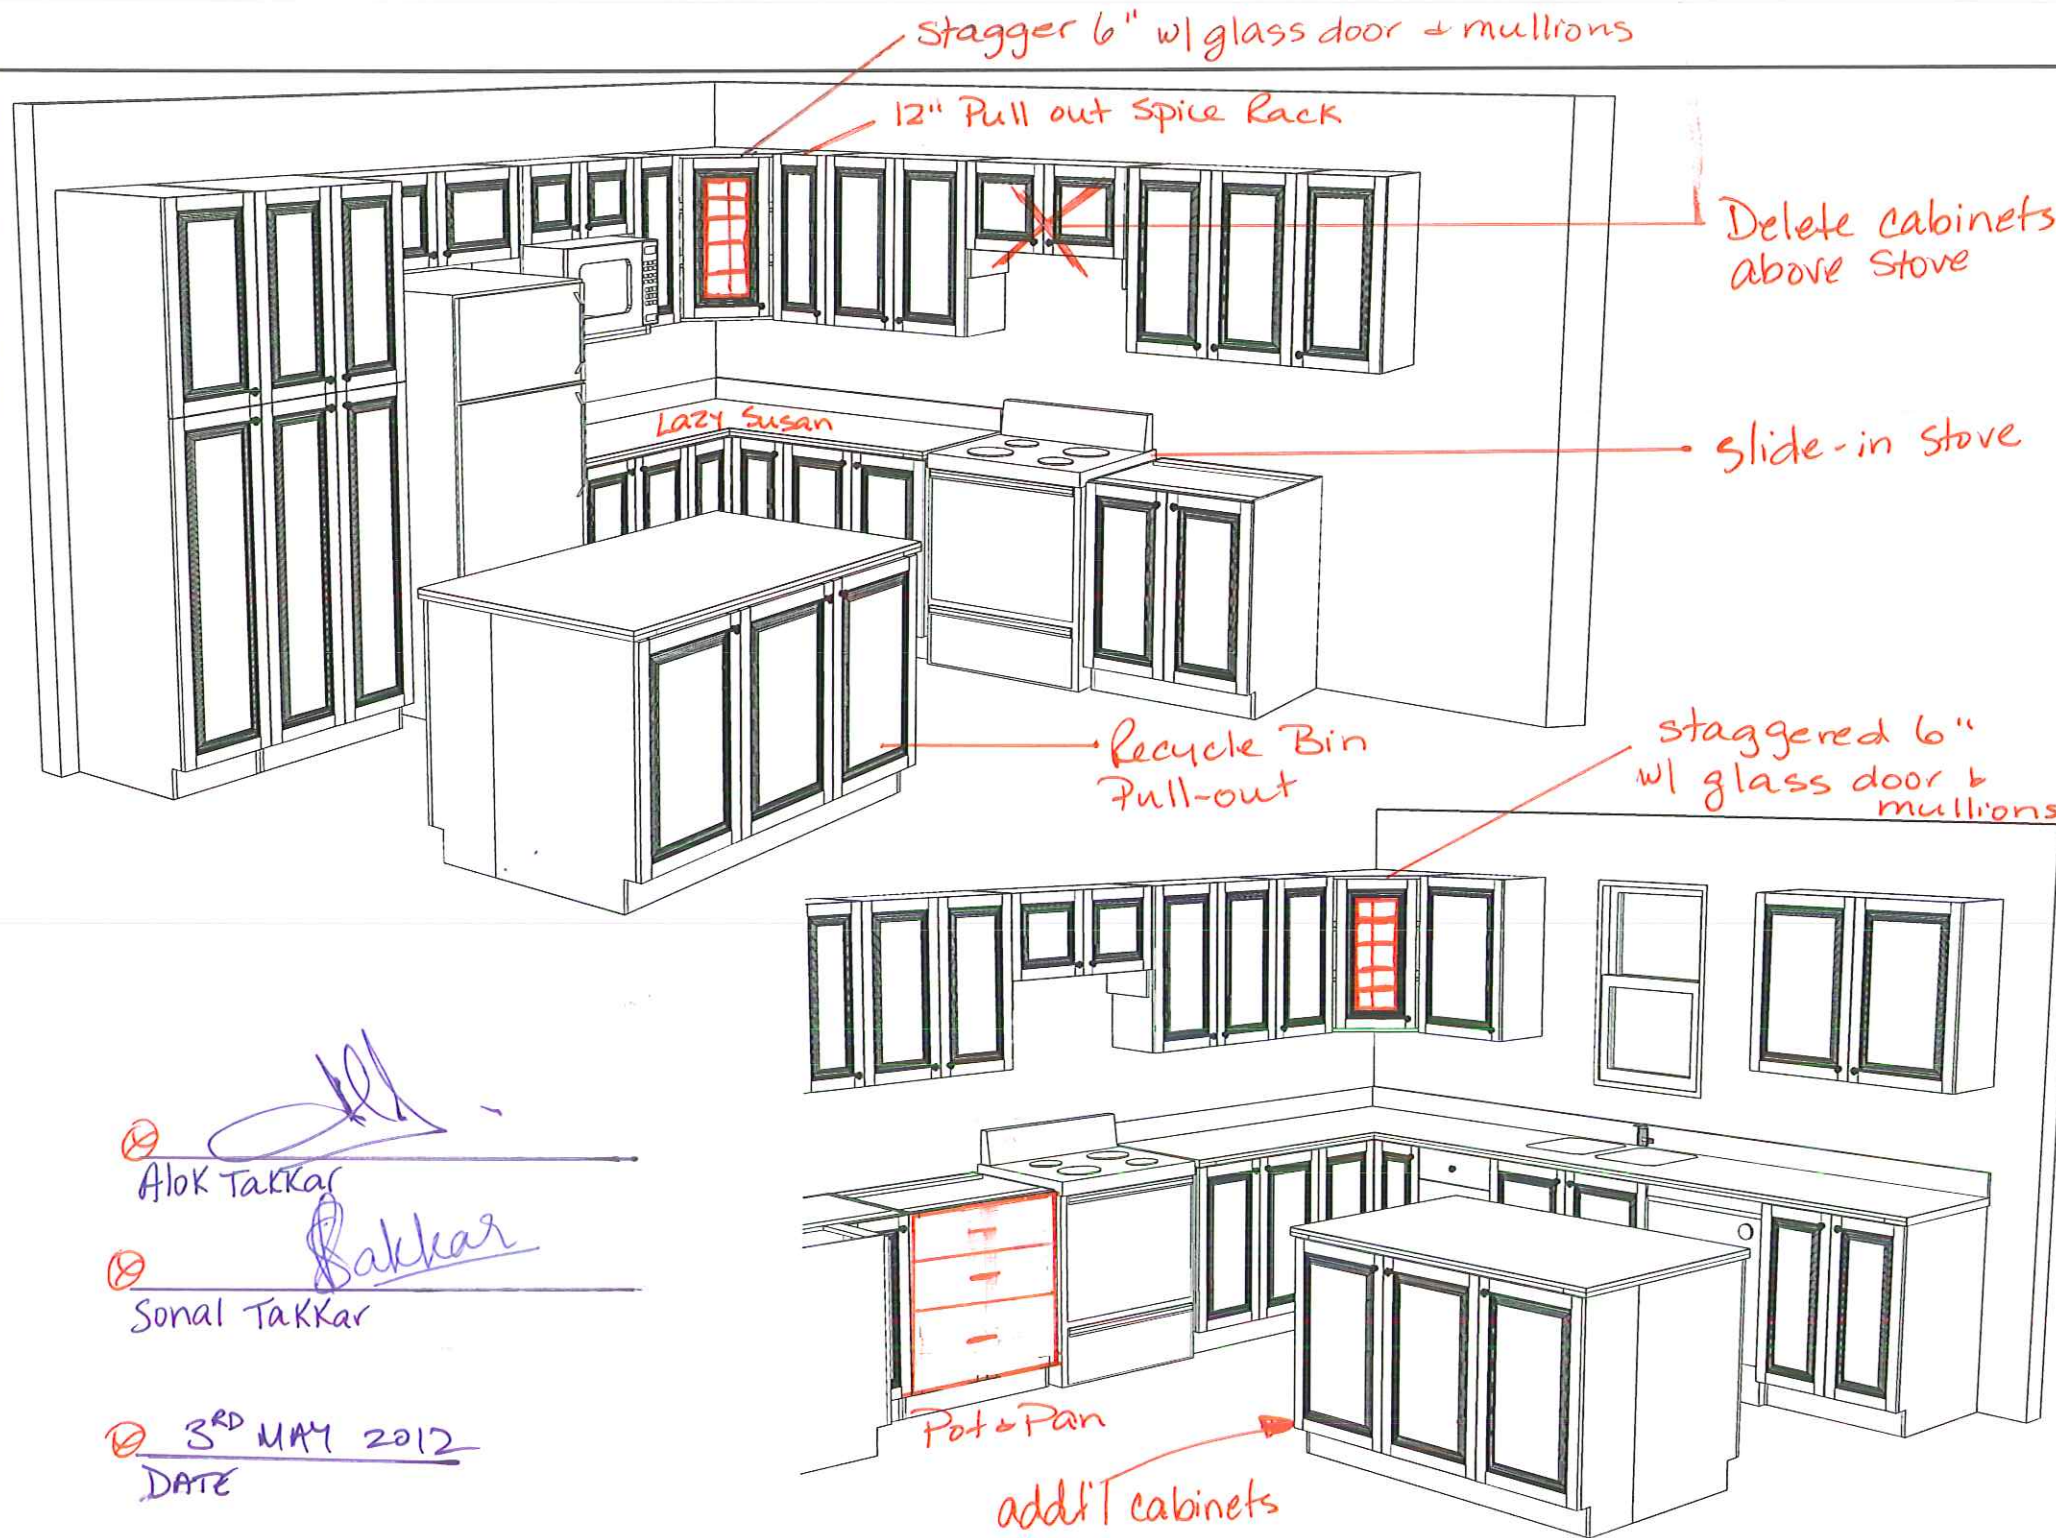

MR kitchens

296 Enterprise, Vars, ON
K0A 3H0
T:613.443.3399
F:613.443.3406

Contractor:
Phoenix Homes

Designer:
GB

Job Number:
Job

Date:
04/25/12

Notes:

Heritage Hills

Lot #69

Scale:

3/4" = 1'

Page:

4 of 4

⊗ Alok Takkar
⊗ Sonal Takkar
⊗ 3RD MAY 2012
DATE

Computer Desk




Alok Takkar




Sonal Takkar



Date

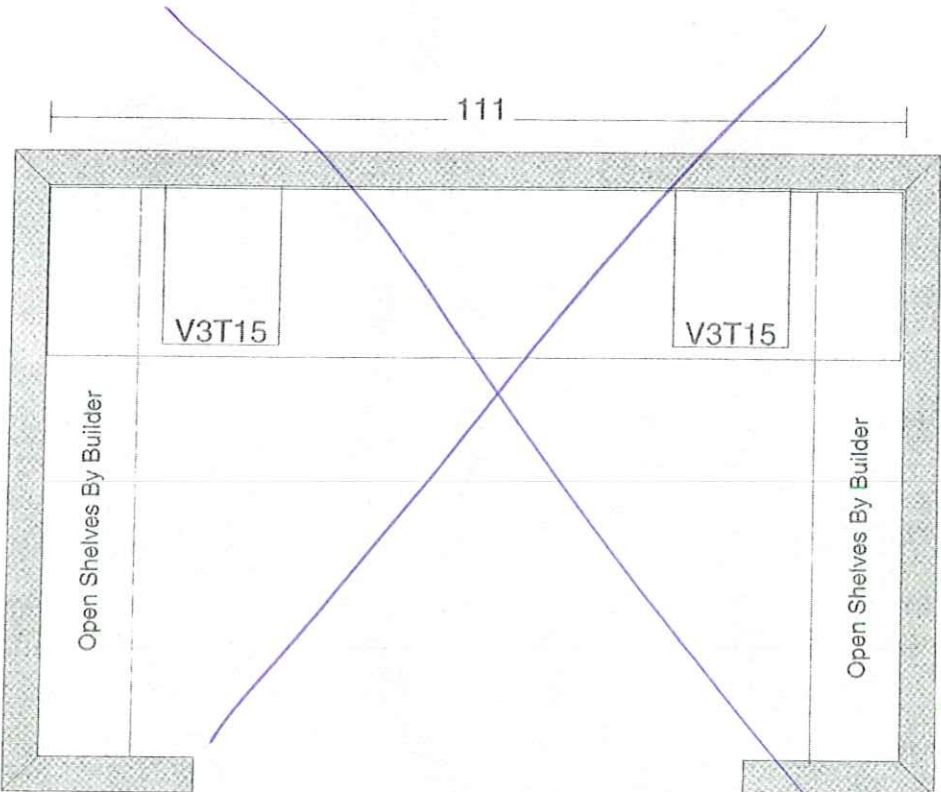

installed
18"
AFF

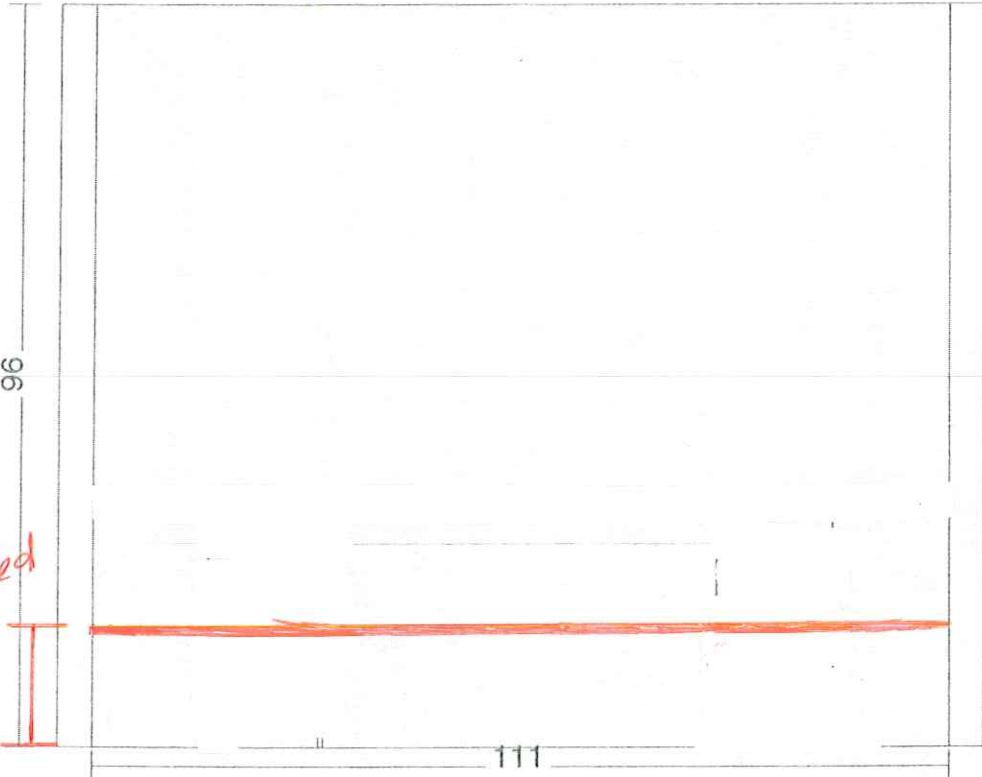

MR kitchēns

Contractor:

Phoenix Homes

Designer

GB

Job Number:

Job

Date:

12/16/08

Notes:

Page: