

DCR PHOENIX HOMES

FERNBANK CROSSING

LOT #37

ROSEMERE (C10)

KITCHEN

MOUNTING HT: 96

LINE -

HARDWARE -

STD WHITE INTERIORS

METAL DRWR BOX

3 PCS - 5/8" KICK

2 PCS - LOOSE FILLER - 6 x 96

1 PC - 90 DEG C MOULD

1PC - 135 DEG C MOULD

2 PCS - T MOULD


CUSTOMER APPROVAL

I have reviewed these drawings and understand the details of the layout and the Cartier Kitchens specifications.

Signature

Date

Feb. 28 / 14

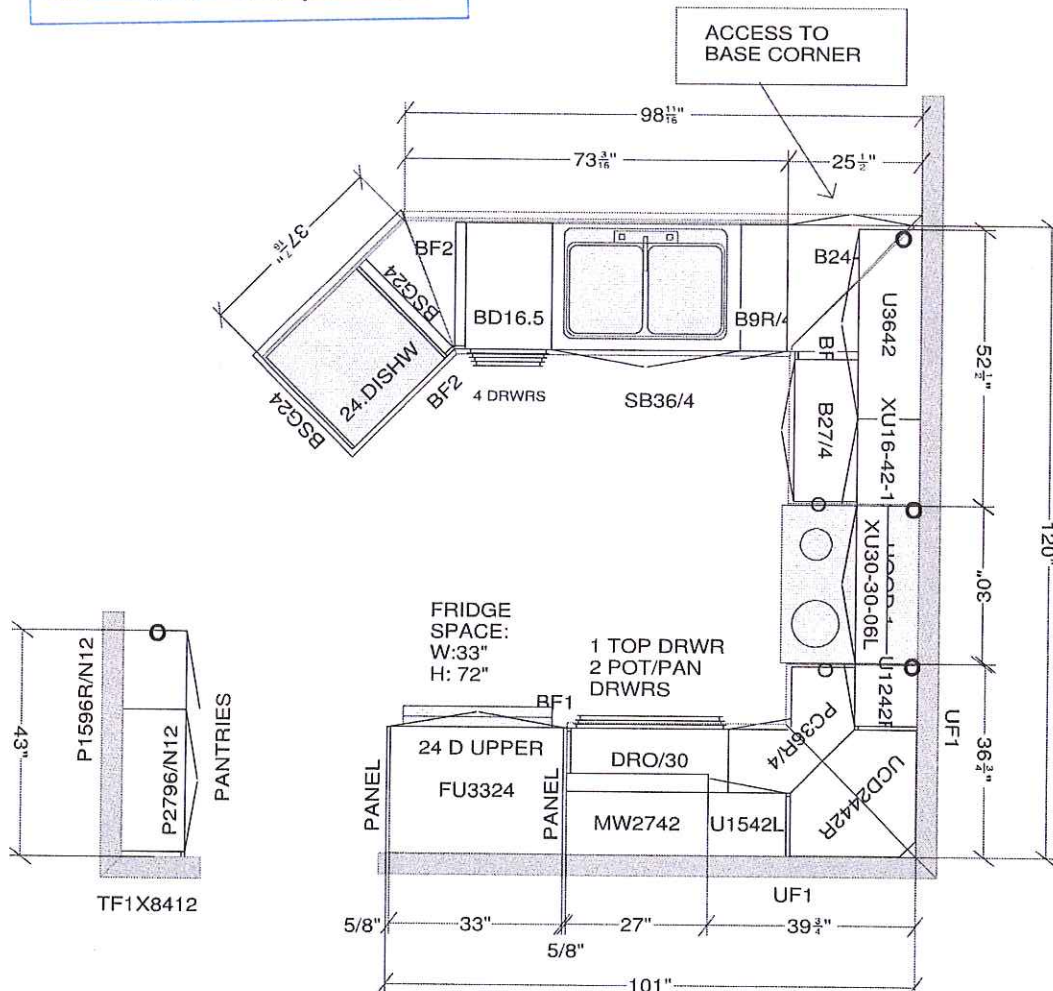

All dimensions and size designations given are subject to verification on job site and adjustment to fit job conditions.

Cartier Kitchens Ottawa

2020
TECHNOLOGIES

This is an original design and must not be released or copied unless applicable fee has been paid or job order placed.

Drawn by: Lori Di Saverio, B.I.D.
Cartier Kitchens Ottawa


Designed: 17/11/2013
Printed: 17/11/2013

DCR - #37 FBC - Kitchen - C10 - ROSEMERE .kit

All

Drawing #: 1 No Scale.

+ NO CROWN
+ BULKHEAD BY BUILDER

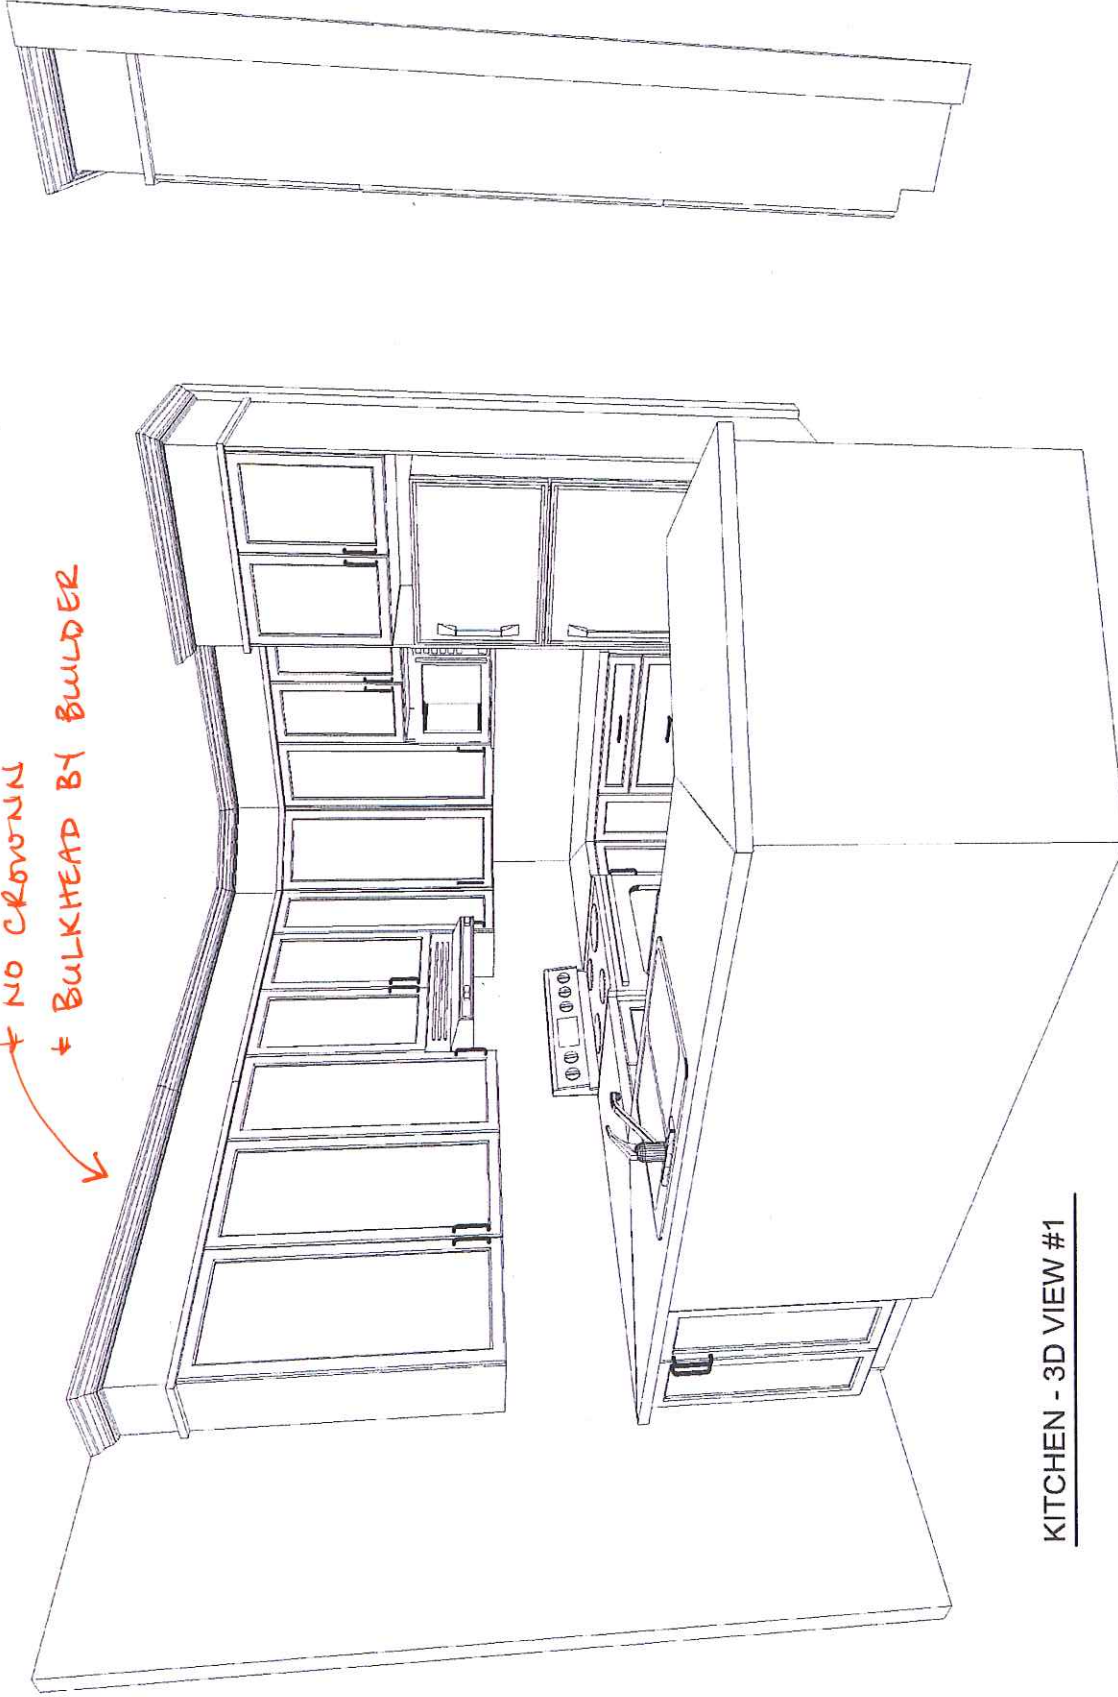

KITCHEN - 3D VIEW #1

CUSTOMER APPROVAL

I have reviewed these drawings and understand the details of the layout and the Cartier Kitchens specifications.

AZ

Signature

Date

Feb. 28 / 14

Note: This drawing is an artistic interpretation of the general appearance of the design. It is not meant to be an exact rendition.

Drawn By: Lori D Saverio, B.I.D.
Cartier Kitchens Ottawa

DCR - #37 FBC - Kitchen - C10 - ROSEMERE .kit


All

Drawing #: 1

2020
TECHNOLOGIES

Designed: 17/11/2013
Printed: 17/11/2013

± NO CROWN / BULKHEAD BY BUILDER

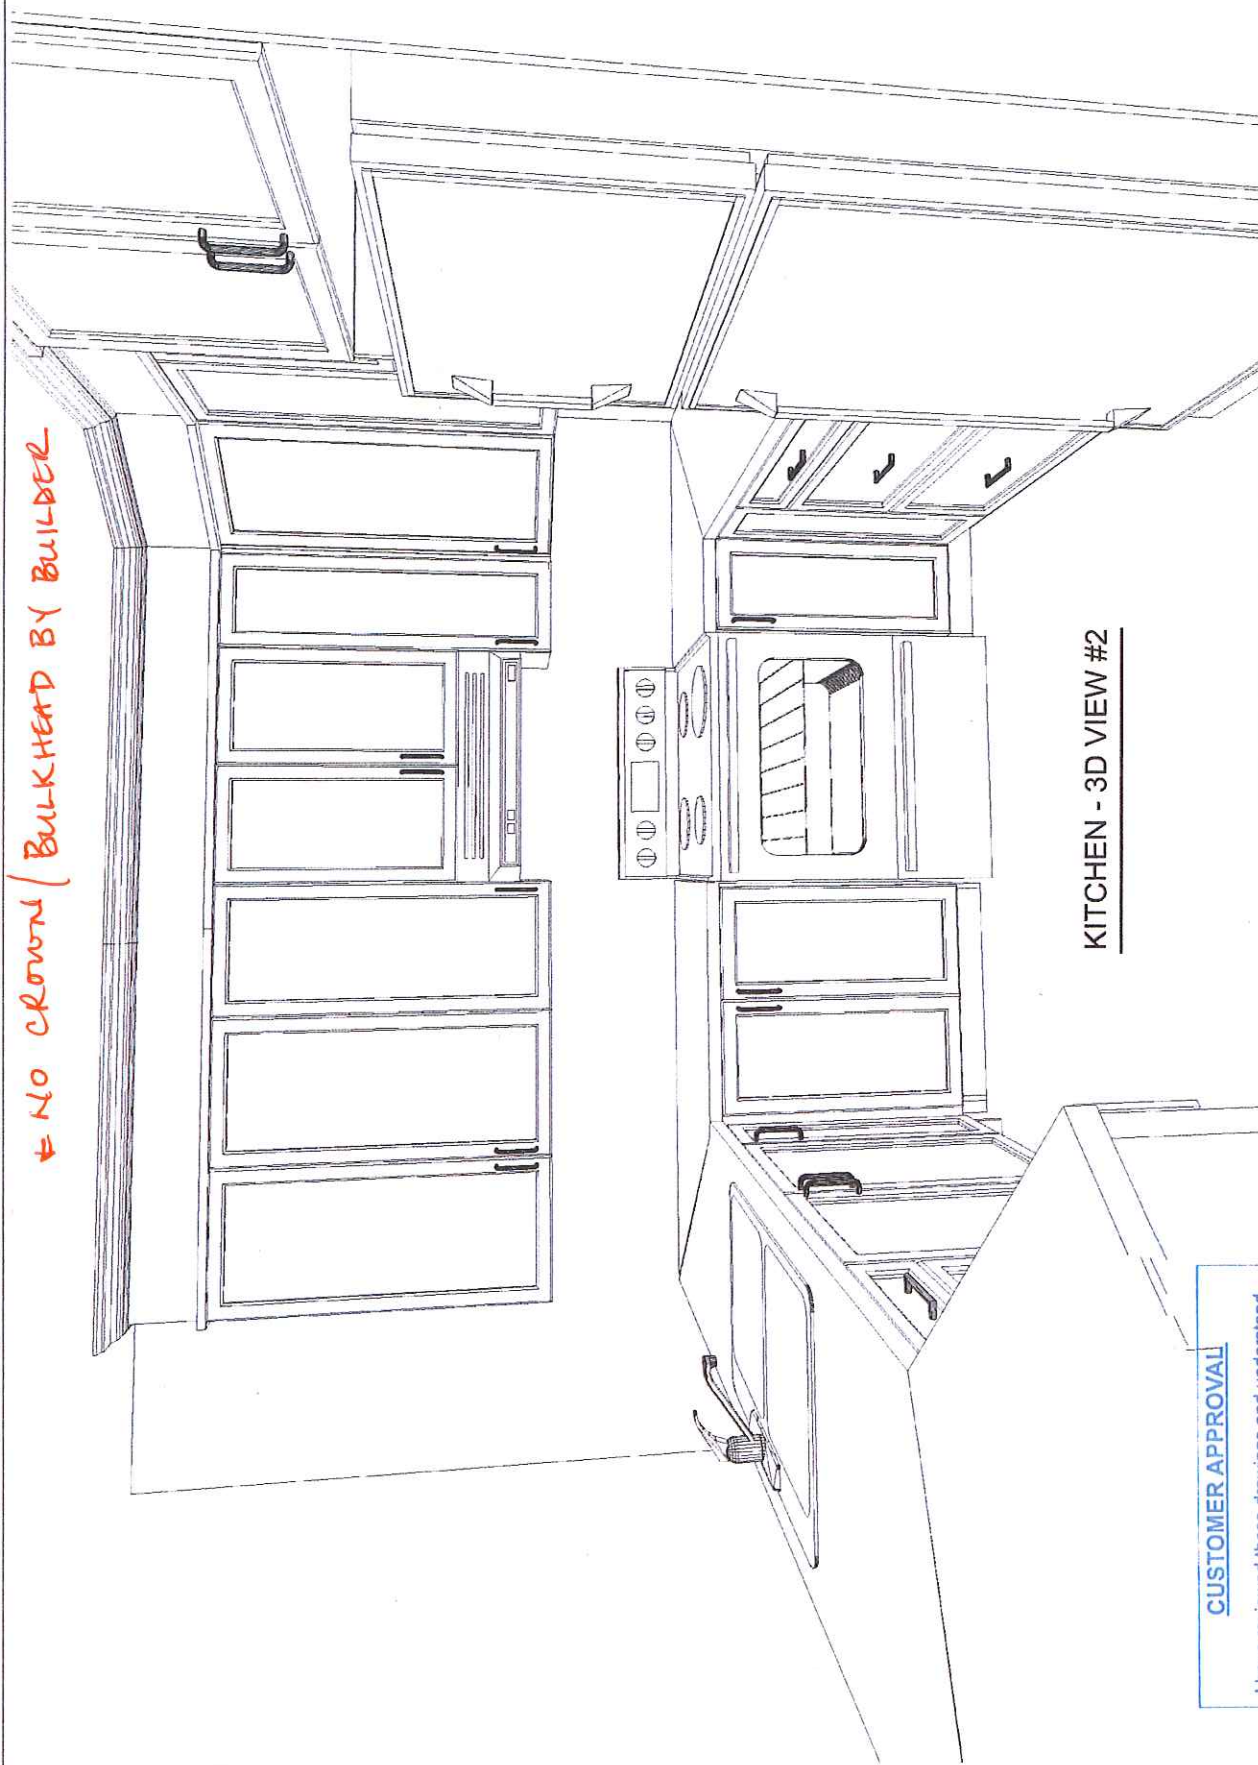

KITCHEN - 3D VIEW #2

CUSTOMER APPROVAL

I have reviewed these drawings and understand the details of the layout and the Cartier Kitchens specifications.

AZ

Signature

Feb. 28 / 14

Date


Note: This drawing is an artistic interpretation of the general appearance of the design. It is not meant to be an exact rendition.

Drawn By: Lori D Saverio, B.I.D.
Cartier Kitchens Ottawa
DCR - #37 FBC - Kitchen - C10 - ROSEMERE .kit



Designed: 17/11/2013
Printed: 17/11/2013

Drawing #: 1

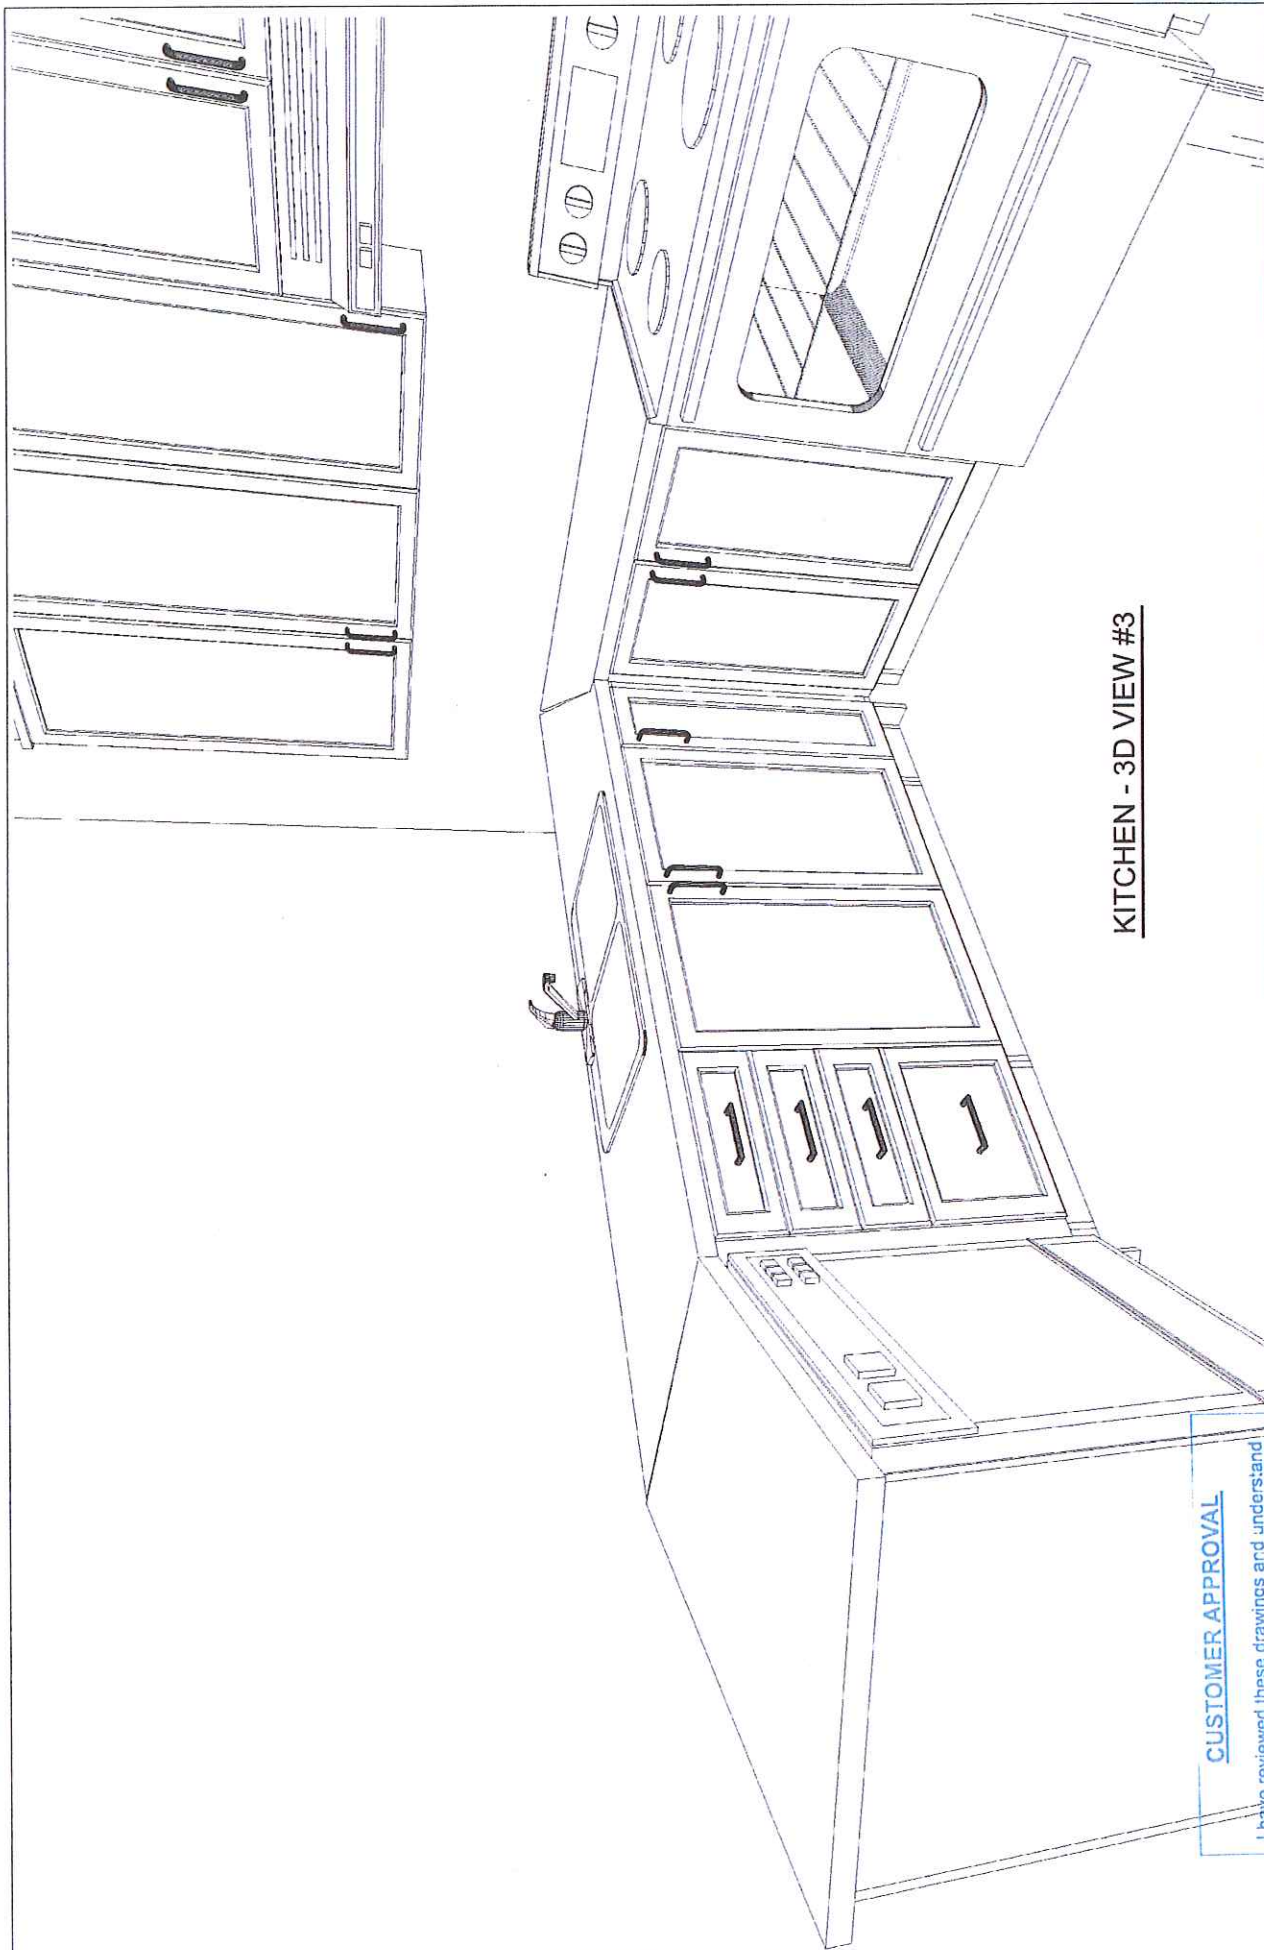

KITCHEN - 3D VIEW #3

CUSTOMER APPROVAL

I have reviewed these drawings and understand the details of the layout and the Cartier Kitchens specifications.

AZ

Signature

Date

Feb. 28/14

Note: This drawing is an artistic interpretation of the general appearance of the design. It is not meant to be an exact rendition.

Drawn By: Lori D Saverio, B.I.D.
Cartier Kitchens Ottawa

DCR - #37 FBC - Kitchen - C10 - ROSEMIERE .kit


All

Drawing #: 1


2020
TECHNOLOGIES

Designed: 17/11/2013
Printed: 17/11/2013

4 NO CROWN/
BULKHEAD BY BUILDER

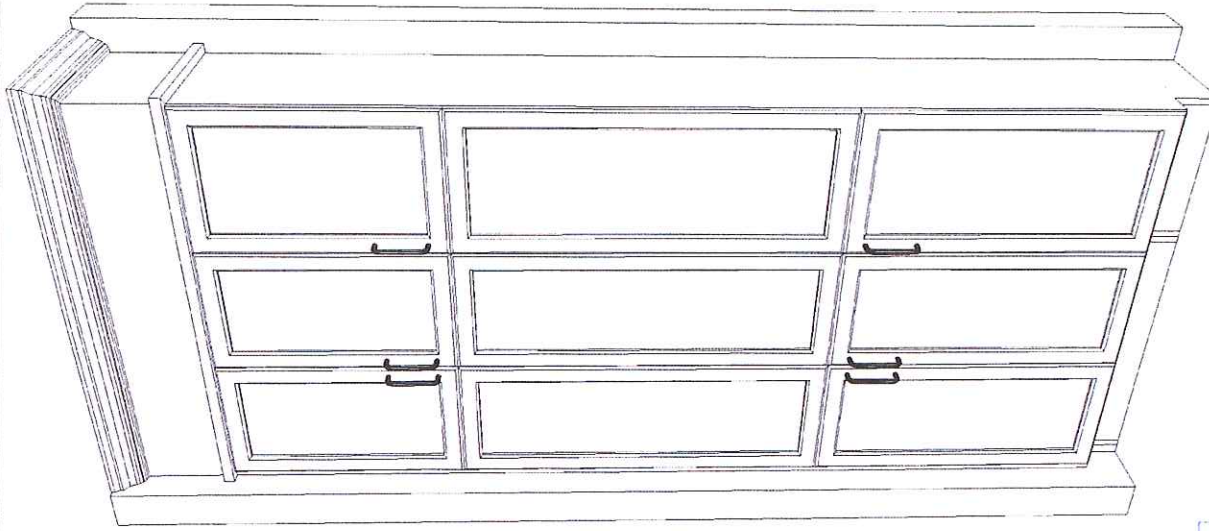

KITCHEN - 3D VIEW #4

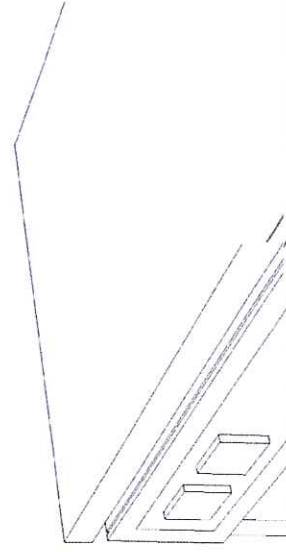

CUSTOMER APPROVAL

I have reviewed these drawings and understand the details of the layout and the Cartier Kitchens specifications.

Signature AZ

Date Feb. 28/14

Note: This drawing is an artistic interpretation of the general appearance of the design. It is not meant to be an exact rendition.


Drawn By: Lori D Saverio, B.I.D.
Cartier Kitchens Ottawa
DCR - #37 FBC - Kitchen - C10 - ROSEMERE.kit



Designed: 17/11/2013
Printed: 17/11/2013

Drawing #: 1

NO CROWN

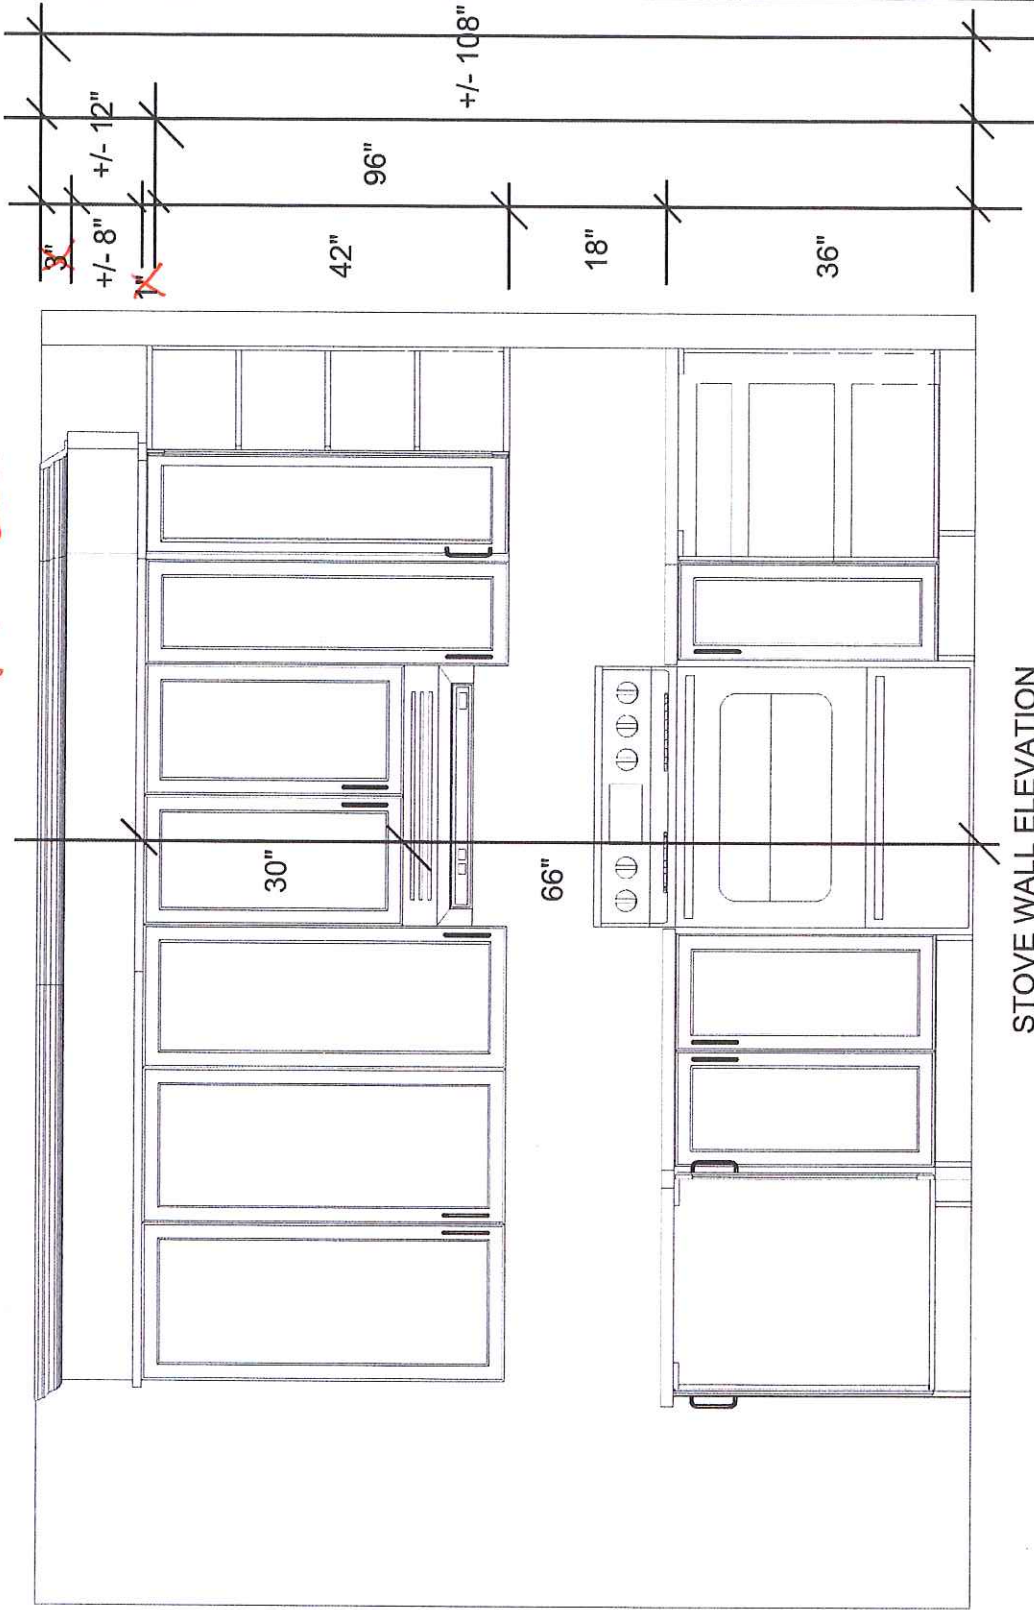

STOVE WALL ELEVATION

CUSTOMER APPROVAL

I have reviewed these drawings and understand the details of the layout and the Cartier Kitchens specifications.

AL

Signature

Date Feb. 28/14

Note: This drawing is an artistic interpretation of the general appearance of the design. It is not meant to be an exact rendition.

Drawn By: Lori D Saverio, B.I.D.
Cartier Kitchens Ottawa

DCR - #37 FBC - Kitchen - C10 - ROSEMERE .kit




All

Drawing #: 1

2020
TECHNOLOGIES

Designed: 17/11/2013
Printed: 17/11/2013

* NO CROWN

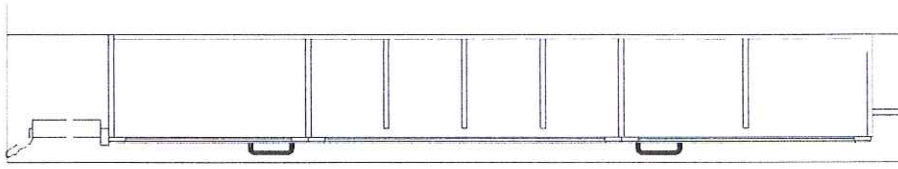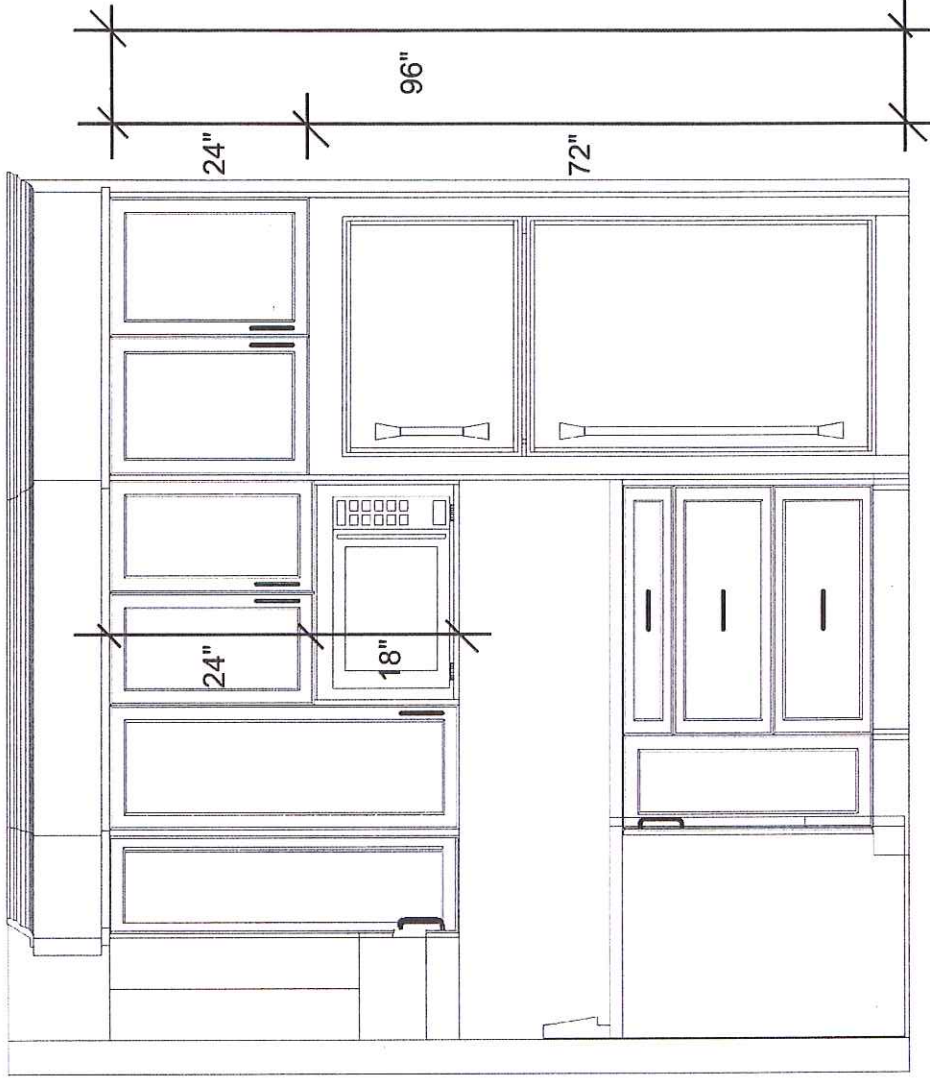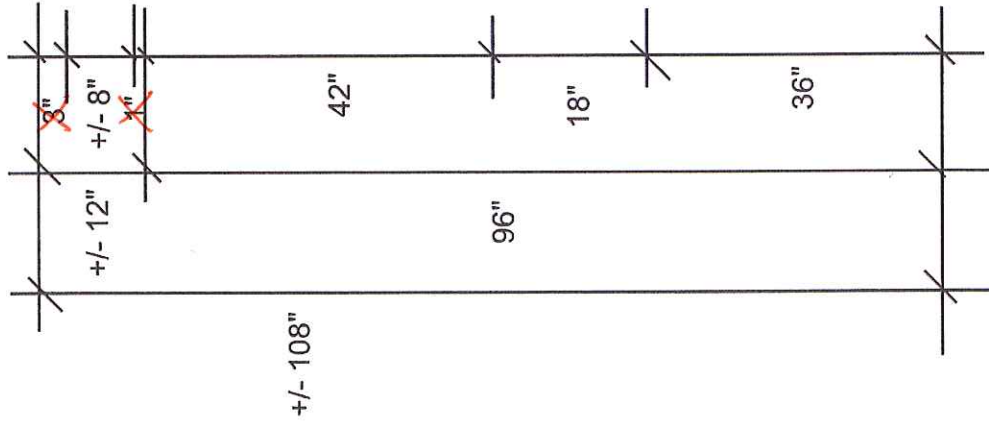

FRIDGE WALL ELEVATION

CUSTOMER APPROVAL

I have reviewed these drawings and understand the details of the layout and the Cartier Kitchens specifications.

Signature

Date

AZ

Feb. 28/14

Note: This drawing is an artistic interpretation of the general appearance of the design. It is not meant to be an exact rendition.

Drawn By: Lori D Saverio, B.I.D.
Cartier Kitchens Ottawa
DCR - #37 FBC - Kitchen - C10 - ROSEMERIE .kit




Designed: 17/11/2013
Printed: 17/11/2013

All

Drawing #: 1

+NO CROWN.

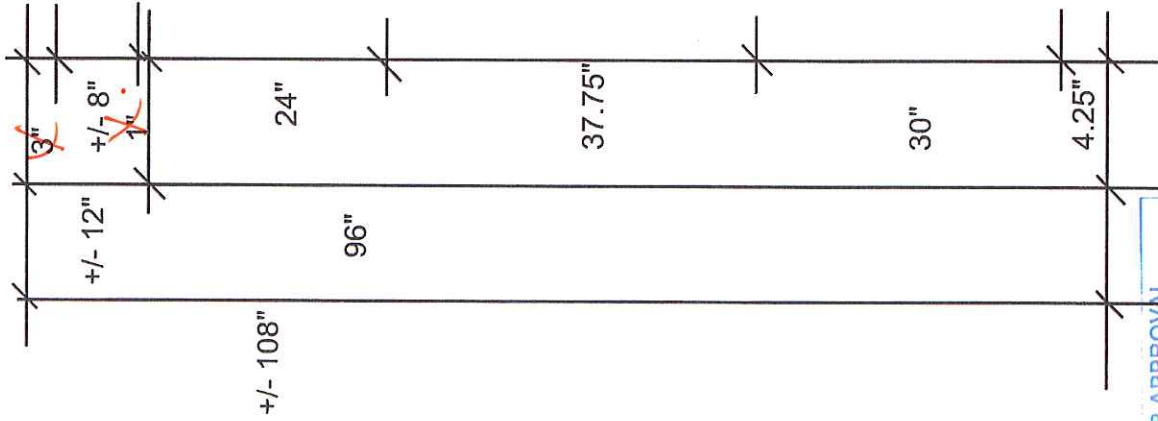

PANTRY WALL ELEVATION

CUSTOMER APPROVAL

I have reviewed these drawings and understand the details of the layout and the Cartier Kitchens specifications.

Signature

Date

AZ

Feb. 28/14

Note: This drawing is an artistic interpretation of the general appearance of the design. It is not meant to be an exact rendition.

Drawn By: Lori D Saverio, B.I.D.
Cartier Kitchens Ottawa

DCR - #37 FBC - Kitchen - C10 - ROSEMERE .kit

All

Drawing #: 1



Designed: 17/11/2013
Printed: 17/11/2013

Family Package #2



Location	Kitchen, Family rm, Laundry, Bed, Den, Bath ceiling, Basement
CP Item #:	A3013-11
Description:	Flush Mount - Brushed Nickel with Marble Glass
Category:	Ceiling Fixture(Flush)
Finish:	Brushed Nickel
Family:	
Diameter:	13 1/8"
Height:	5"
Lamp Quantity:	2
Lamp Type:	A19, Med. Base
Lamp Wattage:	60W
Price:	



Location	Entry, Hall, Bed cathedral
CP Item #:	FM100-05
Description:	Semi-Flush - Brushed Nickel with Marbled Glass
Category:	Semi-Flush Mount
Finish:	Brushed Nickel
Family:	Diamante
Diameter:	13"
Height:	9"
Lamp Quantity:	2
Lamp Type:	A19
Lamp Wattage:	60W
Price:	



Location	Dinette
CP Item #:	ICH256A03BPT
Description:	Pendant - Brushed Pewter with Flat Opal Glass
Category:	Pendant(Island light)
Finish:	Brushed Pewter
Family:	New Yorker Collection
Diameter:	19"
Height:	18"
Lamp Quantity:	3
Lamp Type:	A19, Med. Base
Lamp Wattage:	100W
Price:	



Location	Stair, High Entry, Dining
CP Item #:	ICH256A05BPT
Description:	Chandelier - Brushed Pewter with Flat Opal Glass
Category:	Chandelier
Finish:	Brushed Pewter
Family:	New Yorker Collection
Diameter:	21"
Height:	21 1/2"
Lamp Quantity:	5
Lamp Type:	A19, Med. Base
Lamp Wattage:	100W
Price:	



Location	Wall
CP Item #:	IWF256A01BPT
Description:	Single Wall Bracket - Brushed Pewter with Flat Opal Glass
Category:	Wall Sconce
Finish:	Brushed Pewter
Family:	
Width:	5"
Height:	8"
Extension:	7"
Lamp Quantity:	1
Lamp Type:	A19, Med. Base
Lamp Wattage:	60W
Price:	



Location	Bathroom Vanity
CP Item #:	A14012-11
Description:	Two Light Vanity - Brushed Nickel with Marbled Glass
Category:	Vanity Light
Finish:	Brushed Nickel
Family:	Roma
Width:	18"
Height:	6"
Extension:	7.5"
Lamp Quantity:	2
Lamp Type:	A19, Med. Base
Lamp Wattage:	60W
Price:	



Location	Bathroom Vanity
CP Item #:	A14014-11
Description:	Four Light Vanity - Brush Nickel with Marbled Glass
Category:	Vanity Light
Finish:	Brushed Nickel
Family:	Roma
Width:	30"
Height:	6"
Extension:	7.5"
Lamp Quantity:	4
Lamp Type:	A19, Med. Base
Lamp Wattage:	60W
Price:	



Location	Bathroom Vanity
CP Item #:	A14013-11
Description:	Three Light Vanity - Brush Nickel with Marbled Glass
Category:	Vanity Light
Finish:	Brushed Nickel
Family:	Roma
Width:	24"
Height:	6"
Extension:	7.5"
Lamp Quantity:	3
Lamp Type:	A19, Med. Base
Lamp Wattage:	60W
Price:	

LOT 37 FC
POWDER, MAIN
& ENSUITE