



PAINT SCHEME 1/2

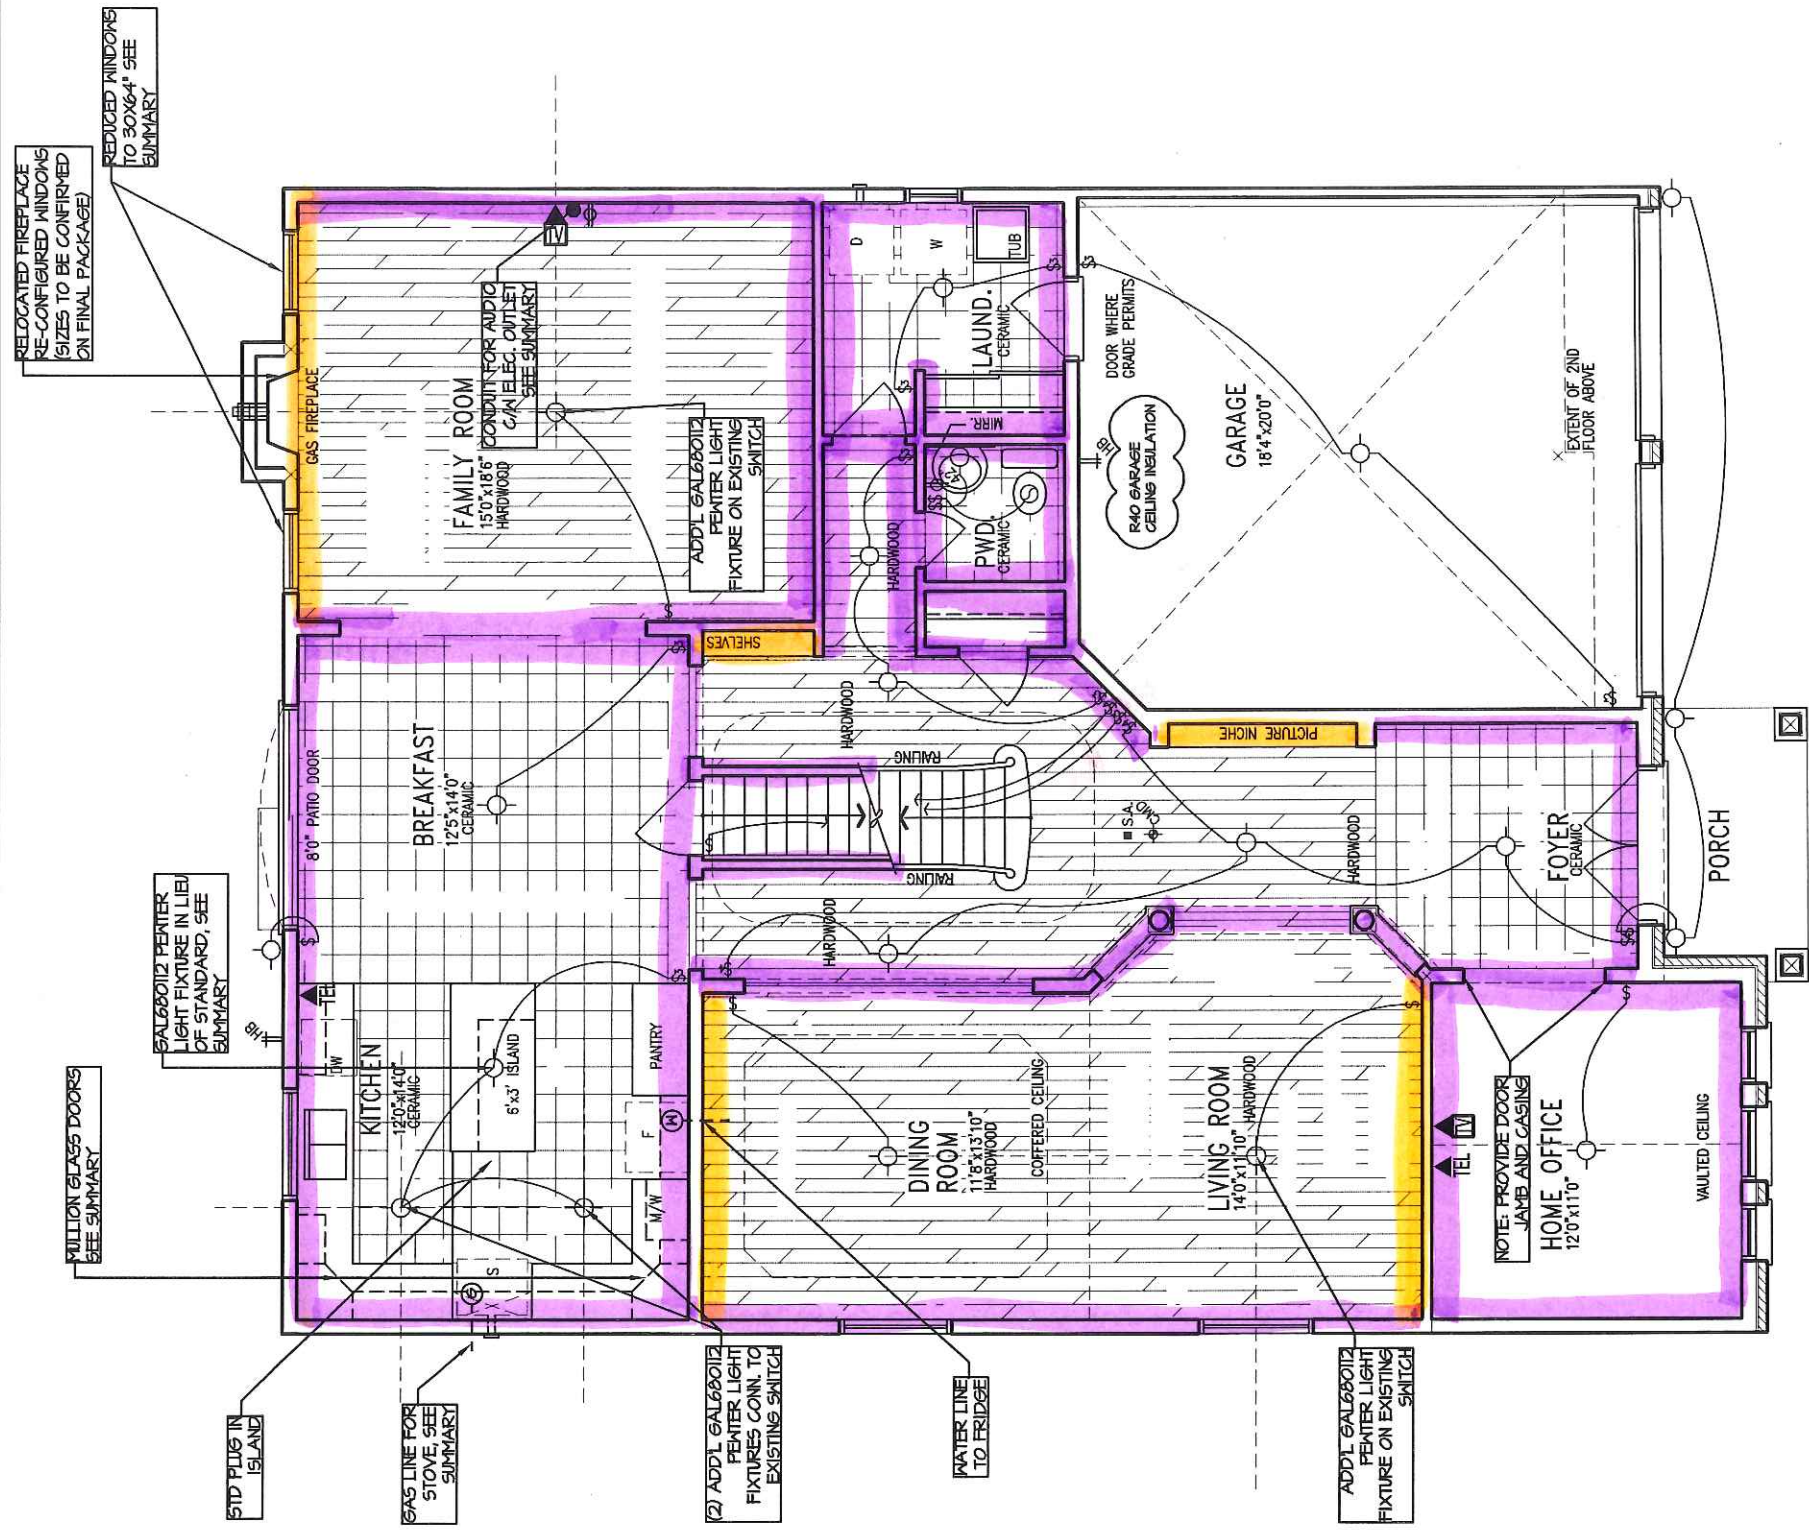

GROUND FLOOR PLAN 'A'

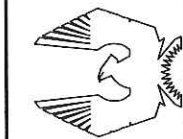

Viljoen
Architect
Inc.

300 A. Wilson Avenue
North 158, Ontario
M3H 1S8
TEL: (416) 630-2255
FAX: (416) 630-4762

PHOENIX HOMES

PLATINA-2007-A

SITE: FERNBANK

LOT NUMBER:

45


CIVIC ADDRESS:

454 CAVESSON ST.

Footprint:	512
Shl. Title:	GROUND FLOOR PLAN A
Drawn by:	IV
Checked by:	
Date:	JULY 2001
Scale:	3/16"=1'
Sheet no:	3A
	9

No.	Description	Date	By
3	REV. AS PER CONST. SUMMARY	DEC14-15	SD
2	RELOC. FP IN FAM. RM. / WINDOWS	OCT25-15	SD
1	ISSUED FOR FOUNDATION ONLY	OCT1-15	SD
PHOENIX REVISIONS			

PAIN'T SCHEME 2/2

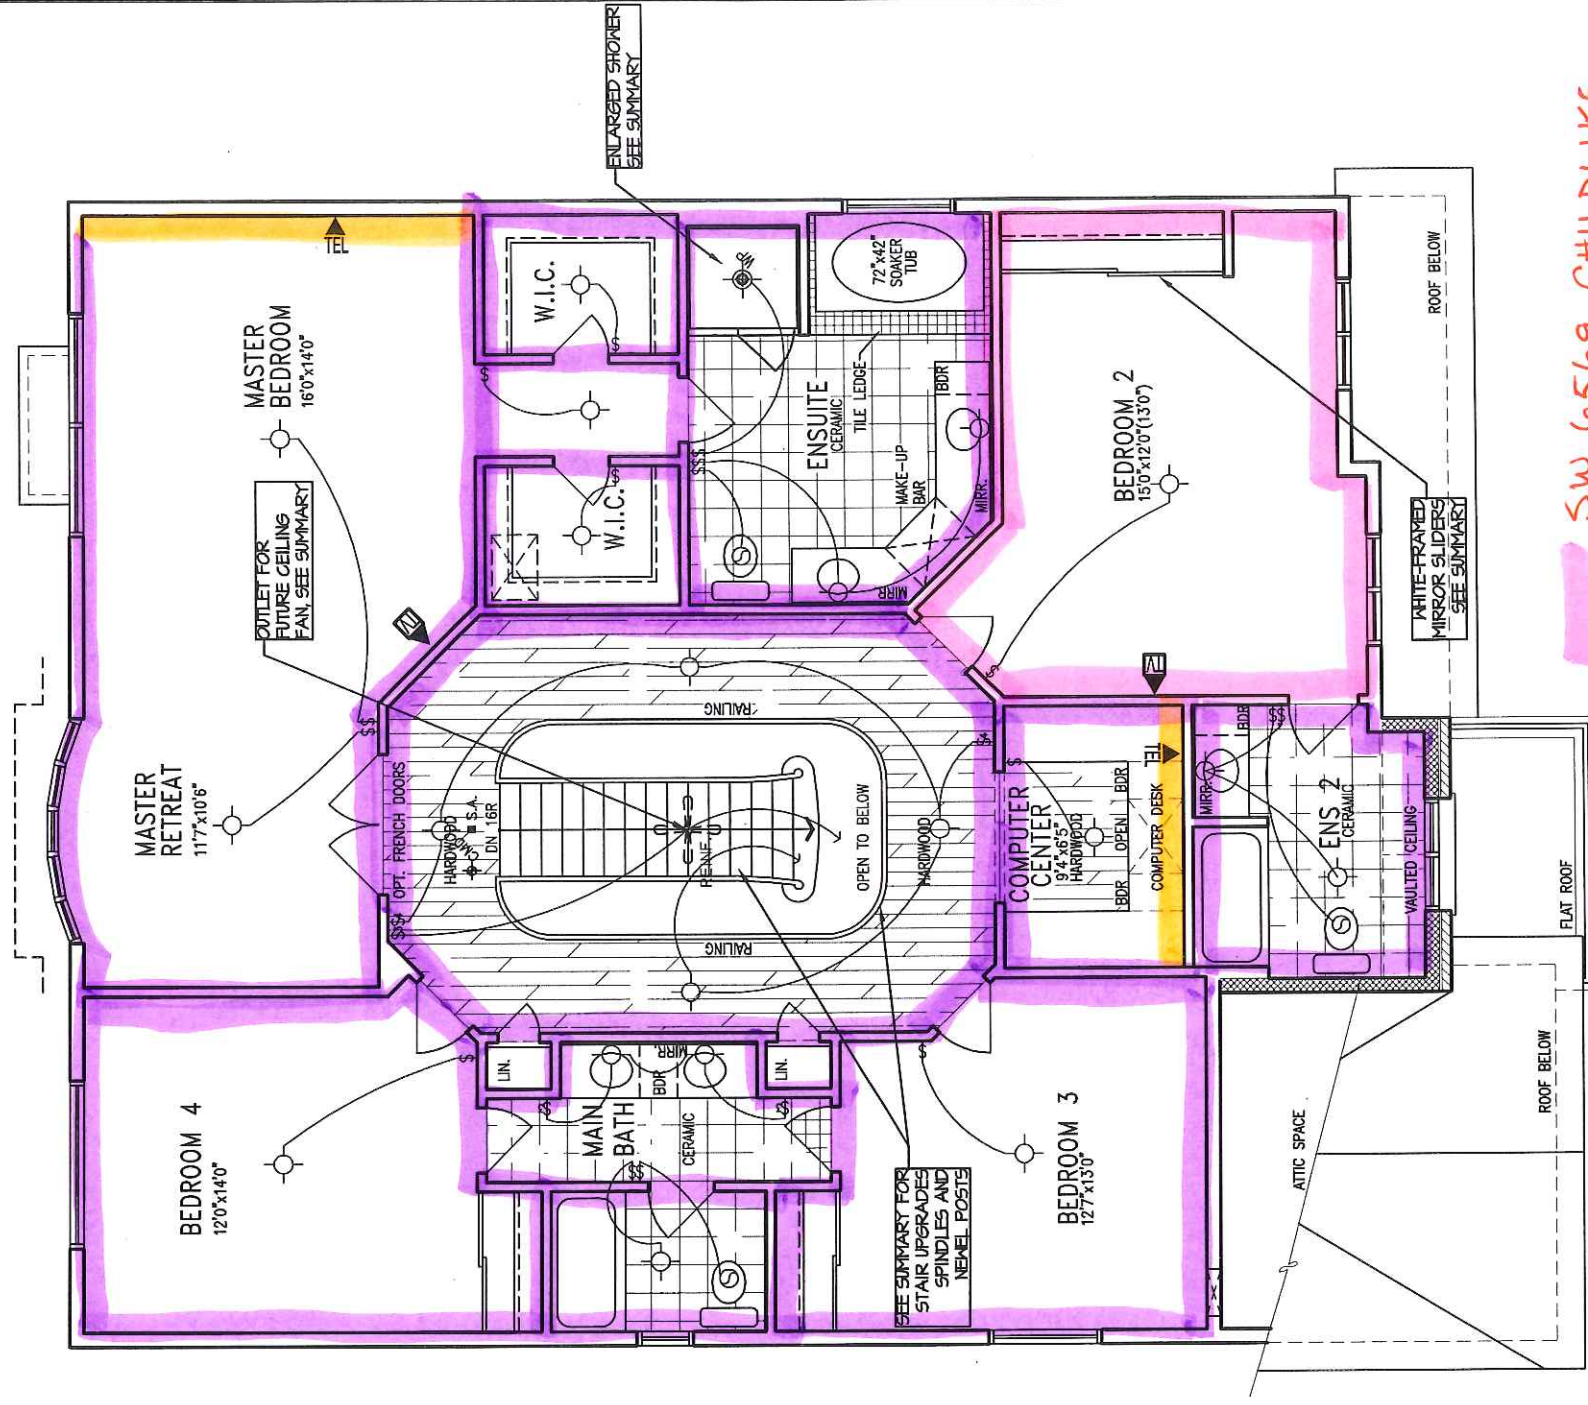

SW 6569 CHILDLIKE

SW 6106 KILIM BEIGE

SW 6108 LATTE

SECOND FLOOR PLAN 'A'

H.T

21



PHOENIX HOMES

**Viljoen
Architect
Inc.**

300 A Wilson Avenue
Toronto, Ontario
M3H 1S9
TEL: (416) 630-2255
FAX: (416) 630-4782

PLATINA-2007-A	
SITE:	FERNBANK
LOT NUMBER:	45
CIVIC ADDRESS: 459 CAYESSE ST.	

[illegible]

footprint:	5 2		
slt. title:	SECOND FLOOR PLAN A		
drawn by:	N		
checked by:	.		
date:	JULY 2001		
scale:	3/16"=1'		
sheet no:	<table border="1"> <tr> <td></td> <td> 4A 9 </td> </tr> </table>		4A 9
	4A 9		