

DCR PHOENIX HOMES

FERNBANK CROSSING

LOT #53

C10 - ROSEMERE - LEFT

KITCHEN - REVISED FEB 2, 2014

MOUNTING HT: 96"

~~CROWN MOULDING~~

LIGHT VALANCE

CUSTOMER APPROVAL



I have reviewed these drawings and understand the details of the layout and the Carrier Kitchens specifications.

A.C. *me*

Signature

Date Mar. 6/14

FLUSH
BAR TOP

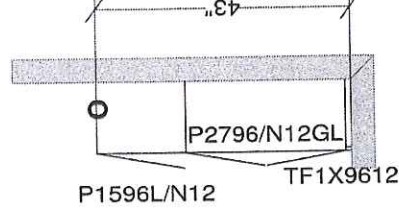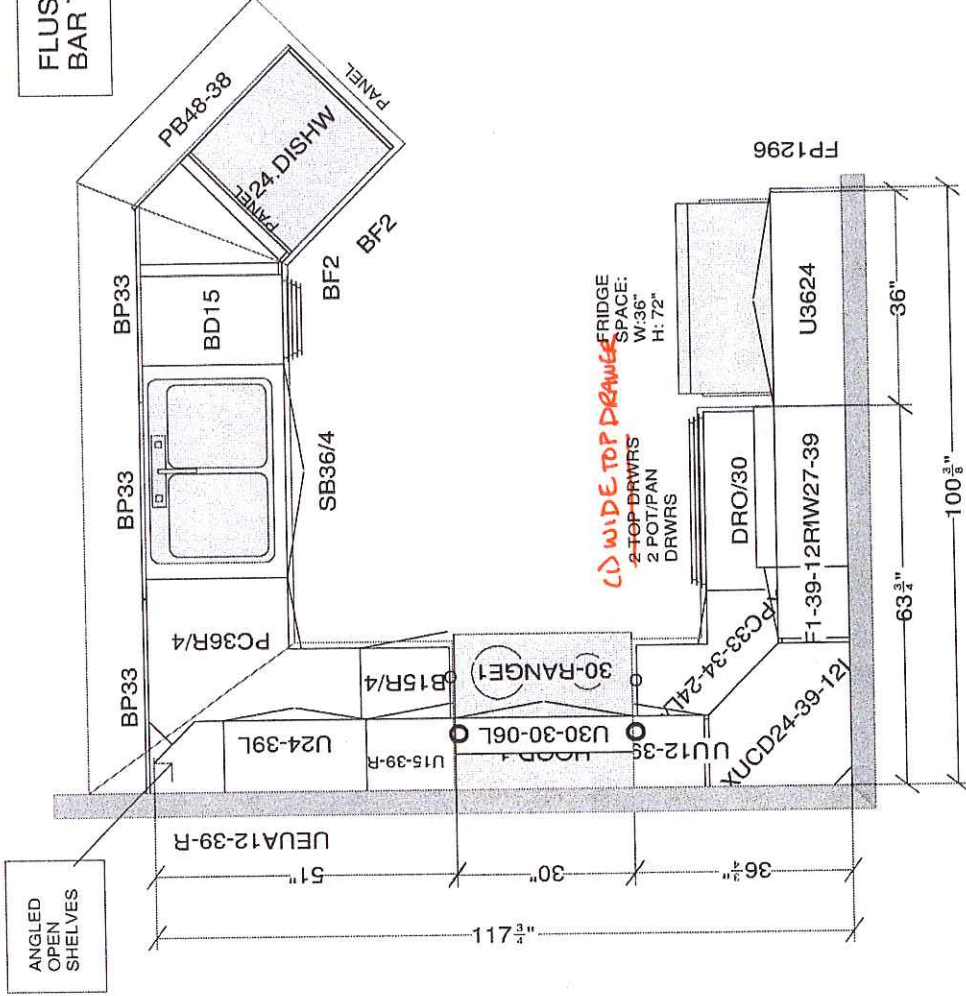

All dimensions, size designations given are subject to verification on job site and adjustment to fit job conditions.

Carrier Kitchens Ottawa



This is an original design and must not be released or copied unless applicable fee has been paid or job order placed.

Drawn by: Lori Di Saverio, B.I.D.
Carrier Kitchens Ottawa

Designed: 05/10/2013
Printed: 02/02/2014

DCR - #53 - KITCHEN - C10 - ROSEMERE.kit

All

Drawing #: 1 No Scale.


CUSTOMER APPROVAL

I have reviewed these drawings and understand the details of the layout and the Cartier Kitchens specifications.

Signature: A.C. Mc

Date: May. 6/14

KITCHEN - 3D VIEW #1

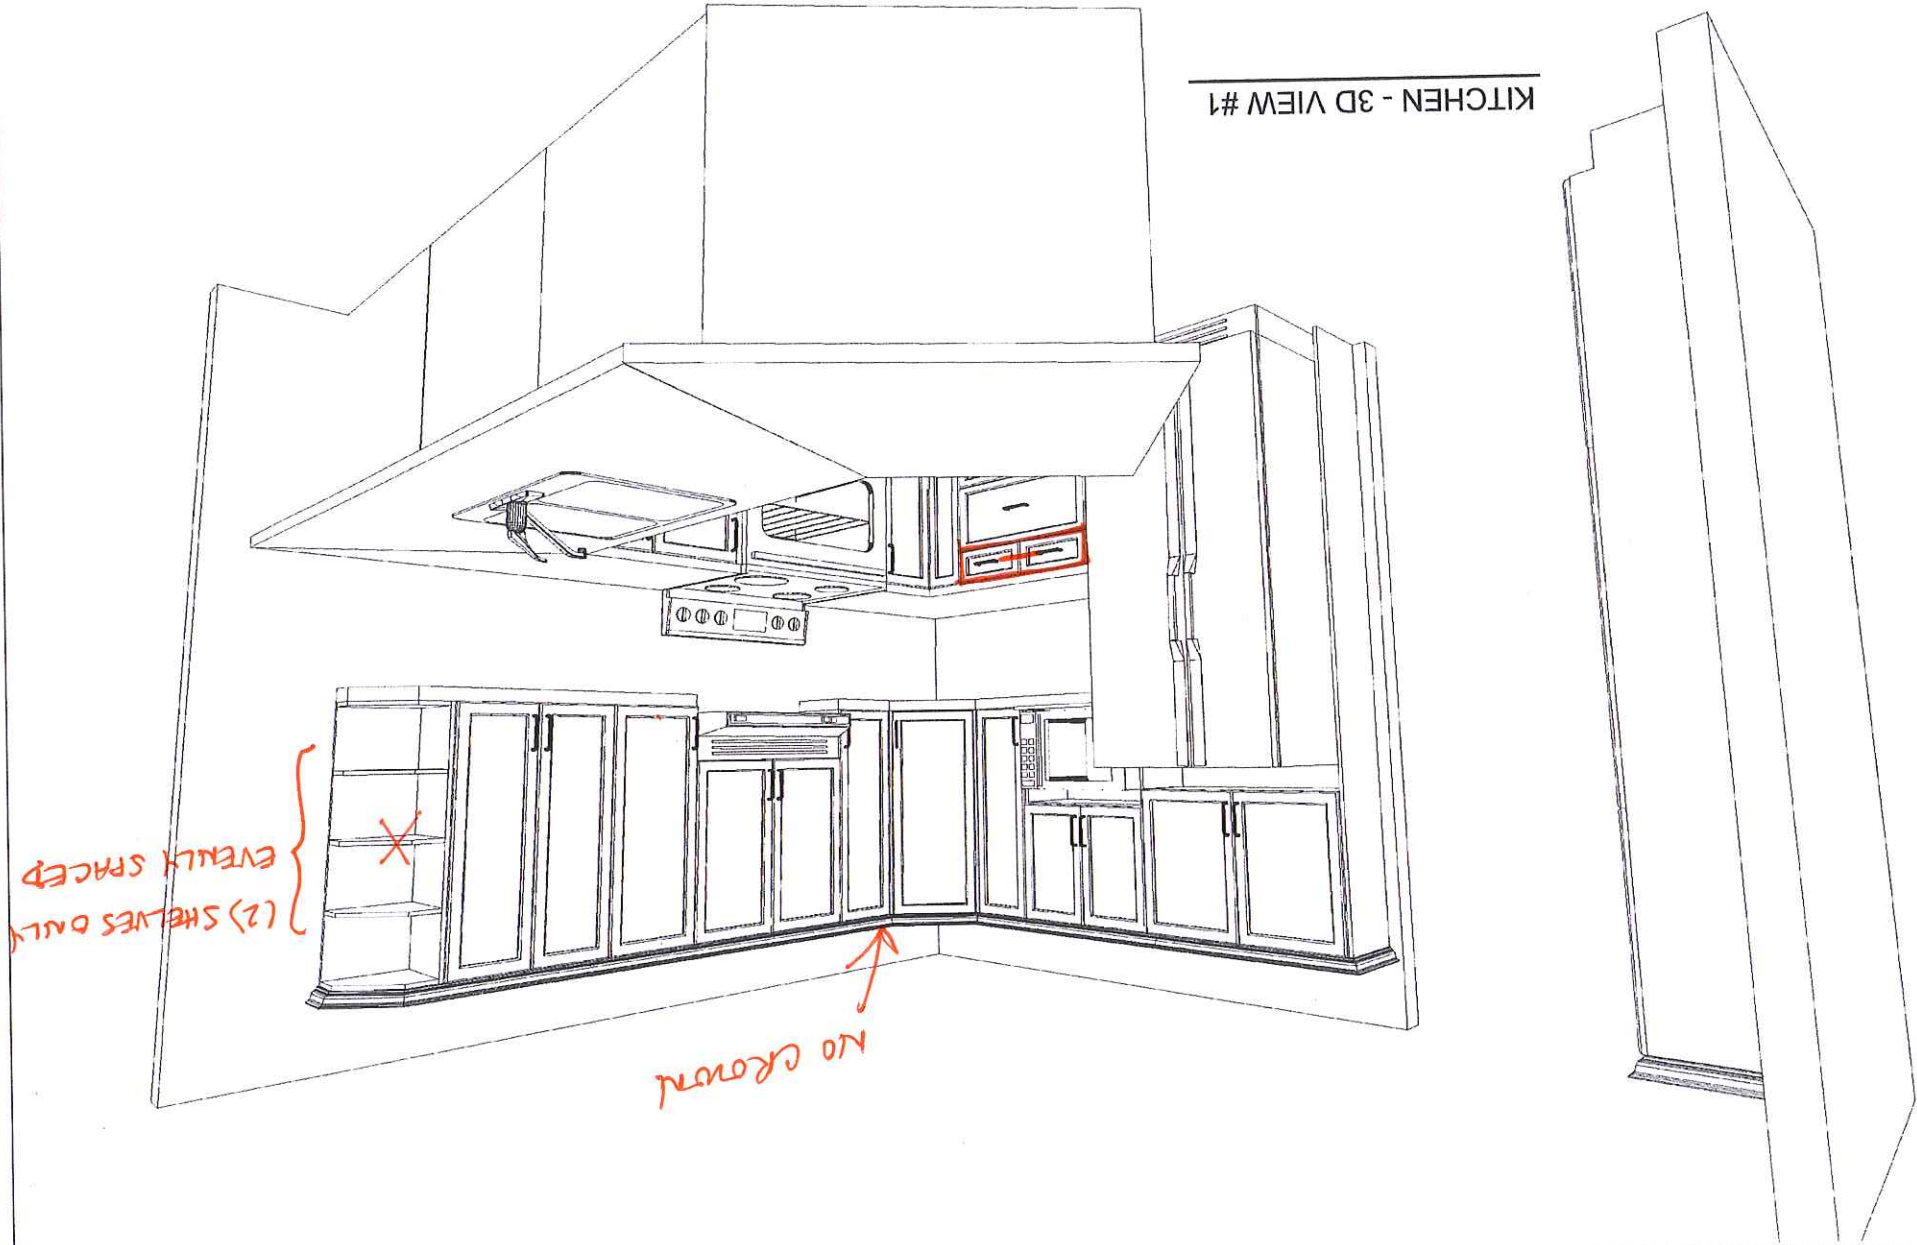

Note: This drawing is an artistic interpretation of the general appearance of the design. It is not meant to be an exact rendition.

Drawn By: Lori D Saverio, B.I.D.
Cartier Kitchens Ottawa

DCR - #53 - KITCHEN - C10 - ROSEMERE.kit

All

Drawing #: 1

Designed: 05/10/2013
Printed: 02/02/2014

2020 TECHNOLOGIES

CUSTOMER APPROVAL

I have reviewed these drawings and understand the details of the layout and the Carlier kitchens specifications.

Signature: Mc Mc

Date: Mar. 6/14

KITCHEN - 3D VIEW #4



Note: This drawing is an artistic interpretation of the general appearance of the design. It is not meant to be an exact rendition.

Drawn By: Lori D Saverio, B.I.D.
Carlier Kitchens Ottawa



All

DCR - #53 - KITCHEN - C10 - ROSEMERE.kit

Drawing #: 1

Designed: 05/10/2013
Printed: 02/02/2014


CUSTOMER APPROVAL

I have reviewed these drawings and understand the details of the layout and the Carlier Kitchens specifications.

Signature: *AC Mc*

Date: *Mar. 6/14*

KITCHEN - 3D VIEW #2

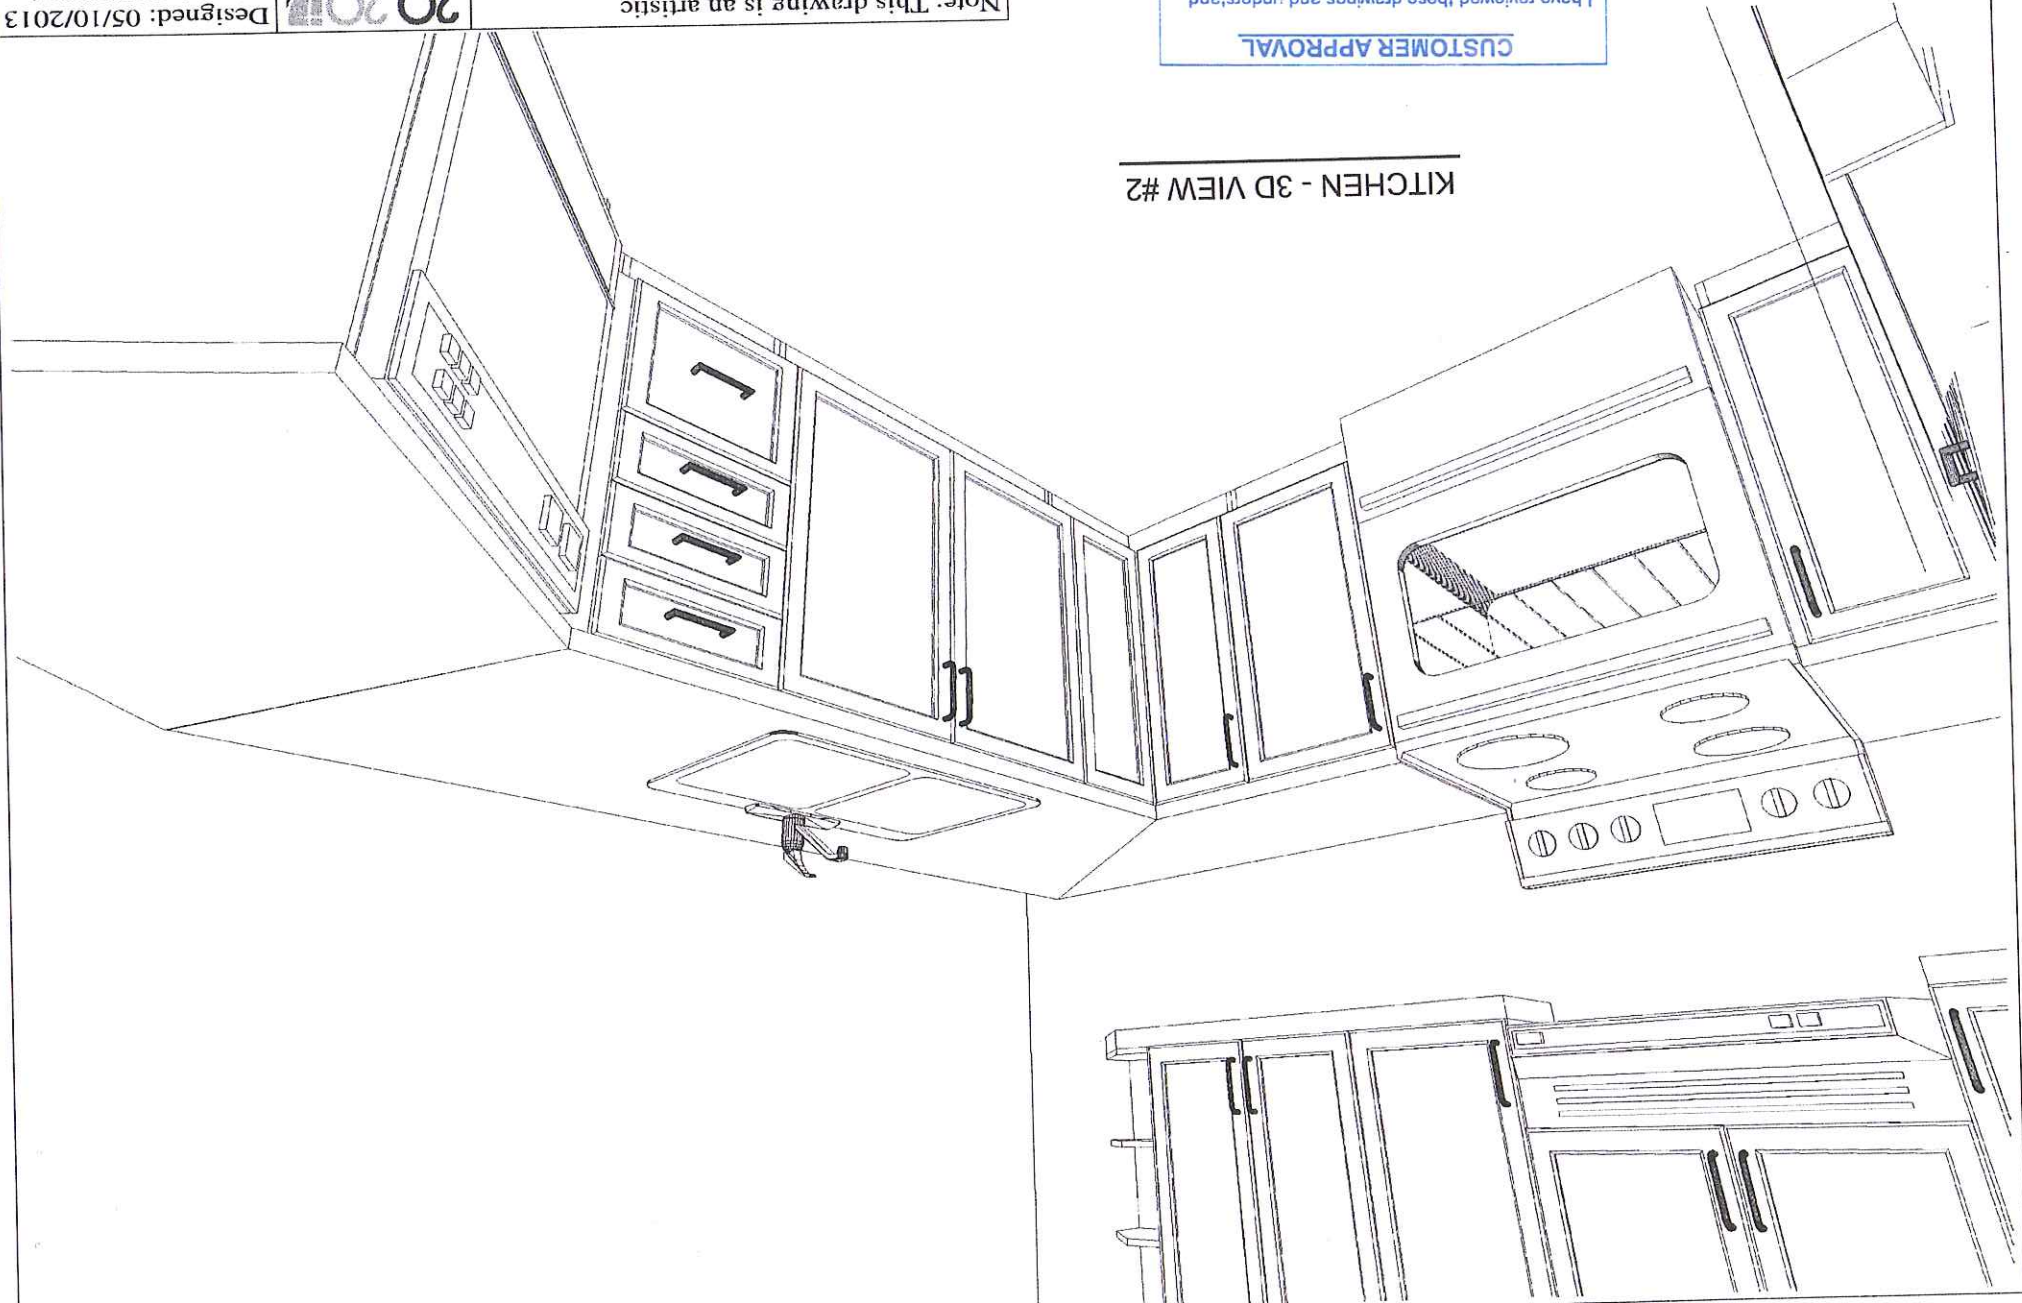

Note: This drawing is an artistic interpretation of the general appearance of the design. It is not meant to be an exact rendition.

Drawn By: Lori D Saverio, B.I.D.
Carlier Kitchens Ottawa

DCR - #53 - KITCHEN - C10 - ROSEMERE.kit

DESIGNED BY 2020 TECHNOLOGIES

Designed: 05/10/2013
Printed: 02/02/2014

Drawing #: 1