


KITCHEN - 3D VIEW #3

CUSTOMER APPROVAL

I have reviewed these drawings and understand the details of the layout and the Carlier Kitchens specifications.

Signature: A.C. Mc

Date: Mar. 6/14

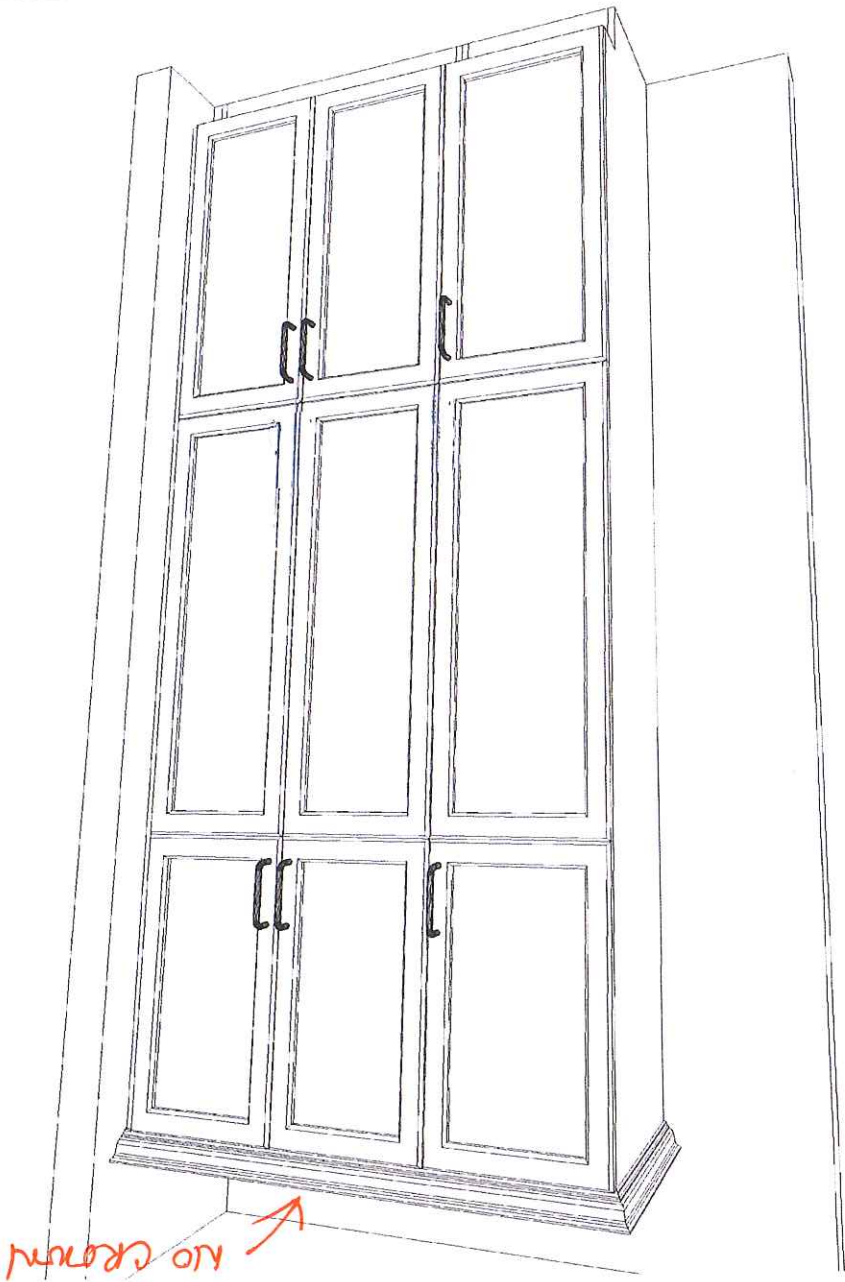

Note: This drawing is an artistic interpretation of the general appearance of the design. It is not meant to be an exact rendition.

Drawn By: Lori D Saverio, B.I.D.
Carlier Kitchens Ottawa

DCR - #53 - KITCHEN - C10 - ROSEMERE.kit

All

Drawing #: 1

Designed: 05/10/2013
Printed: 05/10/2013

2020 TECHNOLOGIES

CUSTOMER APPROVAL

I have reviewed these drawings and understand the details of the layout and the Carlier Kitchens specifications.

Signature: *Mc* *Mc*

Date: *Mar. 6/14*

DCR - #53 - KITCHEN - C10 - ROSEMERRE.kit

Carlier Kitchens Ottawa

Drawn By: Lori D Saverio, B.I.D.

Note: This drawing is an artistic interpretation of the general appearance of the design. It is not meant to be an exact rendition.


2020 TECHNOLOGIES

Designed: 05/10/2013

Printed: 02/02/2014

Drawing #: 1

FRIDGE WALL ELEVATION

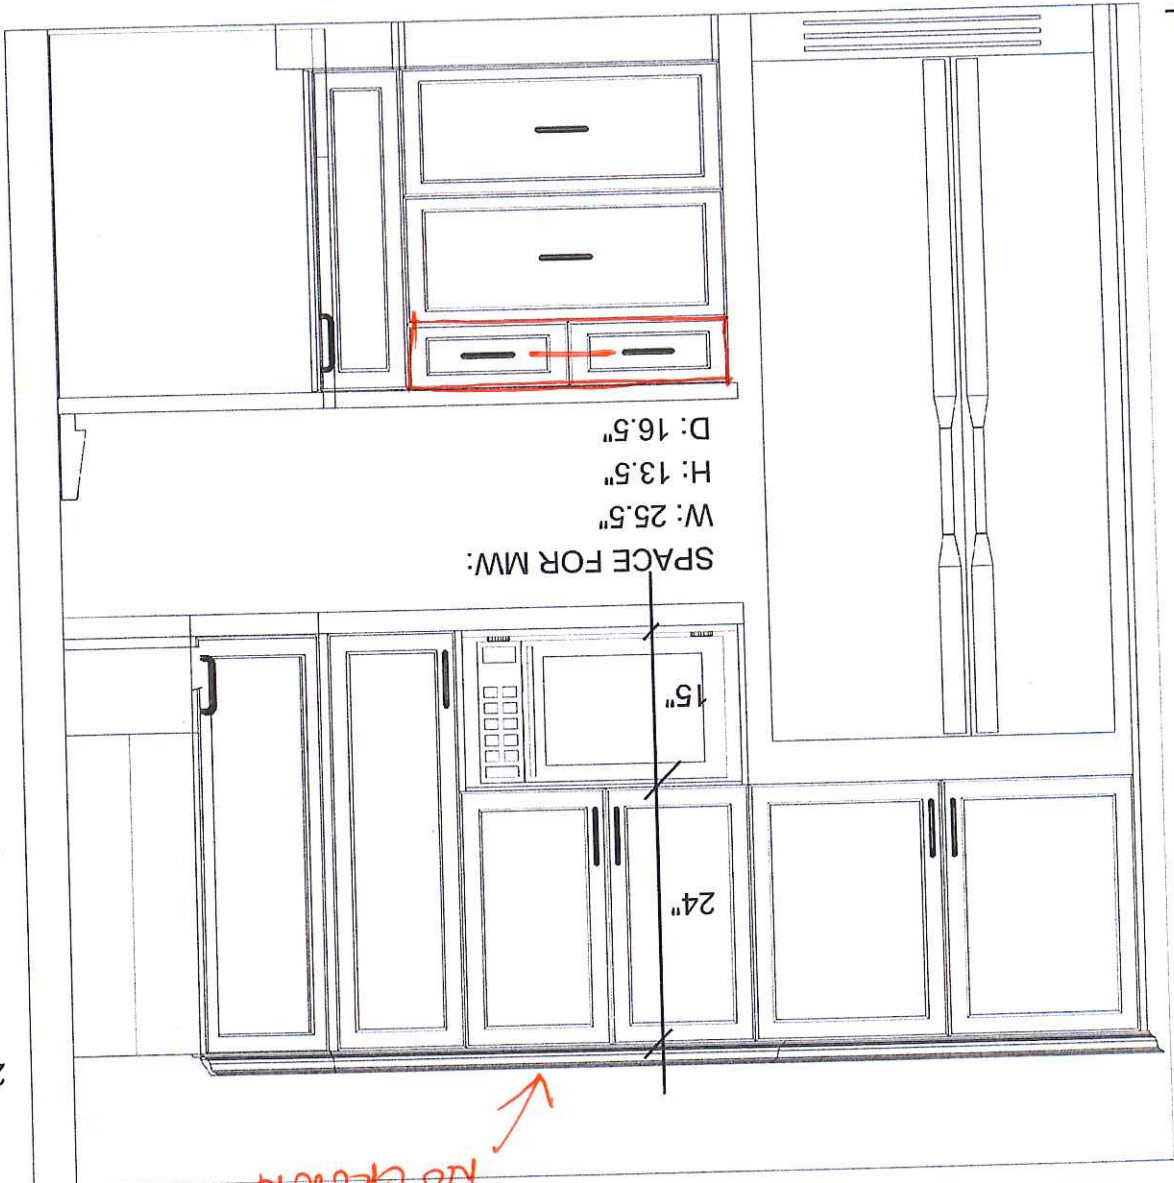

SPACE FOR MW:

W: 25.5"
H: 13.5"
D: 16.5"

no crown

98" 36" 21" 96" 2"

98" 96" 72" 24" 2"

CUSTOMER APPROVAL


I have reviewed these drawings and understand the details of the layout and the Cartier Kitchens specifications.

Signature: *AC Mc*

Date: *Mar. 6/14*

DCR - #53 - KITCHEN - C10 - ROSEMERE.kit		All		Drawing #: 1	
Note: This drawing is an artistic interpretation of the general appearance of the design. It is not meant to be an exact rendition. Drawn By: Lori D Saverio, B.I.D. Cartier Kitchens Ottawa		 2020 TECHNOLOGIES		Designed: 05/10/2013 Printed: 02/02/2014	

STOVE WALL ELEVATION

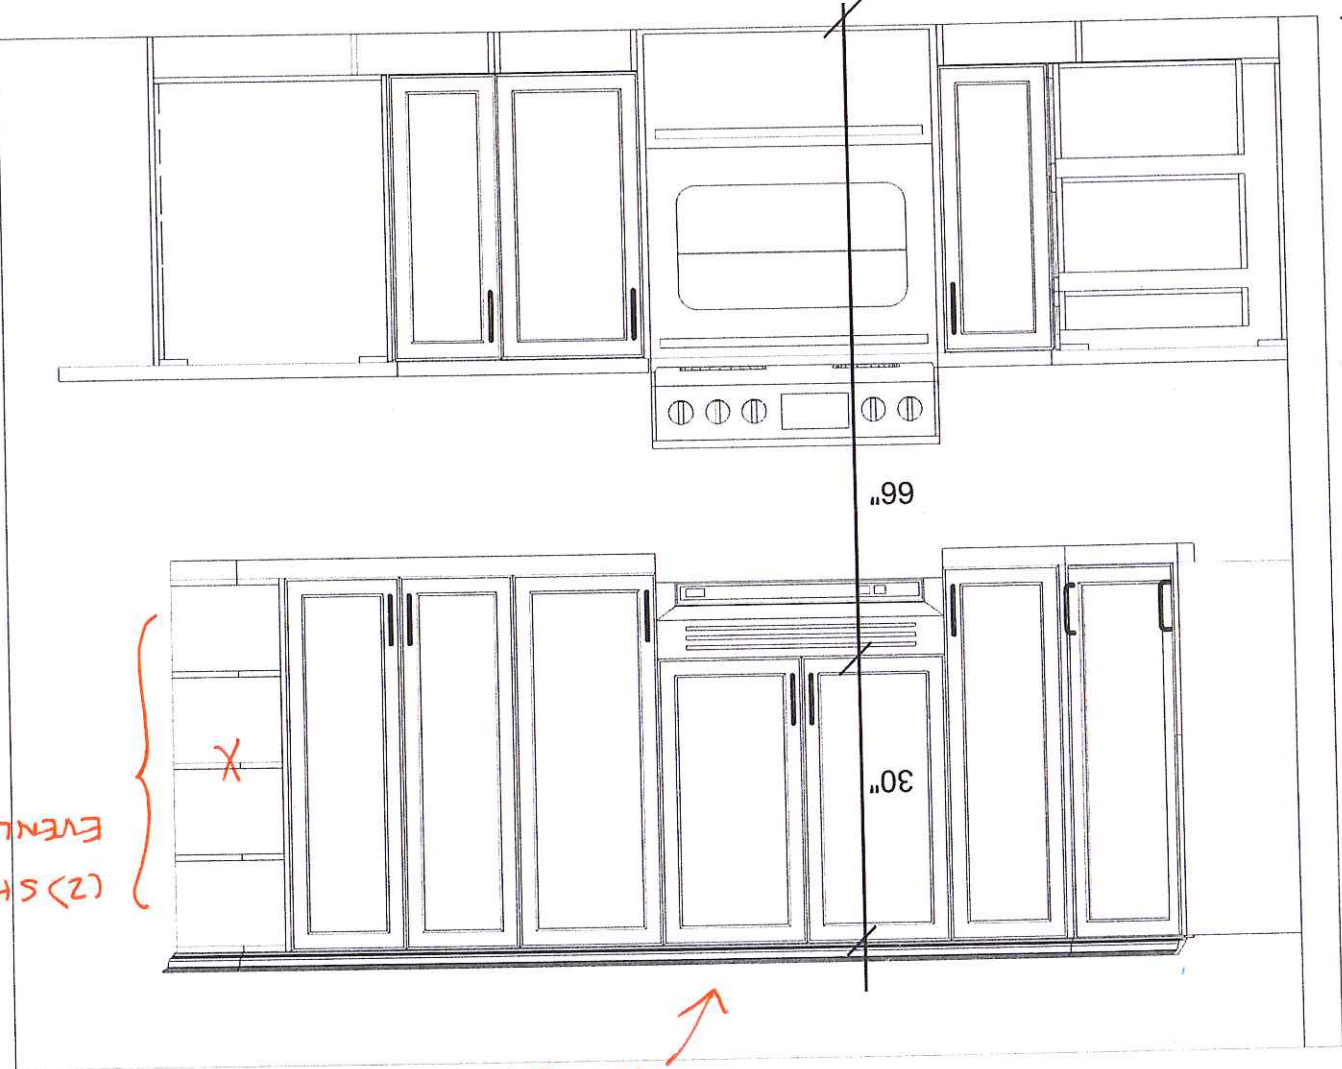

(2) SHELVES ONLY
EVENLY SPACED.

NO CROWN