

DCR PHOENIX HOMES

FERNBANK CROSSING

LOT #78

BRADFORD (35-4)

KITCHEN

REV. SEPT 3, 2013

MOUNTING HEIGHT - 84"

LINE -

HARDWARE -

STD WHITE INTERIOR

METAL DRWR BOX

3 PCS - 5/8" KICK

2 PCS - LOOSE FILLER - 6 x 96

1 PC - T-MOULD

CUSTOMER APPROVAL

I have reviewed these drawings and understand the details of the layout and the Cartier Kitchens specifications.


RG-166

Signature

Date Oct. 17/13

2 CLEAR GLASS DOORS (PLAIN FRAME)

UPPER ANGLED OPEN SHELVES

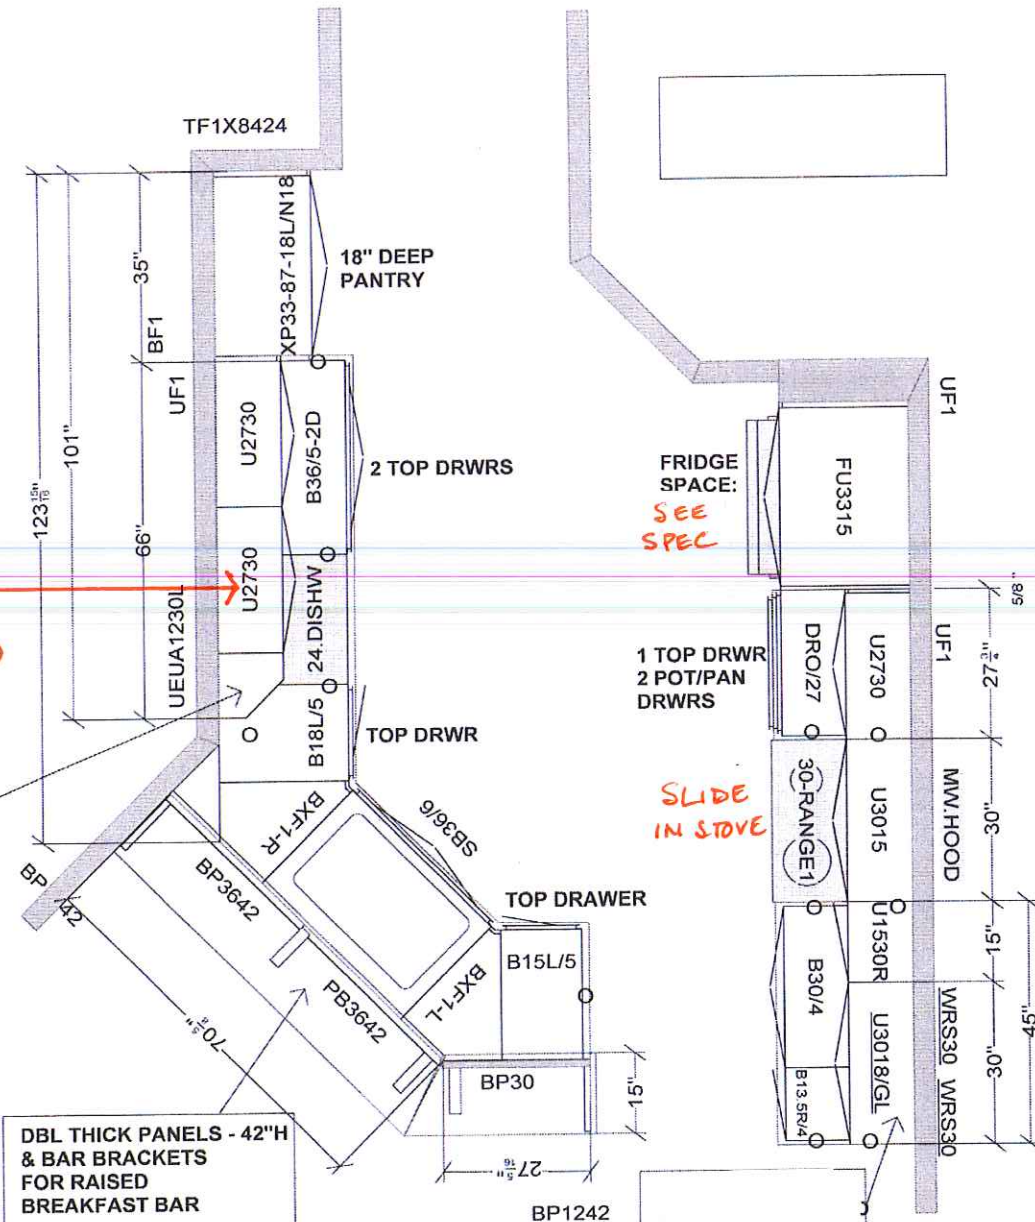

All dimensions size designations given are subject to verification on job site and adjustment to fit job conditions.

Cartier Kitchens Ottawa

2020 TECHNOLOGIES

This is an original design and must not be released or copied unless applicable fee has been paid or job order placed.


Drawn by: Lori Di Saverio, B.I.D. Cartier Kitchens Ottawa

Designed: 05/09/2013
Printed: 05/09/2013

DCR - #78 FBC - BRADFORD (35-4) - KITCHEN .kit

All

Drawing #: 1 No Scale.

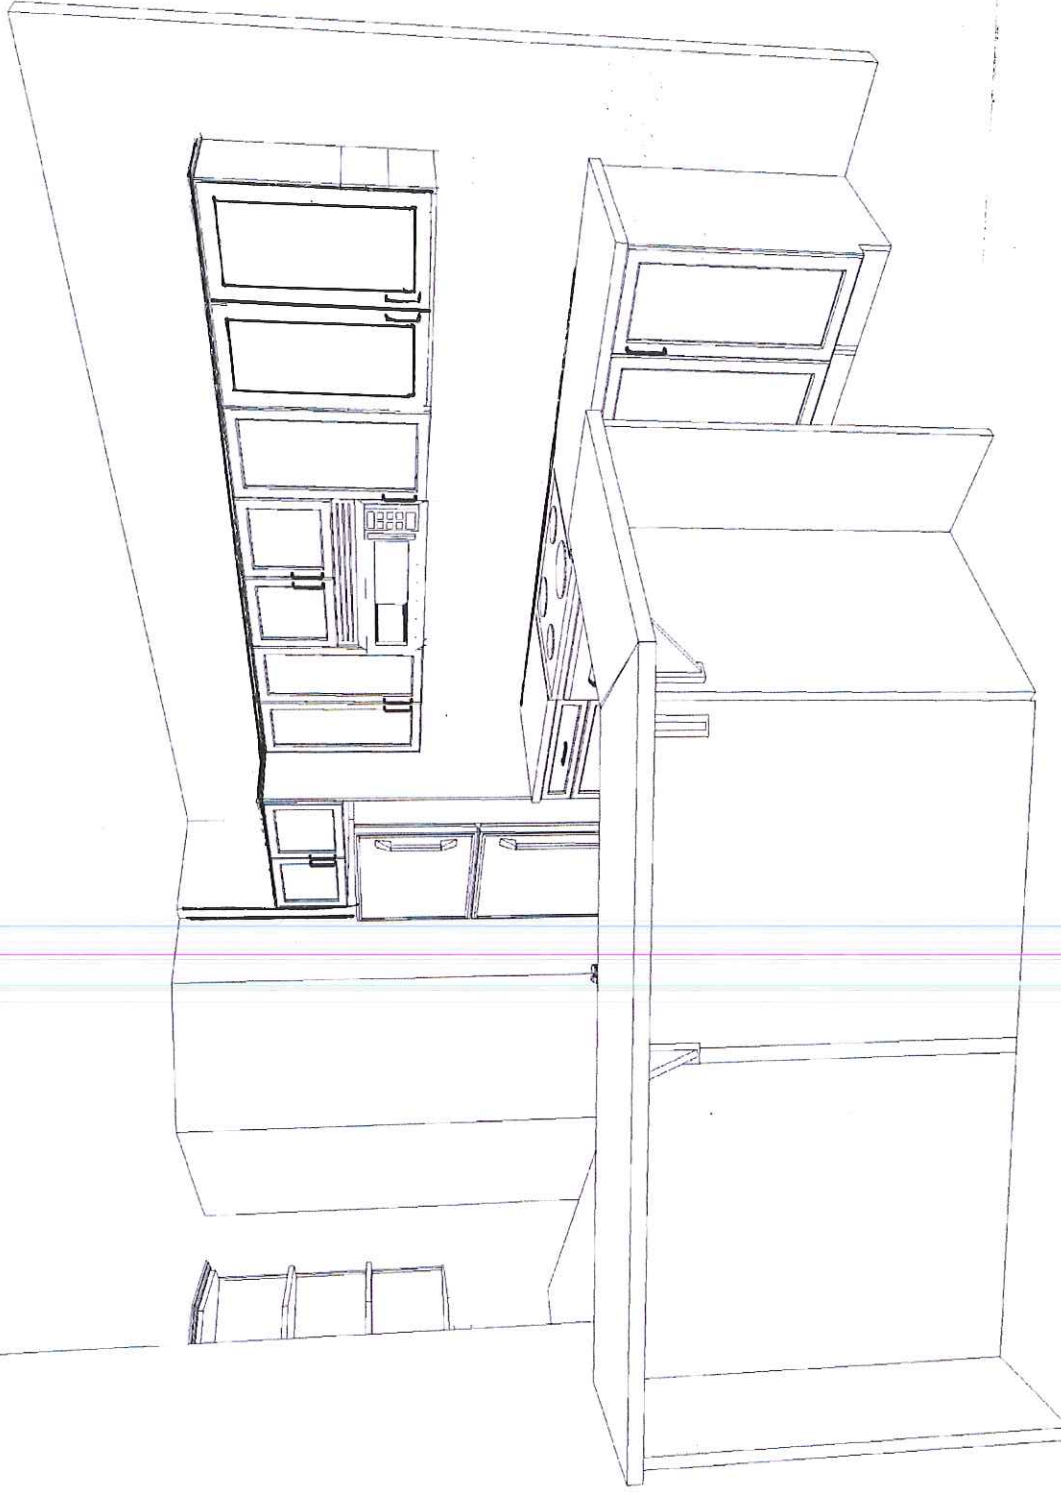

KITCHEN - 3D VIEW #1

I have reviewed these drawings and understand the details of the layout and the Cartier Kitchens specifications.

RG-106

Signature

Date Oct. 17/13

Note: This drawing is an artistic interpretation of the general appearance of the design. It is not meant to be an exact rendition.

Drawn By: Lori D Saverio, B.I.D.
Cartier Kitchens Ottawa


DCR - #78 FBC - BRADFORD (35-4) - KITCHEN

All

Drawing #: 1

2020
TECHNOLOGIES

Designed: 05/09/2013
Printed: 05/09/2013

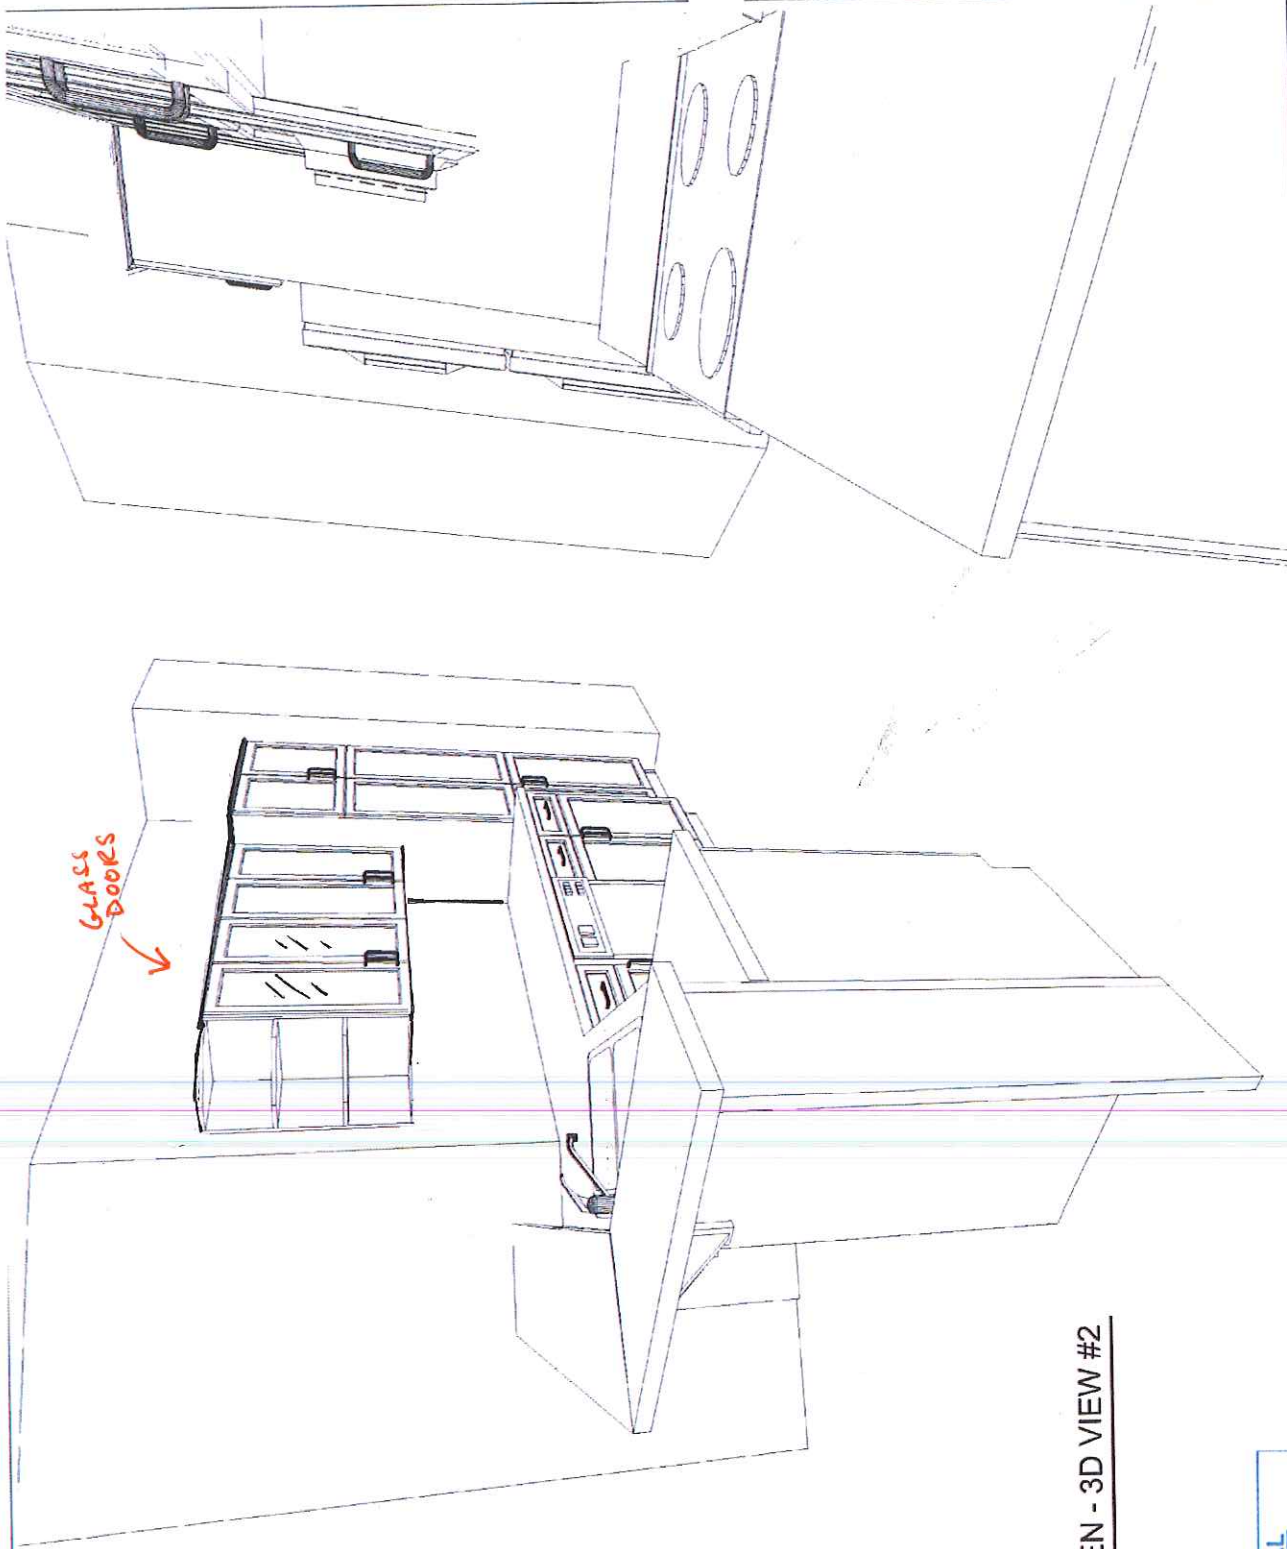

KITCHEN - 3D VIEW #2

CUSTOMER APPROVAL

I have reviewed these drawings and understand the details of the layout and the Cartier Kitchens specifications.

RG 106

Signature

Date Oct. 17/13

Note: This drawing is an artistic interpretation of the general appearance of the design. It is not meant to be an exact rendition.

Drawn By: Lori D Saverio, B.I.D.
Cartier Kitchens Ottawa
DCR - #78 FBC - BRADFORD (35-4) - KITCHEN


2020
TECHNOLOGIES

Designed: 05/09/2013
Printed: 05/09/2013


All

KITCHEN

Drawing #: 1

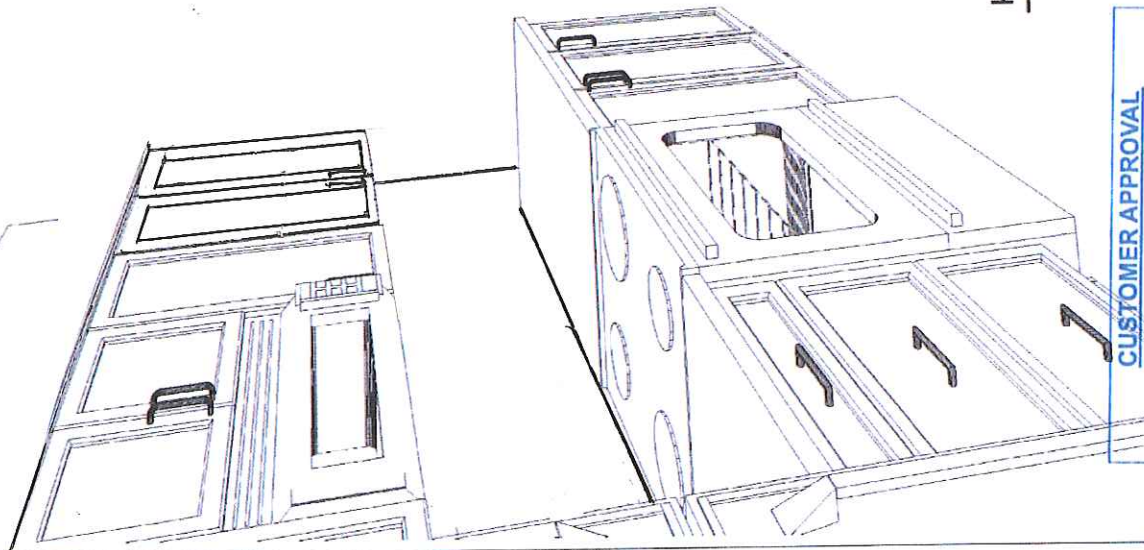

KITCHEN- 3D VIEW #3

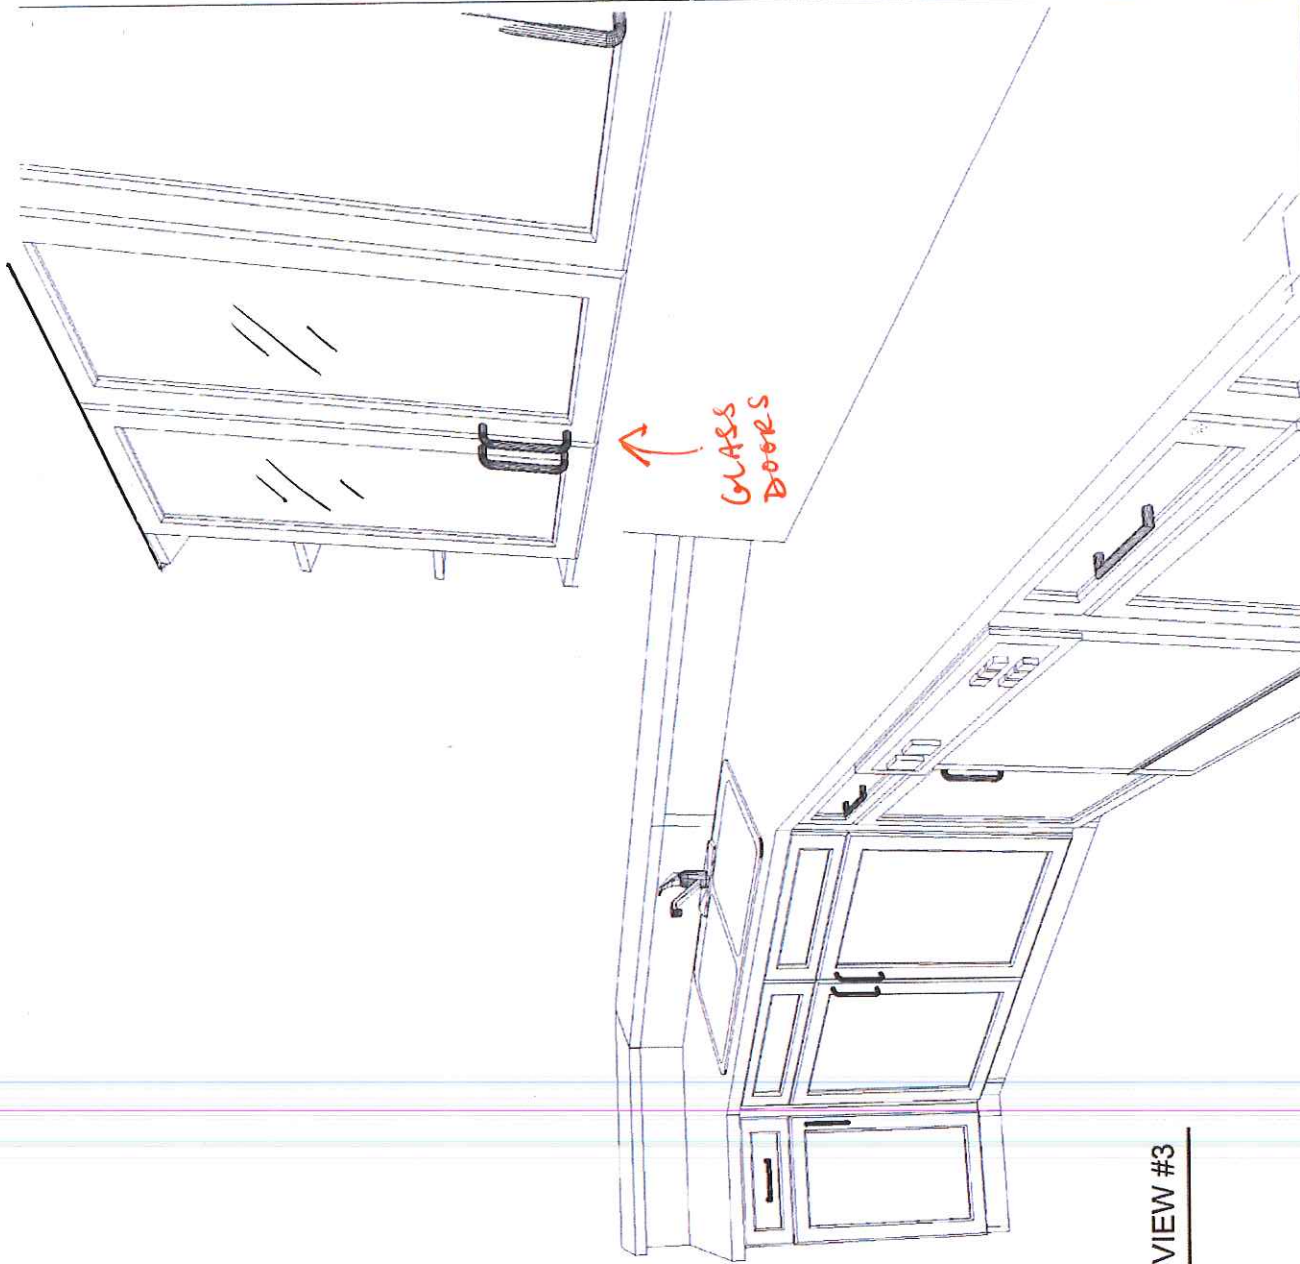

CUSTOMER APPROVAL

I have reviewed these drawings and understand the details of the layout and the Cartier Kitchens specifications.

RG 126

Signature

Date Oct. 17/13

2020
TECHNOLOGIES

Note: This drawing is an artistic interpretation of the general appearance of the design. It is not meant to be an exact rendition.

Drawn By: Lori D Saverio, B.I.D.
Cartier Kitchens Ottawa

DCR - #78 FBC - BRADFORD (35-4) - KITCHEN

All

Drawing #: 1

Designed: 05/09/2013
Printed: 05/09/2013