


DCR PHOENIX HOMES

FRNBANK CROSSING
LOT #80

BRADFORD (35-4)

KITCHEN

- LINE - 2 (STD)
- COMO MELAMINE - QUEENSTON OAK
- HARDWARE -
- STD WHITE INTERIOR
- METAL DRWR BOX
- 3 PCS - 5/8" KICK
- 2 PCS - LOOSE FILLER - 6 x 96
- 1 PC - T-MOULD
- 1 PC - 35 DEG C-MOULD
- 1 PC - 90 DEG C-MOULD

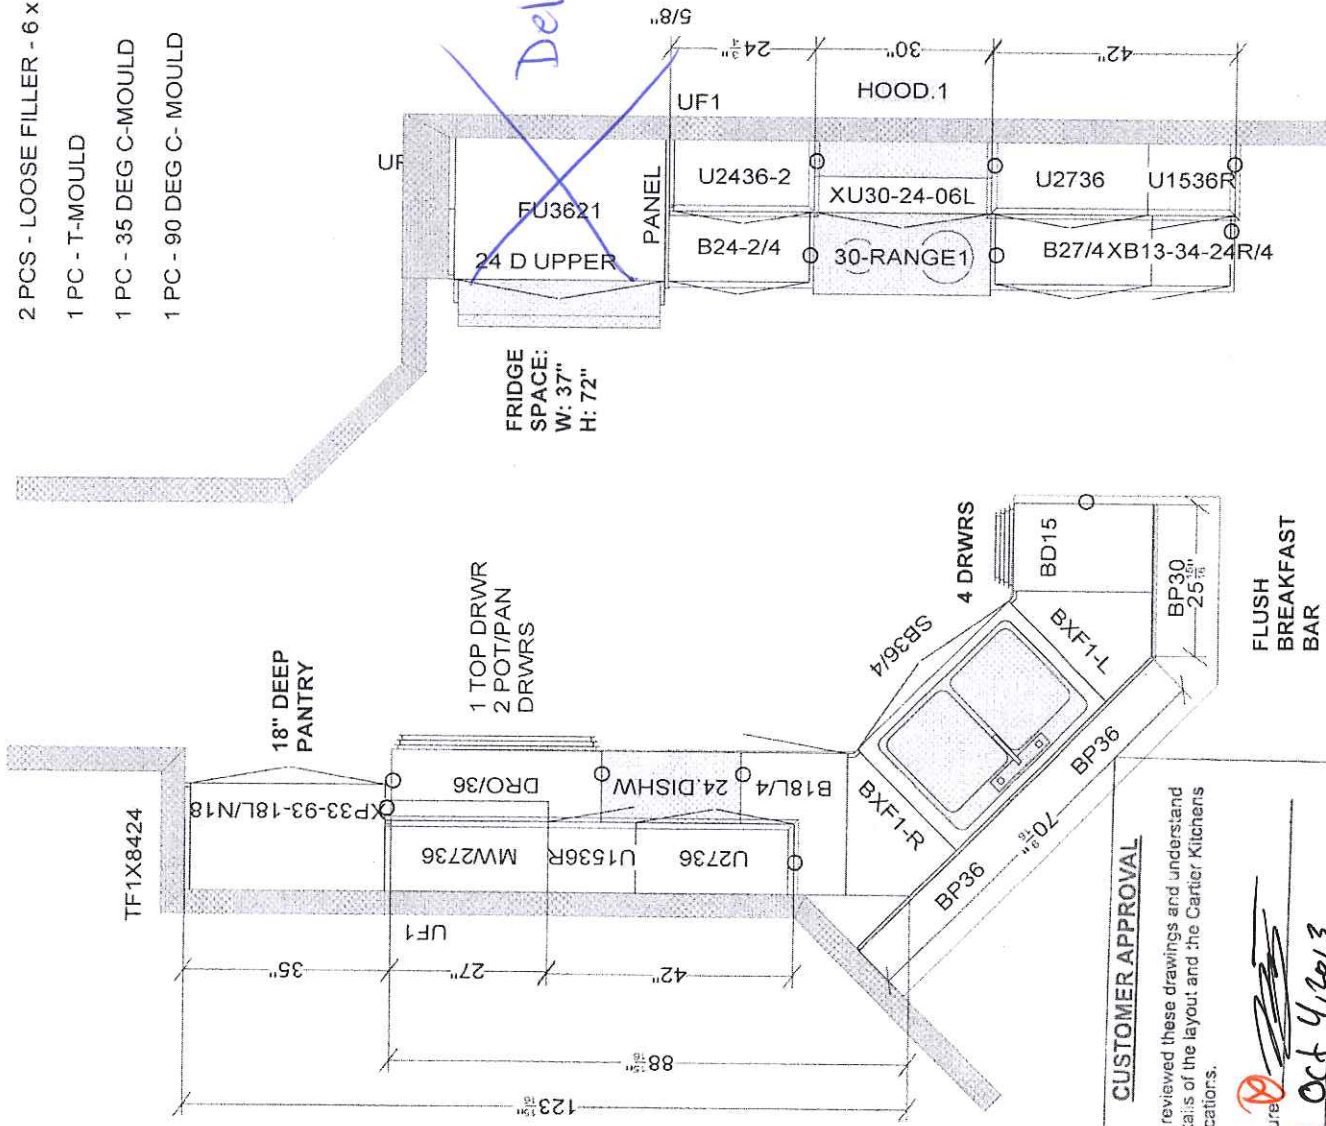


CUSTOMER APPROVAL

I have reviewed these drawings and understand the details of the layout and the Cartier Kitchens specifications.

Signature: *[Signature]*
Date: Oct 4, 2013

FLUSH
BREAKFAST
BAR

All dimensions, size designations given are subject to verification on job site and adjustment to fit job conditions.	2020 TECHNOLOGIES	This is an original design and must not be released or copied unless applicable fee has been paid or job order placed. Drawn by: Lori Di Saverio, B.I.D. Cartier Kitchens Ottawa	Designed: 25/08/2013 Printed: 25/08/2013
DCR - #80 FBC - BRADFORD (35-4) - KITCHEN (MASTER) kit	All	Drawing #: 1	No Scale.

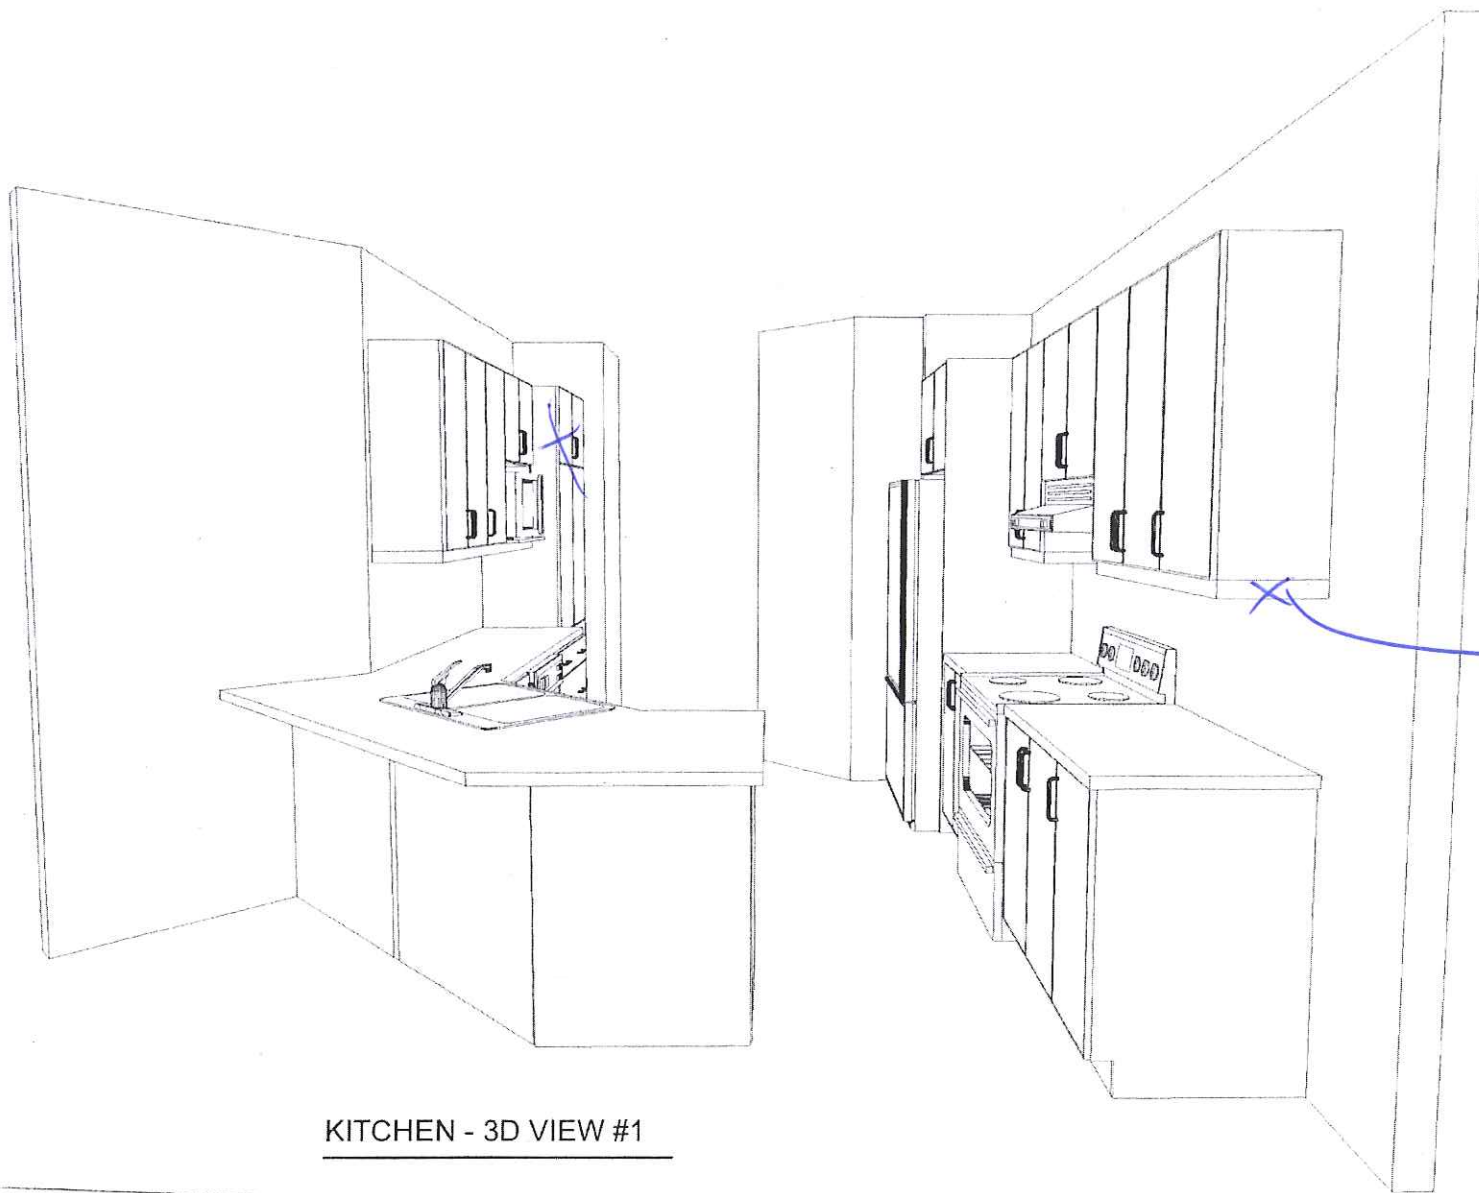

delete light valence.

KITCHEN - 3D VIEW #1

CUSTOMER APPROVAL

I have reviewed these drawings and understand the details of the layout and the Cartier Kitchens specifications.

Signature 
 Date  Oct 4, 2013

Note: This drawing is an artistic interpretation of the general appearance of the design. It is not meant to be an exact rendition.

Drawn By: Lori D Saverio, B.I.D.
 Cartier Kitchens Ottawa


DCR - #80 FBC - BRADFORD (35-4) - KITCHEN



Designed: 25/08/2013
 Printed: 25/08/2013

All

Drawing #: 1

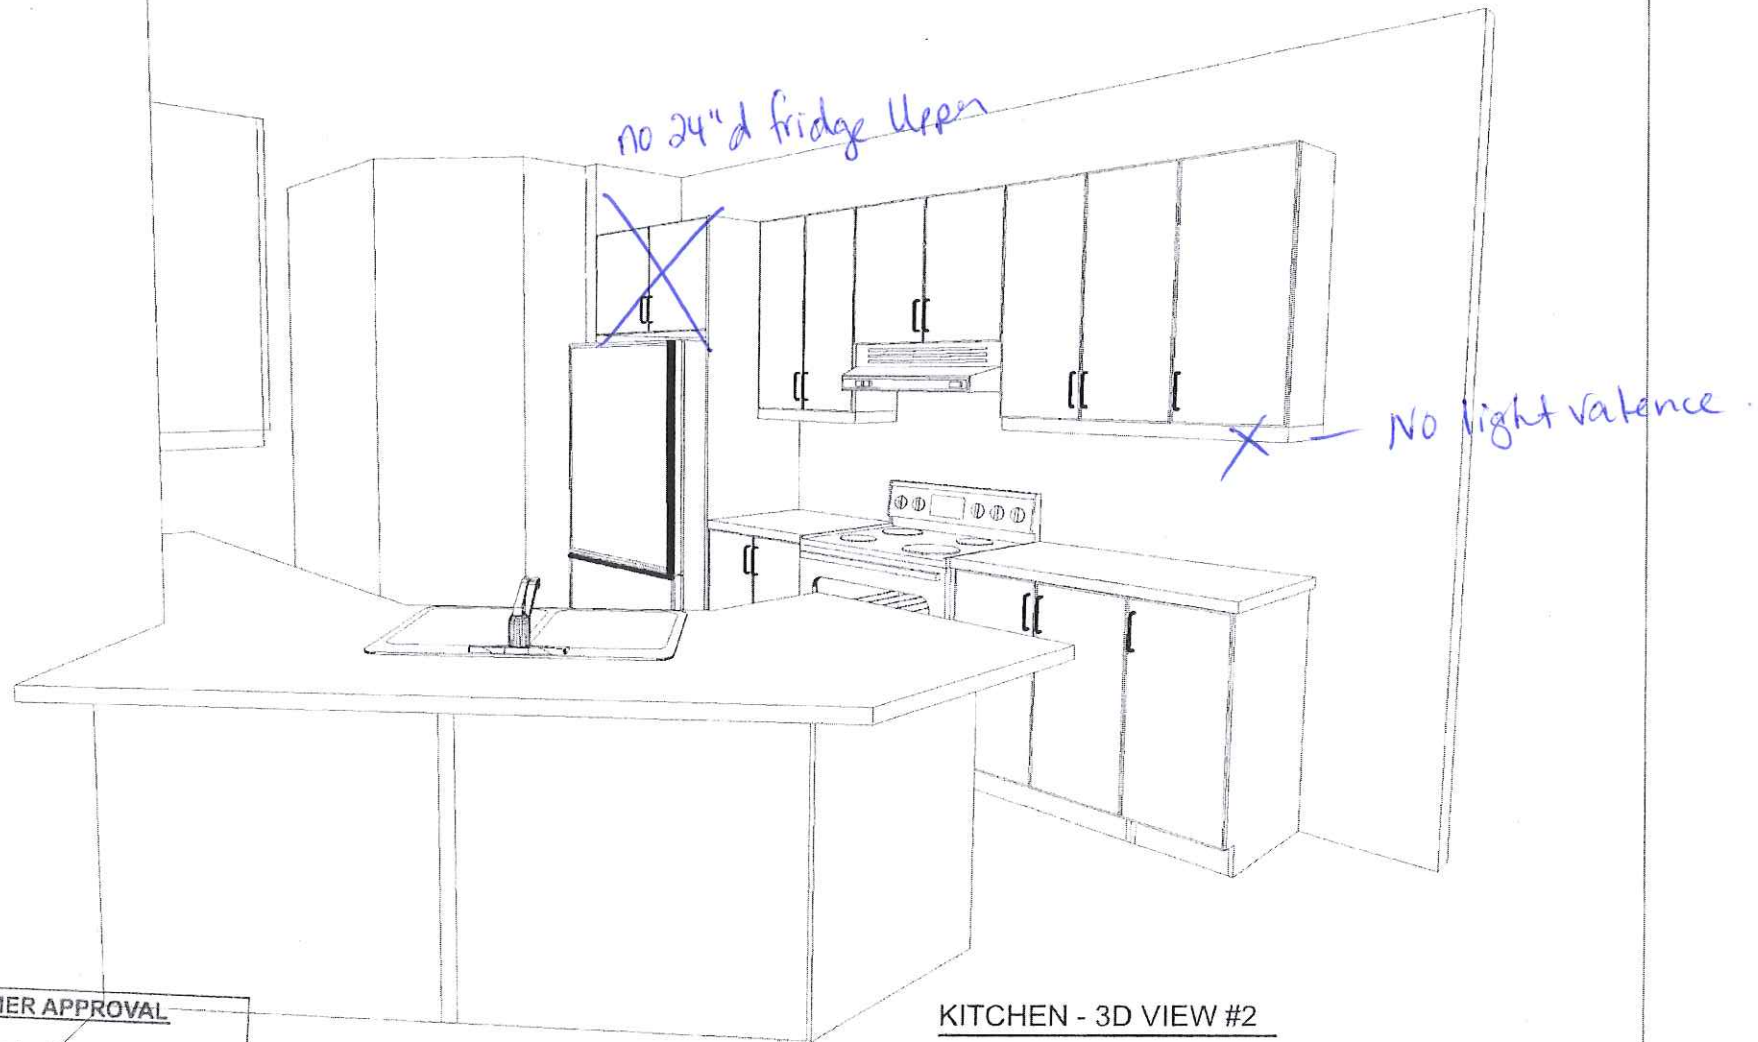

CUSTOMER APPROVAL

I have reviewed these drawings and understand the details of the layout and the Cartier Kitchens specifications.

Signature 

Date  Oct 4, 2013

KITCHEN - 3D VIEW #2

Note: This drawing is an artistic interpretation of the general appearance of the design. It is not meant to be an exact rendition.




Designed: 25/08/2013
Printed: 25/08/2013

Drawn By: Lori D Saverio, B.I.D.
Cartier Kitchens Ottawa

DCR - #80 FBC - BRADFORD (35-4) - KITCHEN

All

Drawing #: 1

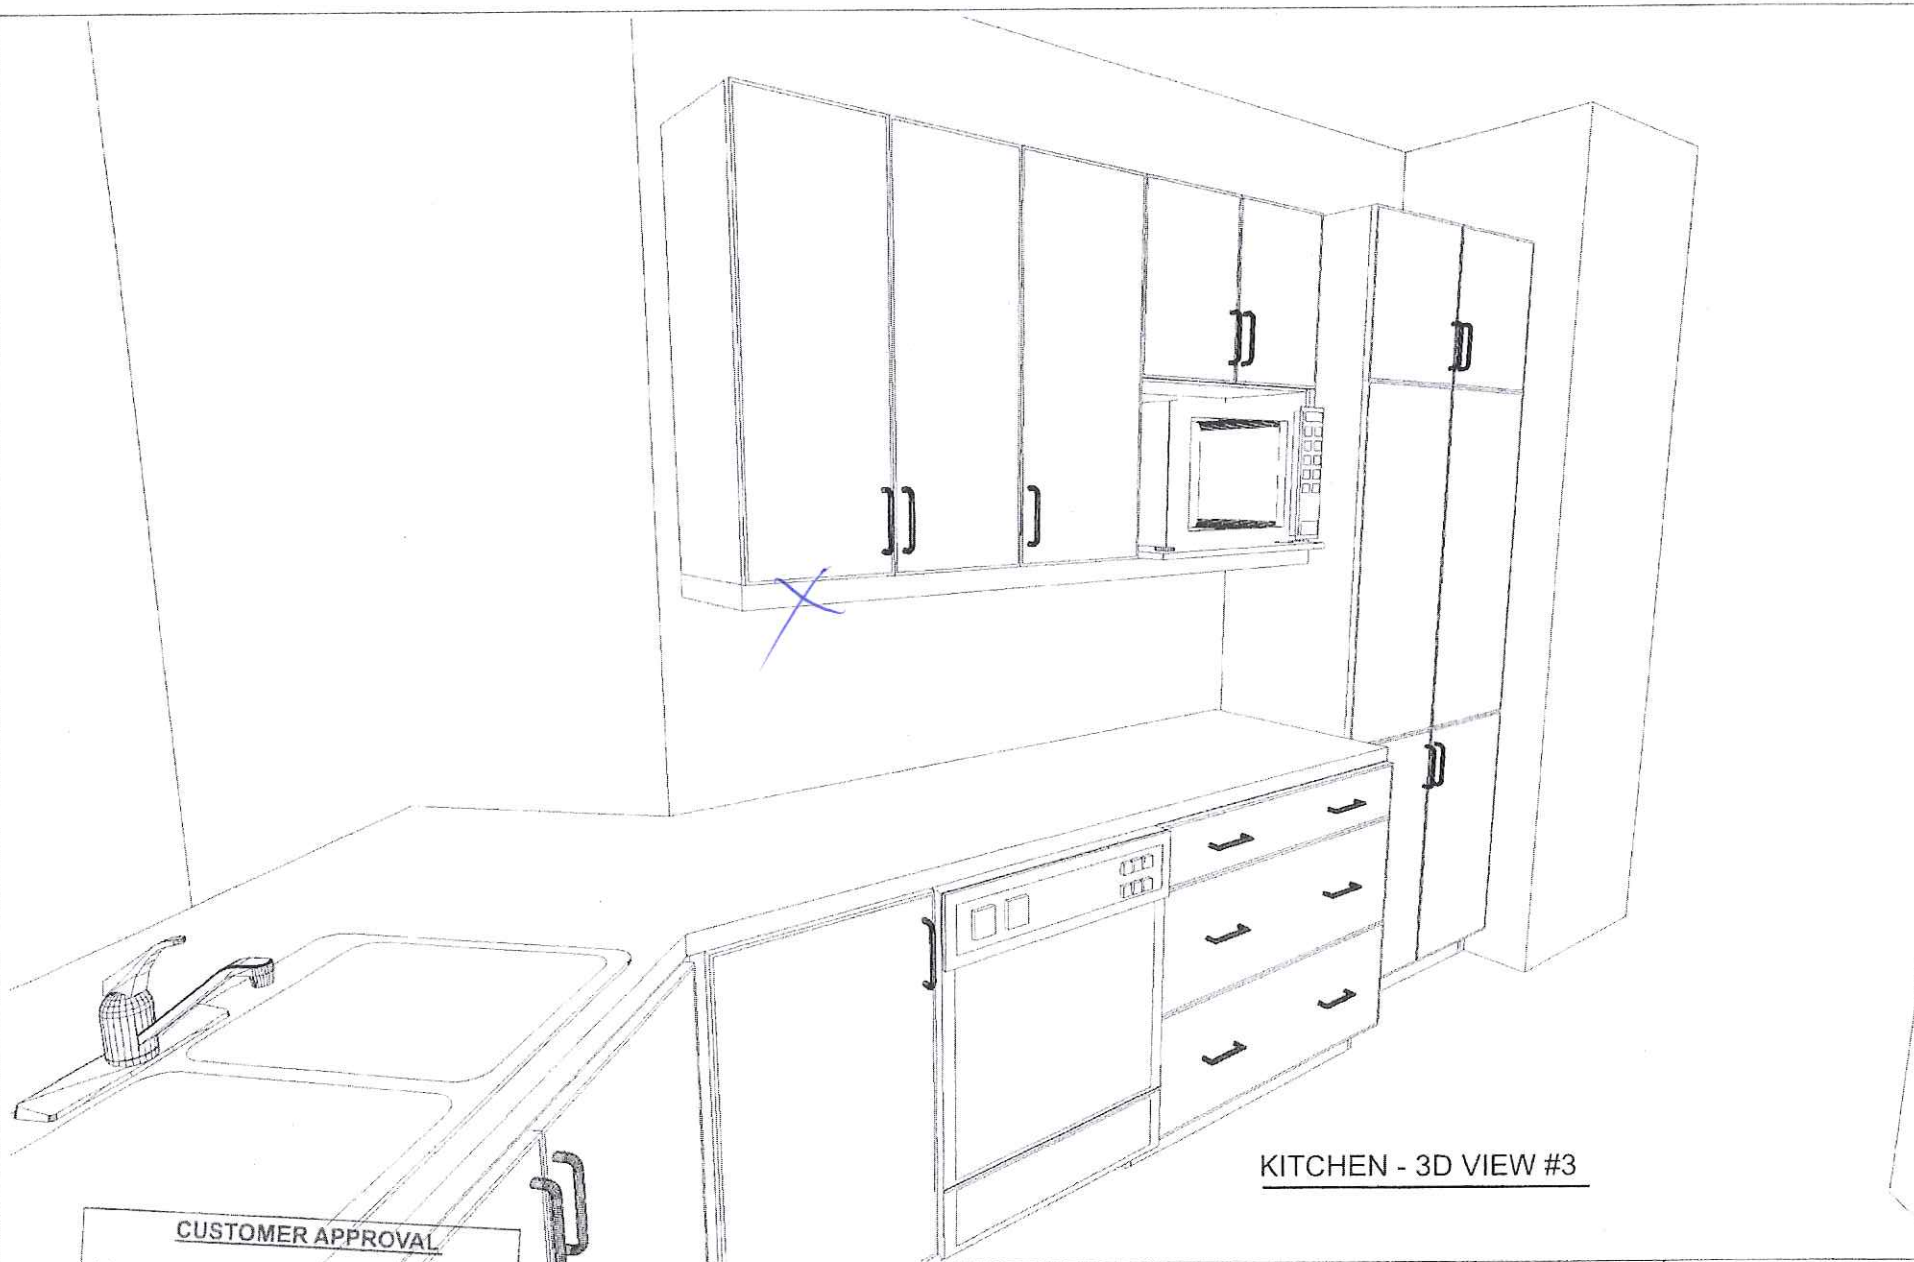

KITCHEN - 3D VIEW #3

CUSTOMER APPROVAL

I have reviewed these drawings and understand the details of the layout and the Cartier Kitchens specifications.

Signature

Date

Note: This drawing is an artistic interpretation of the general appearance of the design. It is not meant to be an exact rendition.

Drawn By: Lori D Saverio, B.I.D.
Cartier Kitchens Ottawa


DCR - #80 FBC - BRADFORD (35-4) - KITCHEN

2020
TECHNOLOGIES

Designed: 25/08/2013
Printed: 25/08/2013

All

Drawing #: 1

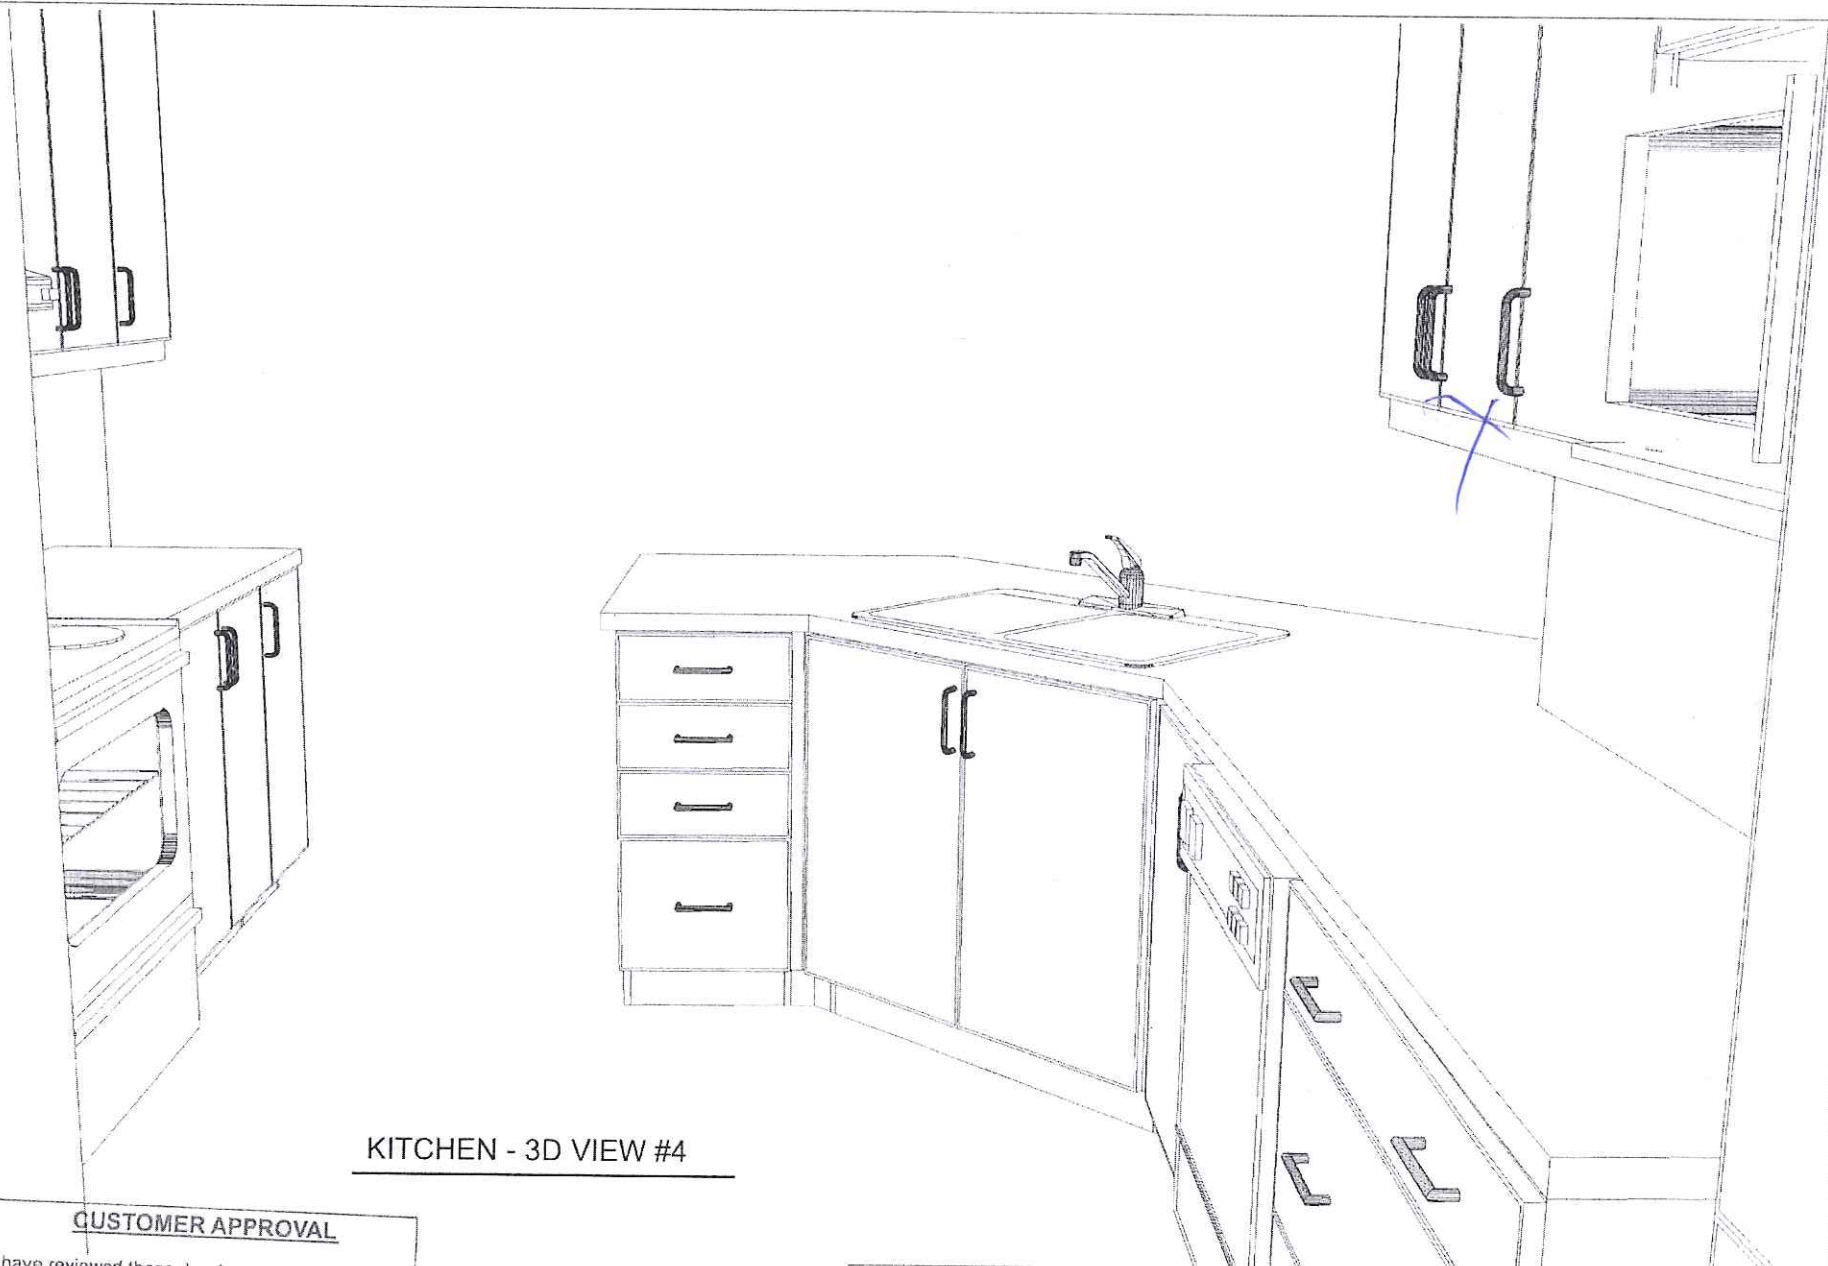

KITCHEN - 3D VIEW #4

CUSTOMER APPROVAL

I have reviewed these drawings and understand the details of the layout and the Cartier Kitchens specifications.

Signature 
 Date  Oct 4, 2013

Note: This drawing is an artistic interpretation of the general appearance of the design. It is not meant to be an exact rendition.

Drawn By: Lori D Saverio, B.I.D.
 Cartier Kitchens Ottawa


DCR - #80 FBC - BRADFORD (35-4) - KITCHEN



Designed: 25/08/2013
 Printed: 25/08/2013


All

Drawing #: 1

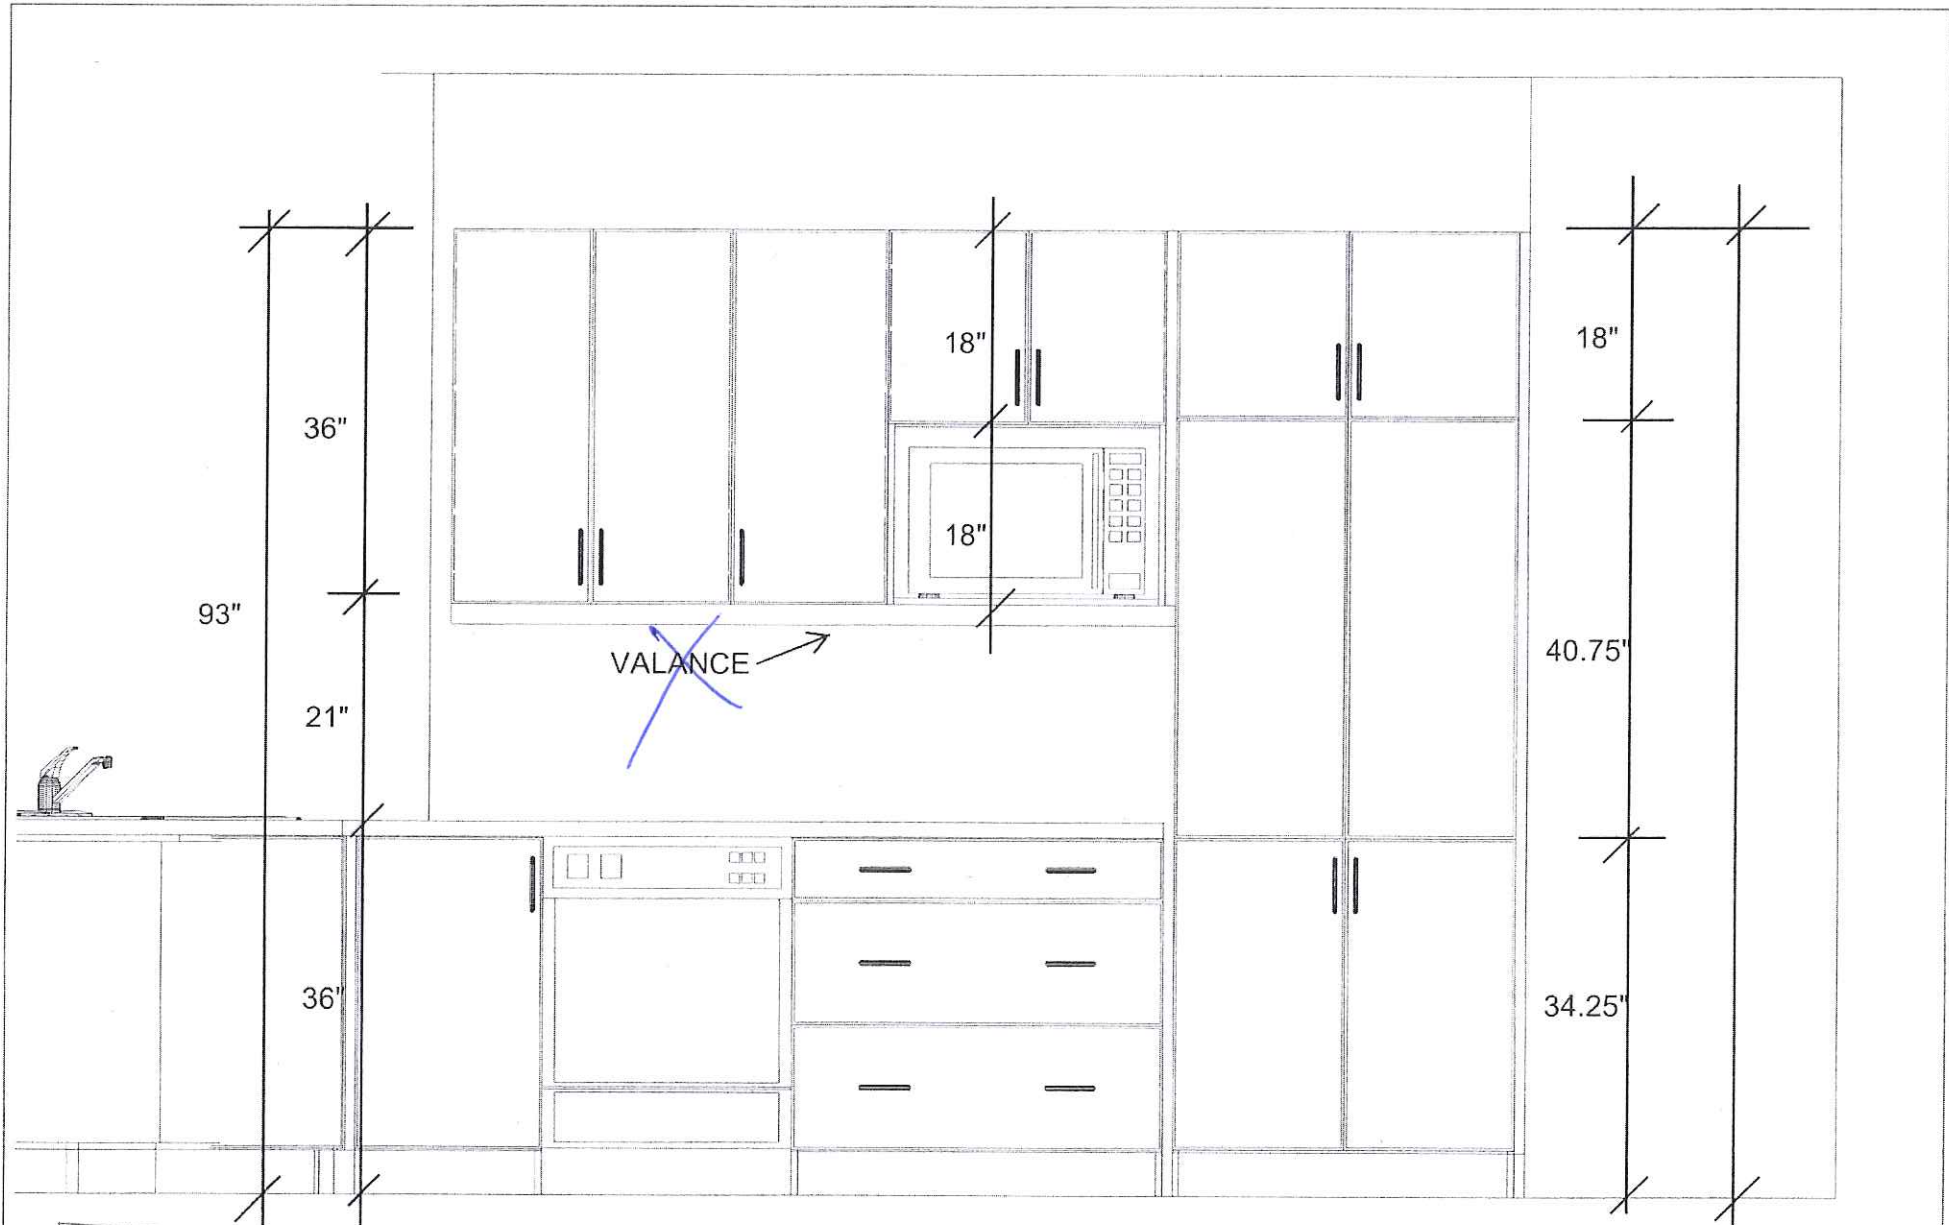

CUSTOMER APPROVAL SINK WALL ELEVATION

I have reviewed these drawings and understand the details of the layout and the Cartier Kitchens specifications.

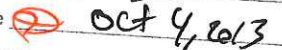Signature 
 Date  Oct 4, 2013

Note: This drawing is an artistic interpretation of the general appearance of the design. It is not meant to be an exact rendition.

Drawn By: Lori D Saverio, B.I.D.
 Cartier Kitchens Ottawa




Designed: 25/08/2013
 Printed: 25/08/2013

DCR - #80 FBC - BRADFORD (35-4) - KITCHEN

All

Drawing #: 1

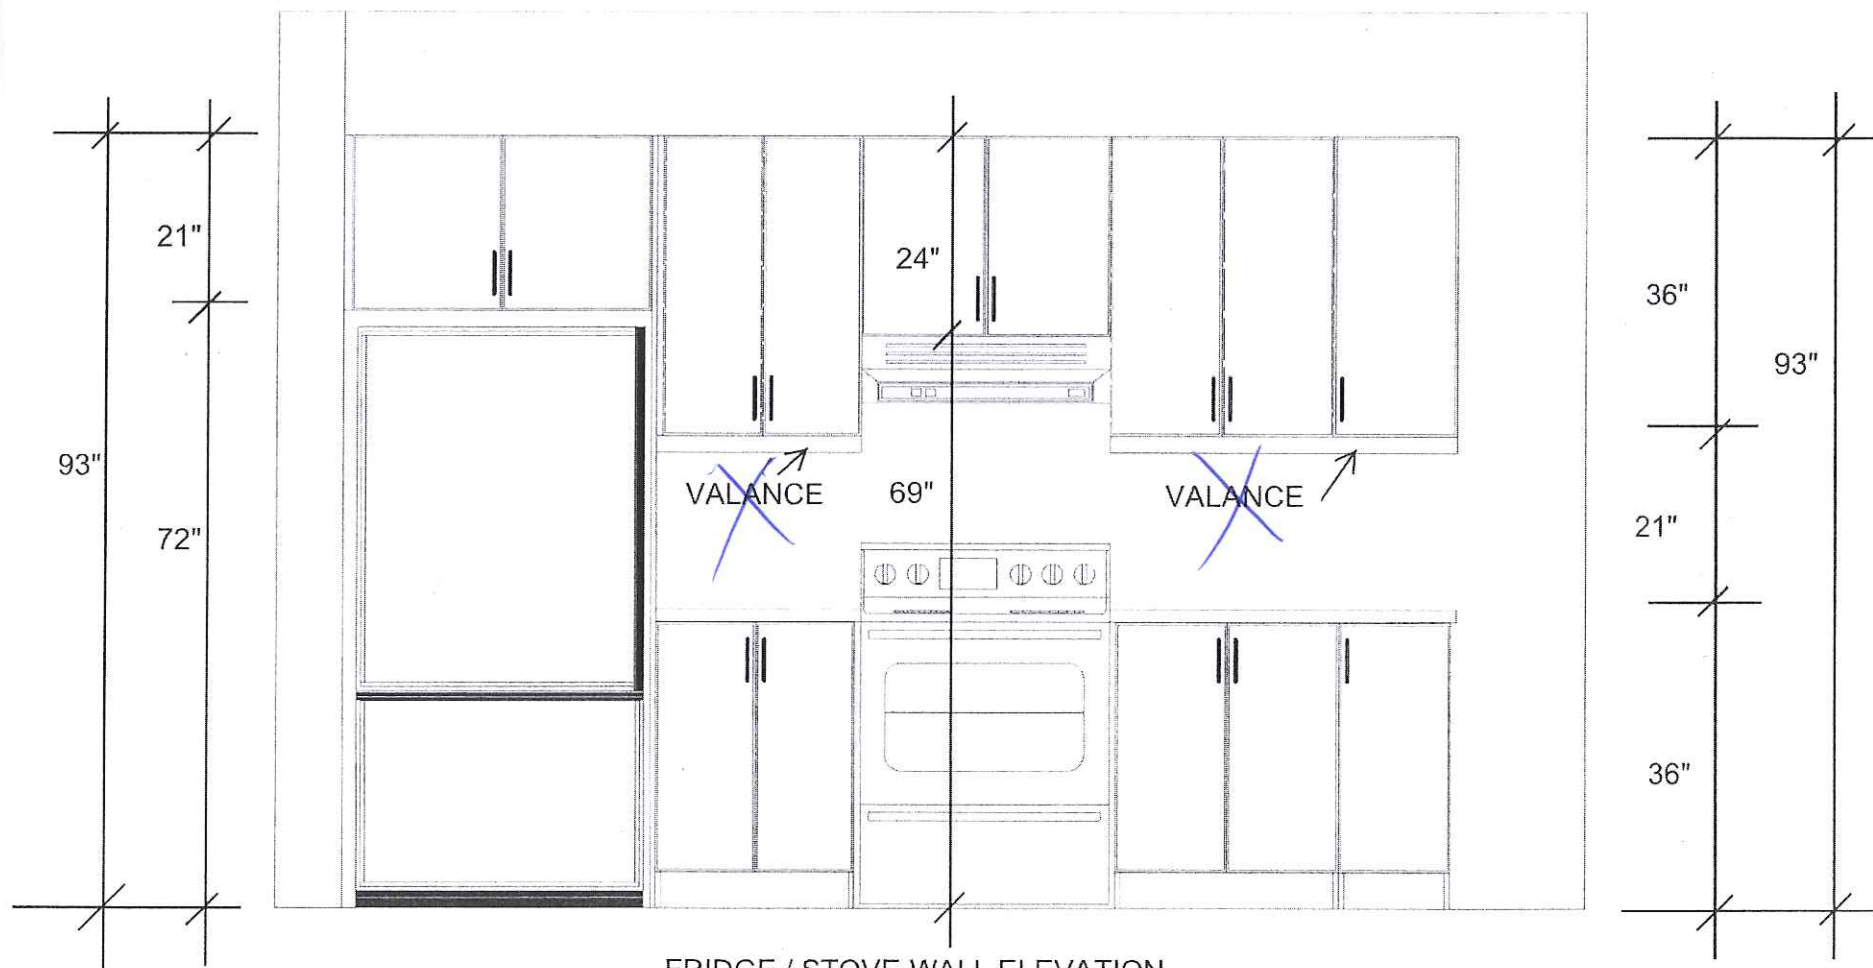

FRIDGE / STOVE WALL ELEVATION

CUSTOMER APPROVAL

I have reviewed these drawings and understand the details of the layout and the Cartier Kitchens specifications.

Signature 
 Date  Oct 4, 2013

Note: This drawing is an artistic interpretation of the general appearance of the design. It is not meant to be an exact rendition.



Designed: 25/08/2013
 Printed: 25/08/2013

Drawn By: Lori D Saverio, B.I.D.
 Cartier Kitchens Ottawa

DCR - #80 FBC - BRADFORD (35-4) - KITCHEN

All

Drawing #: 1