



FERNBANK CROSSING
LOT #80
BRADFORD (35-4)

LINE -
HARDWARE -
STD WHITE INTERIORS
METAL DRWR BOX
5/8" KICK

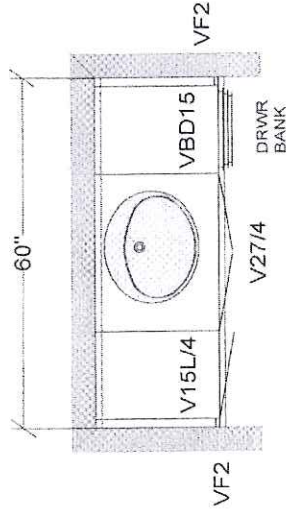

MAIN BATH

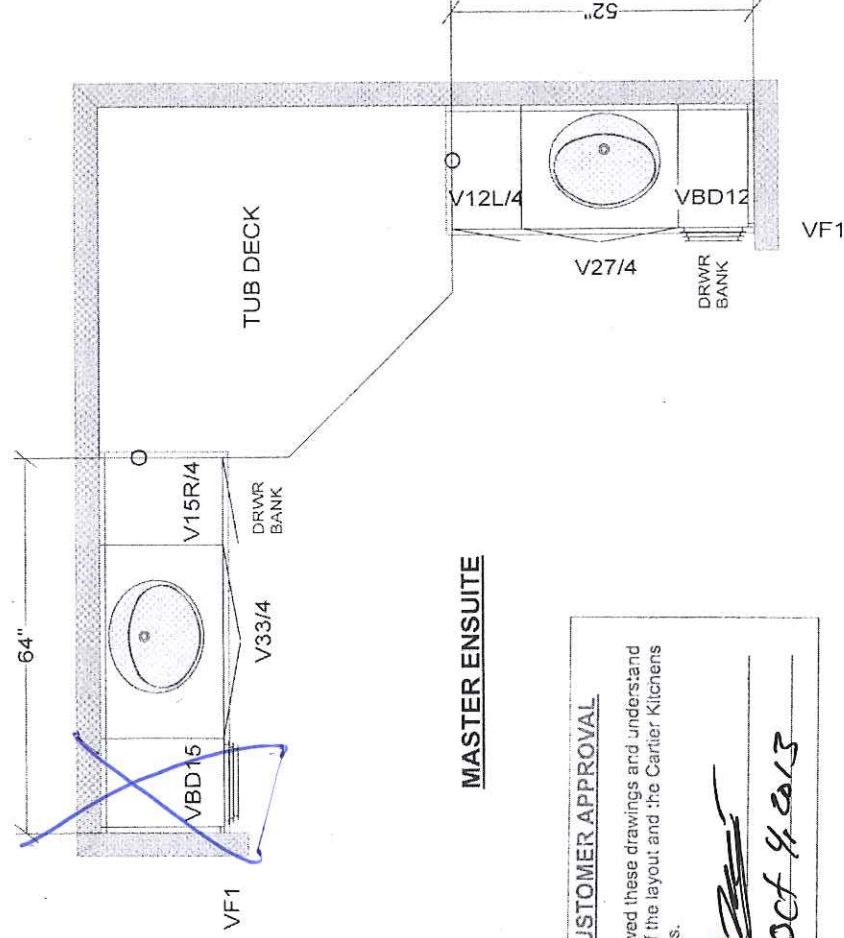

MASTER ENSUITE

CUSTOMER APPROVAL

I have reviewed these drawings and understand the details of the layout and the Cartier Kitchens specifications.

Signature 
Date  Oct 4, 2013


All dimensions, size designations given are subject to verification on job site and adjustment to fit job conditions.		This is an original design and must not be released or copied unless applicable fee has been paid or job order placed.	Designed: 25/08/2013 Printed: 25/08/2013
Cartier Kitchens Ottawa	Cartier Kitchens Ottawa	Drawn by: Lori Di Saverto, B.I.D. Cartier Kitchens Ottawa	Drawing #: 1 No Scale.

CUSTOMER APPROVAL

I have reviewed these drawings and understand the details of the layout and the Carlier Kitchens specifications.

Signature  Date Oct 4, 2013

MAIN BATH VANITY

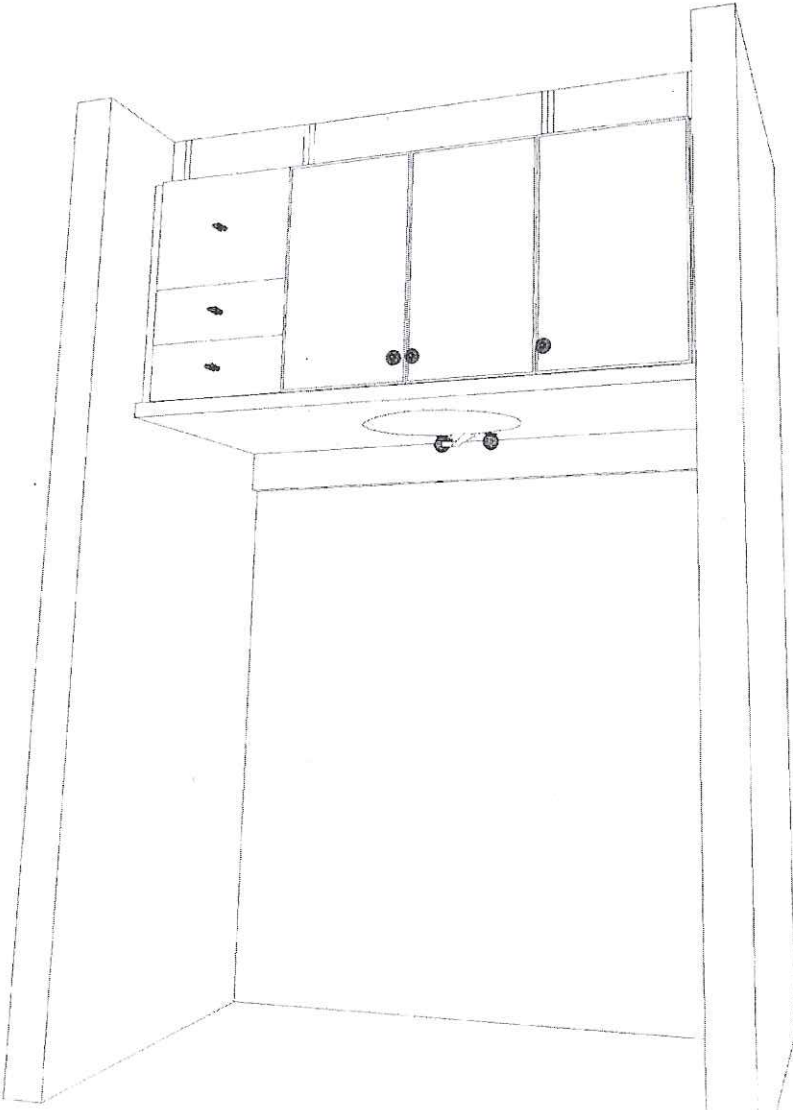

Note: This drawing is an artistic interpretation of the general appearance of the design. It is not meant to be an exact rendition.			Designed: 25/08/2013 Printed: 25/08/2013
Drawn By: Lori D Saverio, B.I.D. Carlier Kitchens Ottawa DCR - #80 FBC - BRADFORD(35-4) - 4 BDRM All			
Drawing #: 1			


CUSTOMER APPROVAL

I have reviewed these drawings and unders;and the details of the layout and the Carter Kitchens specifications.

Signature: 

Date: Oct 4, 2013

MASTER ENSUITE VANITIES

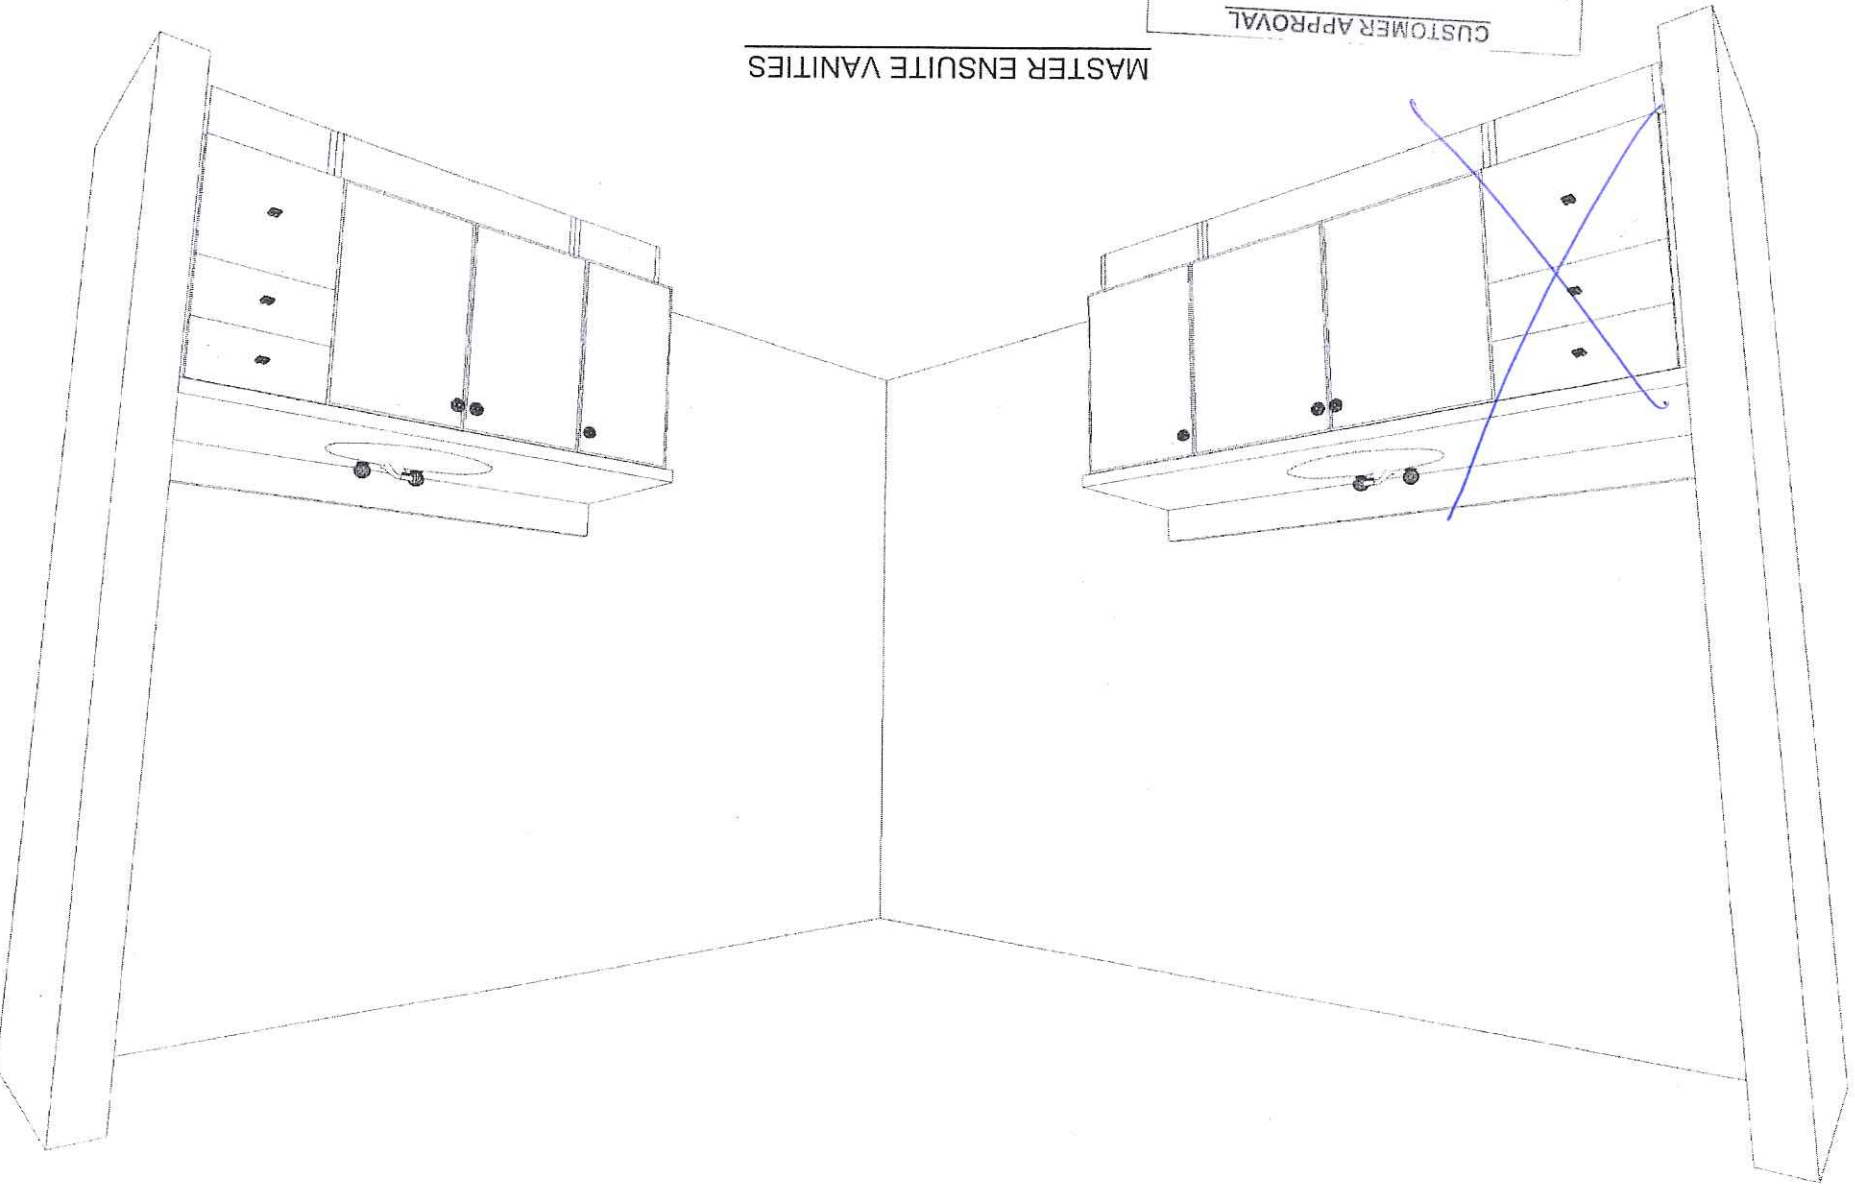

Note: This drawing is an artistic interpretation of the general appearance of the design. It is not meant to be an exact rendition.

Drawn By: Lori D Saverio, B.I.D.
Carter Kitchens Ottawa

DCR - #80 FBC - BRADFORD(35-4) - 4 BDRM

All

Drawing #: 1

2020 TECHNOLOGIES

Designed: 25/08/2013

Printed: 25/08/2013