


CITY OF-VILLE DE OTTAWA

☐ NEW SUBMISSION ☐ RE-SUBMISSION ☐ MODEL CHANGE ☐ MODEL CHANGE PERMIT #

PA11-01261
328 Bamburgh

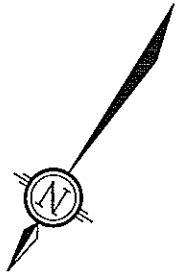

LEGEND


Finish Floor
Top Of Foundation
Underside Of Footing
Min. Underside Of Footing
Drainage/Swale Direction
Terracing 3H to 1V (max.)
Service Location
Proposed Grade
Existing Grade
Driveway & Slope Direction
Grade Percentage
Major Storm Flow Direction
Property Line

12.42%
12.42%
DW
5.0%
↑

CB
X
▲
△
▽
●
○
EBC
S
V
PROPOSED RETAINING WALL

City of Ottawa
Building Services Branch
REVIEWED
By: *[Signature]*
Date: 11/15/11, Sep 22, 2011
Building Code Reviewed
Signature: _____

City of Ottawa
Building Services Branch
REVIEWED
By: *[Signature]*
Date: 11/15/11, Sep 22, 2011
Zoning Reviewed
Signature: _____

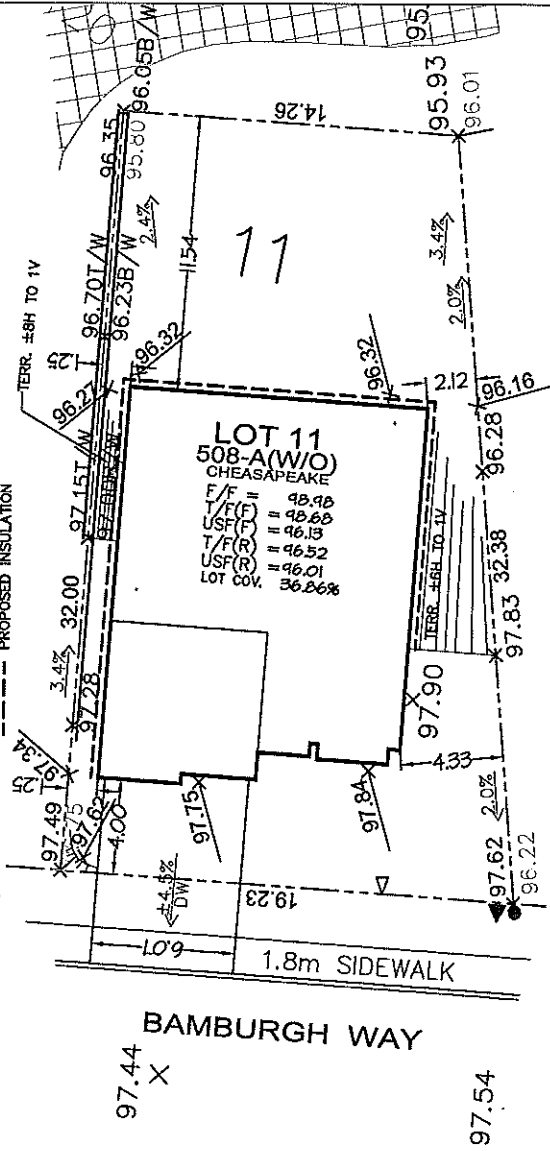

Owner/Applicant
DCR/PHOENIX HOMES
Telephone # 723-9227
Plan # 4M-
Lot # 11 STRANDHERD MEADOWS
Block # Unit #
Conc. #
Civic Address: 328 BAMBURGH WAY

Bldg. Ht. m
Lot coverage 36.86 %
Scale 1:250
ELEVATIONS
Step footings N/A m
Underside footing SEE ABOVE m
Top of foundation SEE ABOVE m

CHECKED/APPROVED BY: T.L.MAK ENG.
AUG. 2011
REV.1 SEPT-11

LOT 11 SITE/GRADING PLAN
STRANDHERD MEADOWS PH5

F/F = 48.98
T/F(F) = 48.68
USF(F) = 46.13
T/F(R) = 46.52
USF(R) = 46.01
LOT COV. 36.86%

PLEASE NOTE: THIS APPLICATION EXPIRES 6(SIX) MONTHS AFTER DATE RECEIVED

Application No: _____
OFFICE USE ONLY: Civic Address: _____

Circ Date	Circ Date	Circ Date	APPLICATION RECEIVED
Works Division Approval	Zoning Approval	UPO Approval	
Date:	Date:	Date:	