

DCR PHOENIX HOMES

STRANDHERD MEADOWS
LOT #11
CHESAPEAKE (508) Left

KITCHEN

CABINET LINE -
DOOR STYLE -
SPECIES -
COLOUR -

HARDWARE -

KICK: 4-PCS.

STD WHITE INTERIORS

METAL DRAWER BOXES

2 - PCS. 90 DEG. CORNER MOULD.

1 - PC. T-MOULD.

2 - PCS - TALL FILLER - 6" x 96"

CUSTOMER APPROVAL


I have reviewed these drawings and understand the details of the layout and the Cartier Kitchens specifications.

Signature

Deep Barber

Date

Nov. 22/11

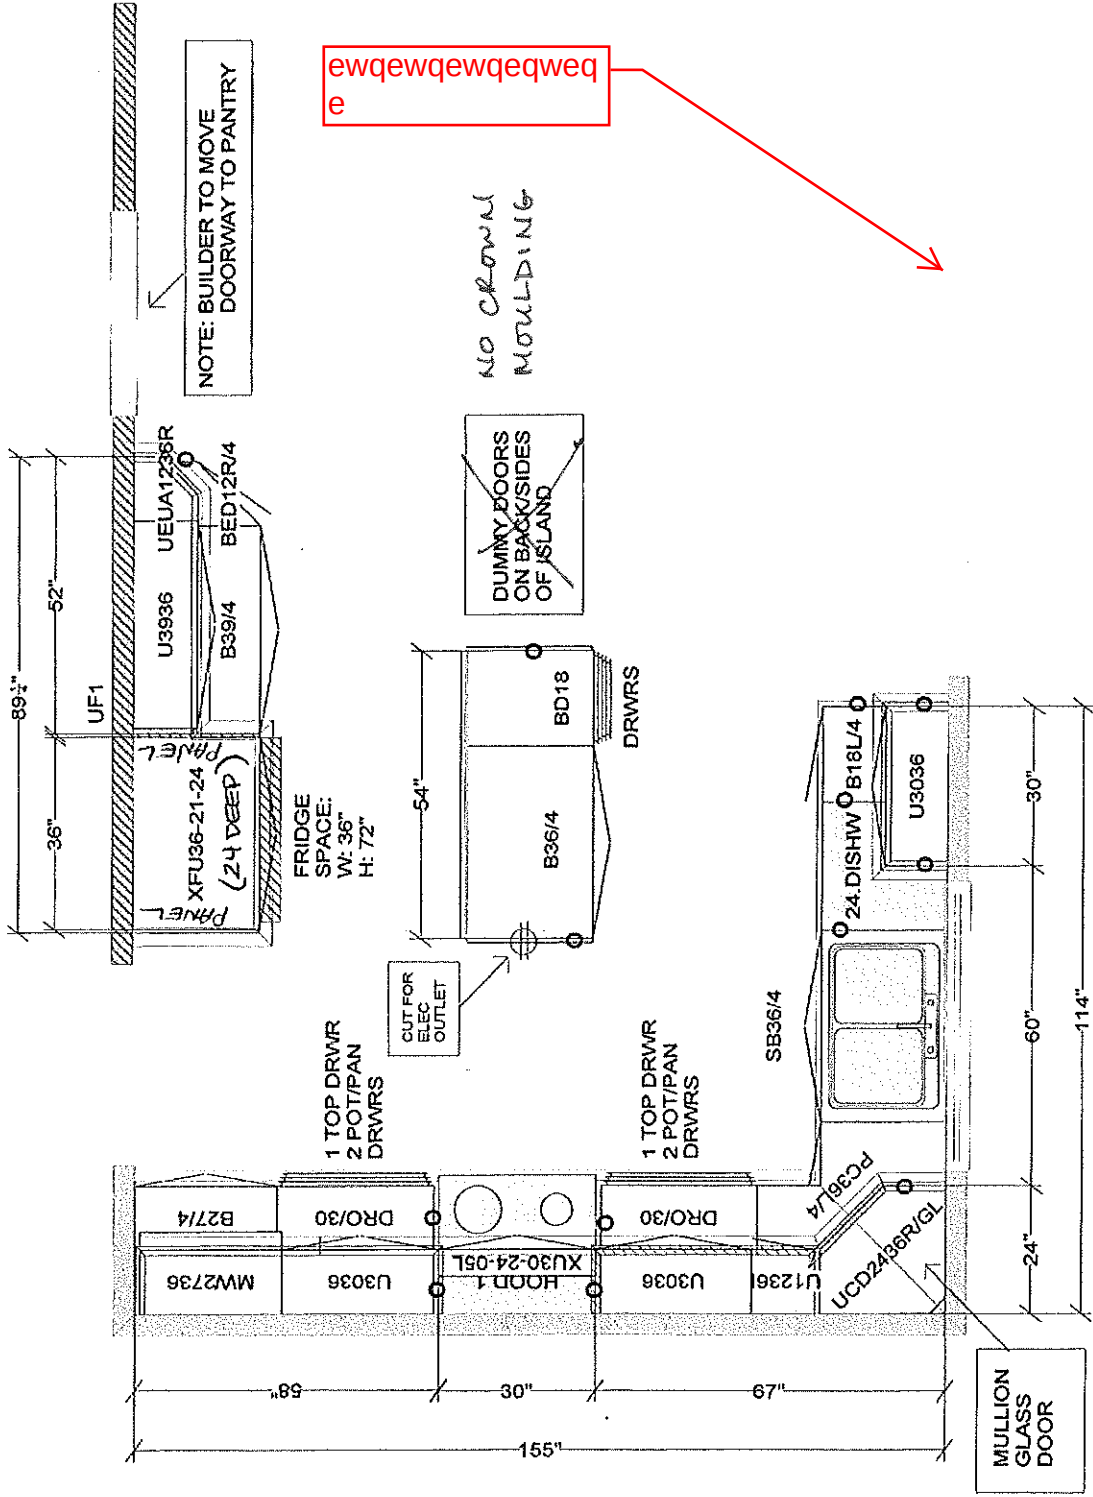

ewqewqewqewqewq
e

All dimensions, size designations given are subject to verification on job site and adjustment to fit job conditions.

CARTIER KITCHENS OTTAWA



2020
TECHNOLOGIES

This is an original design and must not be released or copied unless applicable fee has been paid or job order placed.

DRAWN BY: LD
CARTIER KITCHENS OTTAWA

Designed: 7/26/2011
Printed: 7/26/2011

DCR #11 SM5 - 508 left - Kitchen

All

Drawing #: 1

CUSTOMER APPROVAL

I have reviewed these drawings and understand the details of the layout and the Center Kitchens specifications.

Signature: *[Signature]* Date: *Nov. 22/11*

Note: This drawing is an artistic interpretation of the general appearance of the design. It is not meant to be an exact rendition.


DRAWN BY: Lori Di Saverio, B.I.D.
CARTIER KITCHENS OTTAWA

DCR #11 SM5 - 508 left - Kitchen

2020 TECHNOLOGIES

Designed: 7/26/2011 Printed: 7/26/2011

Drawing #: 1

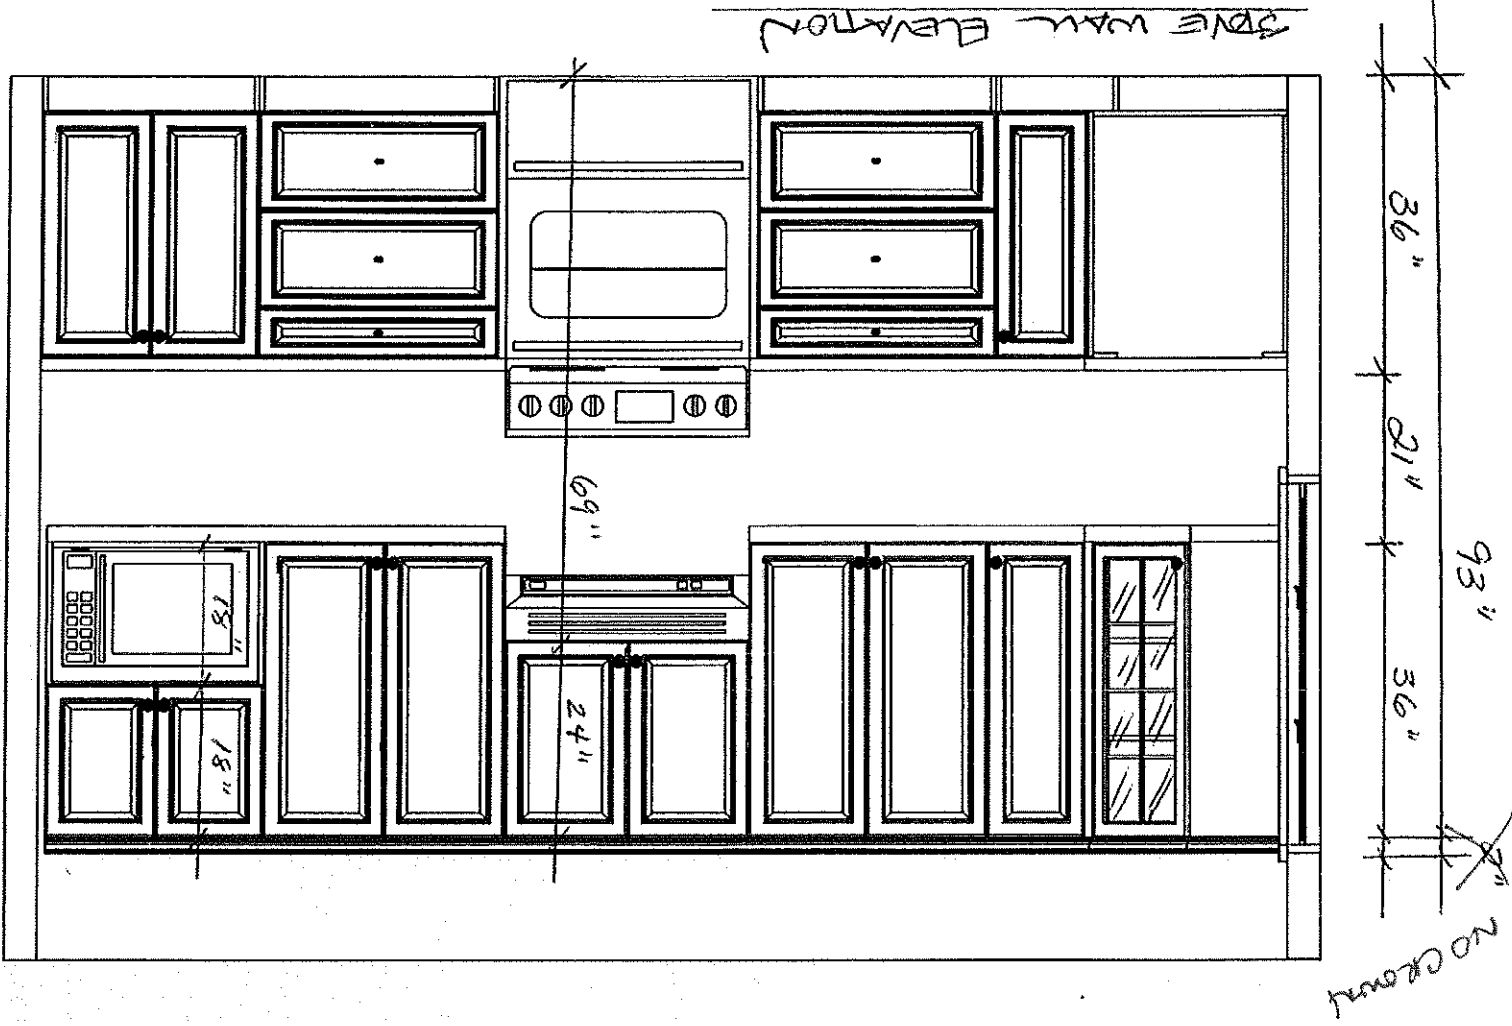


CUSTOMER APPROVAL

I have reviewed these drawings and understand the details of the layout and the Center Kitchens specifications.

Signature: *[Signature]*

Date: Nov. 22/11

SINK WALL ELEVATION

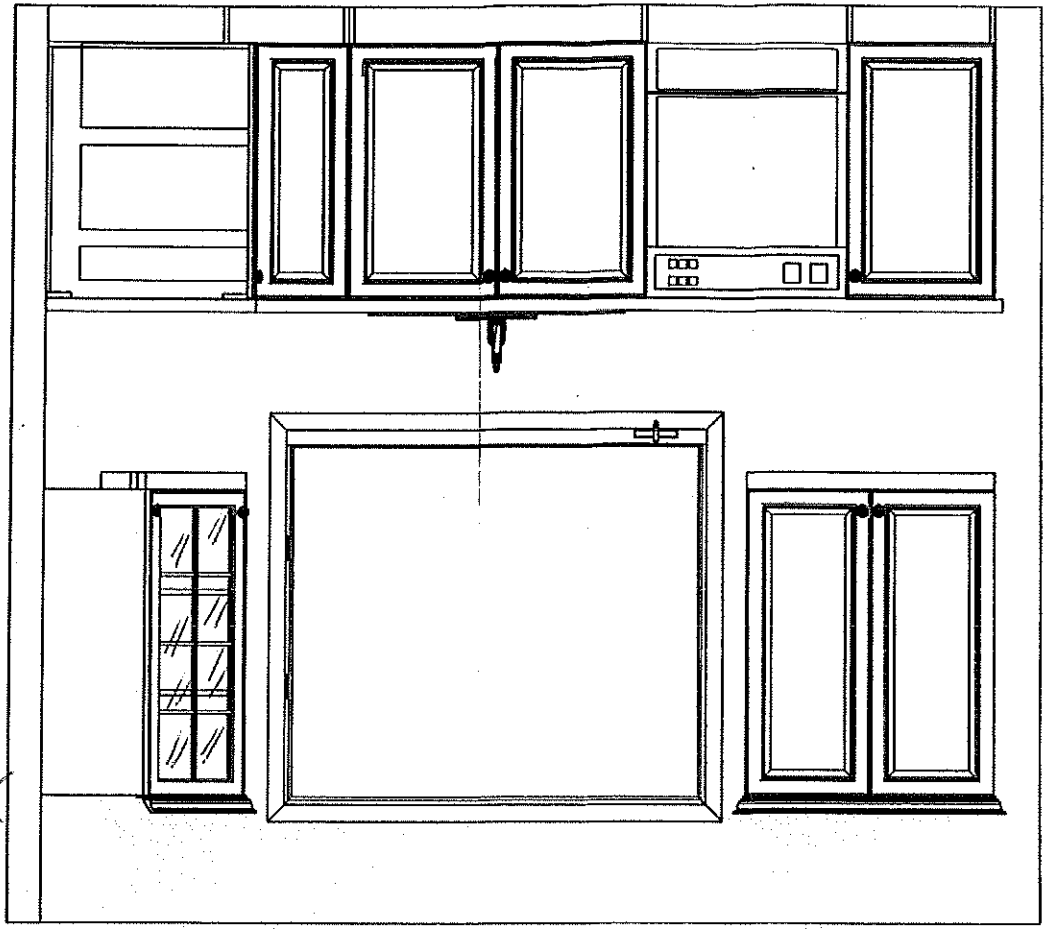

36" 21" 93" 36" 4"

NO CROWN

Note: This drawing is an artistic interpretation of the general appearance of the design. It is not meant to be an exact rendition.

DRAWN BY: Lori Di Saverio, B.I.D.
CENTER KITCHENS OTTAWA

DCR #11 SMS - 508 left - Kitchen

2011 TECHNOLOGIES

Designed: 7/26/2011 Printed: 7/26/2011


Drawing #: 1

CUSTOMER APPROVAL

I have reviewed these drawings and understand the details of the layout and the Carter Kitchens specifications.

Signature: *Stephan*

Date: Nov. 22/11

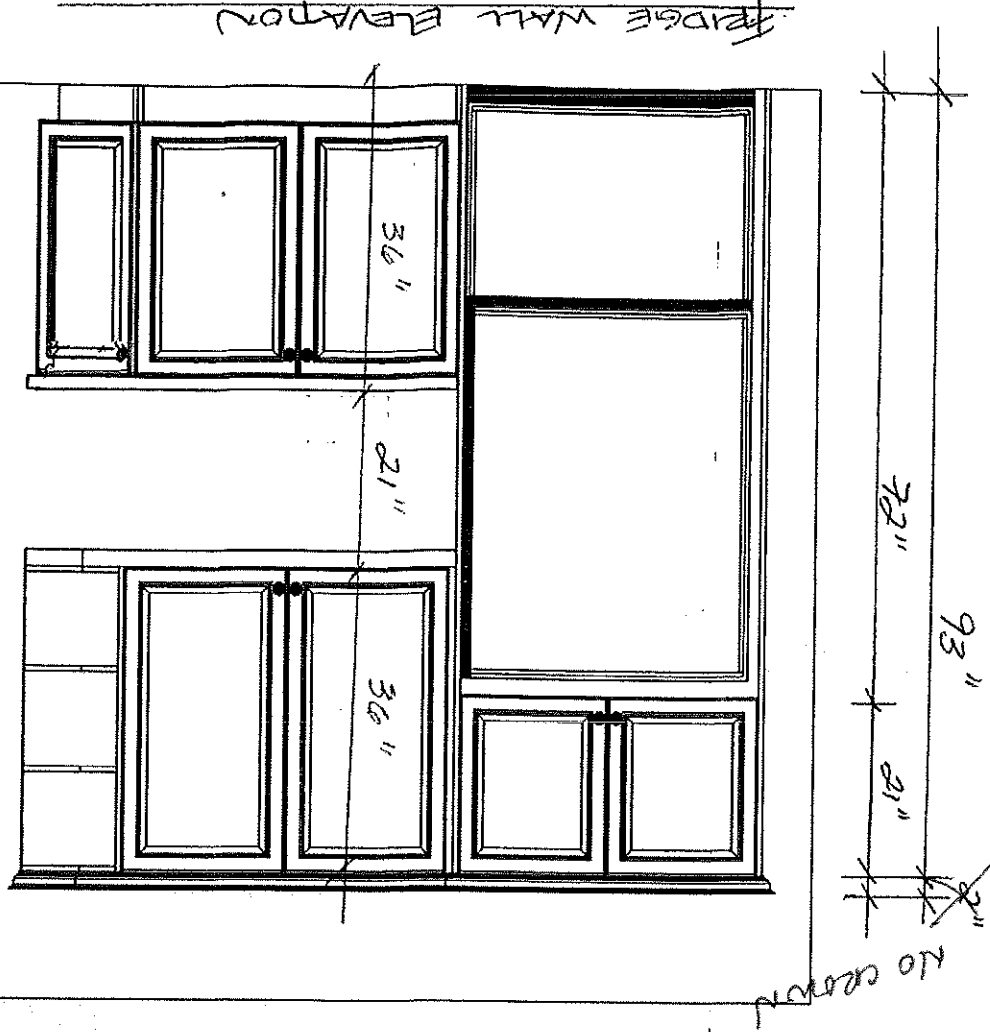

Note: This drawing is an artistic interpretation of the general appearance of the design. It is not meant to be an exact rendition.

DRAWN BY: Lori Di Saverio, B.I.D.
CARTIER KITCHENS OTTAWA

DCR #11 SMS - 508 1eH - Kitchen

2020 TECHNOLOGIES


Printed: 7/26/2011

Designed: 7/26/2011

Drawing #: 1

NO CROWN

3D View #1 - Kitchen.
LOT #11 SMS

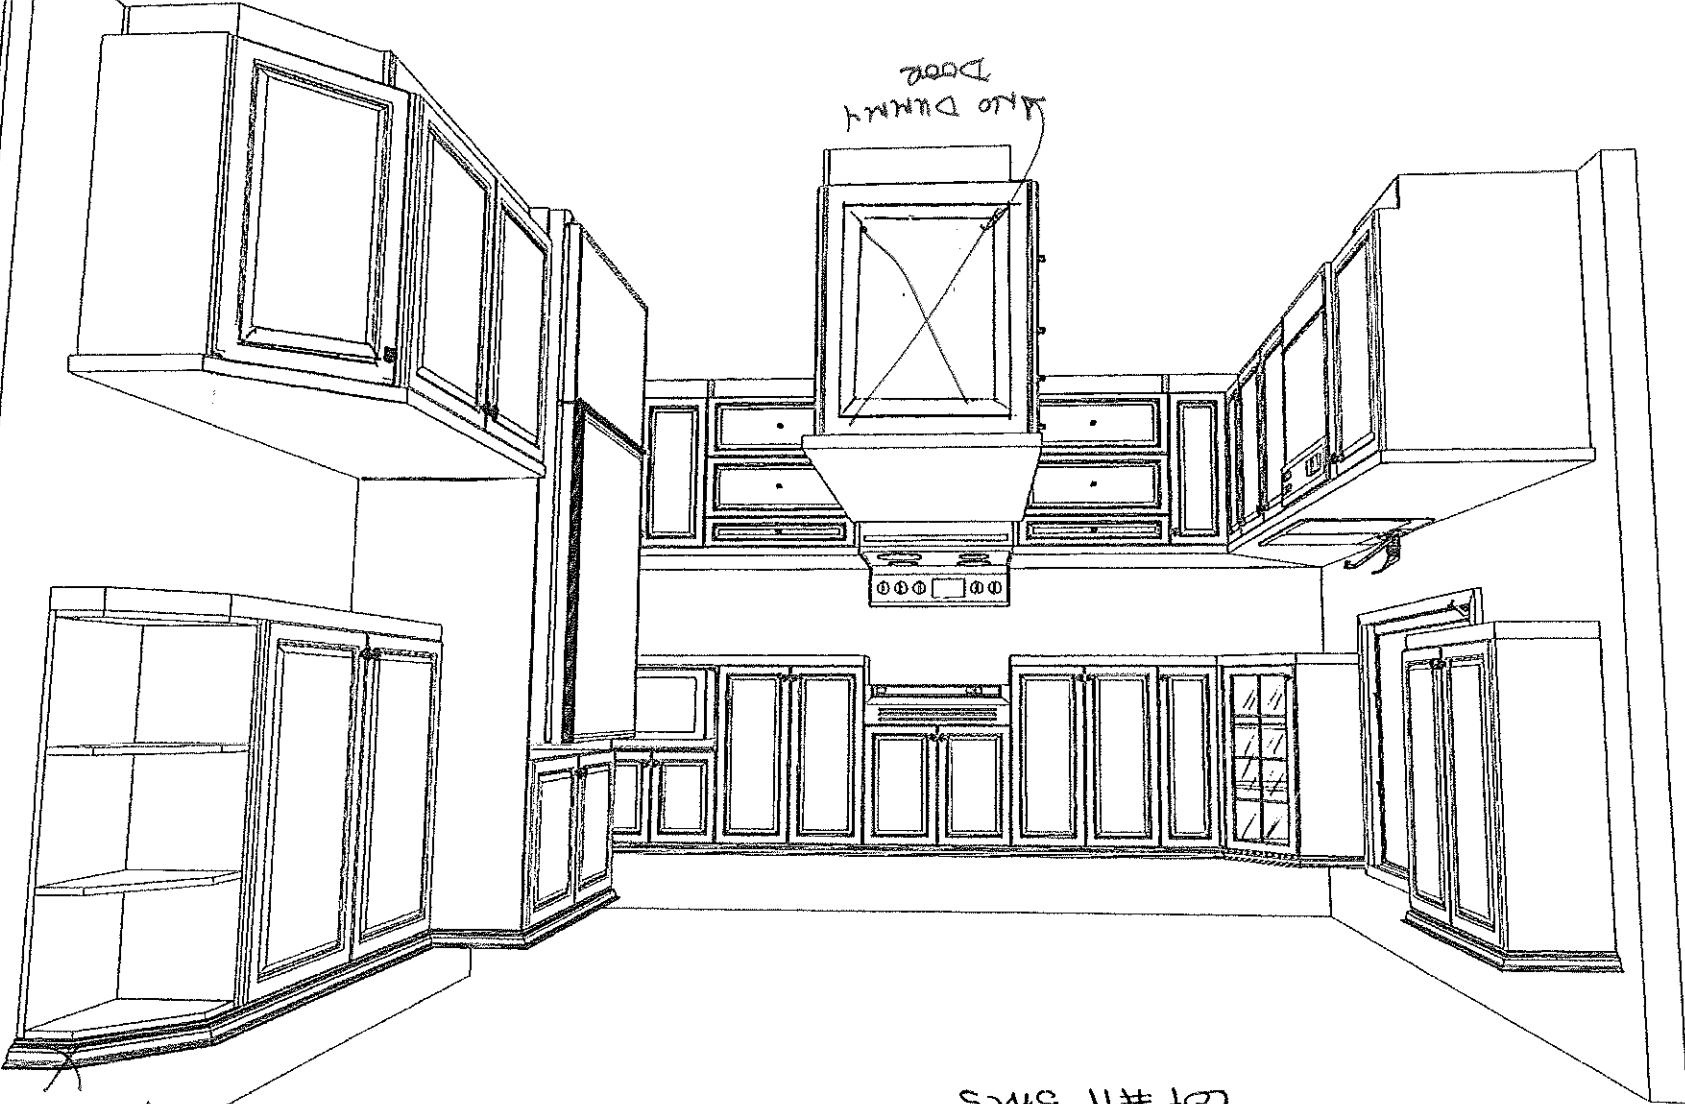

CUSTOMER APPROVAL

I have reviewed these drawings and understand the details of the layout and the Carter Kitchens specifications.

Signature: *Deep Sarkar*

Date: Nov. 22/11

Note: This drawing is an artistic interpretation of the general appearance of the design. It is not meant to be an exact rendition.

DRAWN BY: Lori Di Saverio, B.I.D.
CARTER KITCHENS OTTAWA

DCR #11 SMS - 508 left - Kitchen

All

Designed: 7/26/2011
Printed: 7/26/2011

2020 TECHNOLOGIES


Drawing #: 1		All		DCR #11 SMS - 508 left - Kitchen
Designed: 7/26/2011		Printed: 7/26/2011		Note: This drawing is an artistic interpretation of the general appearance of the design. It is not meant to be an exact rendition. DRAWN BY: Lori Di Saverio, B.L.D. CARTIER KITCHENS OTTAWA TECHNOLOGIES 2020 KITCHEN 2020

CUSTOMER APPROVAL

I have reviewed these drawings and understand the details of the layout and the Cartier Kitchens specifications.

Signature: *[Signature]*

Date: Nov. 22/11

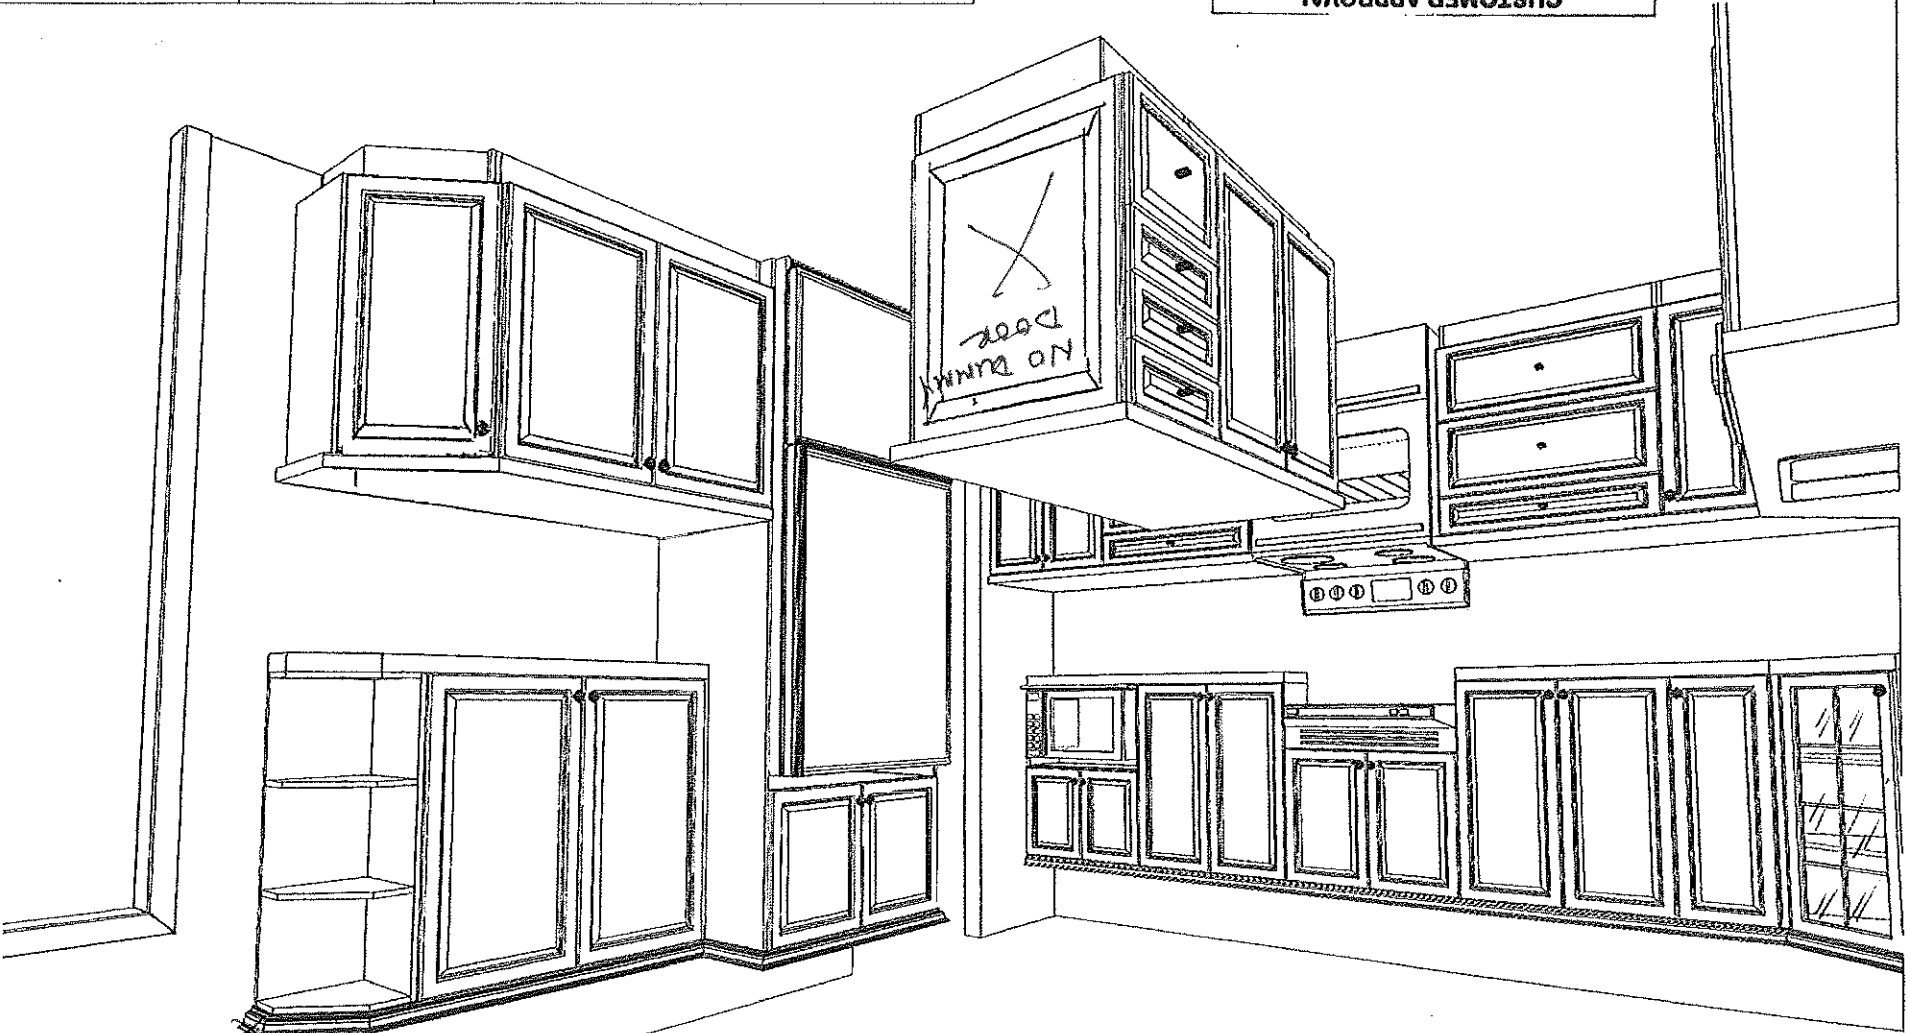

NO CROWN

3D View #2 - Kitchen
 Lot #11 SMS


CUSTOMER APPROVAL

I have reviewed these drawings and understand the details of the layout and the Carter Kitchens specifications.

Signature: *[Signature]*

Date: *Nov. 22/11*

3D View #3 - Kitchen.
 Lot #11 SWS

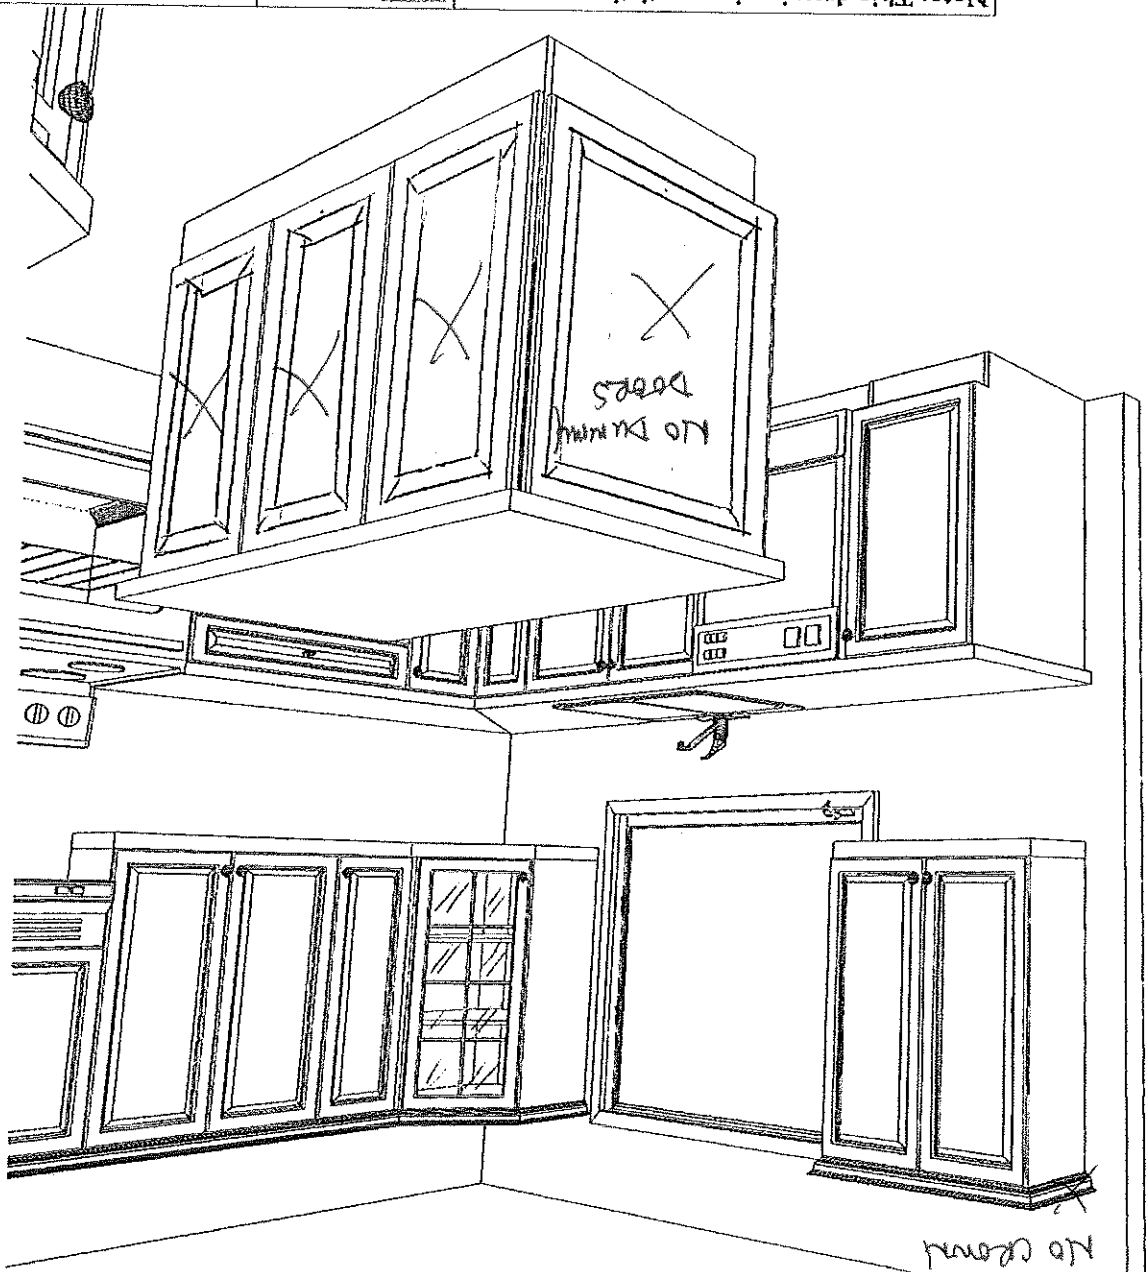

Note: This drawing is an artistic interpretation of the general appearance of the design. It is not meant to be an exact rendition.

DRAWN BY: Lori Di Saverio, B.I.D.
 CARTIER KITCHENS OTTAWA

DCR #11 SWS - 508 left - Kitchen

2020 TECHNOLOGIES

Designed: 7/26/2011
 Printed: 7/26/2011

All

Drawing #: 1

DCR PHOENIX HOMES

CHESAPEAKE (508)

ALT 4 BDRM
with 2ND ENSUITE
VANITIES


LOT #11
STRANDHERD MEADOWS 5

CUSTOMER APPROVAL


I have reviewed these drawings and understand the details of the layout and the Cartier Kitchens specifications.

Signature [Signature]

Date Nov. 23/11

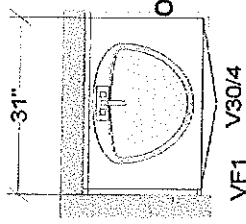


POWDER

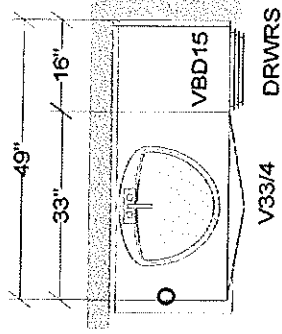


MAIN BATH

LINE 1
~~COMO GRIGIO~~
~~HU 88 HANDLES~~
~~COUNTERTOP: #949-58 - MATTE WHITE~~

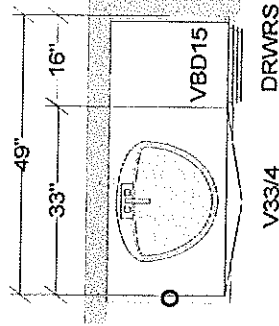

2ND ENSUITE

LINE 2
~~METRO THERMOFOIL~~
~~ANTHRASITE~~

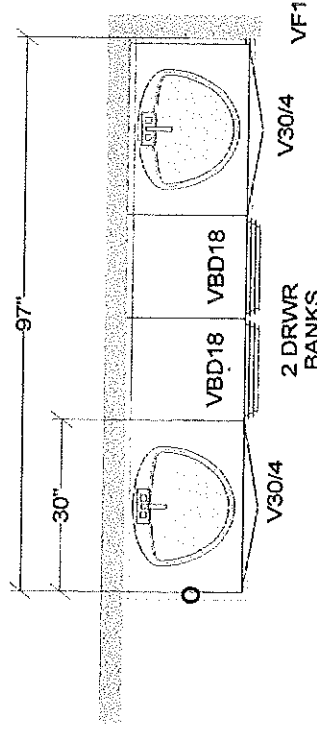

MASTER ENSUITE

LINE 2 -
~~MISSION THERMOFOIL~~
~~WHITE~~
~~KN42 KNOBS~~

~~COUNTER TOP - #949-58 - MATTE WHITE~~

All dimensions size designations given are subject to verification on job site and adjustment to fit job conditions.

CARTIER KITCHENS OTTAWA

DCR #11 SMS - VANITIES



20 YEARS
TECHNOLOGIES

This is an original design and must not be released or copied unless applicable fee has been paid or job order placed.

DRAWN BY: LD
CARTIER KITCHENS OTTAWA

Designed: 7/26/2011
Printed: 7/26/2011

AU

Drawing #: 1


CUSTOMER APPROVAL

I have reviewed these drawings and understand the details of the layout and the Carlier Kitchens specifications.

Signature: [Signature]

Date: Nov. 22/11

Powder room

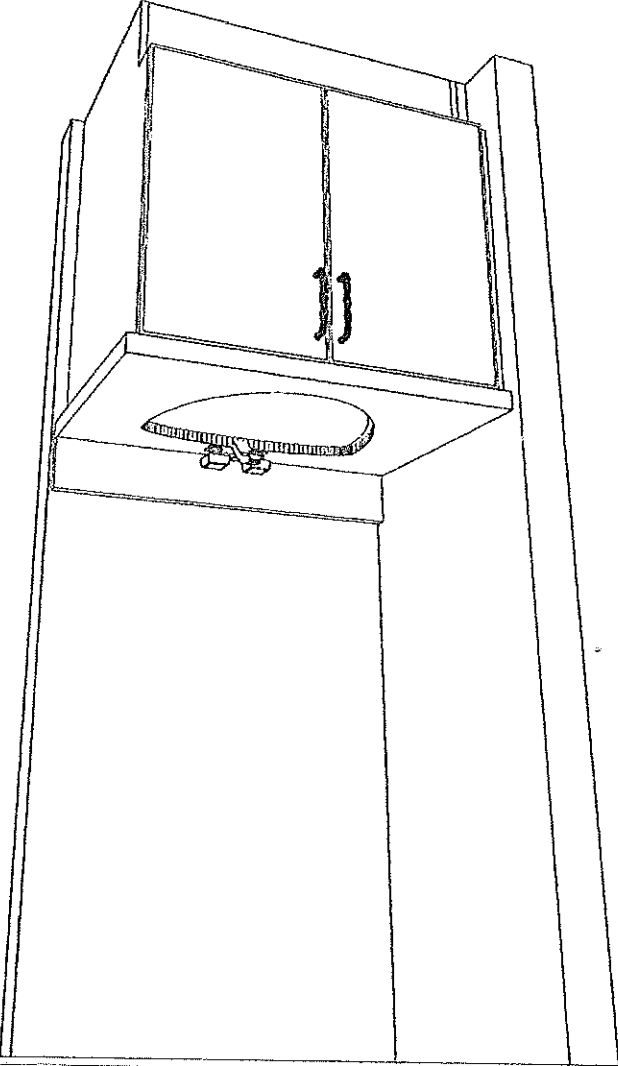


DCR #11 SMS - VANITIES		All		Drawing #: 1	
DRAWN BY: Lori Di Saverio, B.I.D.		2020		TECHNOLOGIES	
CARTIER KITCHENS OTTAWA		[Logo]		[Signature]	
Note: This drawing is an artistic interpretation of the general appearance of the design. It is not meant to be an exact rendition.		Designed: 7/26/2011		Printed: 7/26/2011	

CUSTOMER APPROVAL

I have reviewed these drawings and understand the details of the layout and the Carlier Kitchens specifications.

Signature: *[Signature]*

Date: *Nov. 22/11*

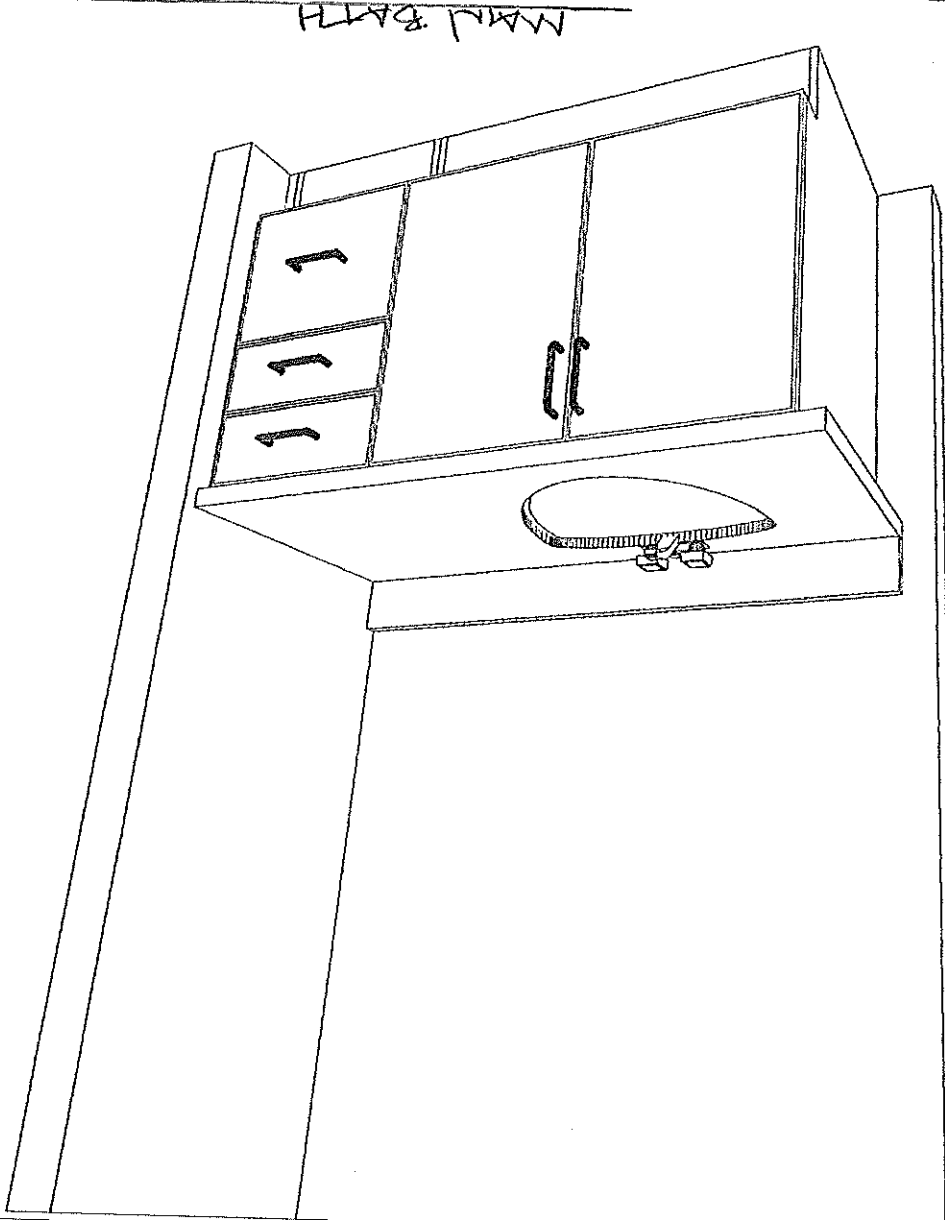

MAL BATH

Note: This drawing is an artistic interpretation of the general appearance of the design. It is not meant to be an exact rendition.

DRAWN BY: Lori Di Saverio, B.L.D.
CARLIER KITCHENS OTTAWA

DCR #11 SMS - VANITIES

2020 TECHNOLOGIES

MC-415

Designed: 7/26/2011
Printed: 7/26/2011

All


Drawing #: 1

CUSTOMER APPROVAL

I have reviewed these drawings and understand the details of the layout and the Carlier Kitchens specifications.

Signature: *[Signature]*

Date: Nov. 22/11

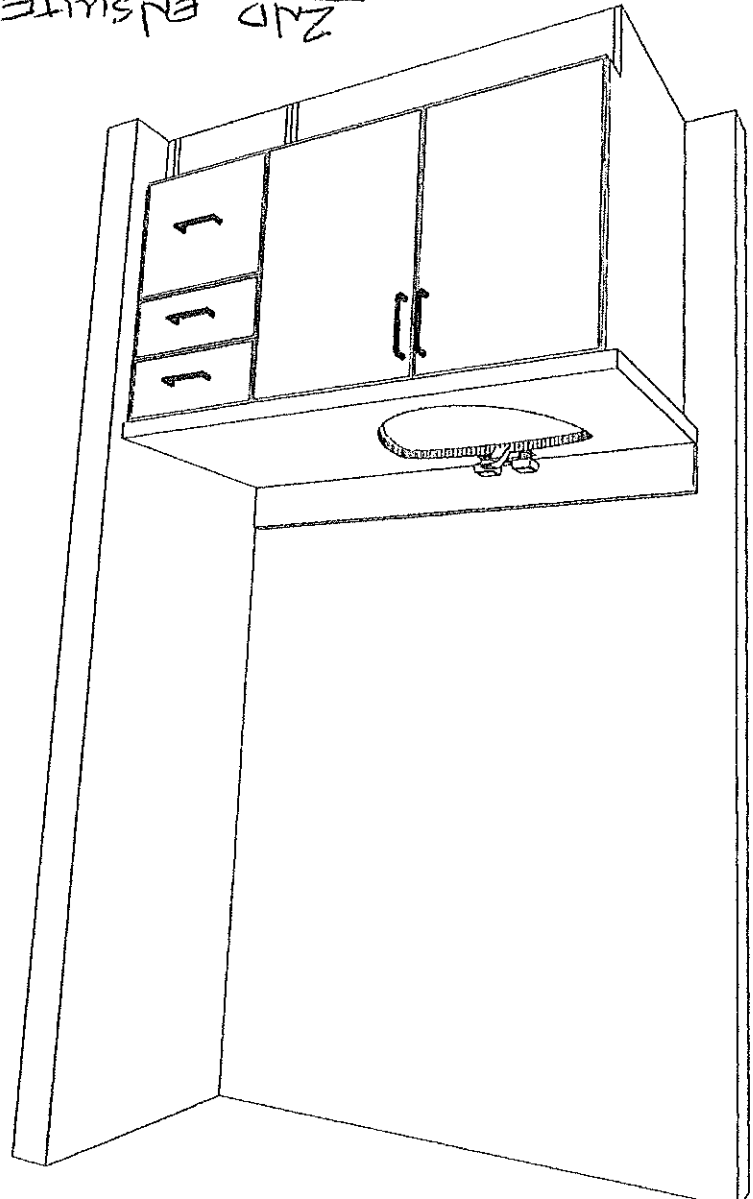

ZAD ensuite

Note: This drawing is an artistic interpretation of the general appearance of the design. It is not meant to be an exact rendition.

DRAWN BY: Lori Di Saverio, B.I.D.
 CARTIER KITCHENS OTTAWA
 DCR #11 SMS - VANITIES

2020 TECHNOLOGIES

Printed: 7/26/2011
 Designed: 7/26/2011

All


Drawing #: 1

CUSTOMER APPROVAL

I have reviewed these drawings and understand the details of the layout and the Carter Kitchens specifications.

Signature: *Steph Bonheur*

Date: Nov. 22 / 11

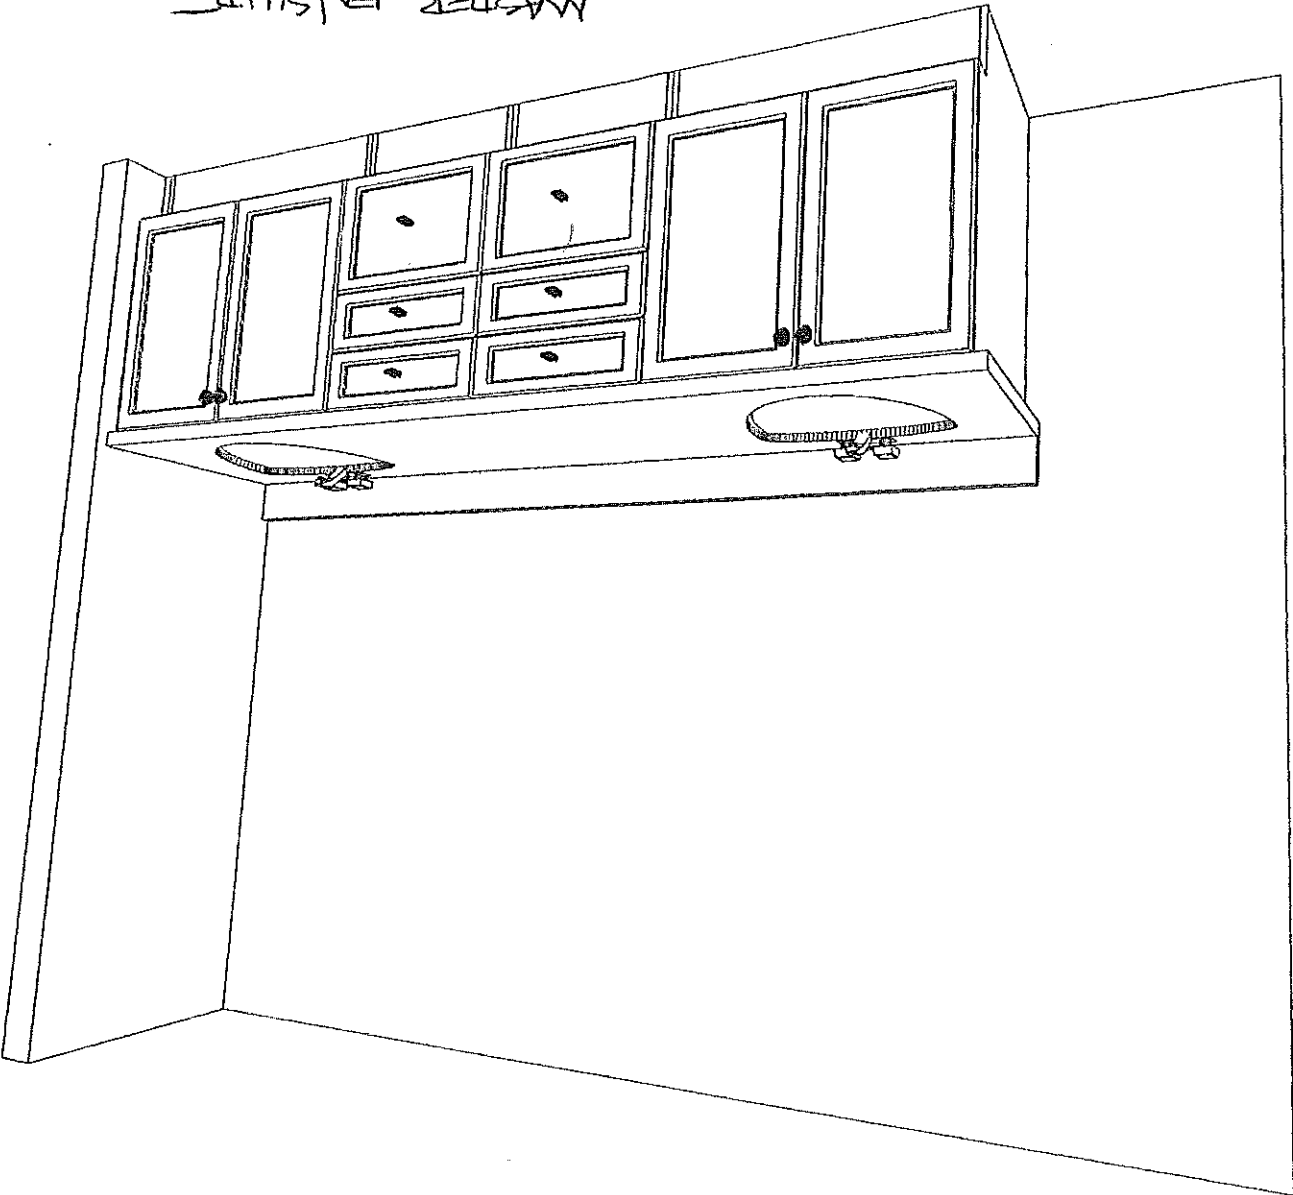

MASTER SUITE

Note: This drawing is an artistic interpretation of the general appearance of the design. It is not meant to be an exact rendition.

DRAWN BY: Lori Di Saverio, B.I.D.
CARTER KITCHENS OTTAWA

DCR #11 SMS - VANITIES

DESIGNED: 7/26/2011
PRINTED: 7/26/2011

2020 TECHNOLOGIES

QC-MS

All

Drawing #: 1