

DCR PHOENIX HOMES

STRANDHERD MEADOWS 5

LOT #20

YARMOUTH (511) - RIGHT

KITCHEN

STAGGERED MOUNTING HEIGHT = 93" & 99"

REVISED: OCTOBER 20, 2011

CUSTOMER APPROVAL

I have reviewed these drawings and understand the details of the layout and the Cartier Kitchens specifications.

Signature: *D. Frei*

Date: *Dec. 6, 2011*

CABINET SERIES : LINE 3
DOOR STYLE : MALIBU
SPECIES - MAPLE

COLOUR - TBC


HARDWARE - BC

KICK: 4-PCS.

STD WHITE INTERIORS

METAL DRAWER BOXES

2 - PCS. 90 DEG. CORNER MOULD.

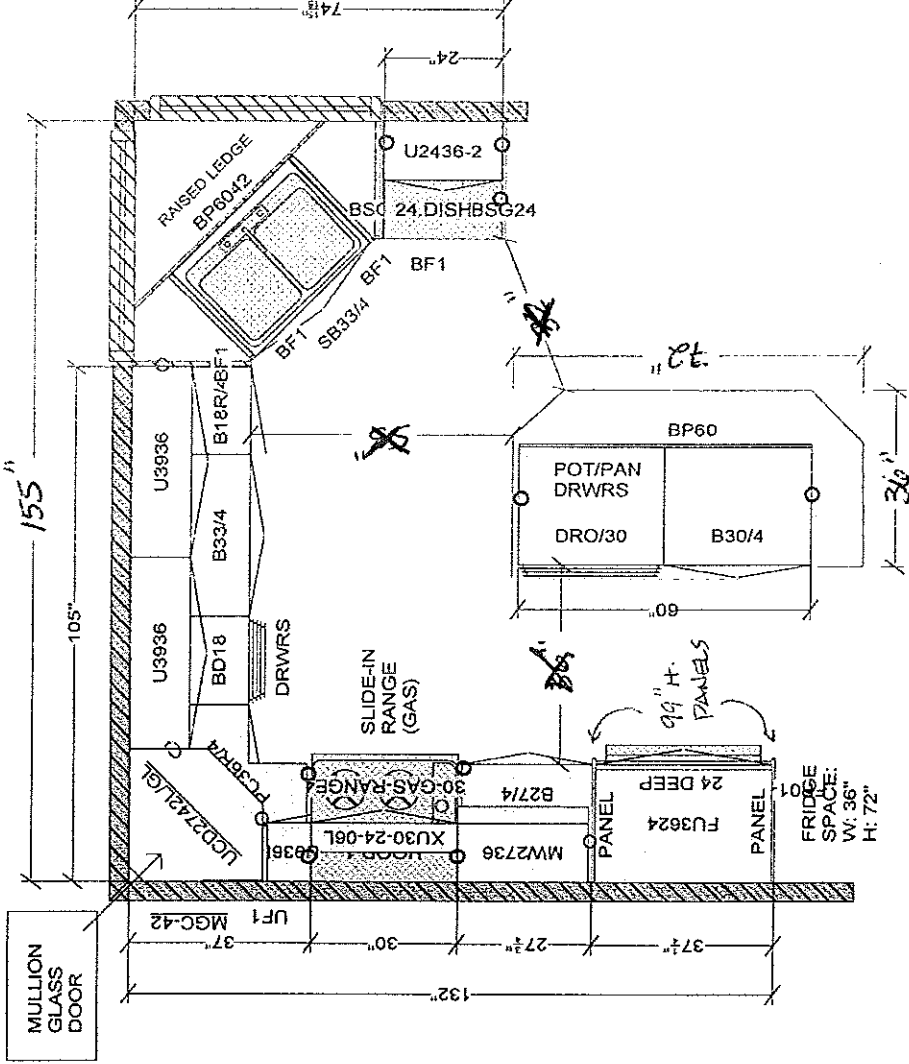

All dimensions, size designations given are subject to verification on job site and adjustment to fit job conditions.

CARTIER KITCHENS OTTAWA

DCR - 20 STRANDHERD MEADOWS - KITCHEN 1



20 YEARS
TECHNOLOGIES


This is an original design and must not be released or copied unless applicable fee has been paid or job order placed.

DRAWN BY: LD
CARTIER KITCHENS OTTAWA

Designed: 7/18/2011
Printed: 10/20/2011

All

Drawing #: 1 | No Scale

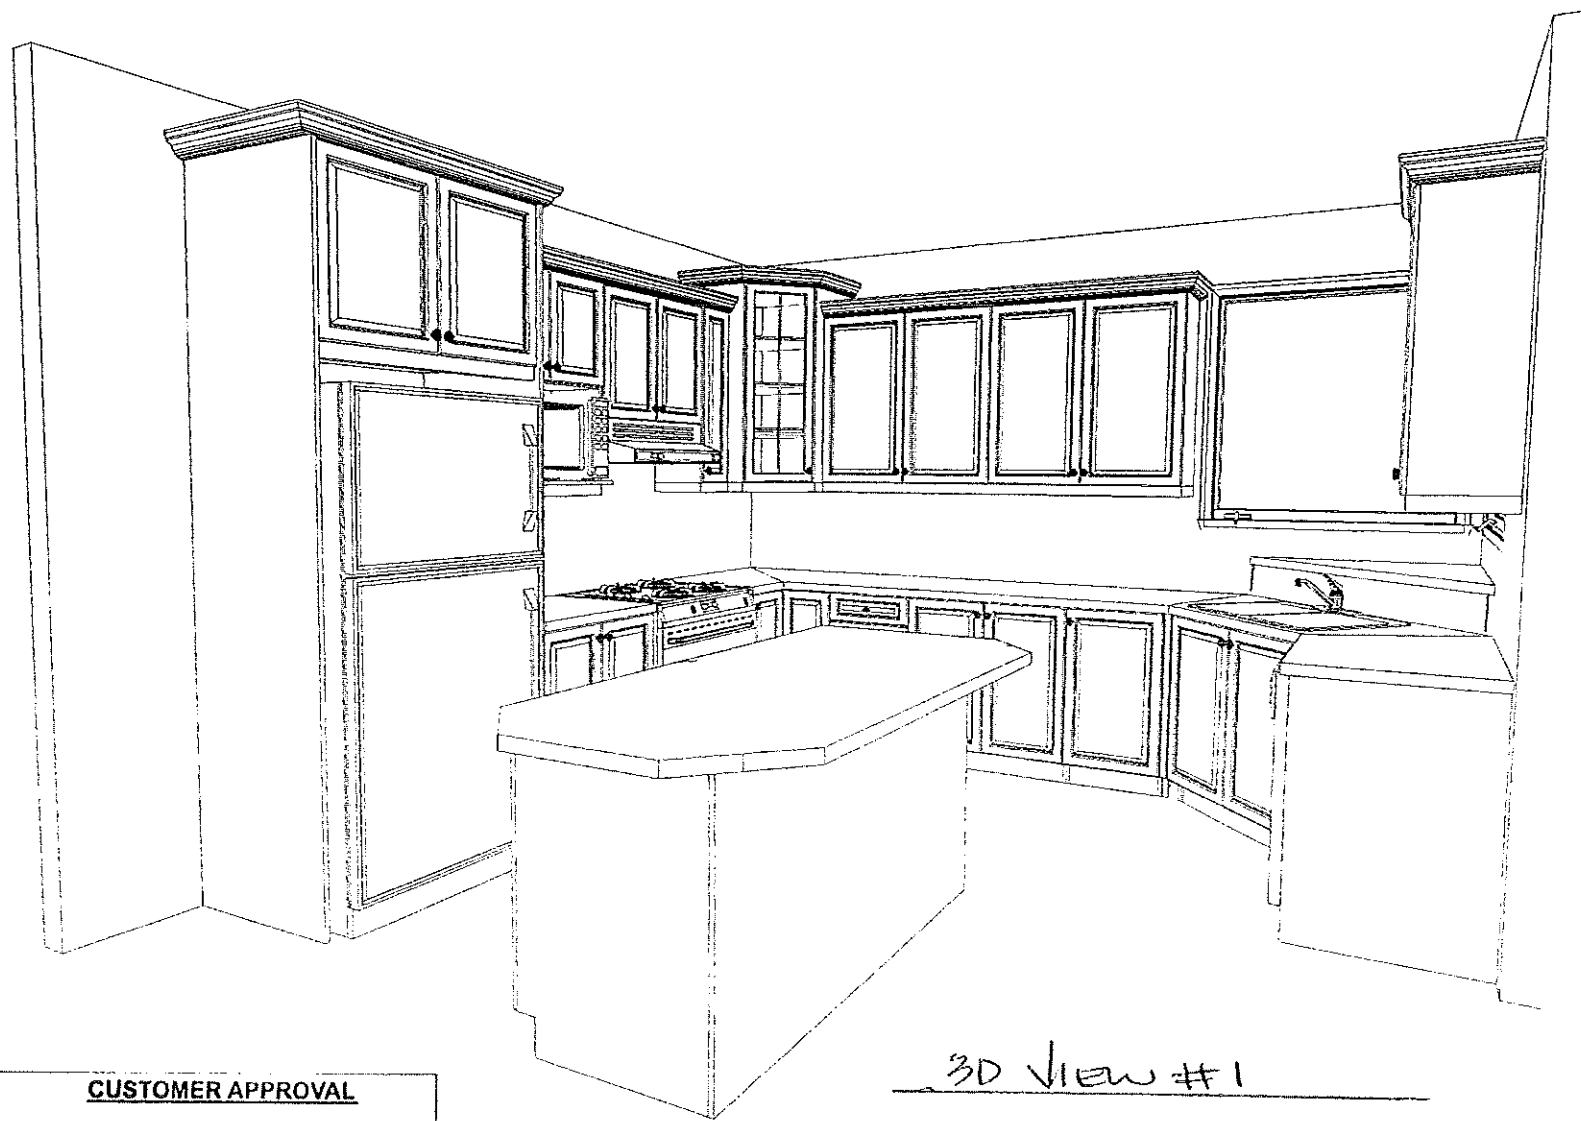

3D View #1

CUSTOMER APPROVAL


I have reviewed these drawings and understand the details of the layout and the Cartier Kitchens specifications.

Signature

Date

[Signature]
Dec 6, 2011 *Dec. 20, 2011*

Note: This drawing is an artistic interpretation of the general appearance of the design. It is not meant to be an exact rendition.

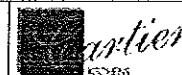


Designed: 7/18/2011
 Printed: 10/20/2011

DESIGNED BY: LORI DISAVERIO,
 DCR - 20 STRANDHERD MEADOWS -

All

Drawing #: 1

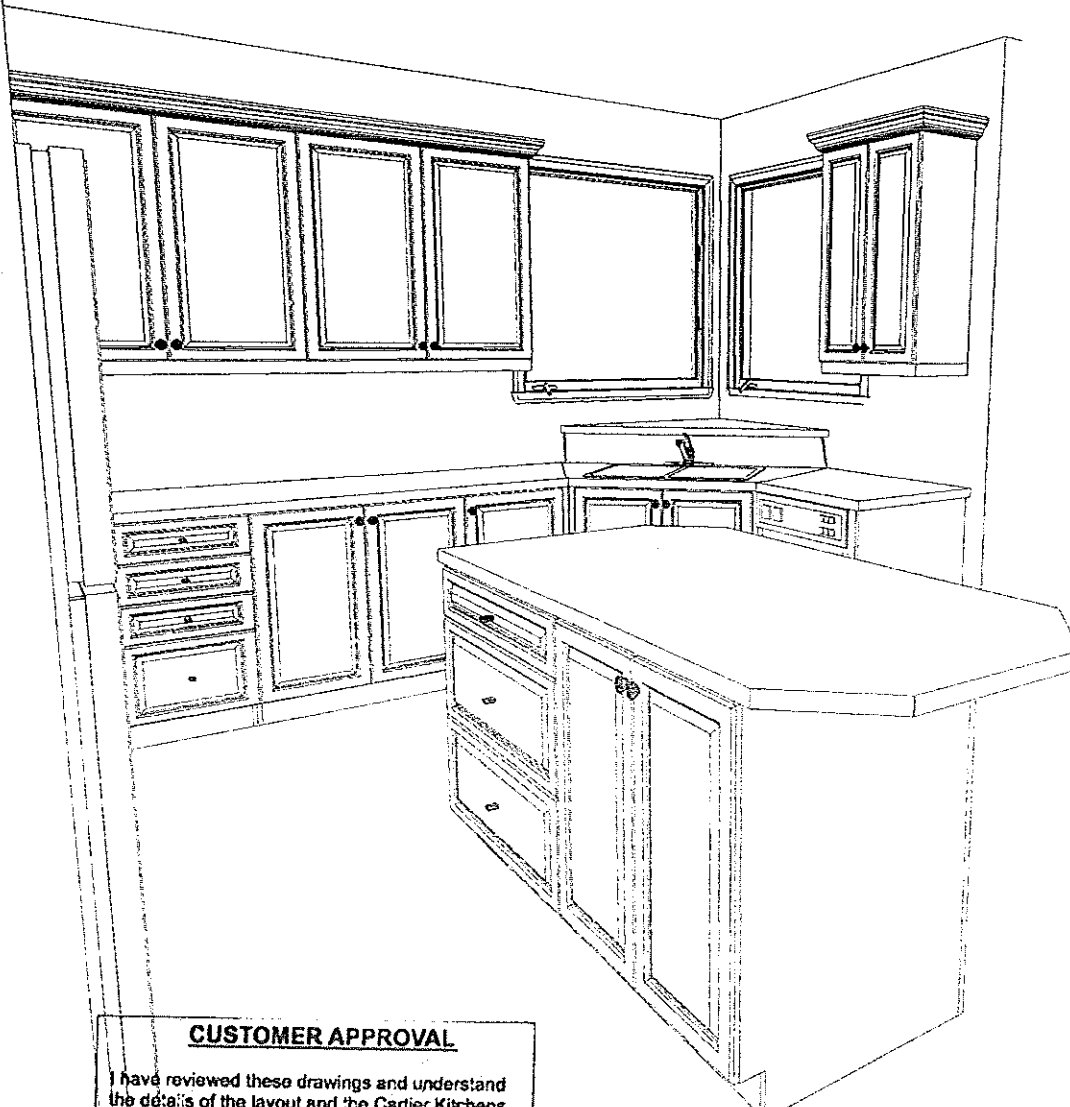


3D VIEW # 2

CUSTOMER APPROVAL

I have reviewed these drawings and understand the details of the layout and the Cartier Kitchens specifications.

Signature

Date

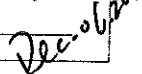
 Dec 06, 2011


Note: This drawing is an artistic interpretation of the general appearance of the design. It is not meant to be an exact rendition.





Designed: 7/18/2011
Printed: 10/20/2011

DESIGNED BY: LORI DISAVERIO.
DCR - 20 STRANDHERD MEADOWS -

All

Drawing #: 1

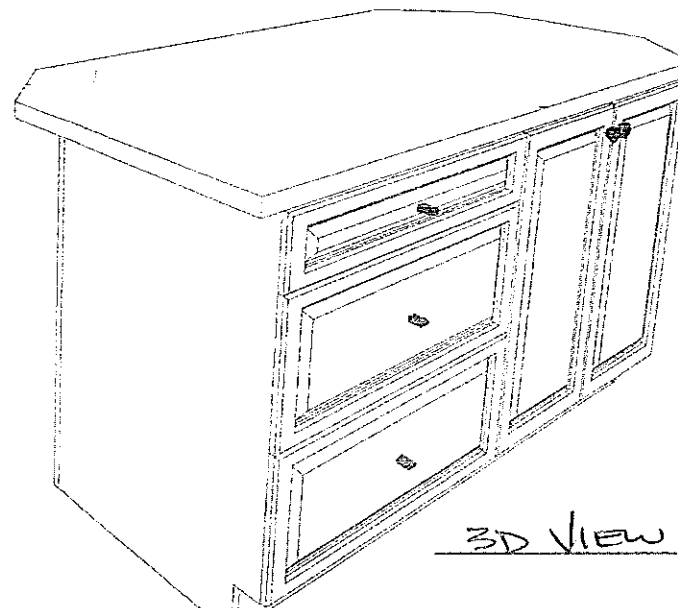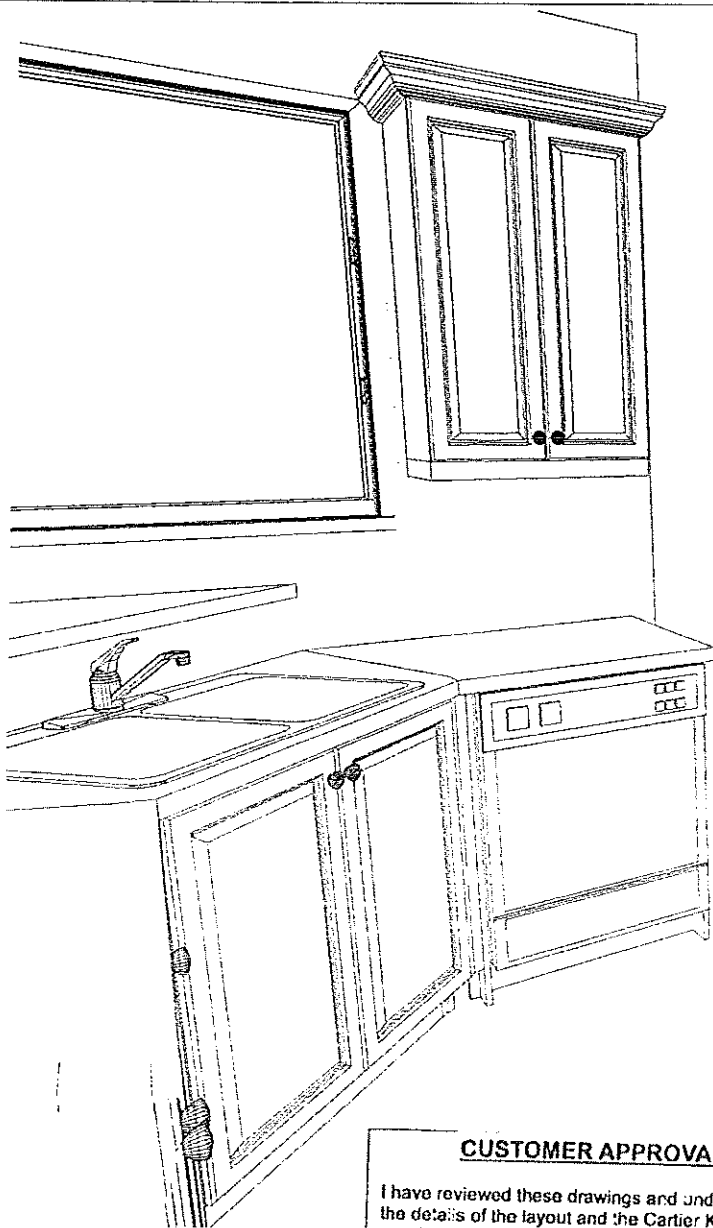

CUSTOMER APPROVAL

I have reviewed these drawings and understand the details of the layout and the Cartier Kitchens specification.

Signature [Signature]
Date Dec. 6, 2011

Note: This drawing is an artistic interpretation of the general appearance of the design. It is not meant to be an exact rendition.



Designed: 7/18/2011
Printed: 10/20/2011



DESIGNED BY: LORI DISAVERIO,
DCR - 20 STRANDHERD MEADOWS -


All

Drawing #: 1

DCR PHOENIX HOMES


STRANDHERD MEADOWS 5
LOT #20
YARMOUTH (511)
ALT 4 BDRM / 2ND ENSUITE
VANITIES

CUSTOMER APPROVAL
I have reviewed these drawings and understand the details of the layout and the Cartier Kitchens specifications.
Signature *[Signature]*
Date *Dec 06, 2011*

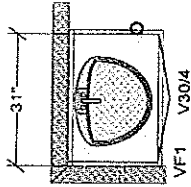


CABINET SERIES:
STYLE & COLOUR:
HW:
STD WHITE INTERIORS
METAL DRAWER BOXES

POWDER ROOM

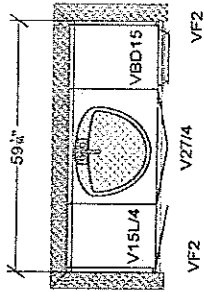


MAIN BATH

CABINET SERIES:
STYLE & COLOUR:
HW:
STD WHITE INTERIORS
METAL DRAWER BOXES

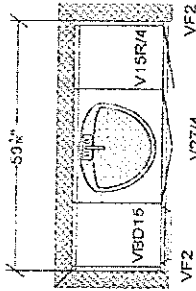

2ND ENSUITE


CABINET SERIES:
STYLE & COLOUR:
HW:
STD WHITE INTERIORS
METAL DRAWER BOXES

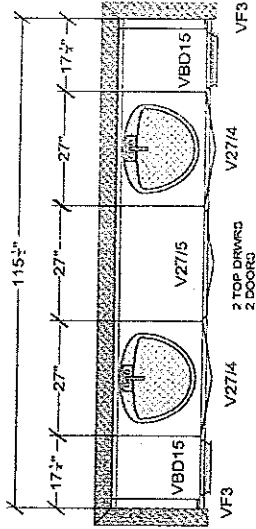

ENSUITE

CABINET SERIES:
STYLE & COLOUR:
HW:
STD WHITE INTERIORS
METAL DRAWER BOXES

All dimensions - size designations given are subject to verification on job site and adjustment to fit job conditions.			This is an original design and must not be released or copied unless applicable fee has been paid or job order placed.	Designed: 10/20/2011 Printed: 10/20/2011
CARTIER KITCHENS OTTAWA	20 YEARS	TECHNOLOGIES	DRAWN BY: LD CARTIER KITCHENS OTTAWA	
DCR #20 SM5 - VANITIES	All		Drawing #: 1	No Scale.

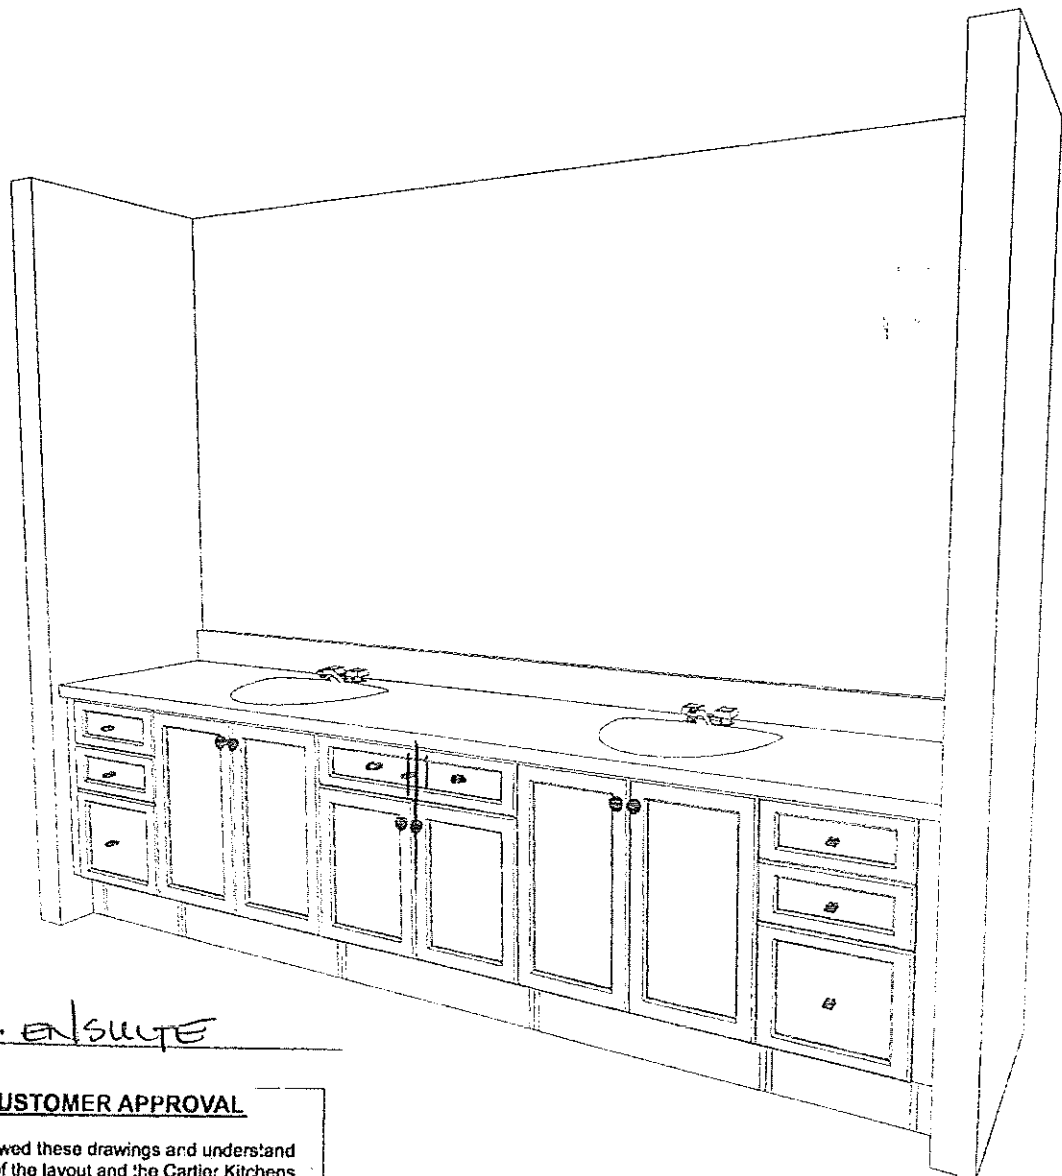

MASTER EN SUITE

CUSTOMER APPROVAL

I have reviewed these drawings and understand the details of the layout and the Cartier Kitchens specifications.

Signature [Signature]
 Date Dec 16, 2011 Dec 20, 2011

Note: This drawing is an artistic interpretation of the general appearance of the design. It is not meant to be an exact rendition.



DESIGNED BY: LORI DISAVERIO,
 DCR #20 SM5 - VANITIES

Designed: 10/20/2011
 Printed: 10/20/2011

All

Drawing #: 1