



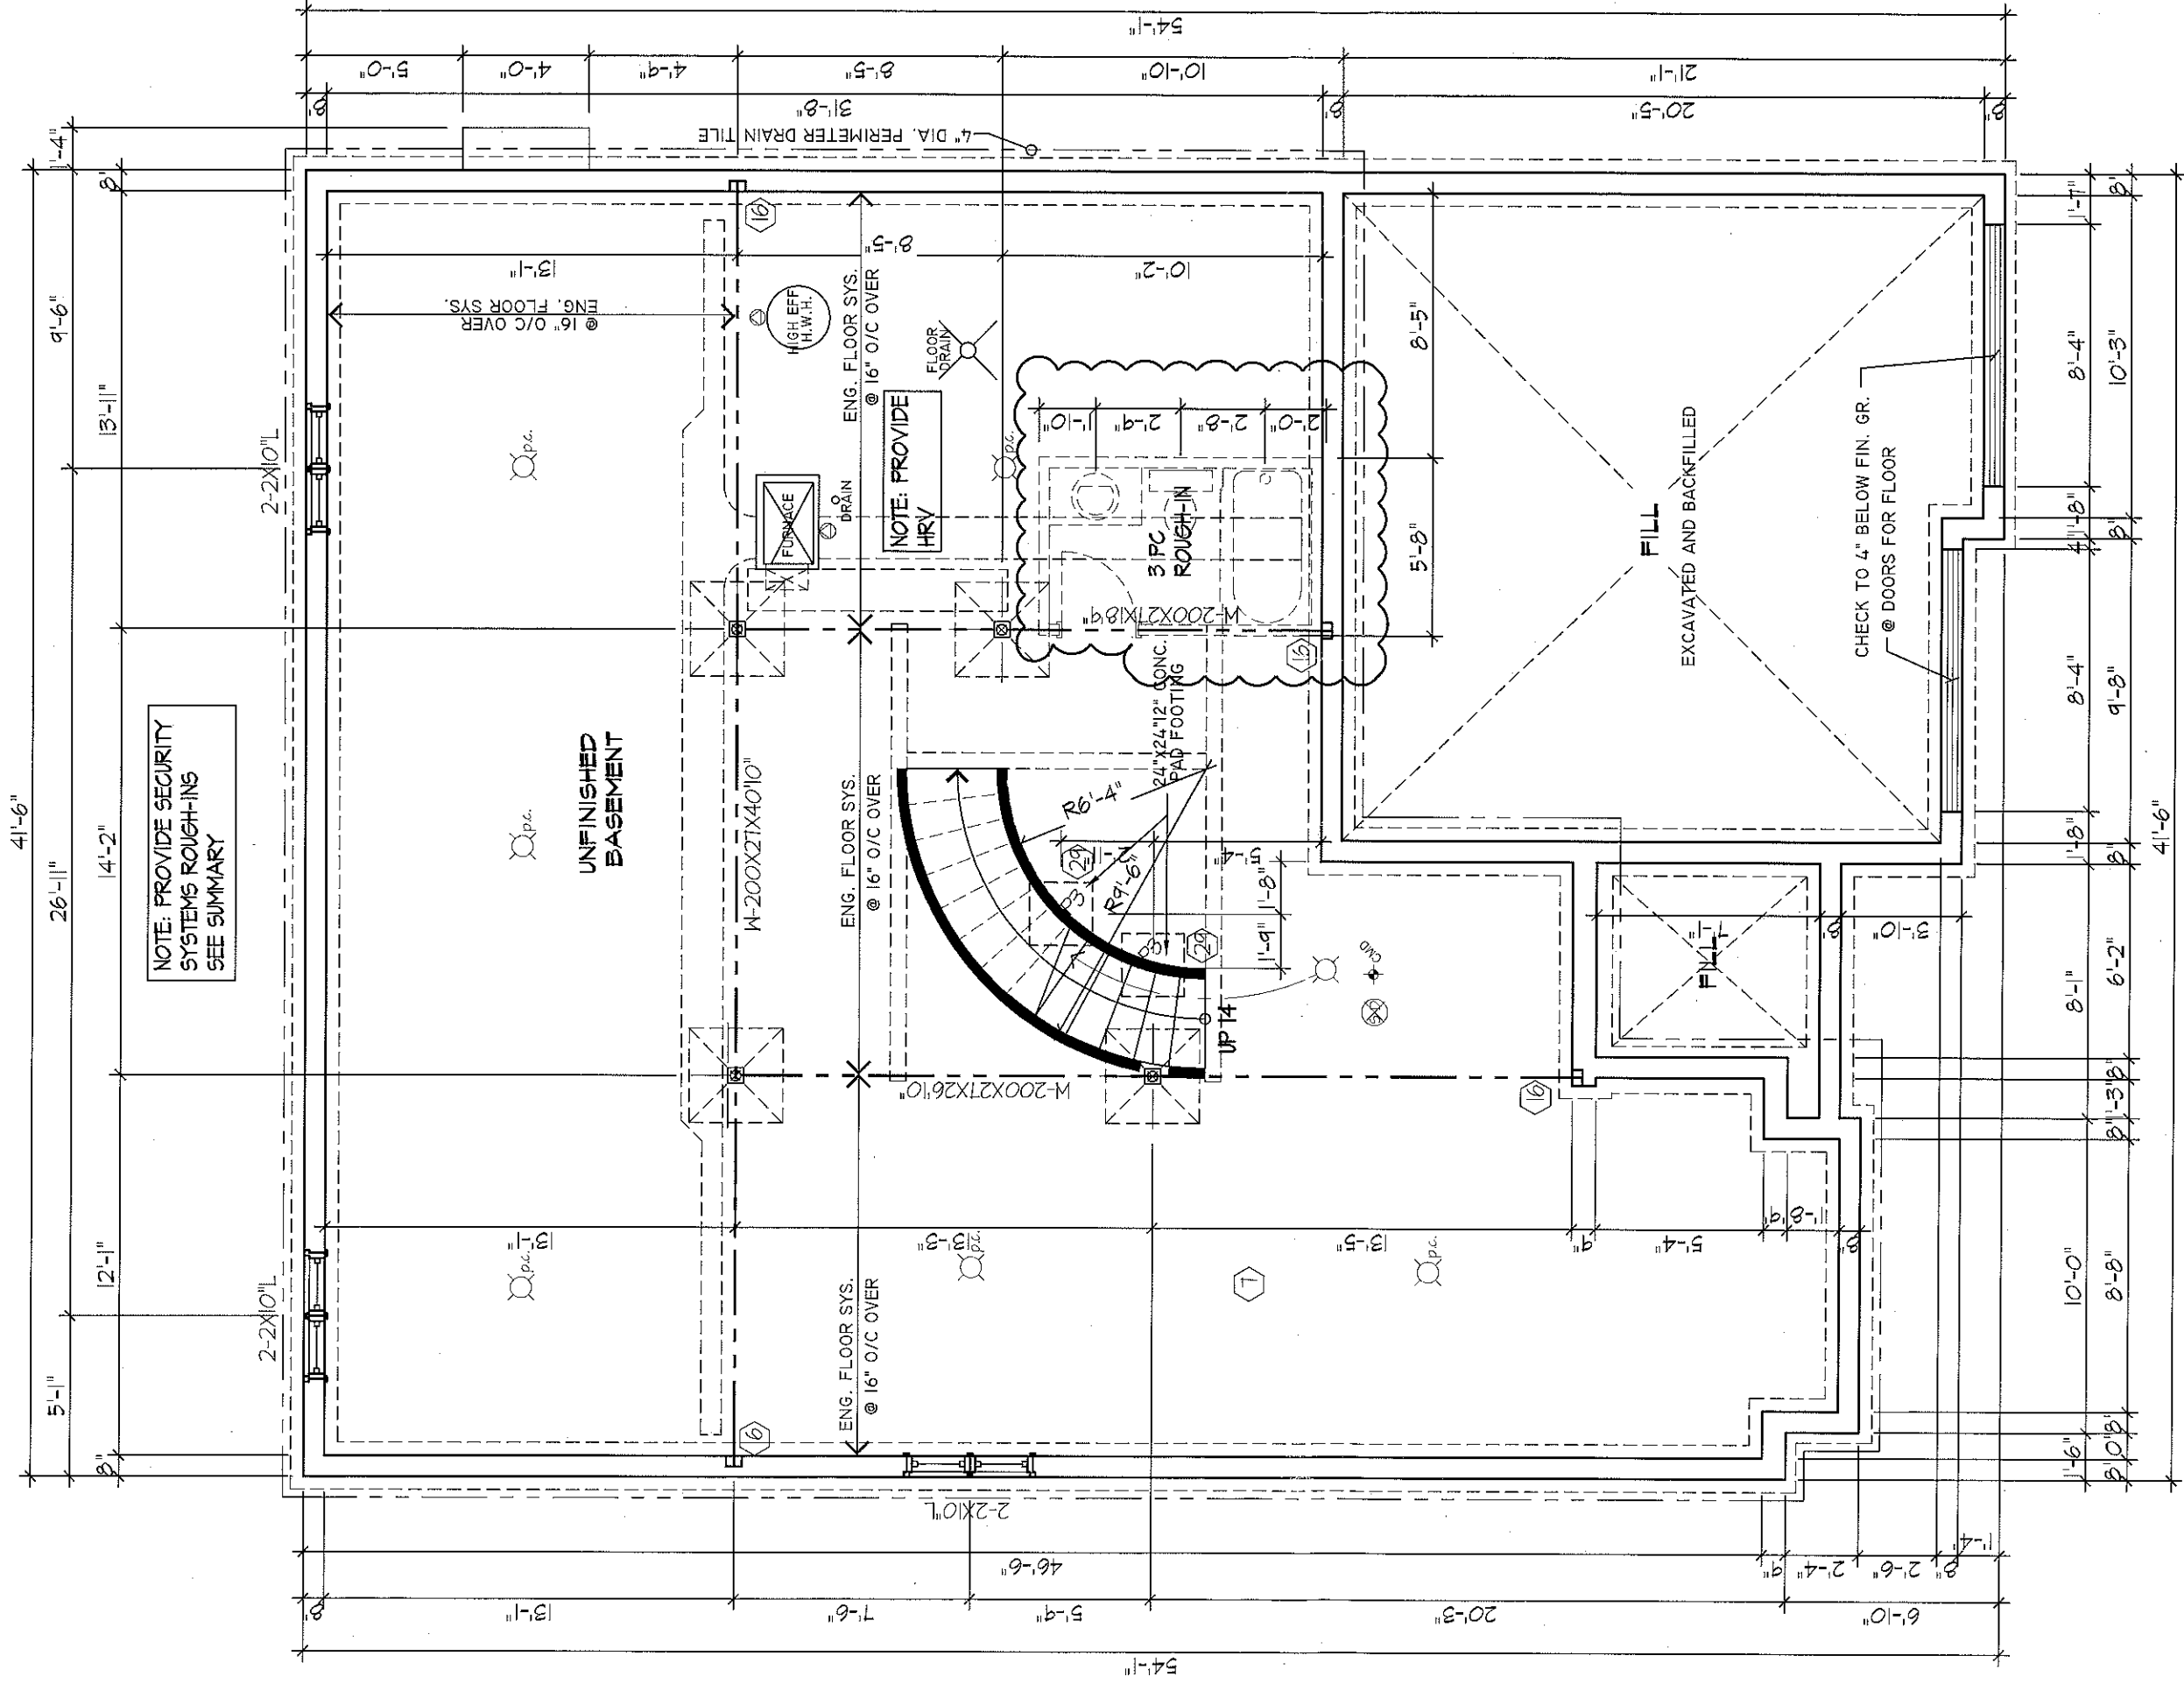

BASEMENT FLOOR PLAN ELEV. A

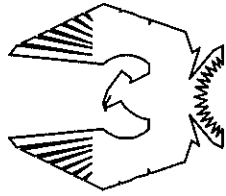

PHOENIX HOMES

CHEASAPEAKE-2007-A

SITE: SM PHASE 5


LOT NUMBER:
CIVIC ADDRESS:
353 BAMBURGH WAY

26


PHOENIX HOMES

file number:	508
drawn by:	A. FRANCOEUR
date:	OCT. 2003
scale:	3/16"=1'
sheet no:	29

No.	Description	Date	By
3	REV. AS PER CONST. SUMMARY	MAY7-12	SD
2	REV. AS PER CONST. SUMMARY	APR14-12	SD
1	ISSUED FOR FOUNDATION ONLY	JAN14-12	SD

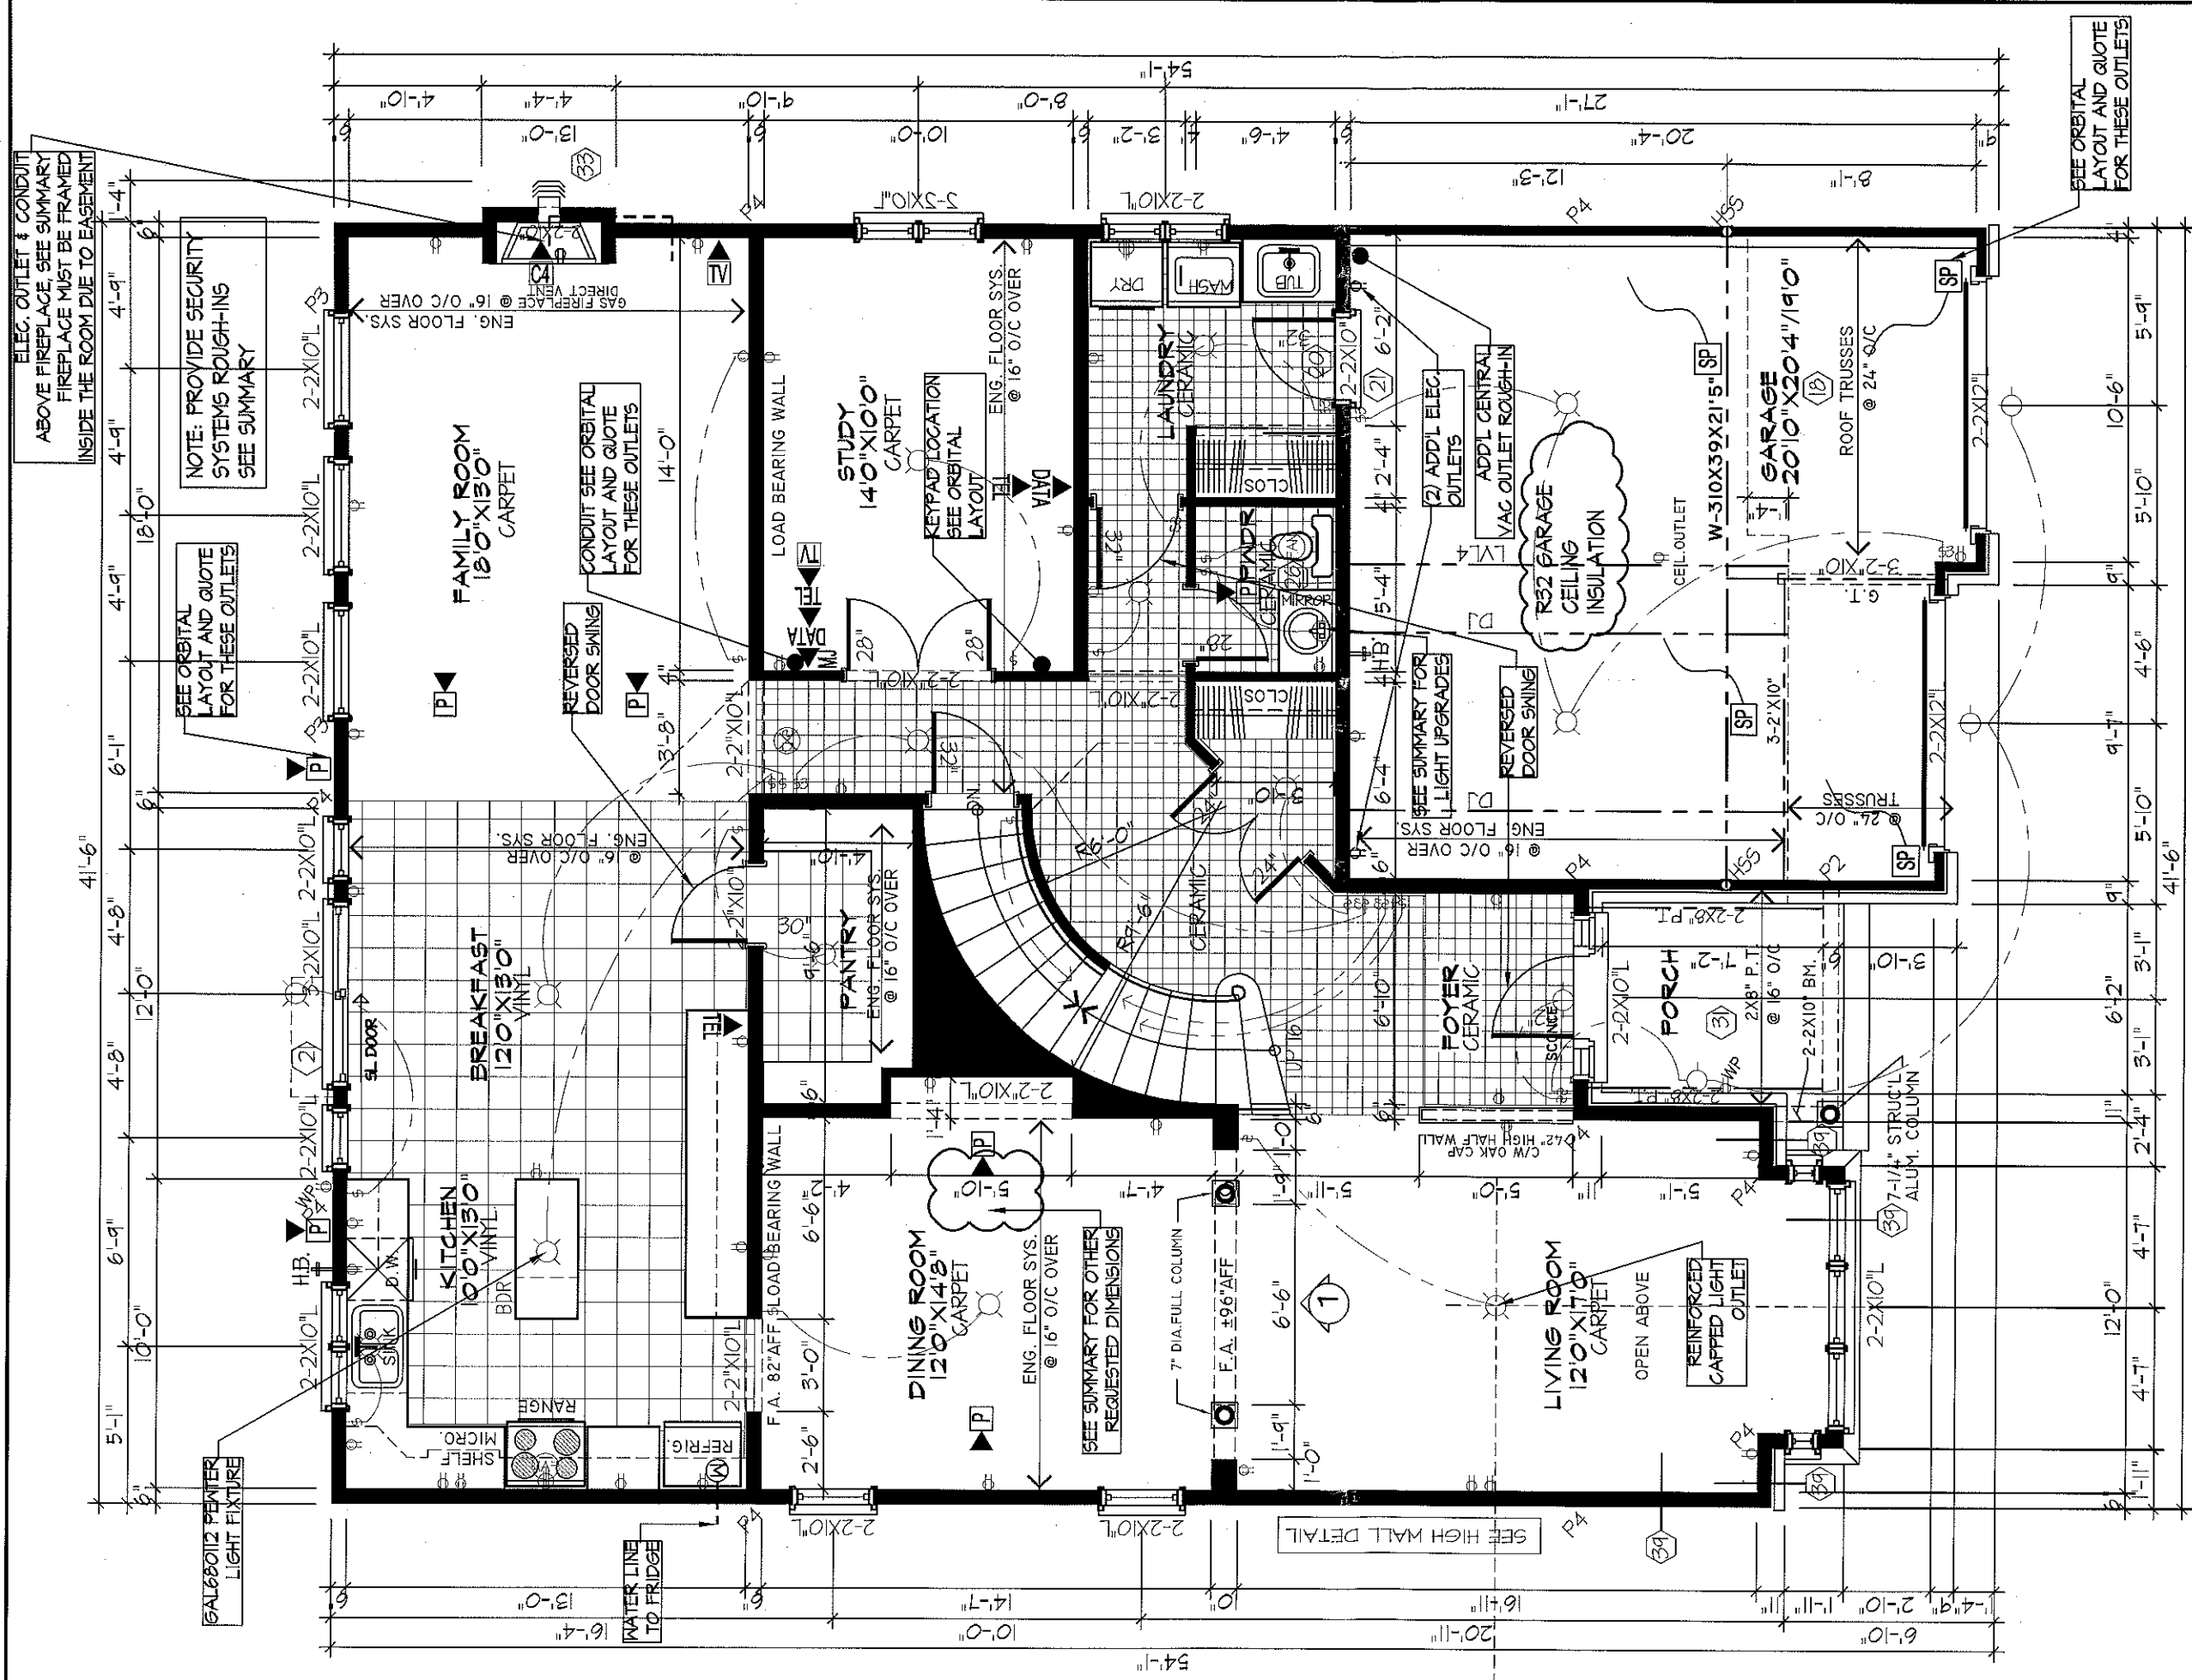

MAIN FLOOR PLAN ELEV. A - 635 SF
(ALT.4 BEDROOM)

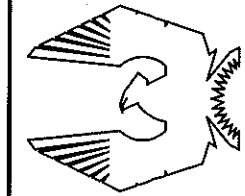

PHOENIX HOMES

CHEASAPEAKE-2007-A-4/5

SITE: SM PHASE 5

LOT NUMBER:


CIVIC ADDRESS:
555 BAMBURGH WAY

26


file number:	508
drawn by:	A. FRANCOER
date:	OCT. 2003
scale:	3/16"=1'
sheet no:	3A.4/5
	9

No.	Description	By
3	REV. AS PER CONST. SUMMARY	MATY-12
2	REV. AS PER CONST. SUMMARY	APR14-12
1	ISSUED FOR FOUNDATION ONLY	JAN19-12

NOTE: PROVIDE SECURITY
SYSTEMS ROUGH-INS
SEE SUMMARY

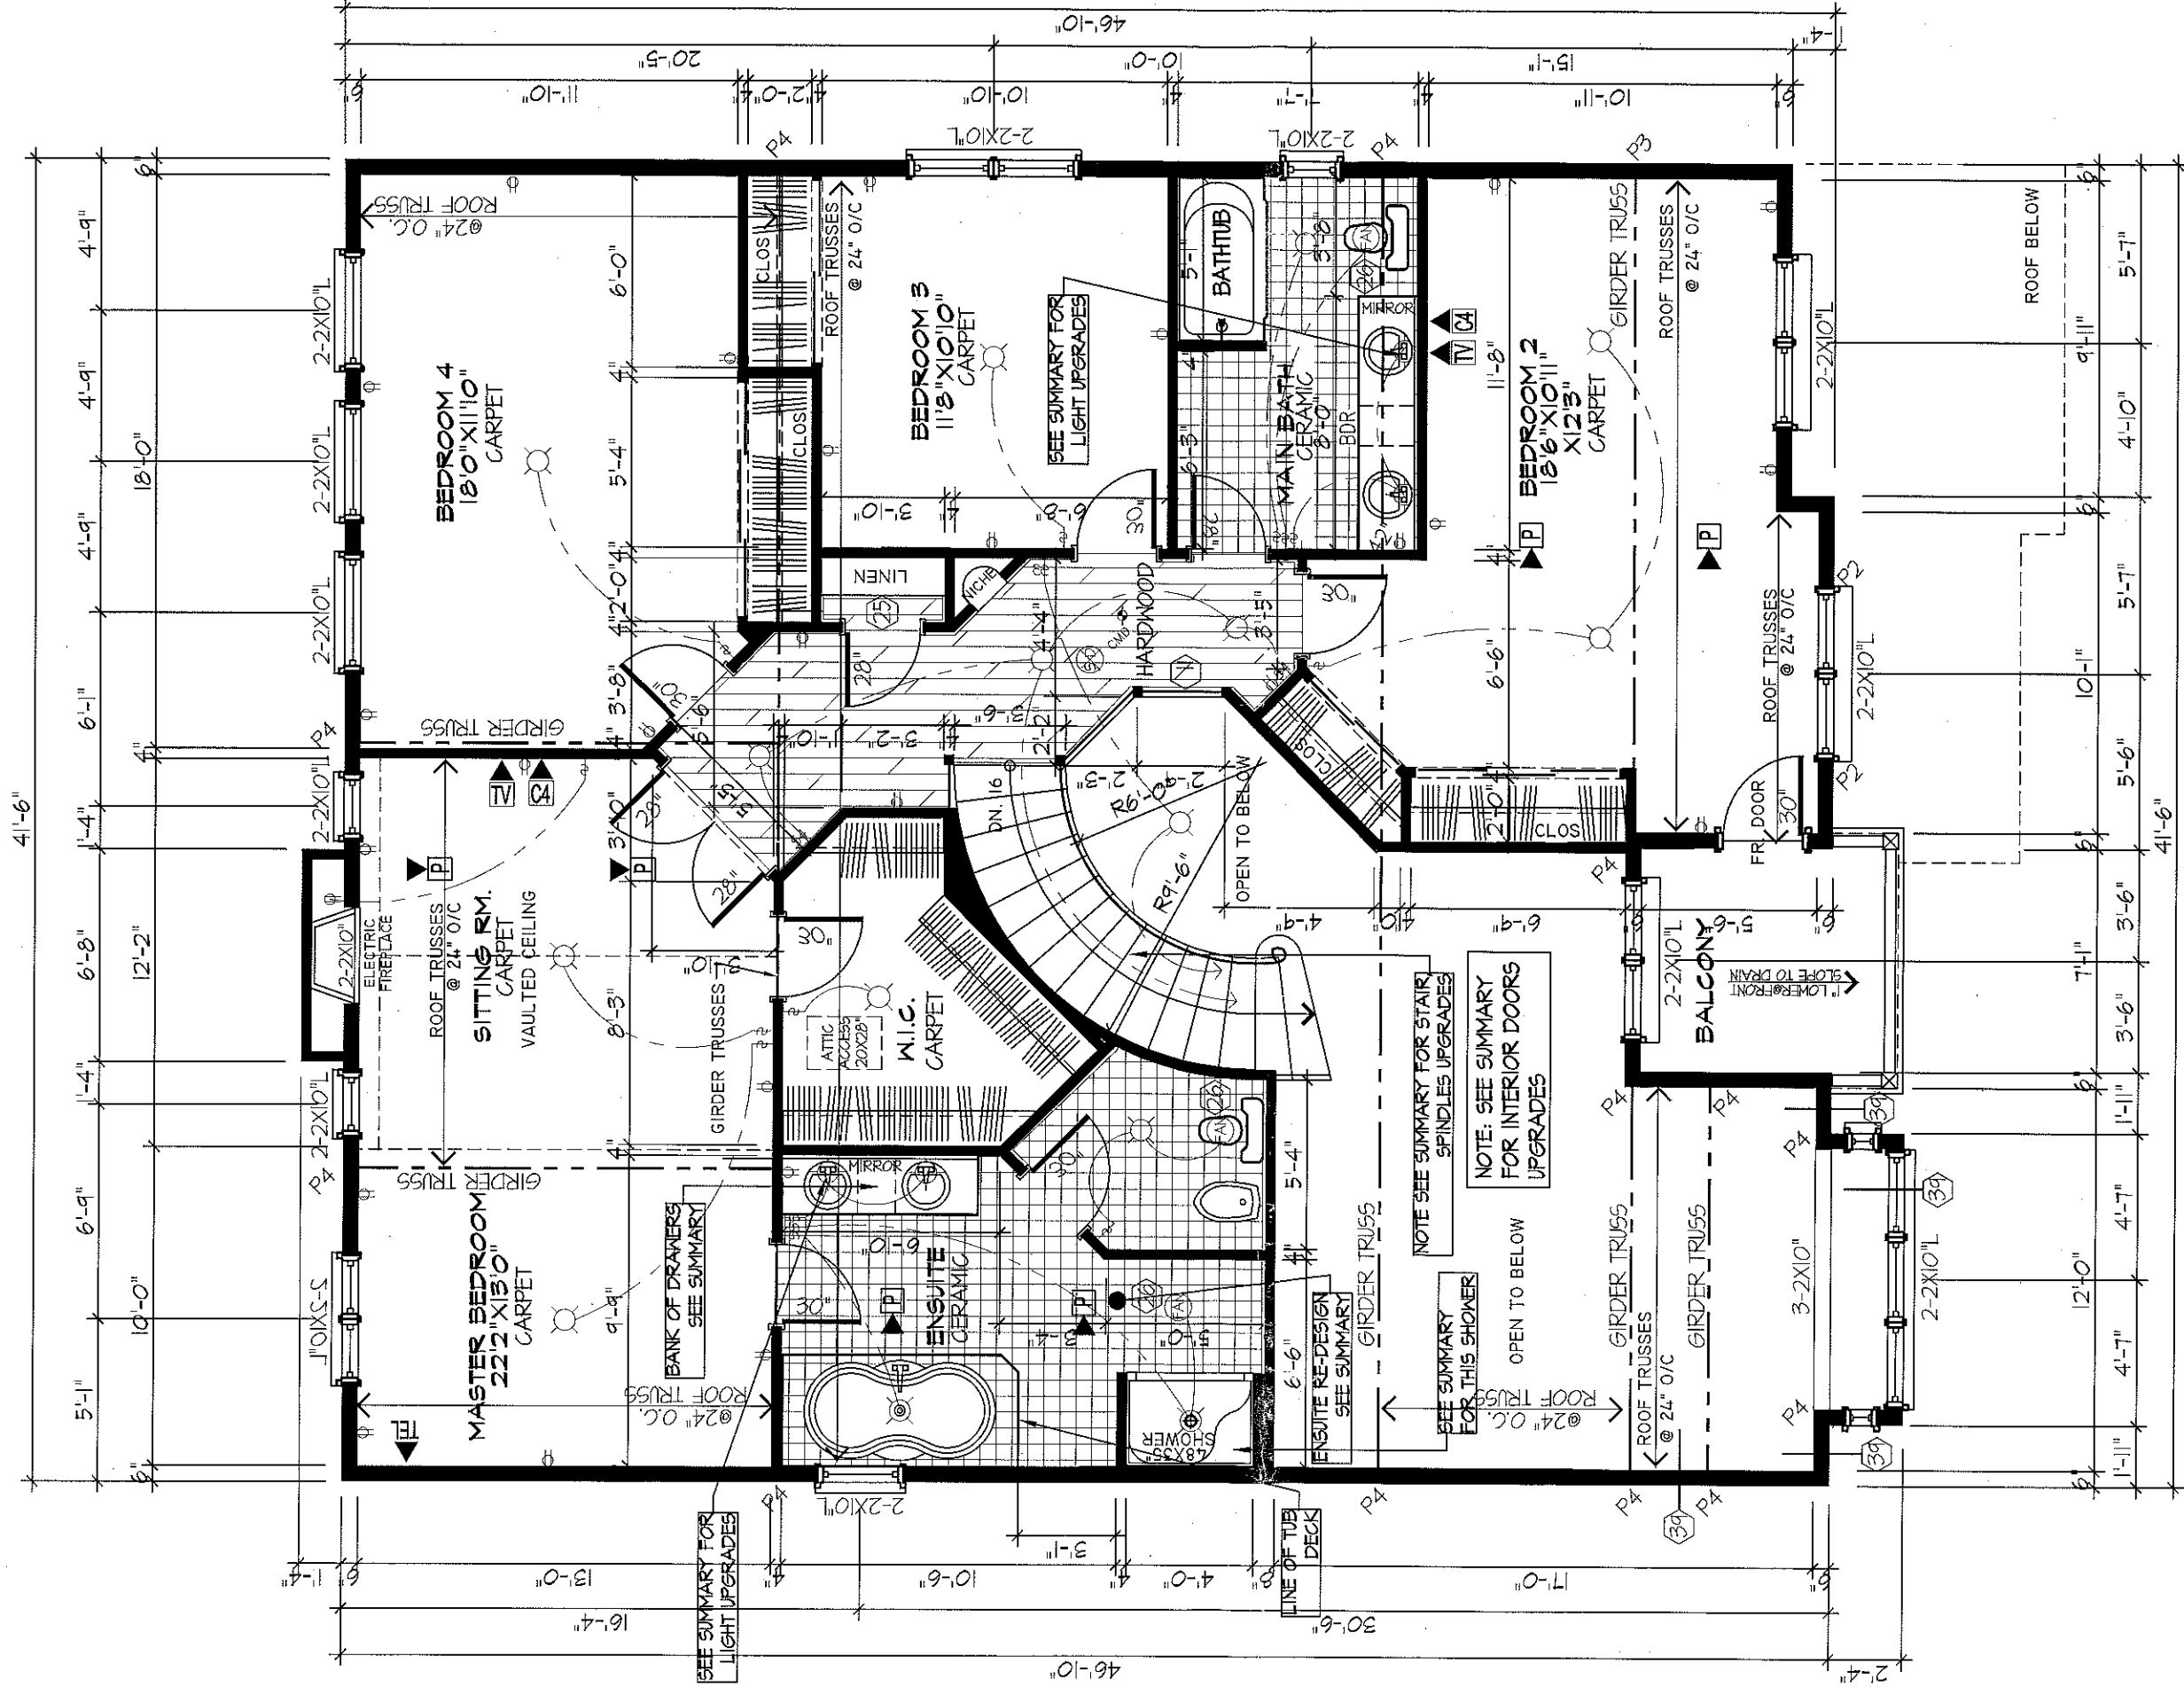

SECOND FLOOR PLAN ELEV. A - 1563 SF (ALT. 4 BEDROOM)

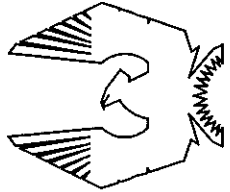

PHOENIX HOMES

CHEASAPEAKE-2007-A-4

SITE: SM PHASE 5

LOT NUMBER:

CIVIC ADDRESS:
553 BAMBURGH WAY

26

file number: 508

drawn by: A. FRANCOEUR

date: OCT. 2003

scale: 3/16"=1'

sheet no:

4A.4
9

3 REV. AS PER CONST. SUMMARY

MAY12 SD

2 REV. AS PER CONST. SUMMARY

APR12 SD


1 ISSUED FOR FOUNDATION ONLY

JAN12 SD

By

Date


REVISIONS

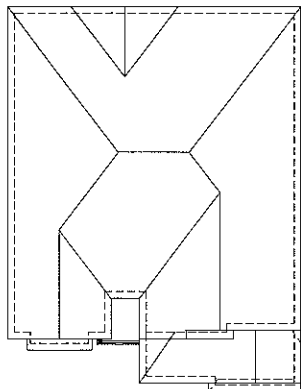

ROOF PLAN-A



FRONT ELEVATION 'A'

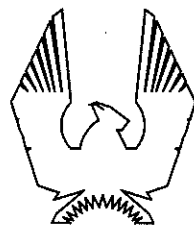

PHOENIX HOMES

CHEASAPEAKE-2007-A

SITE: SM PHASE 5

LOT NUMBER:

26

CIVIC ADDRESS:
353 BAMBURGH WAY

No.	Description	Date	By
3	REV. AS PER CONST. SUMMARY	MAY7-12	SD
2	REV. AS PER CONST. SUMMARY	APR19-12	SD
1	ISSUED FOR FOUNDATION ONLY	JAN19-12	SD
REVISIONS			

file number: 508

drawn by: A. FRANCOEUR


date: OCT. 2003

scale: 3/16"=1'


sheet no:

5A

9

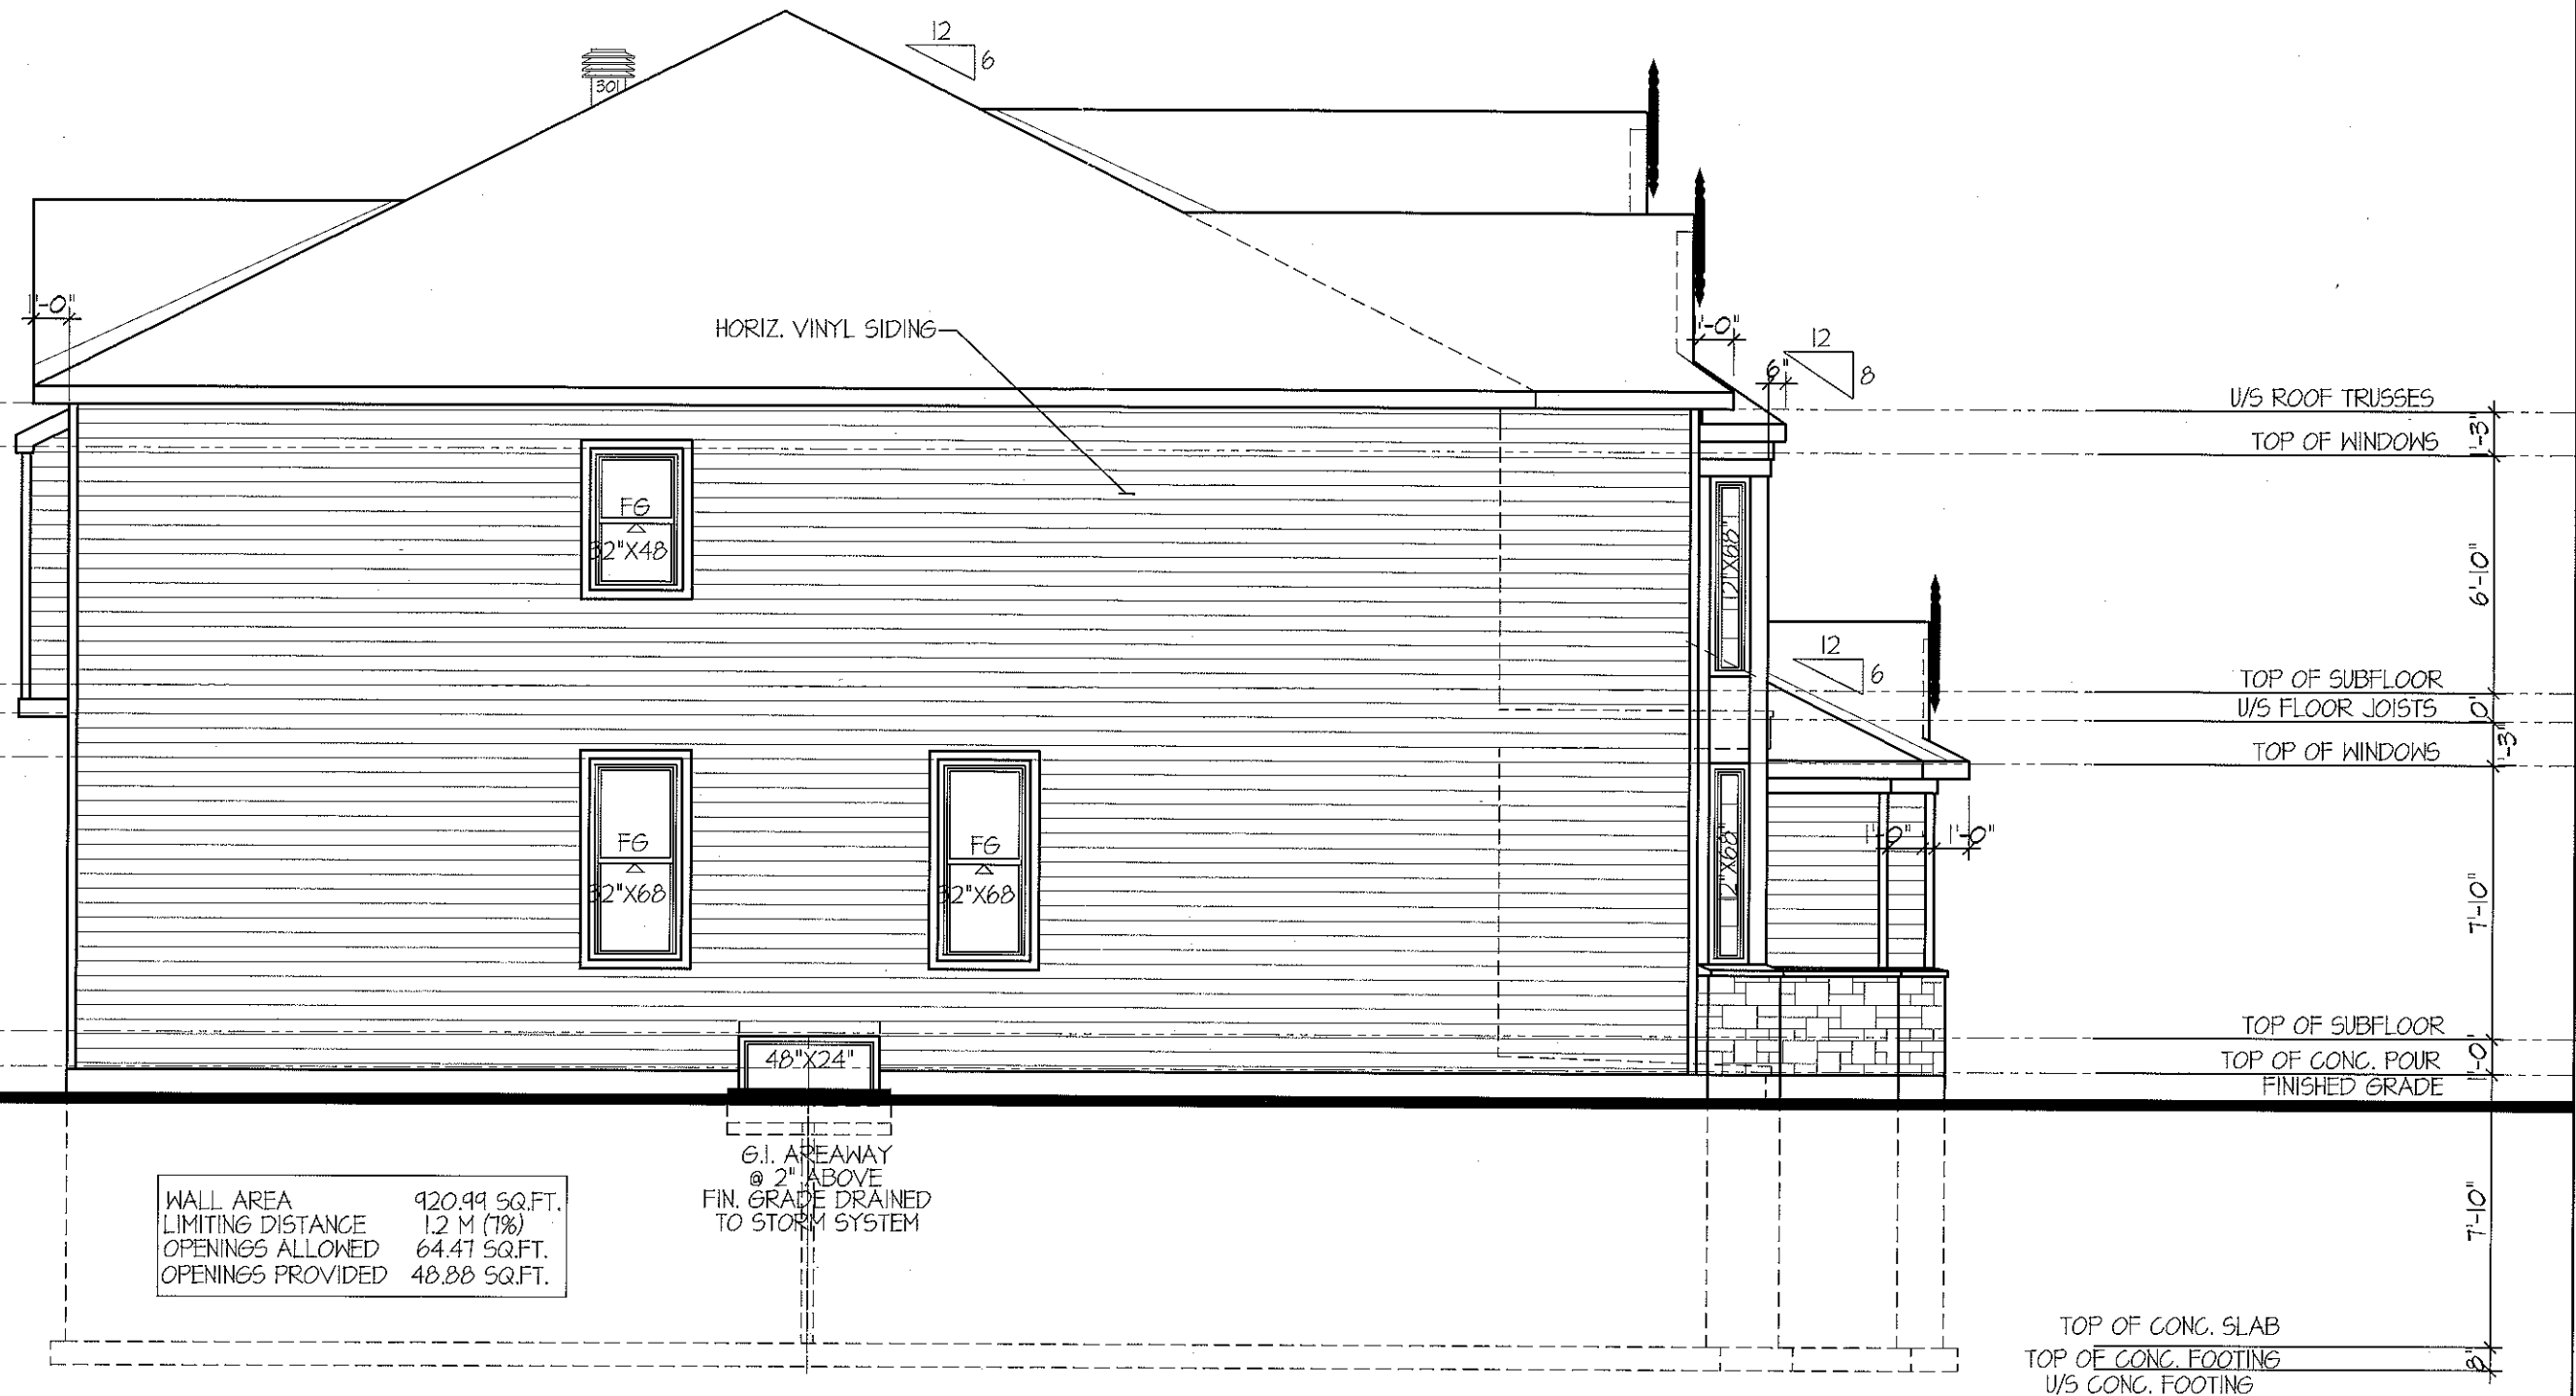

LEFT SIDE ELEVATION 'A'

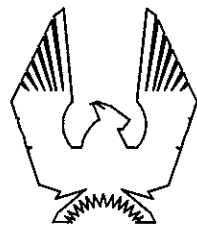

PHOENIX HOMES

CHEASAPEAKE-2007-A

SITE: SM PHASE 5

LOT NUMBER:

26

CIVIC ADDRESS:
353 BAMBURGH WAY

No.	Description	Date	By
3	REV. AS PER CONST. SUMMARY	MAY7-12	SD
2	REV. AS PER CONST. SUMMARY	APR19-12	SD
1	ISSUED FOR FOUNDATION ONLY	JAN19-12	SD
REVISIONS			

file number: 508

drawn by: A. FRANCOEUR


date: OCT. 2003

scale: 3/16"=1'


sheet no:

6A
9

 MAXI VENT #301, TWO REQ'D AT UPPER ROOF
NOTE: LOCATIONS SHOWN ARE APPROXIMATION ONLY AND
WILL BE LOCATED ON SITE BY QUALIFIED INSTALLER.

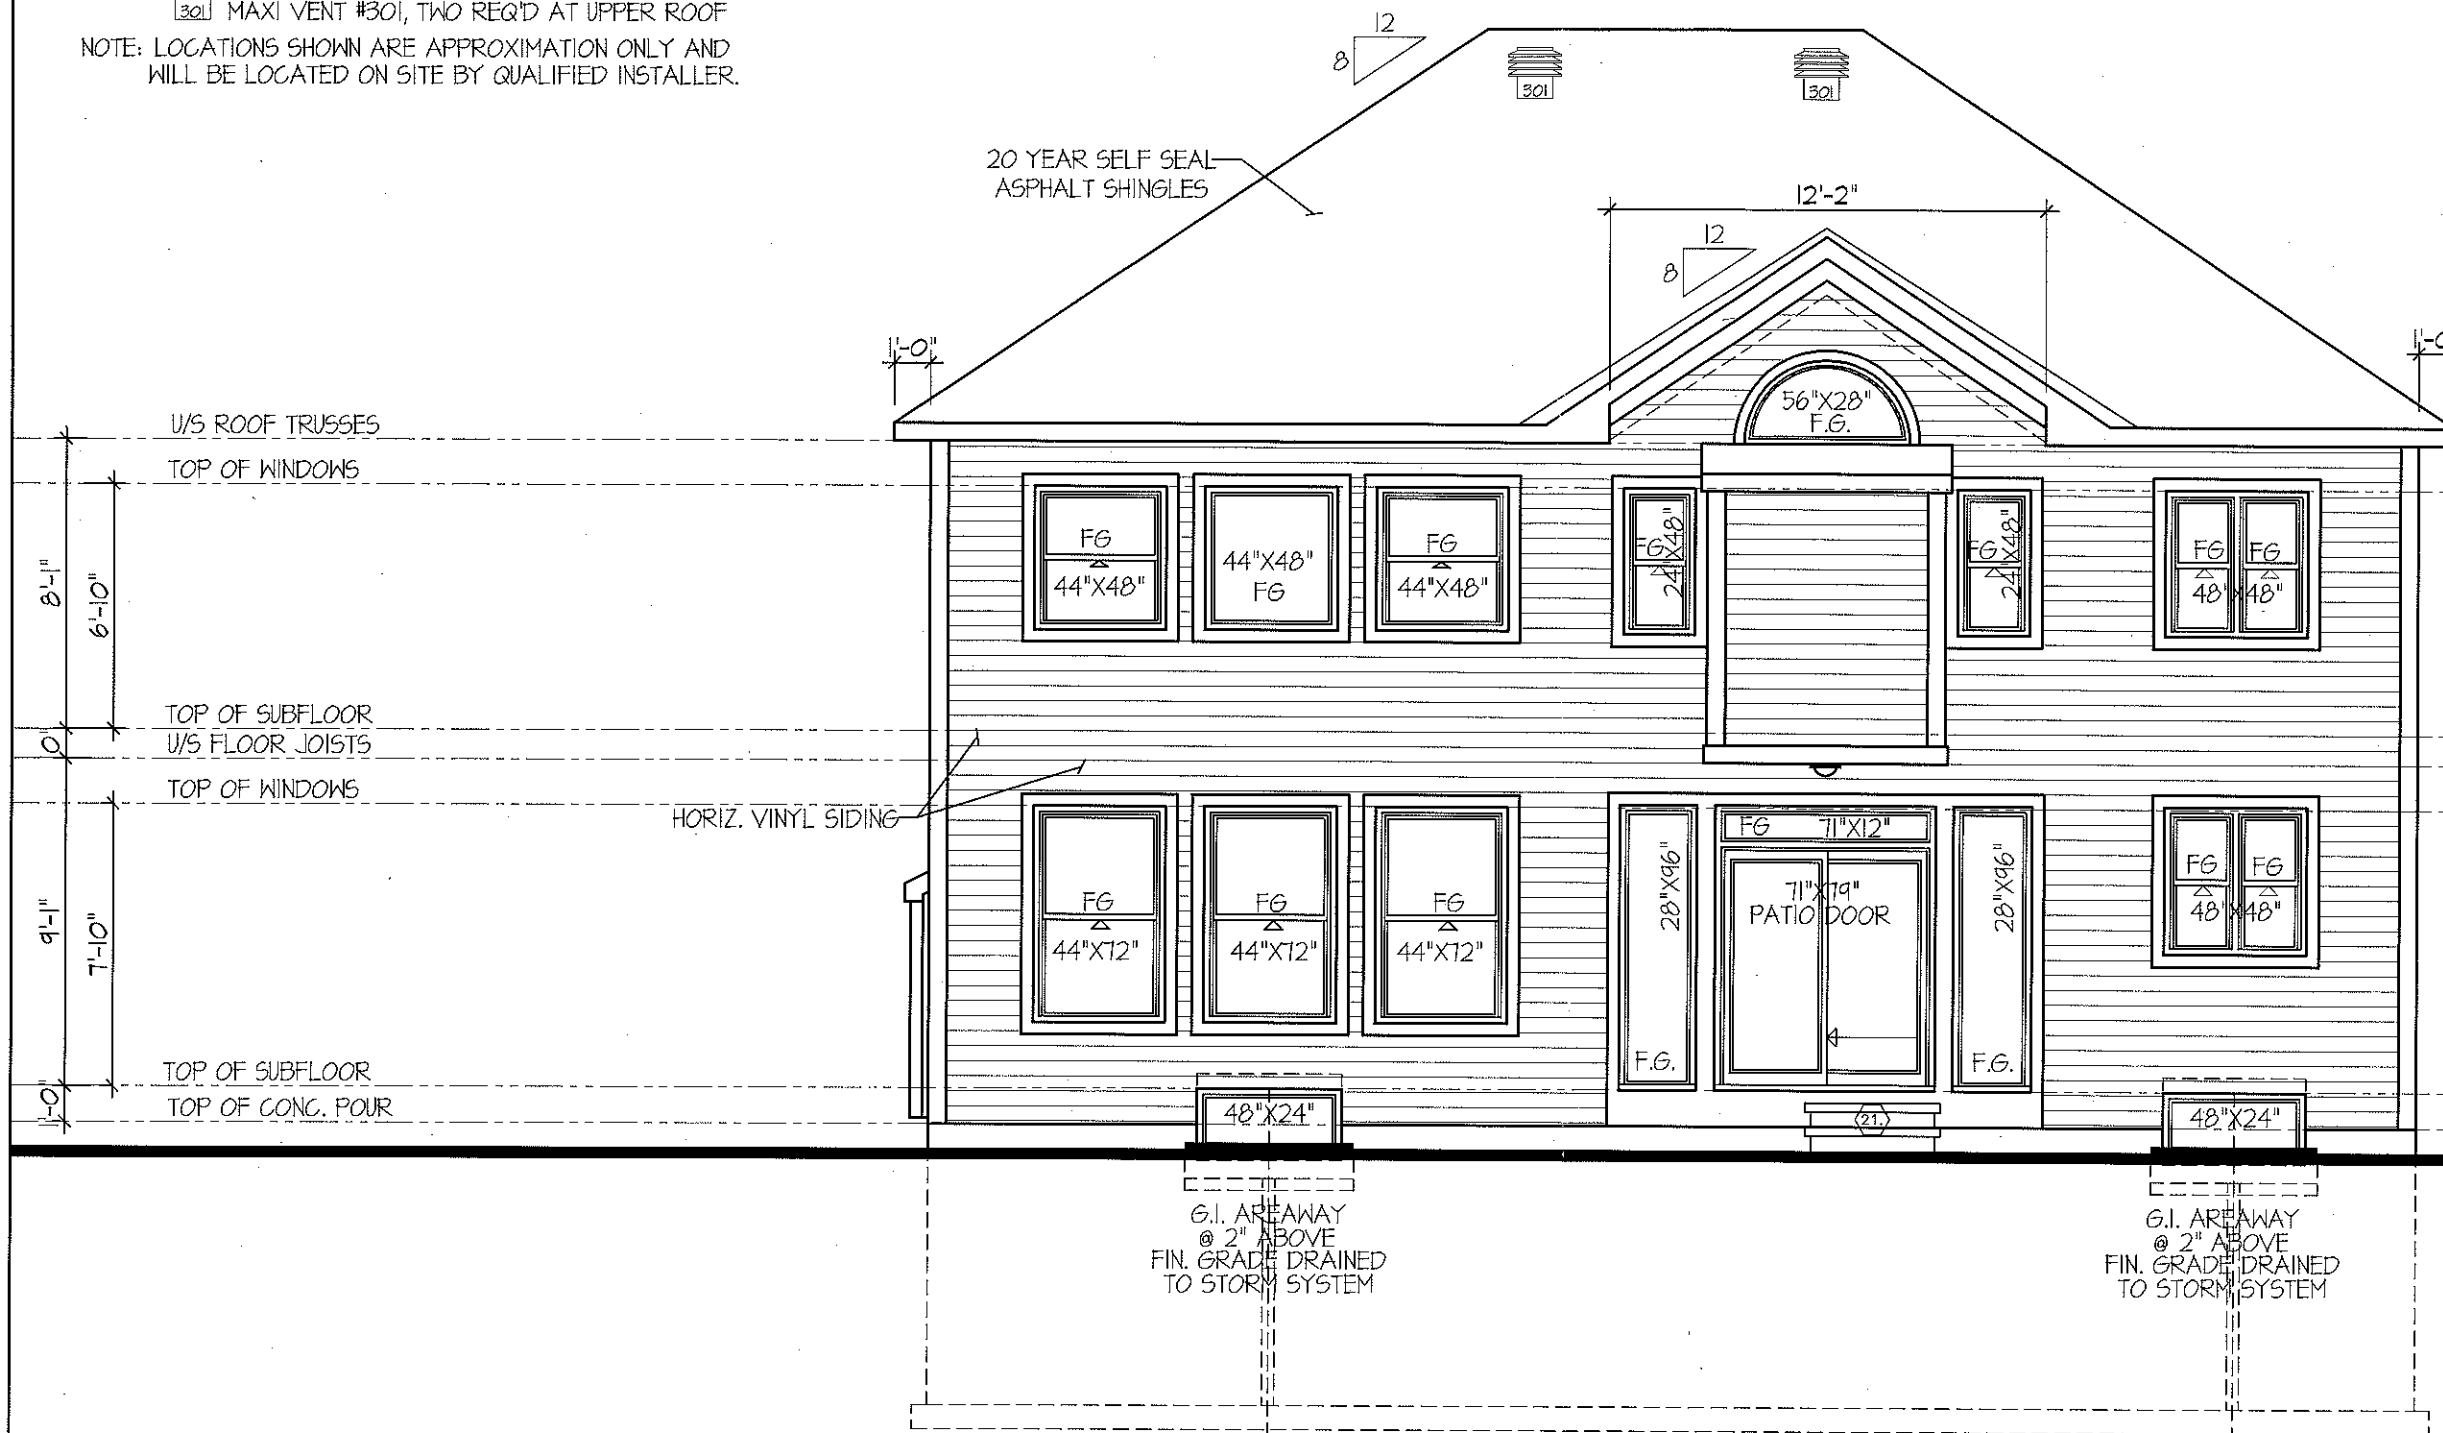

REAR ELEVATION A
(ALT. 4 BED)

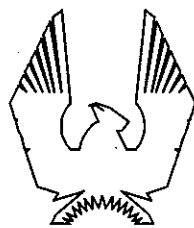

PHOENIX HOMES

CHEASAPEAKE-2007-A/B-4/5

SITE: SM PHASE 5

LOT NUMBER:

26

CIVIC ADDRESS:
353 BAMBURGH WAY

No.	Description	Date	By
3	REV. AS PER CONST. SUMMARY	MAY7-12	SD
2	REV. AS PER CONST. SUMMARY	APR19-12	SD
1	ISSUED FOR FOUNDATION ONLY	JAN19-12	SD
REVISIONS			

file number: 508

drawn by: A. FRANCOEUR


date: OCT. 2003

scale: 3/16"=1'


sheet no:

8.4/5
9


SECTION @ STAIRS (ELEV. A STD. SHOWN)

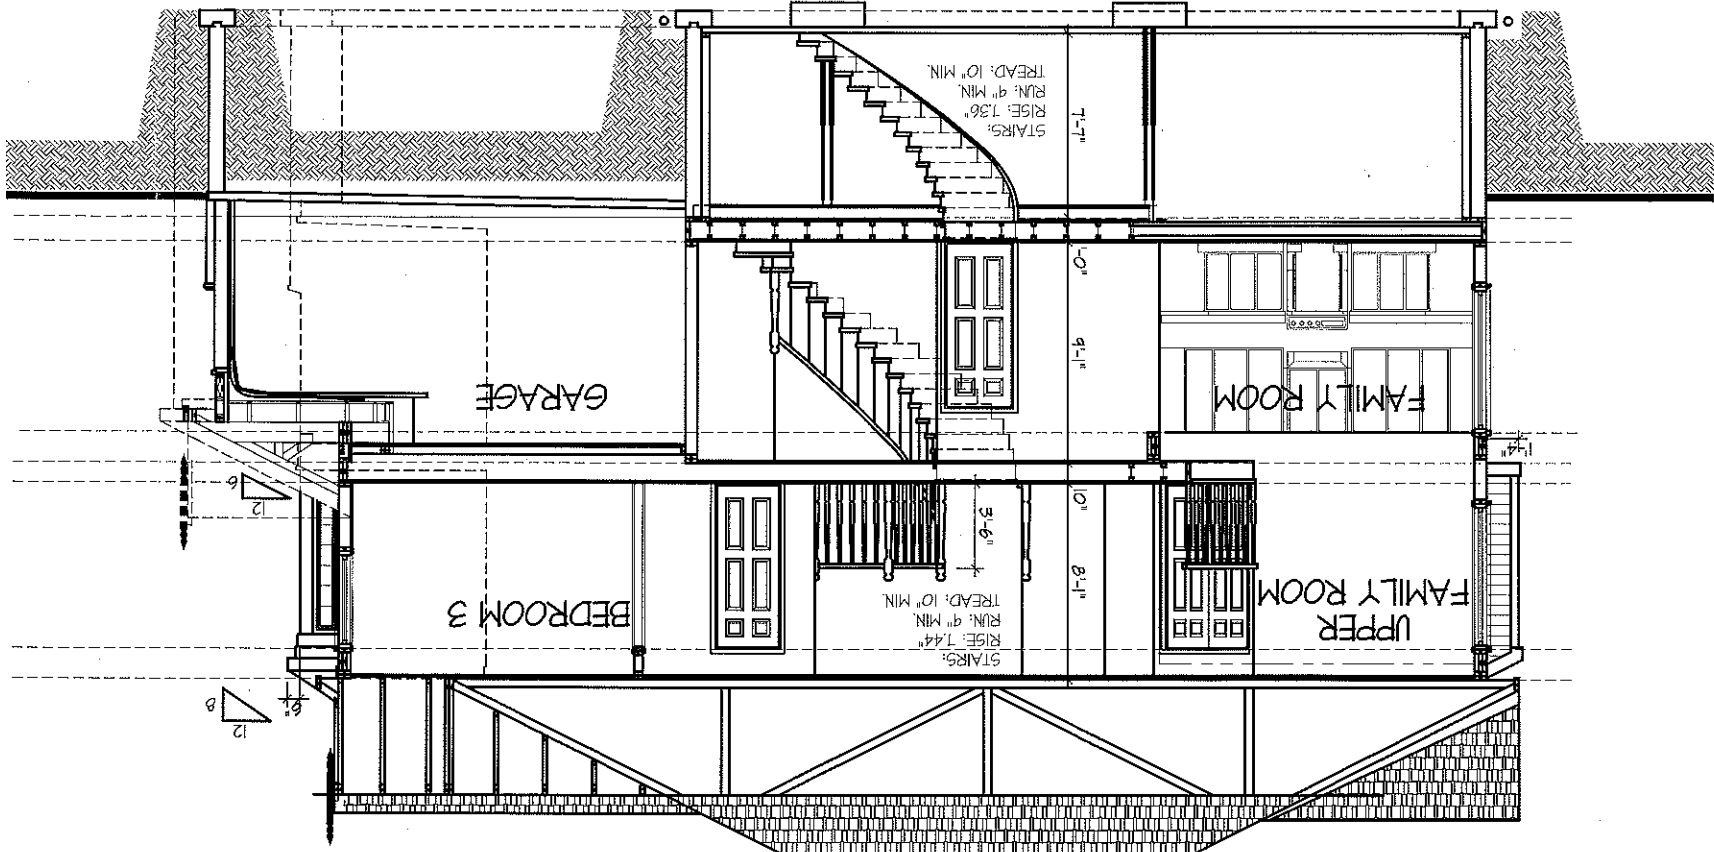

ELEVATION-1
LIVING-DINING ROOM

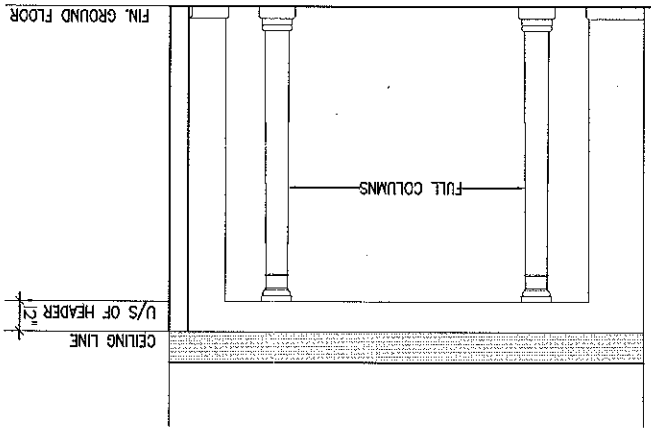


WALL SECTION @ BALCONY

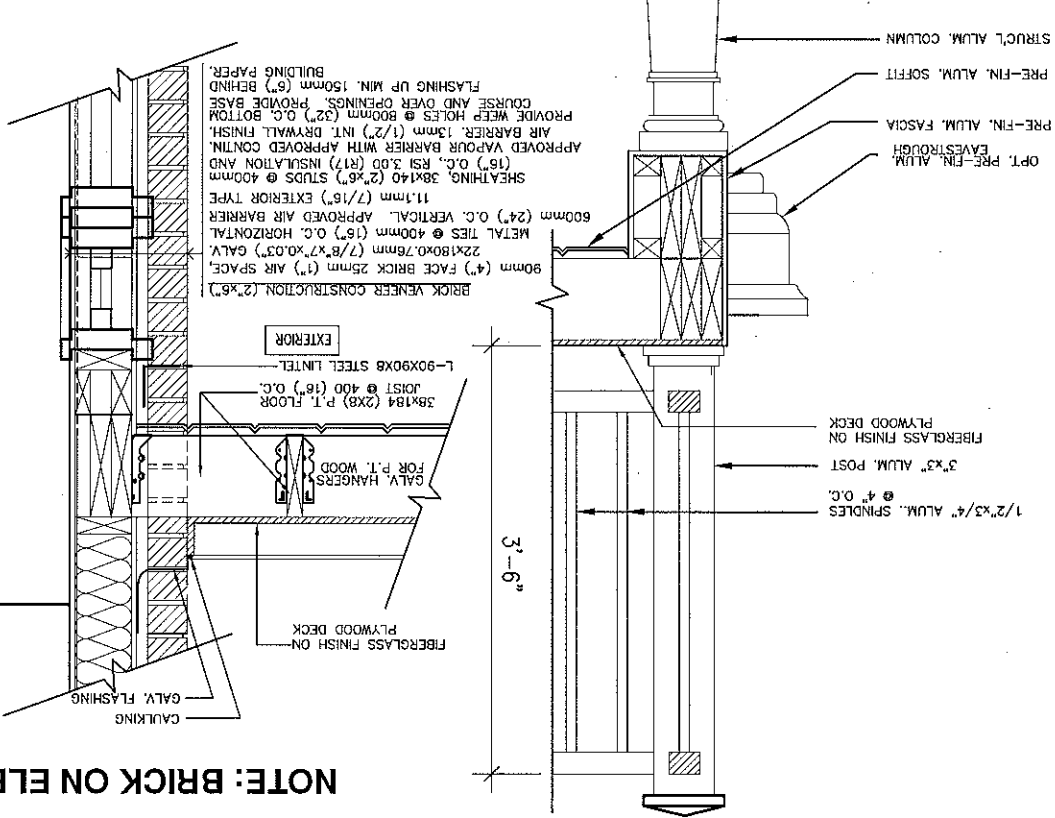

NOTE: BRICK ON ELEVATION "B" ONLY

TYPICAL WALL SECTION

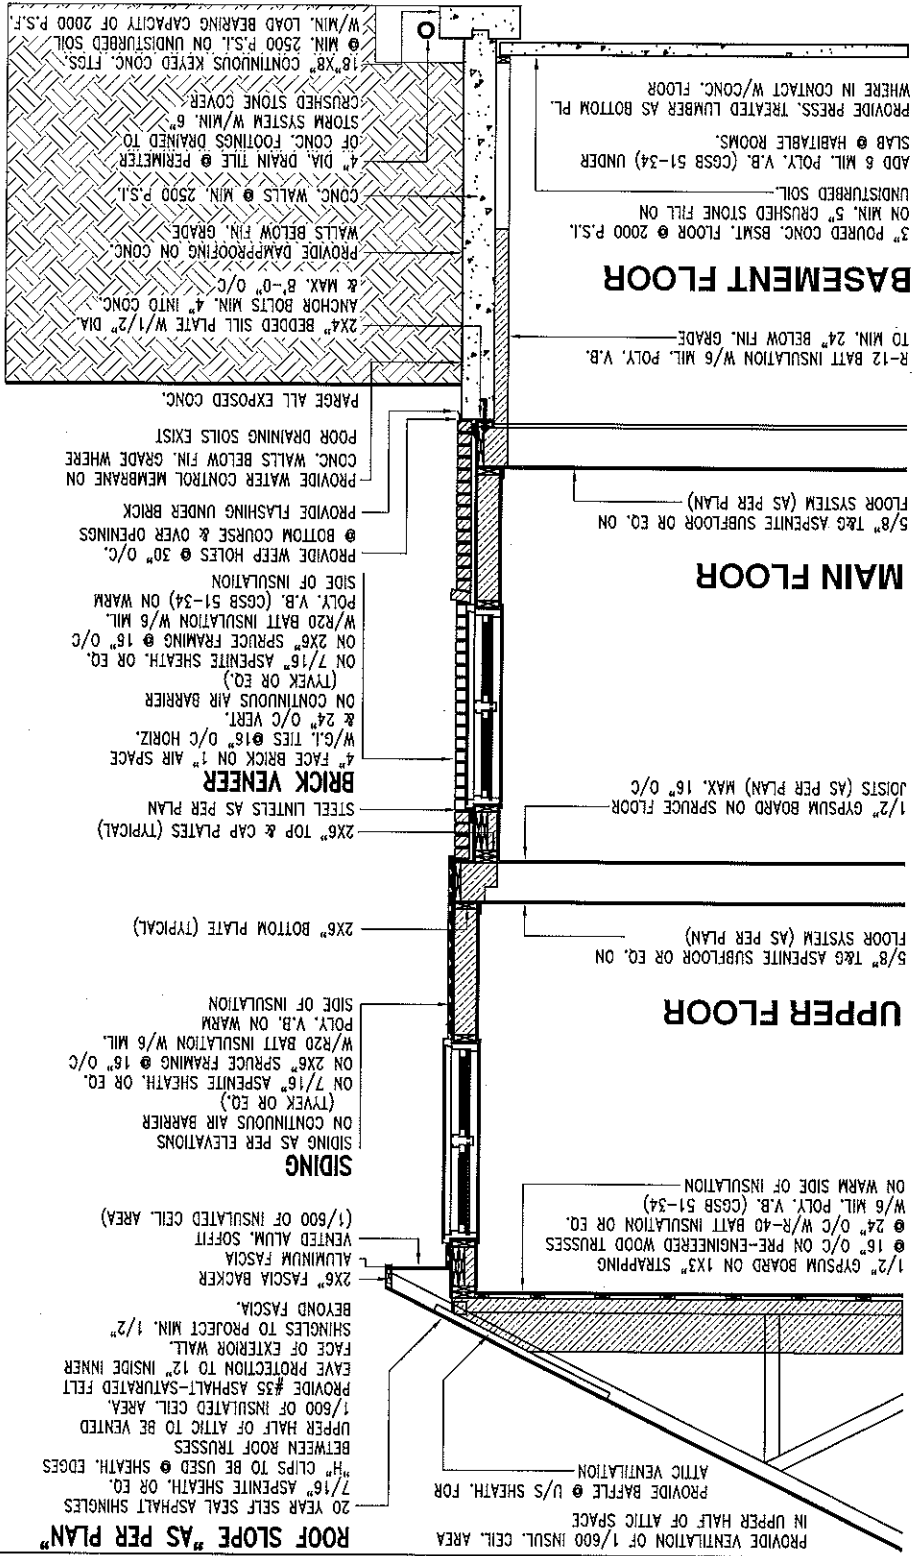

CHEASAPEAKE-2007-A/B

SITE: SM PHASE 5

LOT NUMBER:

CIVIC ADDRESS:

353 BAMBURGH WAY

26

No.	Description	By	Date
1	ISSUED FOR FOUNDATION ONLY	SD	JAN-12
2	REV. AS PER CONST. SUMMARY	SD	APR-12
3	REV. AS PER CONST. SUMMARY	SD	MAY-12

file number:	508
drawn by:	A. FRANCOEUR
date:	OCT. 2003
scale:	NTS
sheet no:	9

PHOENIX HOMES

