


STRANDHERD MEADOWS 5
LOT #29
YARMOUTH (511) - ALT 4 BDRM
KITCHEN

CUSTOMER APPROVAL

I have reviewed these drawings and understand the details of the layout and the Carrier Kitchen's specifications.

Signature [Signature]

Date 5-Oct-11

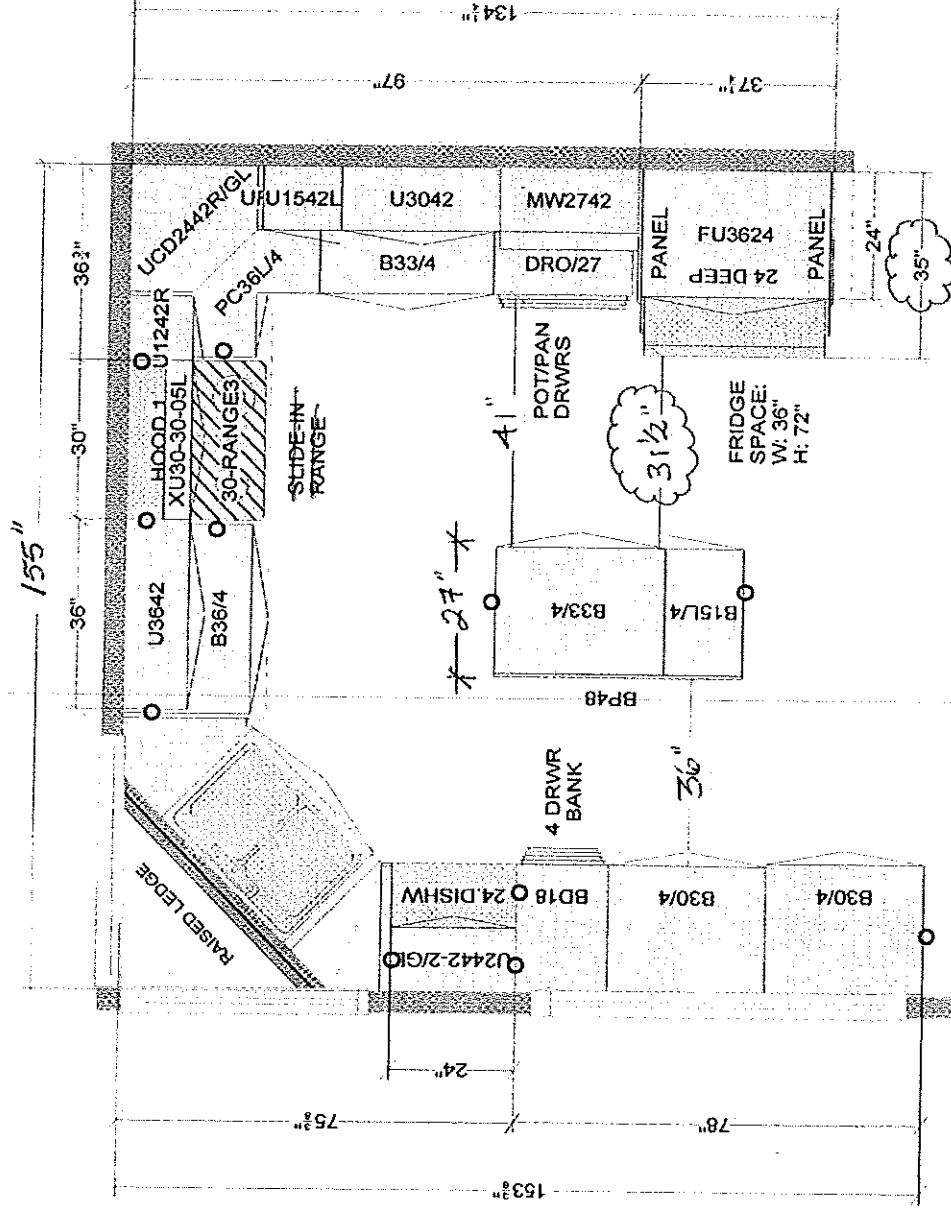

All dimensions, size designations given are subject to verification on job site and adjustment to fit job conditions.

CARTIER KITCHENS OTTAWA

PAID
10/11/1917



This is an original design and must not be released or copied unless applicable fee has been paid or job order placed.

**DRAWN BY: LD
CARTIER KITCHENS OTTAWA**

Designed: 7/7/2011
Printed: 7/7/2011

Printed: 7/7/2011

DCR #29 SMS - Kitchen

1

Drawing #: 1

3D VIEW #1 - KITCHEN

LOT #29 SMS



CUSTOMER APPROVAL

I have reviewed these drawings and understand the details of the layout and the Cartier Kitchens specifications.

Signature

Date

[Handwritten Signature]
[Handwritten Date: 5-20-11]

Note: This drawing is an artistic interpretation of the general appearance of the design. It is not meant to be an exact rendition.

DRAWN BY: Lori Di Saverio; B.I.D.
CARTIER KITCHENS OTTAWA
DCR #29 SMS - Kitchen



Designed: 7/7/2011
Printed: 7/7/2011

All

Drawing #: 1

3D VIEW #2 - KITCHEN
 LOT #29 SM5



CUSTOMER APPROVAL

I have reviewed these drawings and understand the details of the layout and the Cartier Kitchens specifications.

Signature [Signature]

Date 5-OCT-11

Note: This drawing is an artistic interpretation of the general appearance of the design. It is not meant to be an exact rendition.

DRAWN BY: Lori Di Saverio, B.I.D.
 CARTIER KITCHENS OTTAWA
 DCR #29 SM5 - Kitchen




Designed: 7/7/2011
 Printed: 7/7/2011

All Drawing #: 1

3D View #3 - LOT #29 SM5

KITCHEN

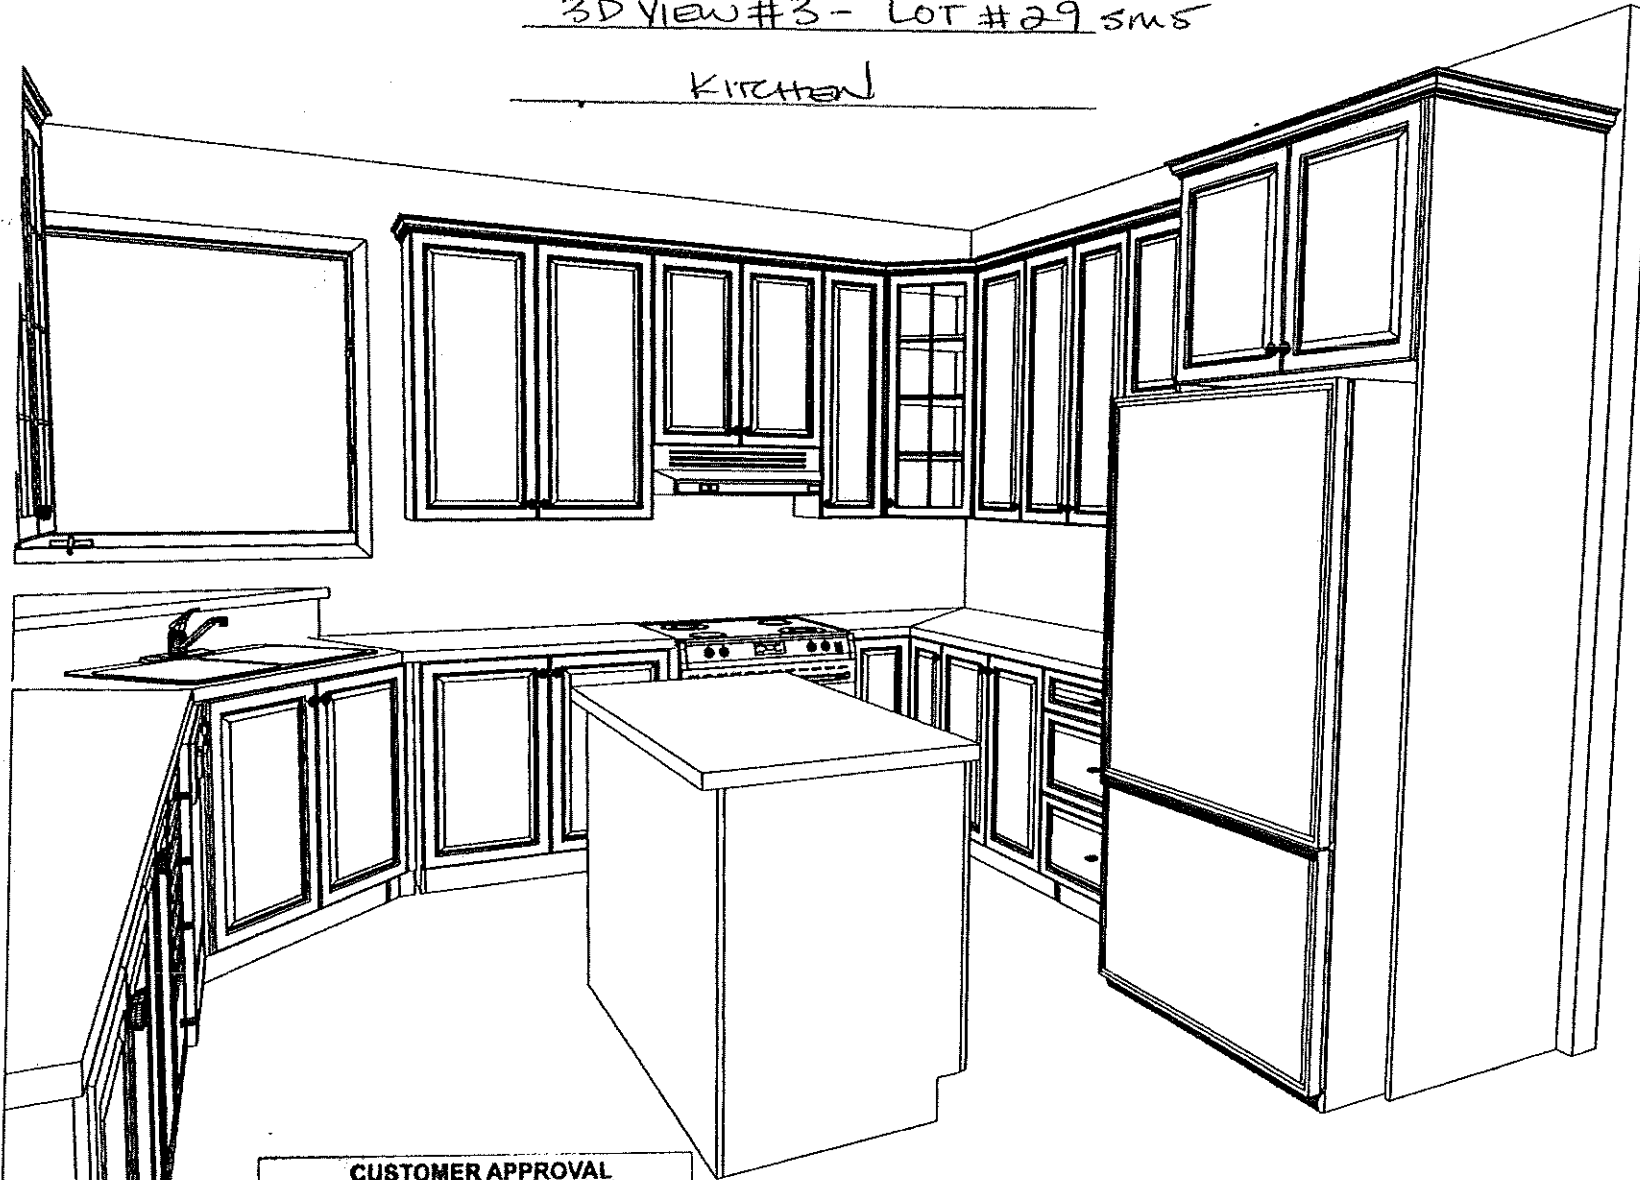

CUSTOMER APPROVAL

I have reviewed these drawings and understand the details of the layout and the Cartier Kitchens specifications.

Signature

Date

[Signature]
5-Oct-11

Note: This drawing is an artistic interpretation of the general appearance of the design. It is not meant to be an exact rendition.


DRAWN BY: Lori Di Saverio, B.I.D.
CARTIER KITCHENS OTTAWA
DCR #29 SM5 - Kitchen



Designed: 7/7/2011
Printed: 7/7/2011

All

Drawing #: 1

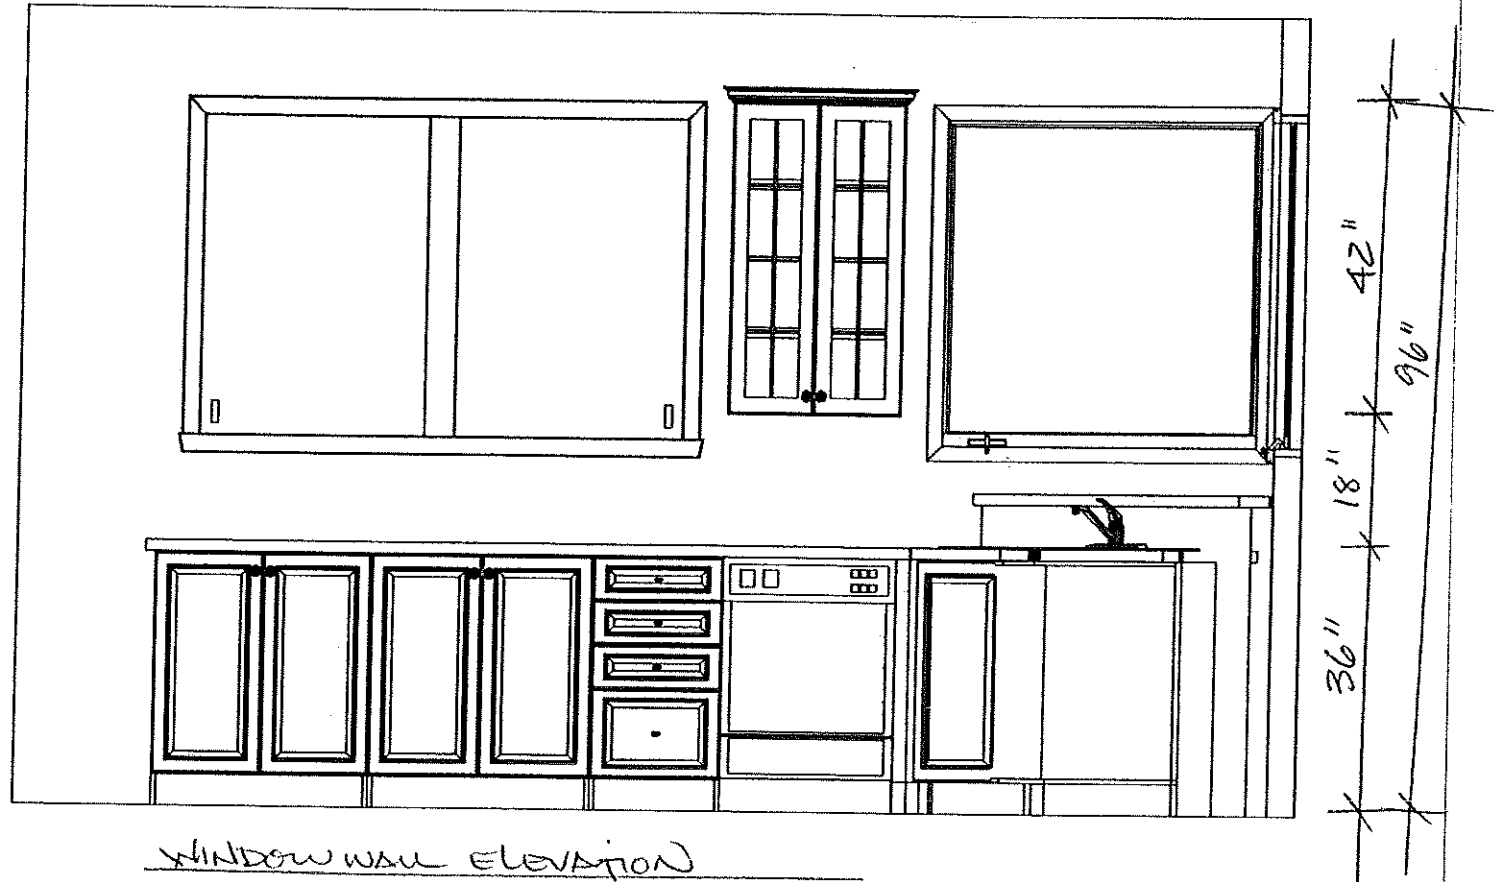

CUSTOMER APPROVAL	
I have reviewed these drawings and understand the details of the layout and the Cartier Kitchens specifications.	
Signature	<i>[Signature]</i>
Date	5-04-11

Note: This drawing is an artistic interpretation of the general appearance of the design. It is not meant to be an exact rendition.

DRAWN BY: Lori Di Saverio, B.I.D.
CARTIER KITCHENS OTTAWA
DCR #29 SM5 - Kitchen



Designed: 7/7/2011
Printed: 7/7/2011

All

Drawing #: 1



2"
 42"
 18"
 36"
 96"

STOVE WALL ELEVATION

CUSTOMER APPROVAL

I have reviewed these drawings and understand the details of the layout and the Cartier Kitchens specifications.

Signature

Date

5-OCT-11

Note: This drawing is an artistic interpretation of the general appearance of the design. It is not meant to be an exact rendition.

DRAWN BY: Lori Di Saverio, B.I.D.
 CARTIER KITCHENS OTTAWA


DCR #29 SM5 - Kitchen



Designed: 7/7/2011
 Printed: 7/7/2011

All

Drawing #: 1

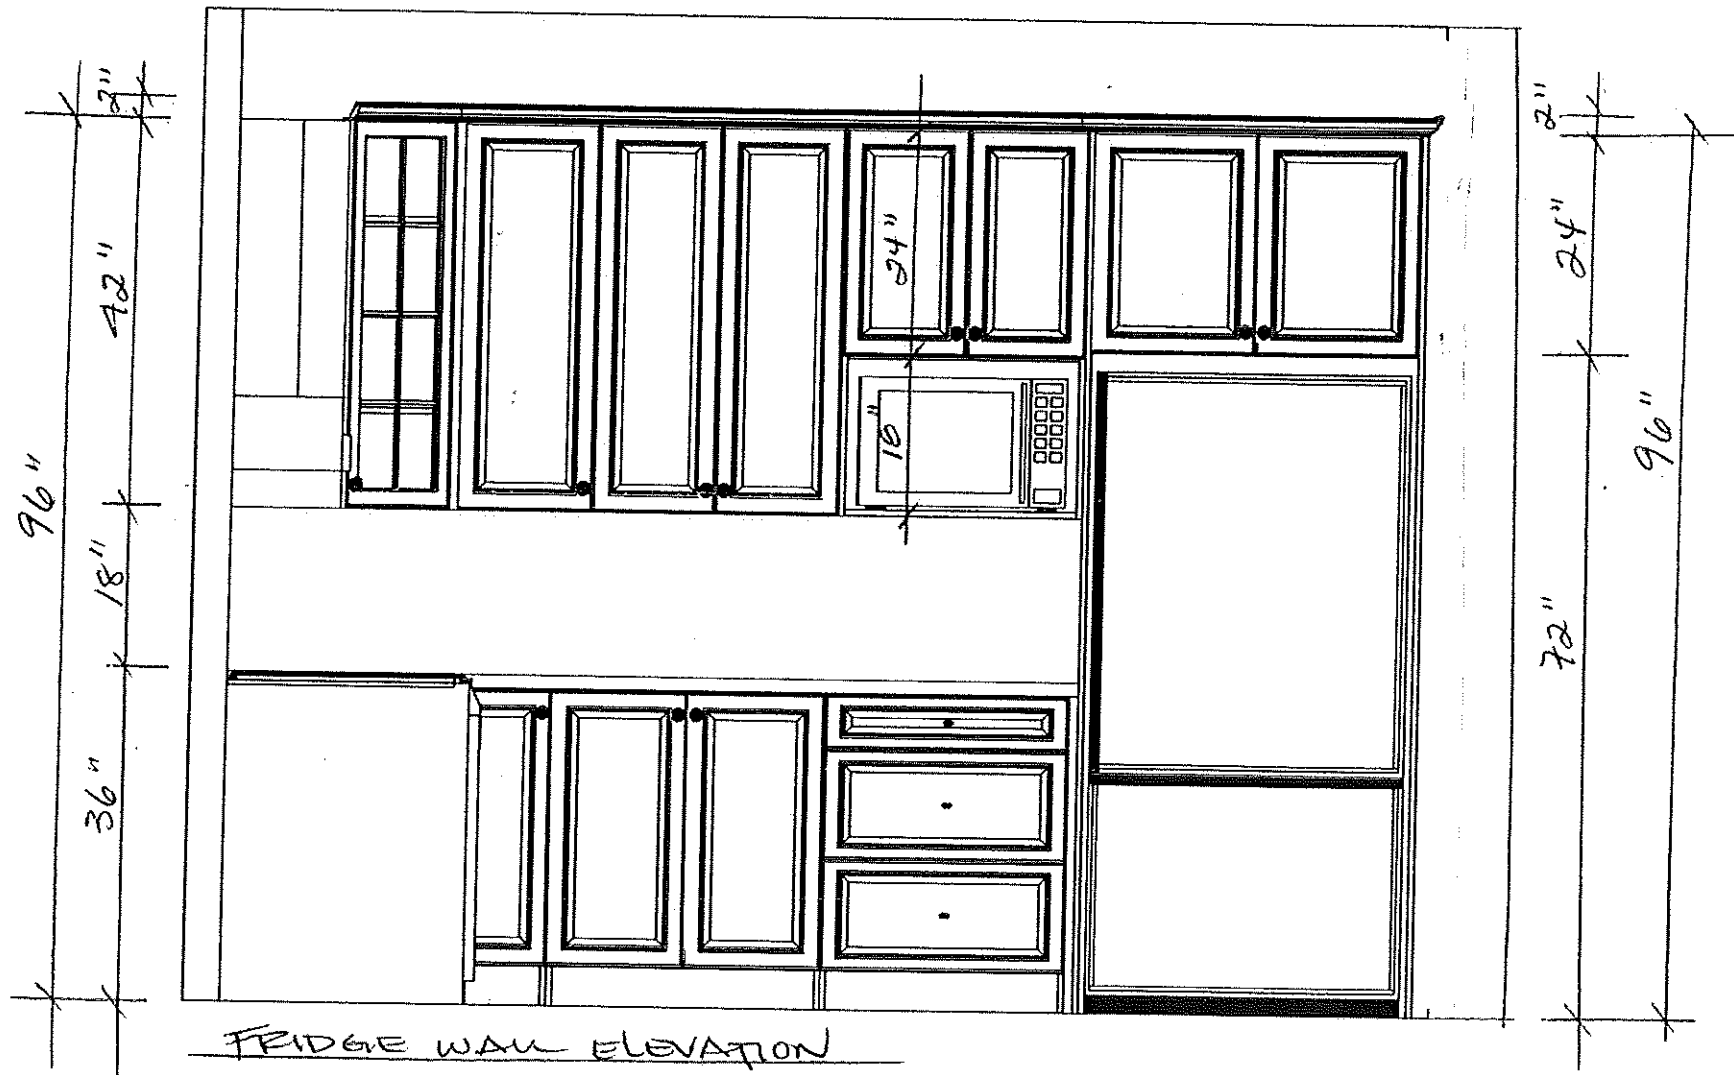

FRIDGE WALL ELEVATION

CUSTOMER APPROVAL

I have reviewed these drawings and understand the details of the layout and the Cartier Kitchens specifications.

Signature

Date

Note: This drawing is an artistic interpretation of the general appearance of the design. It is not meant to be an exact rendition..

DRAWN BY: Lori Di Saverio, B.I.D.
CARTIER KITCHENS OTTAWA
DCR #29 SM5 - Kitchen



Designed: 7/7/2011
Printed: 7/7/2011

All

Drawing #: 1

LOT 29 SMS.

ANCONA
RAPIDO CHEF 30

