

DCR PHOENIX HOMES

STRANDHERD MEADOWS 5

LOT #31

MODEL - YARMOUTH (511)

KITCHEN

CABINET SERIES:
STYLE COLOUR:

KICK: 4-PCS.

HW:


STD WHITE INTERIORS

METAL DRAWER BOXES

2 - PCS. 90 DEG. CORNER MOULD.

STAGGERED MOUNTING HEIGHT - 93" / 96"

* 2" CROWN
* RECESSED VAINUE

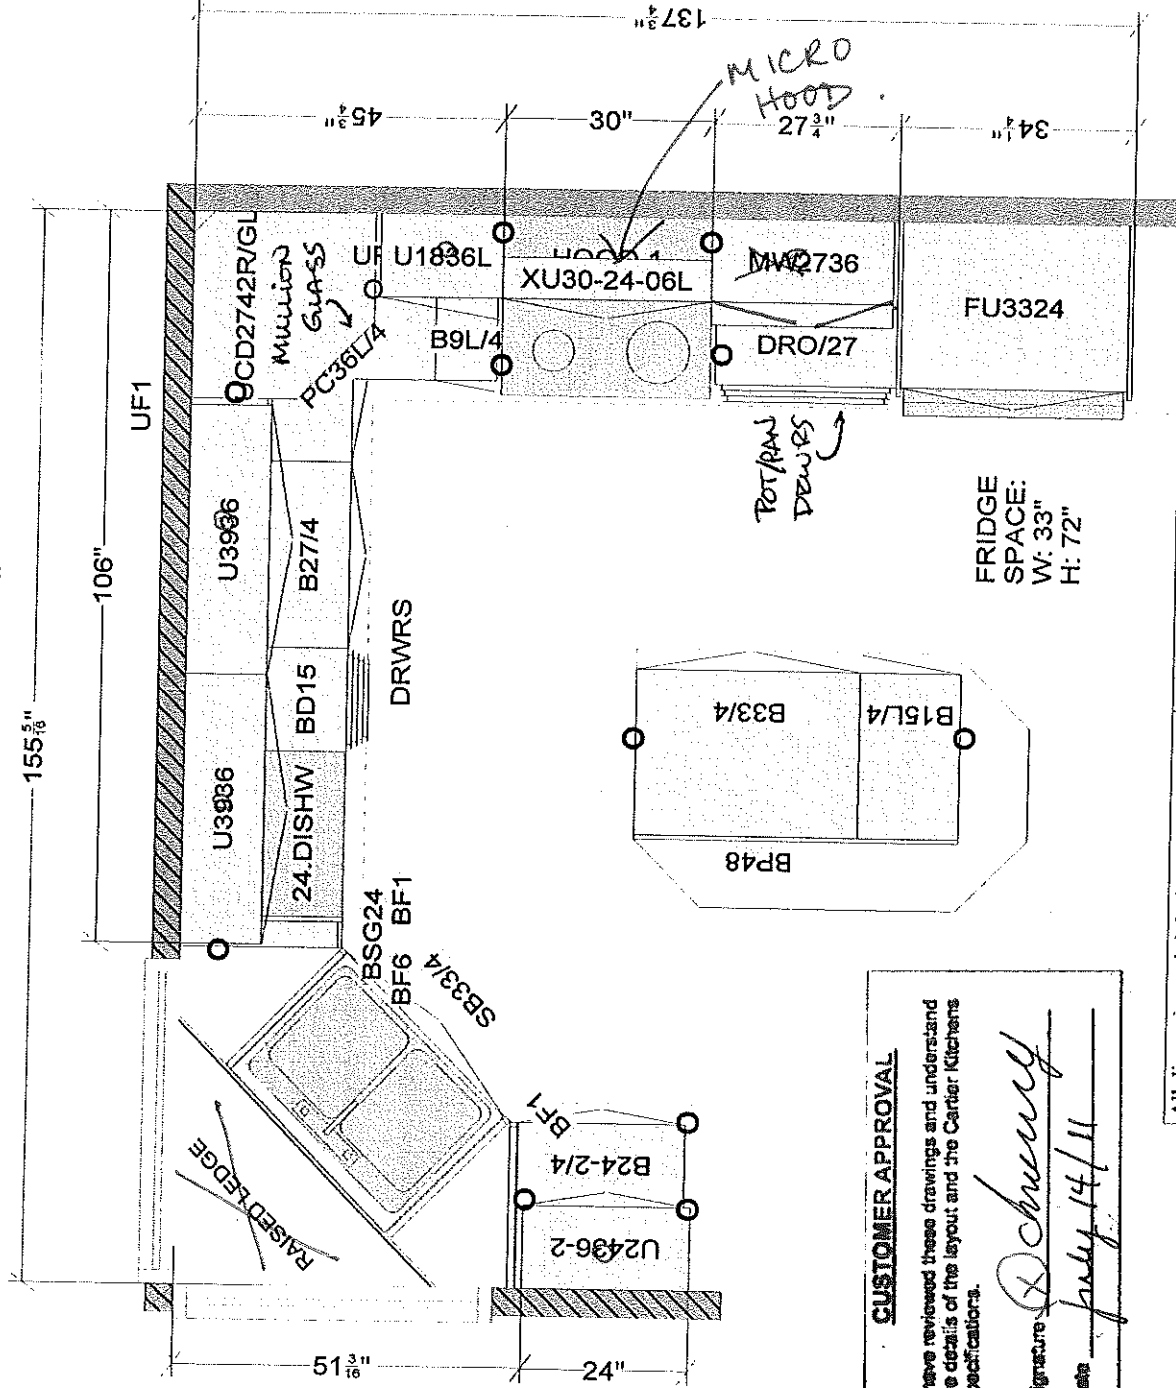

CUSTOMER APPROVAL

I have reviewed these drawings and understand the details of the layout and the Cartier Kitchens specifications.

Signature *[Signature]*

Date *July 14/11*

All dimensions, size designations given are subject to verification on job site and adjustment to fit job conditions.

CARTIER KITCHENS OTTAWA



This is an original design and must not be released or copied unless applicable fee has been paid or job order placed.

DRAWN BY: LD
CARTIER KITCHENS OTTAWA

Designed: 5/30/2011
Printed: 6/16/2011

DCR - 31 STRANDHERD MEADOWS - KITCHEN

All


Drawing #: 1

Drawing #: 1	
DESIGNED: 5/30/2011 PRINTED: 6/16/2011	 Note: This drawing is an artistic interpretation of the general appearance of the design. It is not meant to be an exact rendition. DRAWN BY: Lori Di Saverio, B.I.D. CARTIER KITCHENS OTTAWA DCR - 31 STRANDHERD MEADOWS -

CUSTOMER APPROVAL

I have reviewed these drawings and understand the details of the layout and the Cartier Kitchens specifications.

Signature: *[Signature]*
 Date: July 14/11

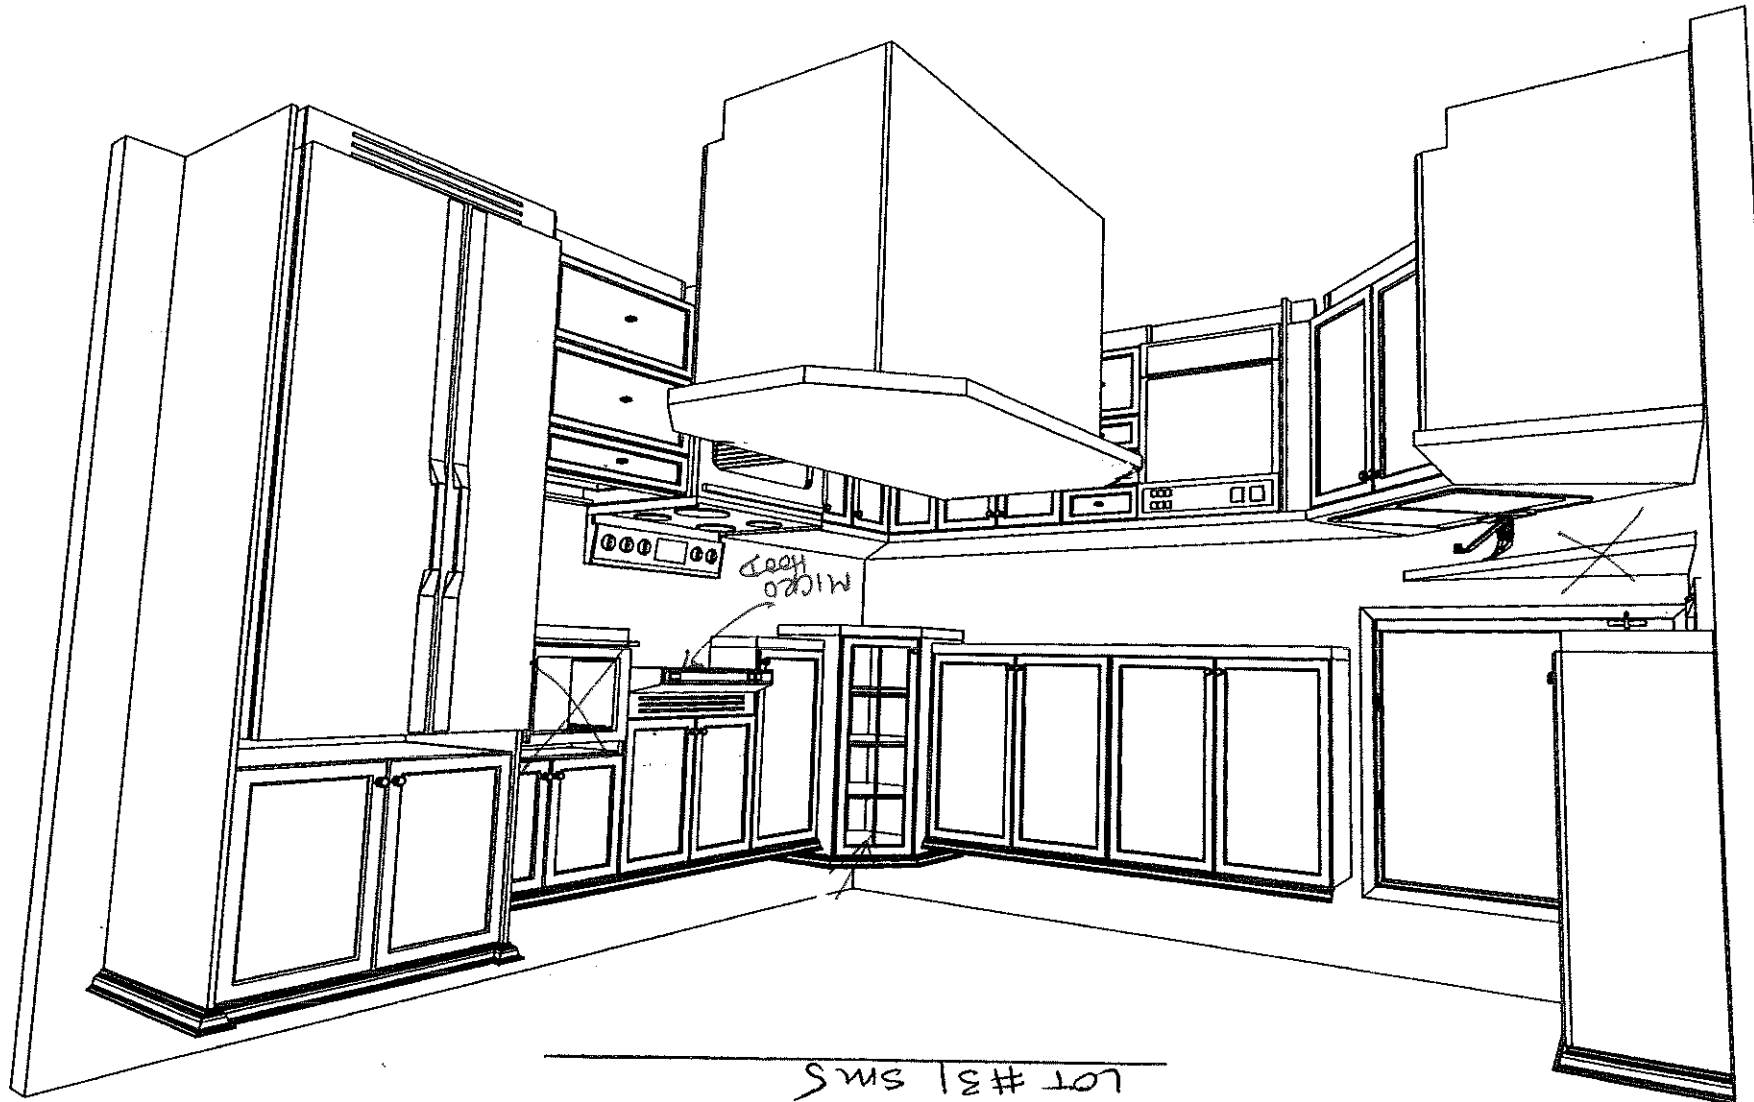


3D View #1 -
 LOT #31 SMS

CUSTOMER APPROVAL

I have reviewed these drawings and understand the details of the layout and the Carrier Kitchens specifications.

Signature: *[Signature]*
 Date: July 14/11

3D View #2
 Lot #31-SMS

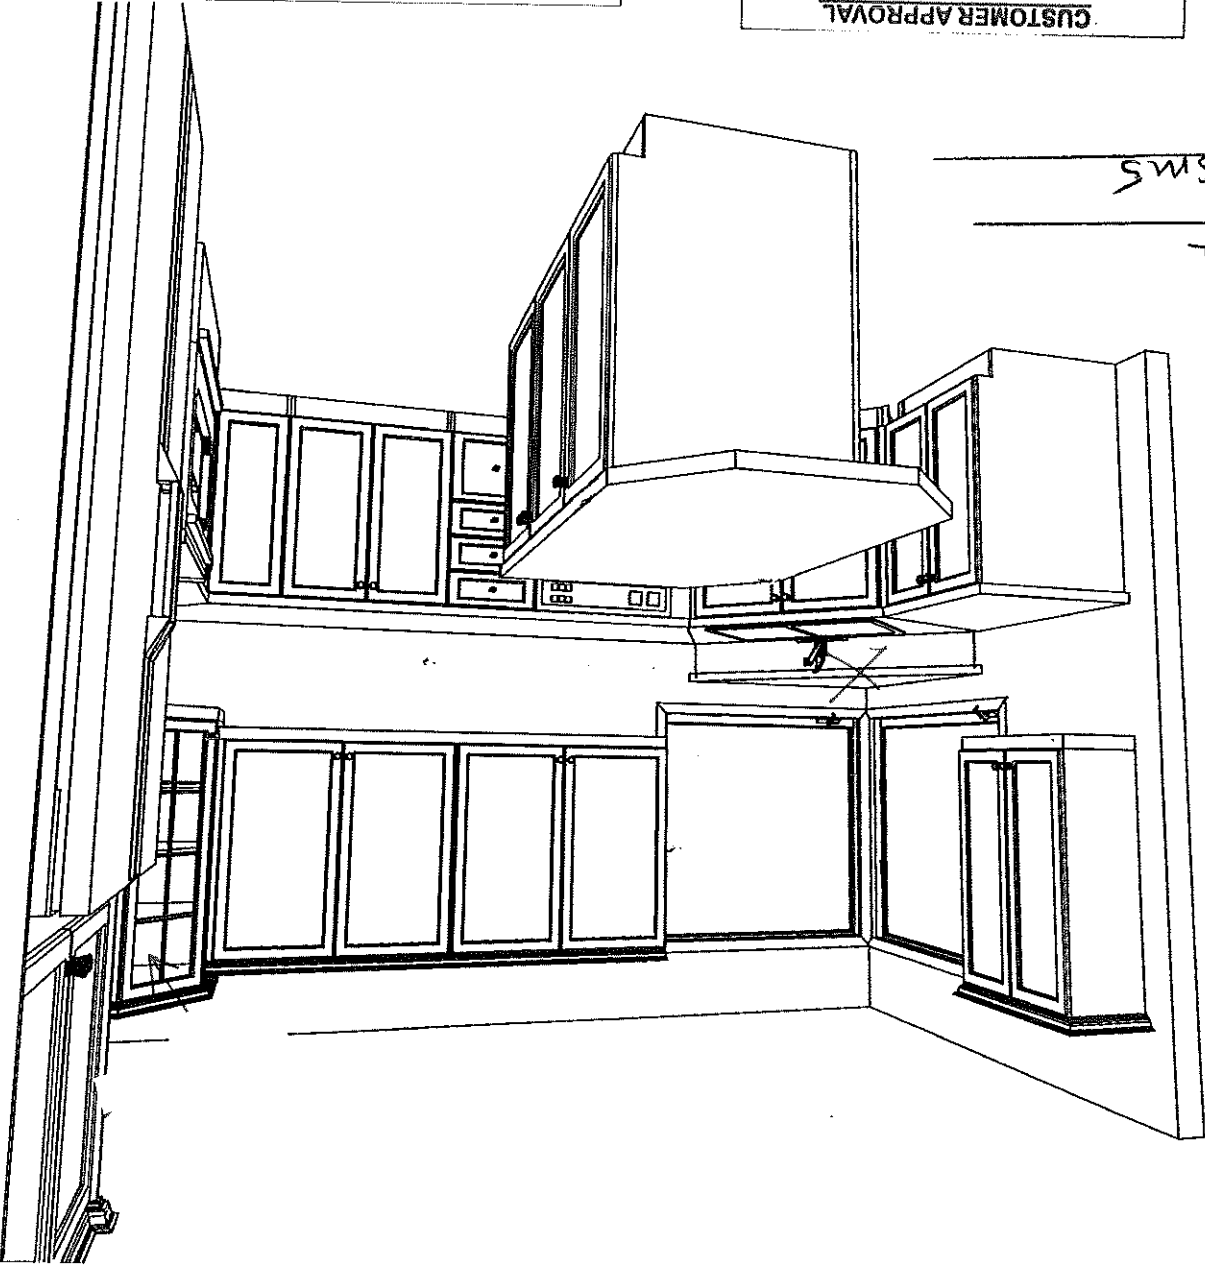

Note: This drawing is an artistic interpretation of the general appearance of the design. It is not meant to be an exact rendition.

DRAWN BY: Lori Di Saverio, B.I.D.
 CARRIER KITCHENS OTTAWA

DCR - 31 STRANDHERD MEADOWS -



Designed: 5/30/2011
 Printed: 6/16/2011
 Drawing #: 1

CUSTOMER APPROVAL

I have reviewed these drawings and understand the details of the layout and the Cartier Kitchens specifications.

Signature: *[Signature]*
 Date: July 14/11

Note: This drawing is an artistic interpretation of the general appearance of the design. It is not meant to be an exact rendition.

DRAWN BY: Lori Di Saverio, B.I.D.
 CARTIER KITCHENS OTTAWA

DCR - 31 STRANDHERD MEADOWS -

2020
 TECHNOLOGIES

Cartier
 KITCHENS

Designed: 5/30/2011
 Printed: 6/16/2011

Drawing #: 1



CUSTOMER APPROVAL

I have reviewed these drawings and understand the details of the layout and the Carlier Kitchens specifications.

Signature: *[Signature]*
 Date: July 14/11

DCR - 31 STRANDHERD MEADOWS -
 DRAWN BY: Lori Di Saverio, B.I.D.
 CARTIER KITCHENS OTTAWA

Note: This drawing is an artistic interpretation of the general appearance of the design. It is not meant to be an exact rendition.


DESIGNED BY: Lori Di Saverio, B.I.D.
 PRINTED BY: Lori Di Saverio, B.I.D.

2020 TECHNOLOGIES

DESIGNED: 5/30/2011
 PRINTED: 6/16/2011

Drawing #: 1

SIDE WALL ELEVATION 2 - LOT # 31-SMS

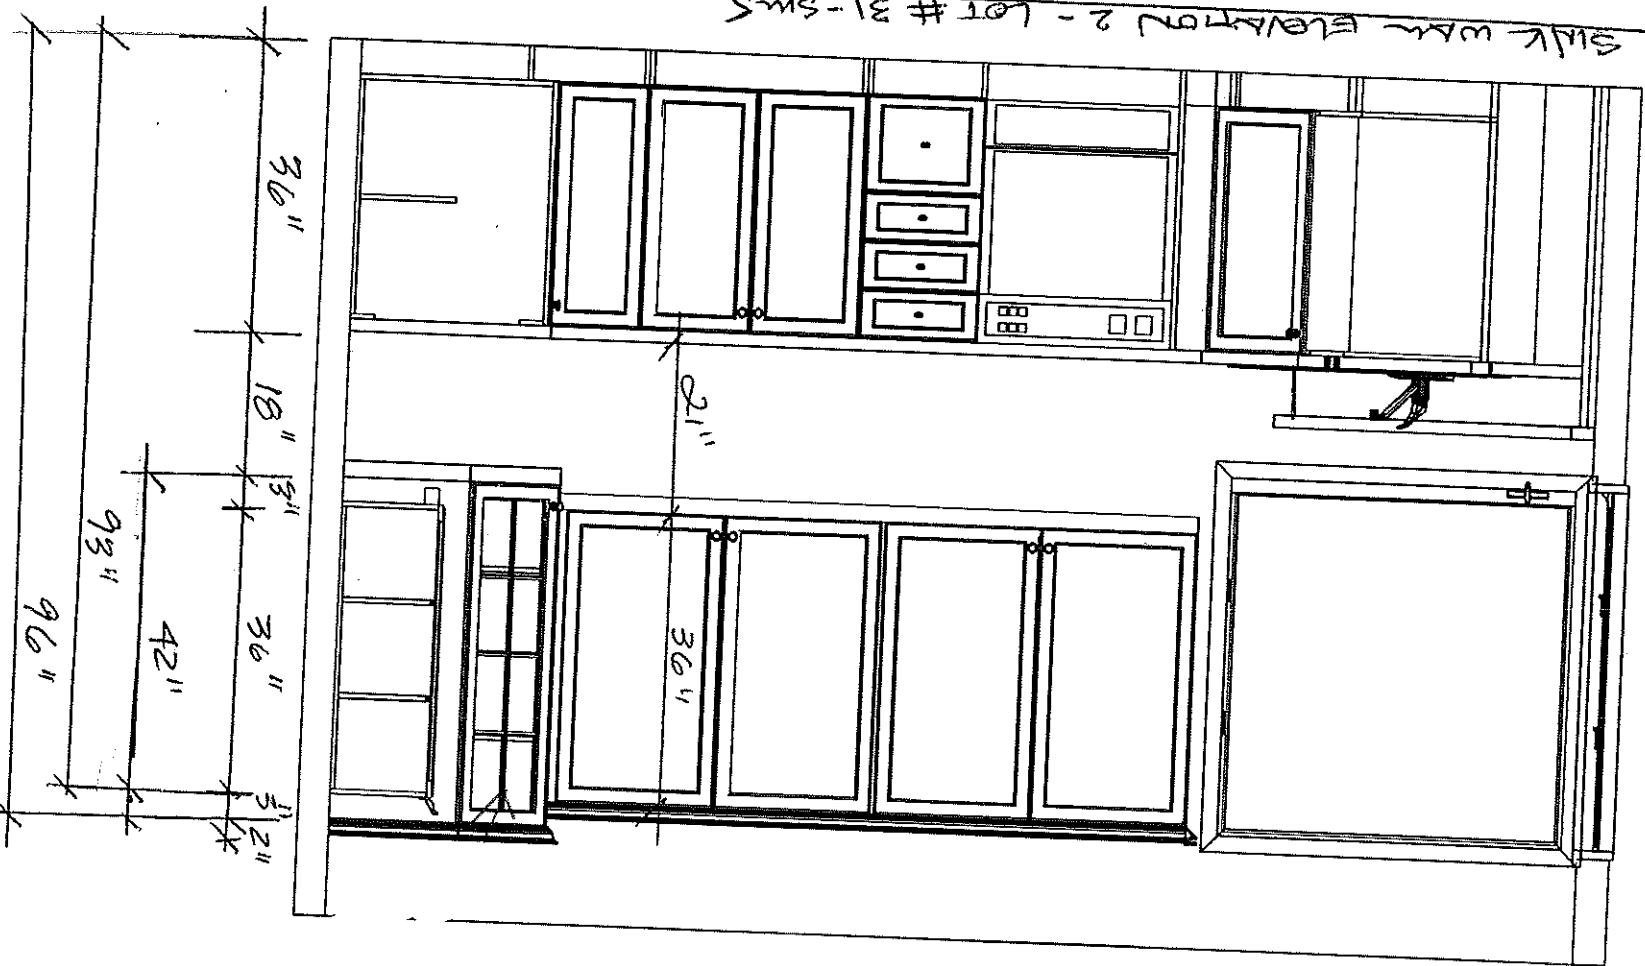

CUSTOMER APPROVAL

I have reviewed these drawings and understand the details of the layout and the Cartier Kitchens specifications.

Signature: *[Signature]*
 Date: July 14/11

DCR - 31 STRANDHERD MEADOWS -
 DRAWN BY: Lori Di Saverio, B.I.D.
 CARTIER KITCHENS OTTAWA

Note: This drawing is an artistic interpretation of the general appearance of the design. It is not meant to be an exact rendition.



Designed: 5/30/2011
 Printed: 6/16/2011
 Drawing #: 1

SIDE WALL ELEVATION - LOT # 31 S.M.S

