

DCR PHOENIX HOMES

YARMOUTH (511)
LOT #41
STRANDHERD MEADOWS 5
KITCHEN

REVISED: JUNE 4, 2011

CUSTOMER APPROVAL


I have reviewed these drawings and understand the details of the layout and the Cartier Kitchens specifications.

Signature [Signature] J.O.
Date July 26/11

LINE - 3
DOOR STYLE - BELAIR UPPEERS
- MALIBU LOWERS
SPECIES - MAPLE
COLOUR - HAZLENUT
HW - TBC
STD WHITE INTERIORS
METAL DRAWER BOXES
2 - PCS. 90 DEG. CORNER MOULD.
3 PCS - KICK
RECESSED LT VALANCE
2" CROWN MOULDING - VENEER

STAGGERED
MOUNTING HT: 87" / 93" / 99"

MULLION!
GLASS INSERT
MATCHING
INTERIOR

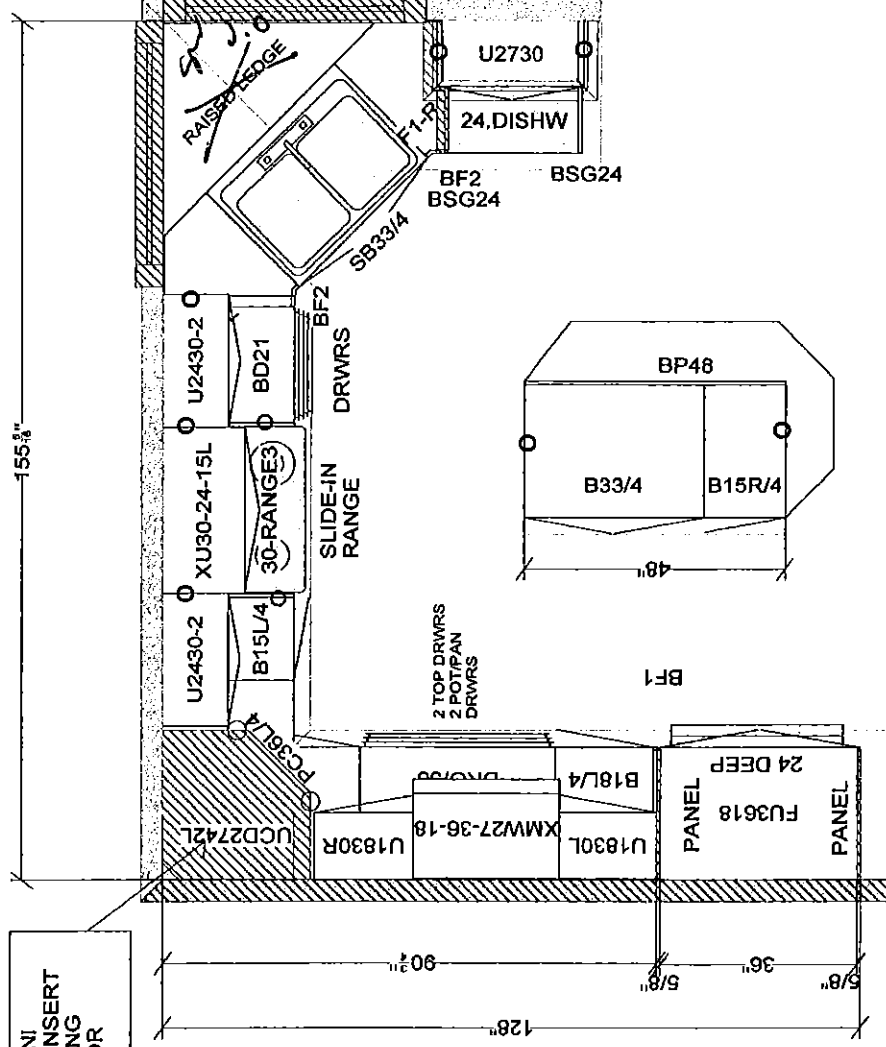

All dimensions, size designations given are subject to verification on job site and adjustment to fit job conditions.

CARTIER KITCHENS OTTAWA



20 years
TECHNOLOGIES

This is an original design and must not be released or copied unless applicable fee has been paid or job order placed.

DRAWN BY: LD
CARTIER KITCHENS OTTAWA

Designed: 5/8/2011
Printed: 6/4/2011

DCR #41 SM 5 - Yarmouth (511)

All

Drawing # 1



3D View #2 - Rev. June 4/11

CUSTOMER APPROVAL

I have reviewed these drawings and understand the details of the layout and the Cartier Kitchens specifications.

Signature

(Signature)

Date

July 26/11

Note: This drawing is an artistic interpretation of the general appearance of the design. It is not meant to be an exact rendition.


DRAWN BY: Lori Di Saverio, B.I.D.
CARTIER KITCHENS OTTAWA
DCR #41 SM 5 - Yarmouth (511)



Designed: 5/8/2011
Printed: 6/4/2011

All

Drawing #: 1

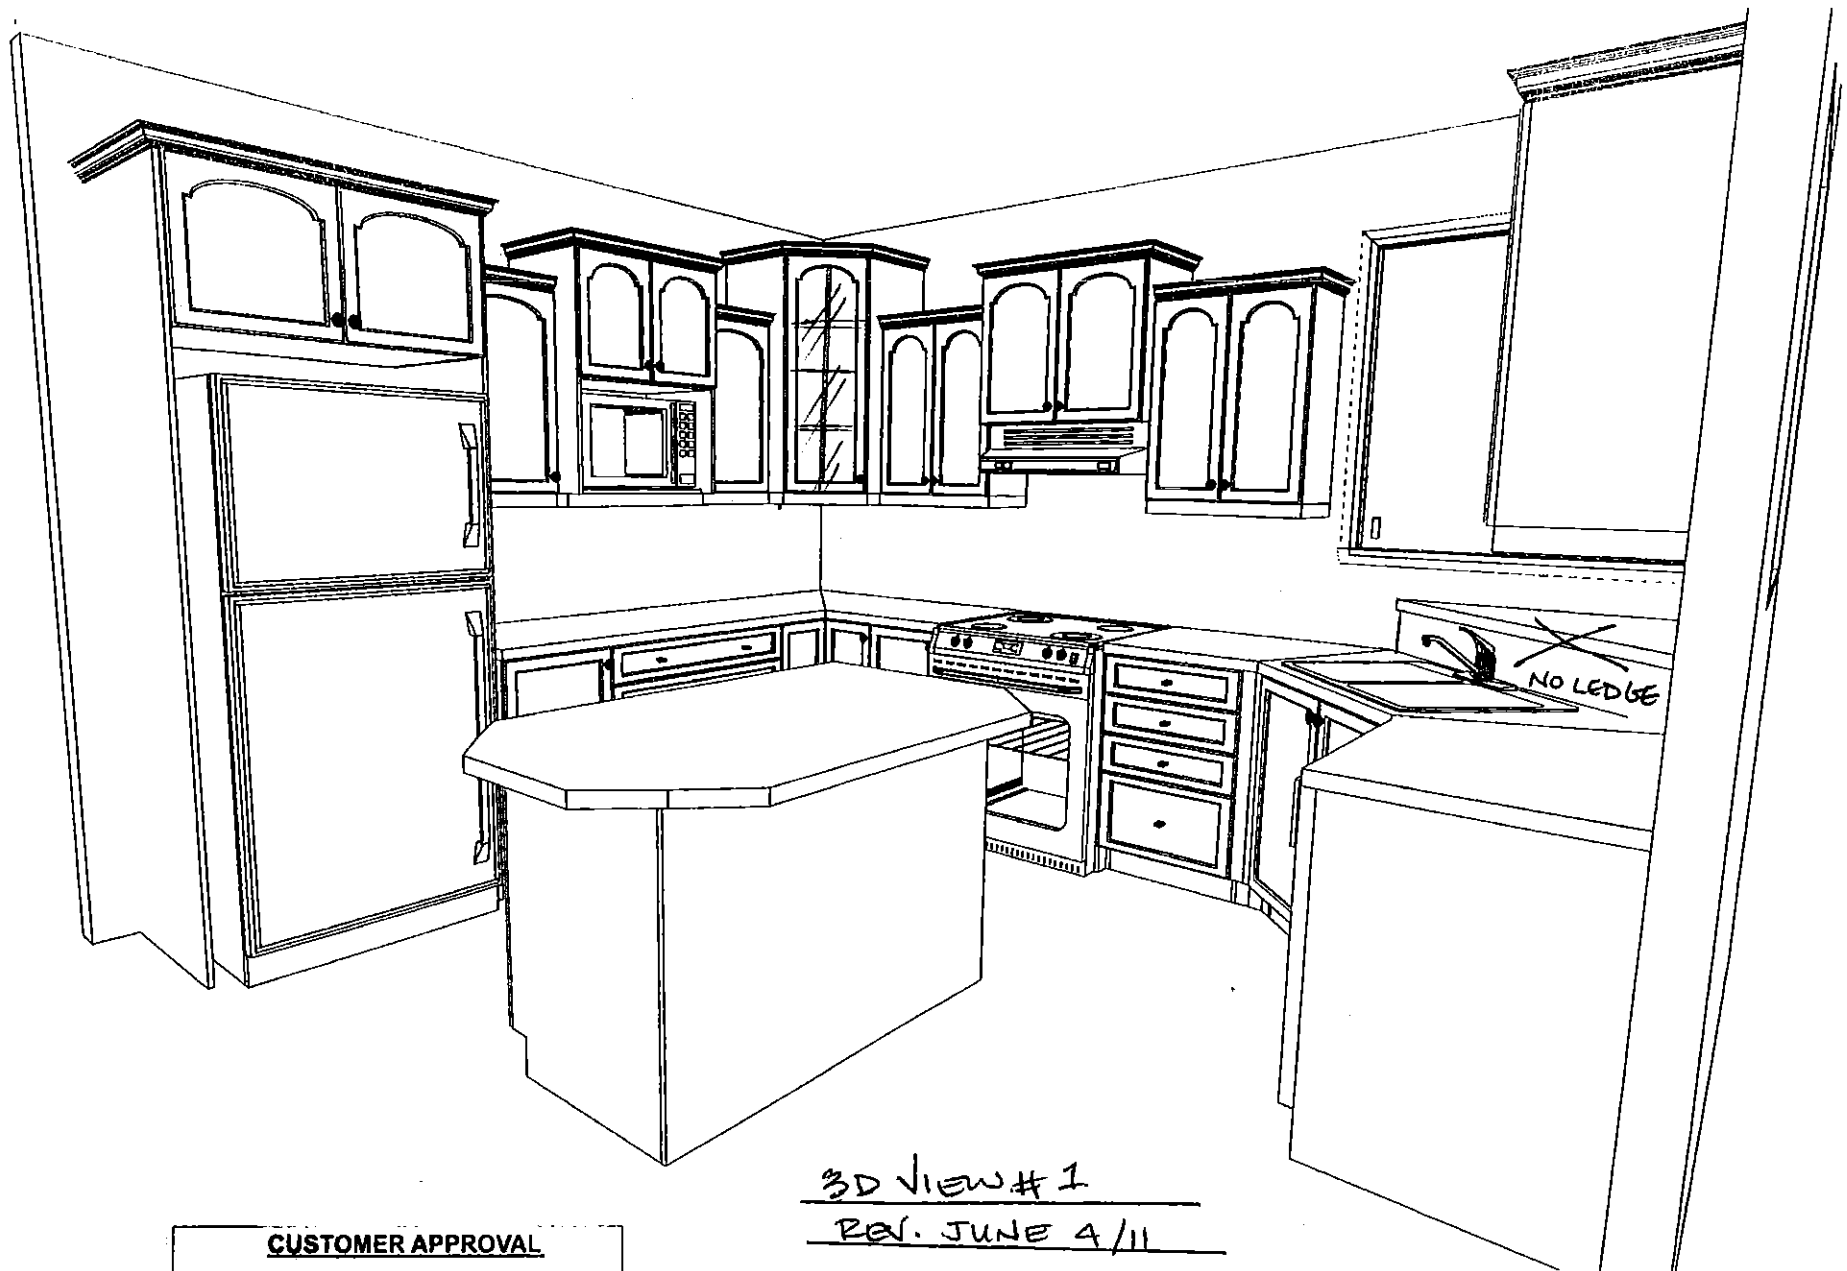

CUSTOMER APPROVAL

I have reviewed these drawings and understand the details of the layout and the Cartier Kitchens specifications.

Signature LD 8/11

Date July 26/11

3D View #1

REV. JUNE 4/11

Note: This drawing is an artistic interpretation of the general appearance of the design. It is not meant to be an exact rendition.

DRAWN BY: Lori Di Saverio, B.I.D.
CARTIER KITCHENS OTTAWA
DCR #41 SM 5 - Yarmouth (511)




20
YEARS
OF
EXCELLENCE

Designed: 5/8/2011
Printed: 6/4/2011

All

Drawing #: 1

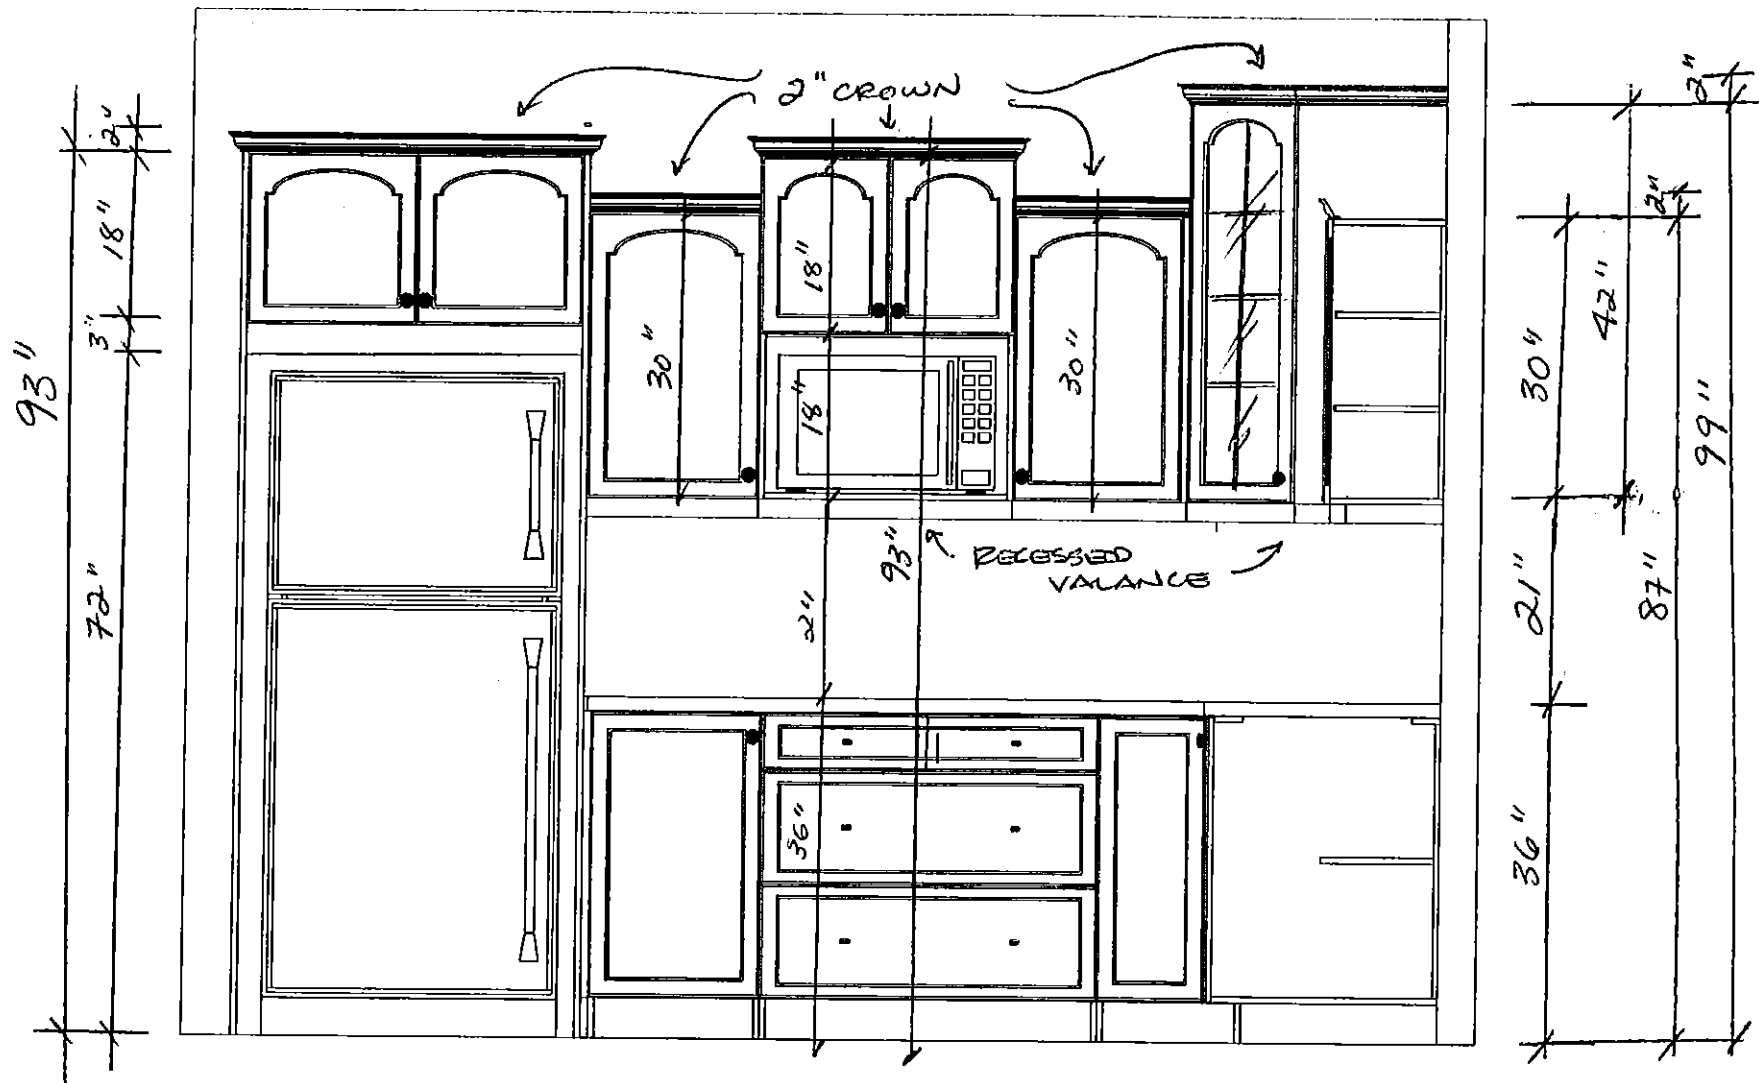

FRIDGE WALL ELEVATION ~ REV. JUNE 4/11

CUSTOMER APPROVAL

I have reviewed these drawings and understand the details of the layout and the Cartier Kitchens specifications.

Signature (X) SW JO

Date July 26/11

Note: This drawing is an artistic interpretation of the general appearance of the design. It is not meant to be an exact rendition.

DRAWN BY: Lori Di Saverio, B.I.D.
CARTIER KITCHENS OTTAWA
DCR #41 SM 5 - Yarmouth (511)




20
© 2011 Cartier Kitchens

Designed: 5/8/2011
Printed: 6/4/2011

All

Drawing #: 1

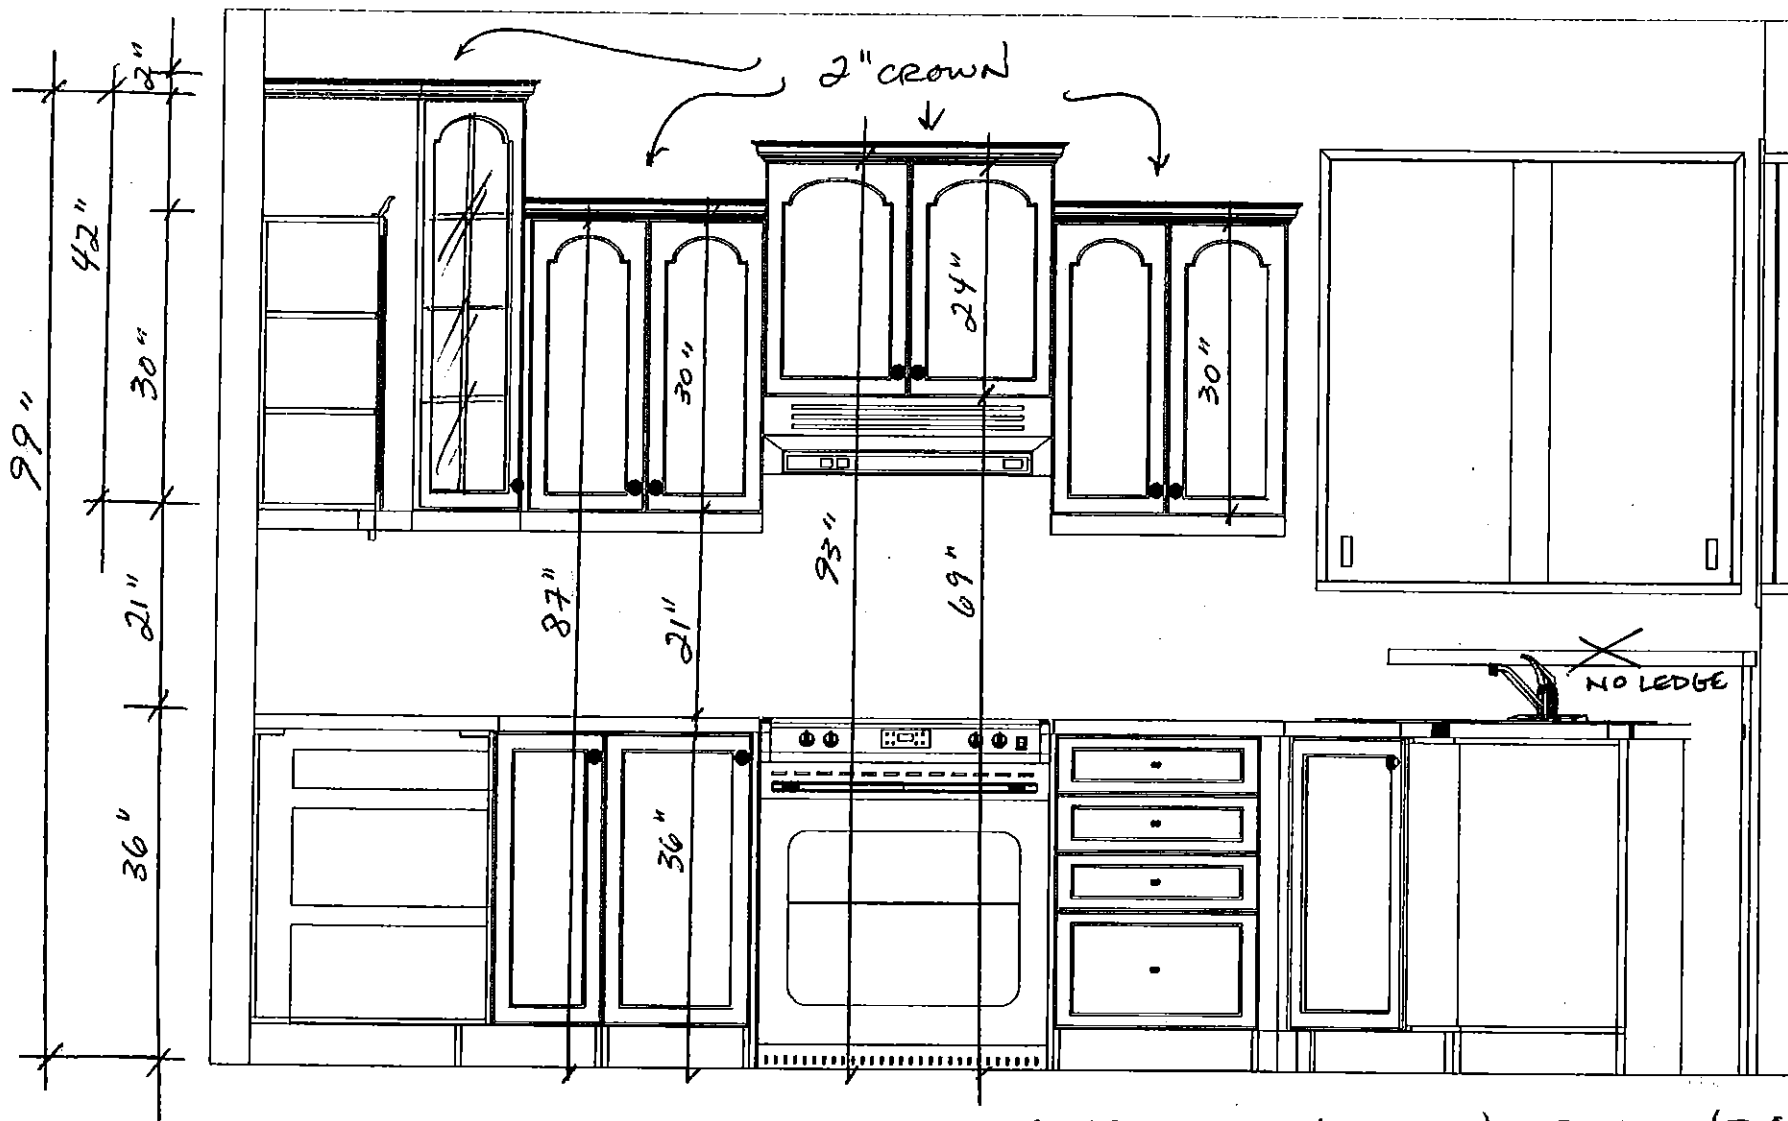

CUSTOMER APPROVAL

I have reviewed these drawings and understand the details of the layout and the Cartier Kitchens specifications.

Signature


Date

[Signature]

July 26/11

Note: This drawing is an artistic interpretation of the general appearance of the design. It is not meant to be an exact rendition.


DRAWN BY: Lori Di Saverio, B.I.D.
CARTIER KITCHENS OTTAWA
DCR #41 SM 5 - Yarmouth (511)

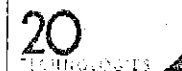

Designed: 5/8/2011
Printed: 6/4/2011

All

Drawing #: 1

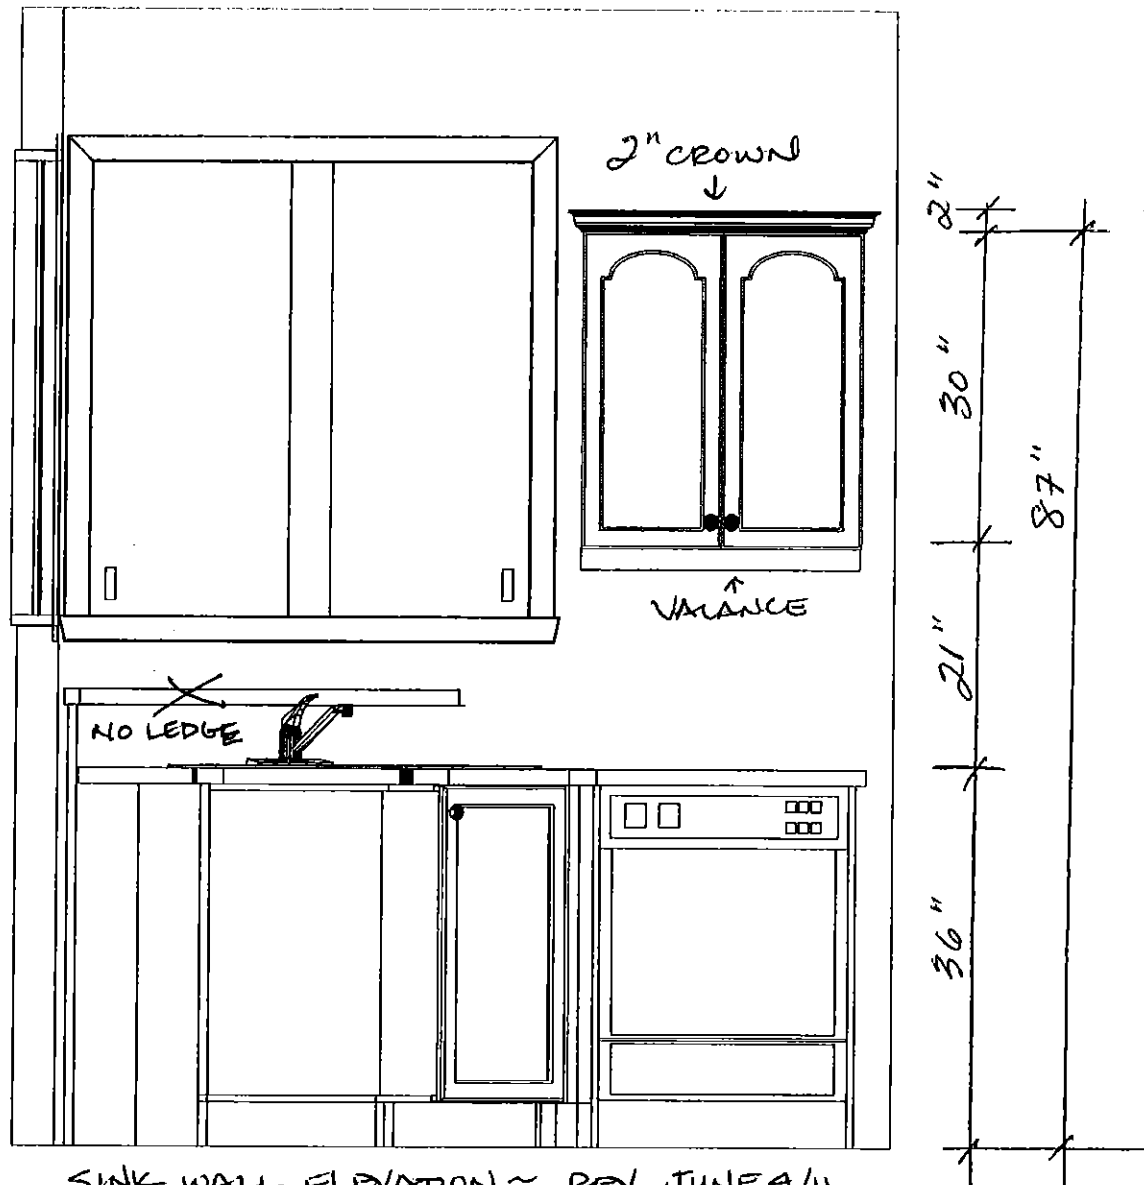

SINK WALL ELEVATION ~ REV. JUNE 4/11

CUSTOMER APPROVAL

I have reviewed these drawings and understand the details of the layout and the Cartier Kitchens specifications.

Signature

[Signature] J.O.

Date

July 26/11

Note: This drawing is an artistic interpretation of the general appearance of the design. It is not meant to be an exact rendition.

DRAWN BY: Lori Di Saverio, B.I.D.
CARTIER KITCHENS OTTAWA
DCR #41 SM 5 - Yarmouth (511)



20

Years ago

Designed: 5/8/2011
Printed: 6/4/2011


All

Drawing #: 1

LOT 41 SMS
LIVING RM. CEILING FAN.


ceiling fans | ventilateurs plafonniers

85

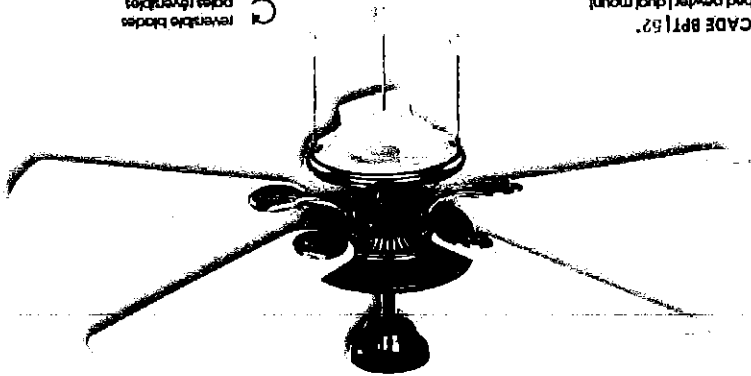


KINCADE BPT152
oil rubbed bronze | dual mount
complete with adaptor glass light kit
bushes | 2 x 60W A
luminaire & globe adaptable
includes | 2 x 60W A
ampoules

- ☒ reversible blades
- ☒ poles réversibles
- ☒ brushed oak
- ☐ white
- ☐ chêne clair

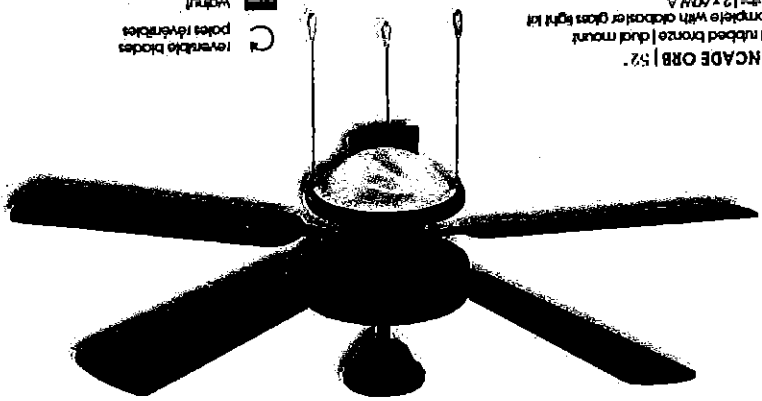


KINCADE ORB152
oil rubbed bronze | dual mount
complete with adaptor glass light kit
bushes | 2 x 60W A
luminaire & globe adaptable
includes | 2 x 60W A
ampoules

- ☒ reversible blades
- ☒ poles réversibles
- ☒ walnut
- ☒ medium oak
- ☒ chêne moyen

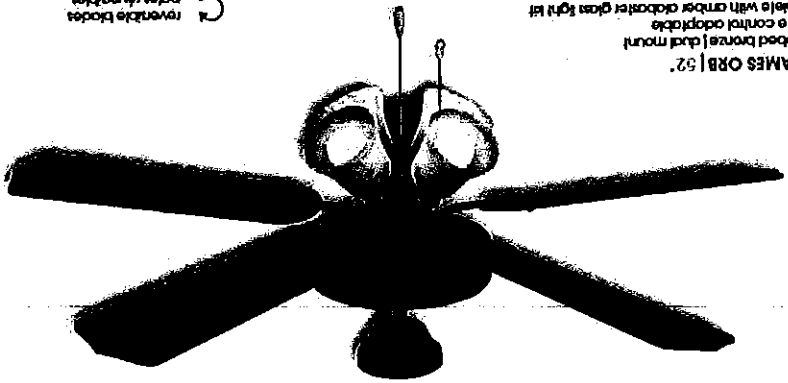

ST. JAMES ORB152
oil rubbed bronze | dual mount
complete with adaptor glass light kit
bushes | 4 x 40W C type
remote control adaptable
complete with adaptor glass light kit
luminaire & globe adaptable
includes | 4 x 40W type C
ampoules



- ☒ reversible blades
- ☒ poles réversibles
- ☒ walnut
- ☒ noyer
- ☒ medium oak
- ☒ chêne moyen

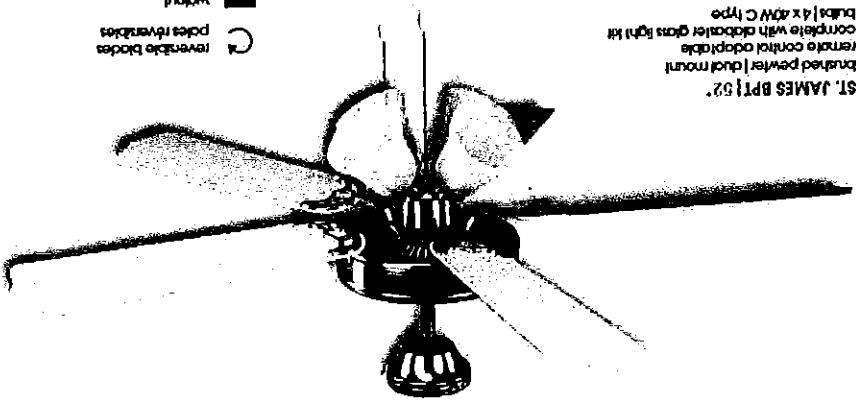

ST. JAMES BPT152
brushed pewter | dual mount
remote control adaptable
complete with adaptor glass light kit
bushes | 4 x 40W C type
luminaire & globe adaptable
includes | 4 x 40W type C
ampoules

- ☒ reversible blades
- ☒ poles réversibles
- ☒ walnut
- ☒ noyer
- ☒ white
- ☒ blanc


Family Package #1

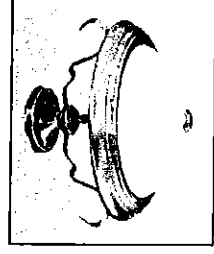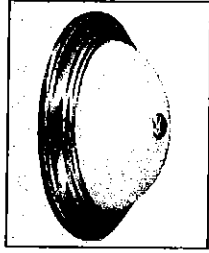

Location	Kitchen, Family rm, Laundry, Bed, Den, Bath
CP Item #:	AS013-05
Description:	Flush Mount - Brushed Nickel with Marbled Glass
Category:	Ceiling (Flush/Flush)
Finish:	Brushed Nickel
Diameter:	13-1/8"
Height:	5"
Lamp Quantity:	2
Lamp Type:	A19, Med. Base
Lamp Wattage:	60W
Price:	



Location	Dinette
CP Item #:	PEND100-11
Description:	Pendant - Brushed Nickel with Marbled Glass
Category:	Pendant (Standard Light)
Finish:	Brushed Nickel
Family:	Dinette
Diameter:	16"
Height:	25"
Lamp Quantity:	1
Lamp Type:	A19, Med. Base
Lamp Wattage:	60W
Price:	


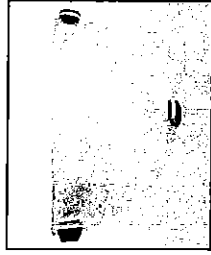


Location	Wall
CP Item #:	WS12-11
Description:	Wall Sconce - Brushed Nickel with Marbled Glass
Category:	Wall Sconce
Finish:	Brushed Nickel
Family:	Wall
Width:	12"
Height:	6.25"
Extension:	3.75"
Lamp Quantity:	1
Lamp Type:	A19, Med. Base
Lamp Wattage:	60W
Price:	



Location	Bedroom Vanity
CP Item #:	A16014-5
Description:	Four Light Vanity - Chrome with Marbled Glass
Category:	Vanity Light
Finish:	Chrome
Family:	Dinette
Width:	36"
Height:	6.75"
Extension:	6.5"
Lamp Quantity:	4
Lamp Type:	A19
Lamp Wattage:	60W
Price:	

Family Package #1

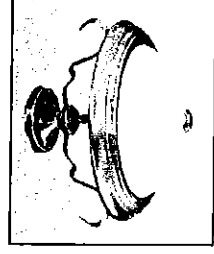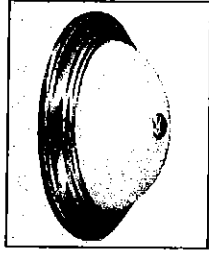

Location	Entry, Hall, Bedroom
CP Item #:	AS013-11
Description:	Semi-Flush Mount - Brushed Nickel with Marbled Glass
Category:	Semi-Flush Mount
Finish:	Brushed Nickel
Width:	15-1/8"
Height:	11"
Lamp Quantity:	2
Lamp Type:	A19, Med. Base
Lamp Wattage:	100W
Price:	



Location	Stair, High Entry, Dining
CP Item #:	CHAND100-11
Description:	Chandelier - Brushed Nickel with Marbled Glass
Category:	Chandelier
Finish:	Brushed Nickel
Family:	Dinette
Diameter:	15.5"
Height:	21"
Lamp Quantity:	3
Lamp Type:	A19, Med. Base
Lamp Wattage:	60W
Price:	



Location	Bedroom Vanity
CP Item #:	A16012-5
Description:	Two Light Vanity - Chrome with marble glass
Category:	Vanity Light
Finish:	Chrome
Family:	Dinette
Width:	14"
Height:	6.75"
Extension:	6.5"
Lamp Quantity:	2
Lamp Type:	A19
Lamp Wattage:	60W
Price:	



Location	Bedroom Vanity
CP Item #:	A16013-5
Description:	Three Light Vanity - Chrome with Marbled Glass
Category:	Vanity Light
Finish:	Chrome
Family:	Dinette
Width:	24"
Height:	6.75"
Extension:	6.5"
Lamp Quantity:	3
Lamp Type:	A19
Lamp Wattage:	60W
Price:	

LOT 41 SNIS
VANITY
LIGHT FIXTURES
THROUGHOUT.