

—SUBMISSION □ MODEL CHANGE

Grading around the foundation should be 0.15m min. below top of foundation grade.

井

Timothy Jones

Grading & Drainage
APPROVED
Development Review - City Of Ottawa

Signed: _____
Service Location

Proposed Grade

Existing Grade

Driveway & Slope Direction

Grade Percentage

Major Storm Flow Direction

Property Line

0
1
2
3
4

Catch Basin

Utility Drop

PROPOSED ROGERS CABLE PEDESTAL

EXISTING ROGERS CABLE PEDESTAL

PROPOSED TRANSFORME

EXISTING TRANSFORMER

PROPOSED BELL PEDESTAL

EXISTING BELL PEDESTAL

PROPOSED STREETLIGHT C/W
BRACKET AND NUMBER

PROPOSED STREETLIGHT DISCONNECT

SANITARY, STORM AND WATER

SERVICE LOCATIONS

PROPOSED INSULATION

ELEVATIONS SHOWN HEREON ARE FOR SITE GRADING
PLAN SUBMISSION.

DCR/PHOENIX HOMES

Plan # 4M-

Lot # 4 STRANDHERD MEADOWS5

Block #	Unit #
1	1
2	2
3	3
100	100

Conc. #	Conc. #
1	1

Civic Address: 308 BAMBURGH WAY

Bldg. Ht. _____ m

Lot coverage 33.5%

Scale 1:250

EVALUATIONS

Step footings N/A

Underside footing

SEE ABOVE

CHECKED / APPROVED BY: T.L.MAK ENG.
AUG. 2011
REV1 AUG29-11

F/F= 99.21
T/F(F)= 98.91
USF(F)= 96.06
T/F(R)= 96.44
USF(R)= 95.92
LOT COV. 33.51%

LOT 4 SITE/GRADING PLAN
STRANDHERD MEADOWS PH5
(9 FT POUR FDN)

PLEASE NOTE: THIS APPLICATION EXPIRES 6(SIX) MONTHS
AFTER DATE RECEIVED

Application No:

OFFICE USE ONLY: Civic Address:

[illegible]

Works Division Approval	Zoning Approval Date:	UPO Approval Date:
-------------------------	-----------------------	--------------------

308 Bamburgh
PA11-01333

CITY OF-VILLE DE
OTTAWA

☐ NEW SUBMISSION ☐ RE-SUBMISSION ☐ MODEL CHANGE ☐ MODEL CHANGE PERMIT #

LEGEND

Finish Floor
Top Of Foundation
Underside Of Footing
U.S.F.
M.U.S.F.
Drainage/Swale Direction
Terracing 3H to 1V (max.)
Service Location

Proposed Grade

Existing Grade



Driveway & Slope Direction

Grade Percentage

Major Storm Flow Direction

Property Line

Catch Basin
Utility Drop Locations
PROPOSED ROGERS CABLE PEDESTAL
EXISTING ROGERS CABLE PEDESTAL
PROPOSED TRANSFORMER
EXISTING TRANSFORMER
PROPOSED BELL PEDESTAL
EXISTING BELL PEDESTAL
PROPOSED STREETLIGHT C/W
BRACKET AND NUMBER
PROPOSED STREETLIGHT DISCONNECT
SANITARY, STORM AND WATER
SERVICE LOCATIONS
PROPOSED INSULATION

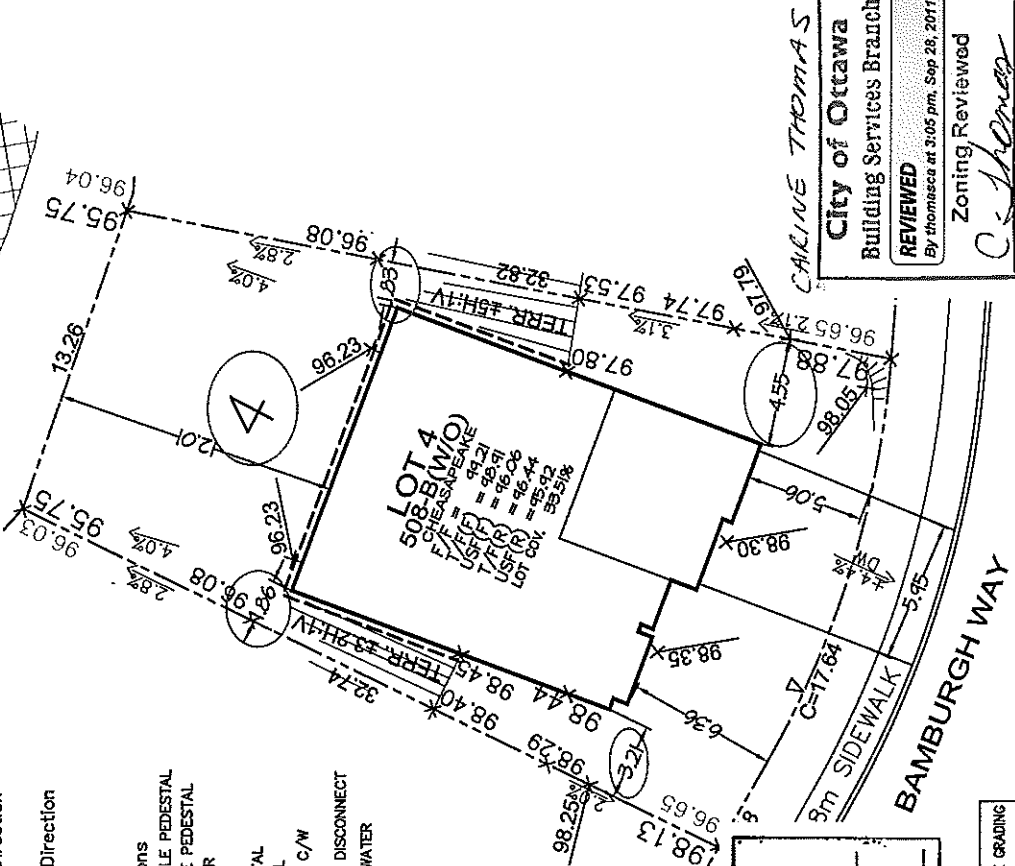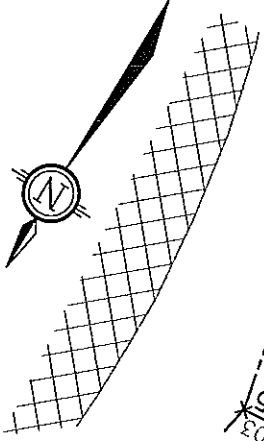

City of Ottawa
Building Services Branch
REVIEWED
By: [Signature]
Building Code Reviewed
Signature

CARLINE THOMAS
City of Ottawa
Building Services Branch
REVIEWED
By: [Signature]
Zoning Reviewed
Signature

ELEVATIONS SHOWN HEREON ARE FOR SITE GRADING
PLAN SUBMISSION.

Owner/Applicant

DCR/PHOENIX HOMES

Telephone # 723-9227

Plan # 4M-

Lot # 4 STRANDHERD MEADOWS

Block # Unit #

Conc. #

Civic Address: 308 BAMBURGH WAY

Bldg. Ht. m

Lot coverage 33.51 %

Scale 1:250

ELEVATIONS

Step footings N/A m

Underside footing SEE ABOVE m

Top of foundation SEE ABOVE m

CHECKED/APPROVED BY: T.L.M.A.K. ENG.

AUG. 2011

REV:1 AUG29-11

LOT SITE/GRADING PLAN
4 STRANDHERD MEADOWS PH5
(9 FT POUR FDN)

F/F= 44.21
T/F(F)= 48.91
USF(F)= 46.06
T/F(R)= 46.44
USF(R)= 45.42
LOT COV. 33.51%

PLEASE NOTE: THIS APPLICATION EXPIRES 6(SIX) MONTHS
AFTER DATE RECEIVED

Application No: _____

OFFICE USE ONLY: Civic Address: _____

Circ Date	Circ Date	Circ Date	APPLICATION RECEIVED
Works Division Approval	Zoning Approval	UP0 Approval	
Date:	Date:	Date:	