

DCR PHOENIX HOMES

STRANDHERD MEADOWS 5

C10 - ROSEMERE

LOT #78

OPTION 2 KITCHEN
NOV 24-11

CUSTOMER APPROVAL


I have reviewed these drawings and understand the details of the layout and the Cartier Kitchens specifications.

Signature [Signature]

Date Nov. 24/2012

CABINET LINE - LINE 2 ? / LINE 3 ? - TBC
DOOR STYLE - TBC
SPECIES - MAPLE
COLOUR - OLIVE ? / WILD APPLE ? - TBC
HARDWARE - HU 120
KICK: 3-PCS.
STANDARD WHITE INTERIOR
METAL DRAWER BOX
1 - PC. 90 DEG. CORNER MOULD.
2 - PCS. T-MOULD
1 - PC. 135 DEG. CORNER MOULD.
2 - PCS FILLER - 6" x 96"

KITCHEN - MOUNTING HT: 96"

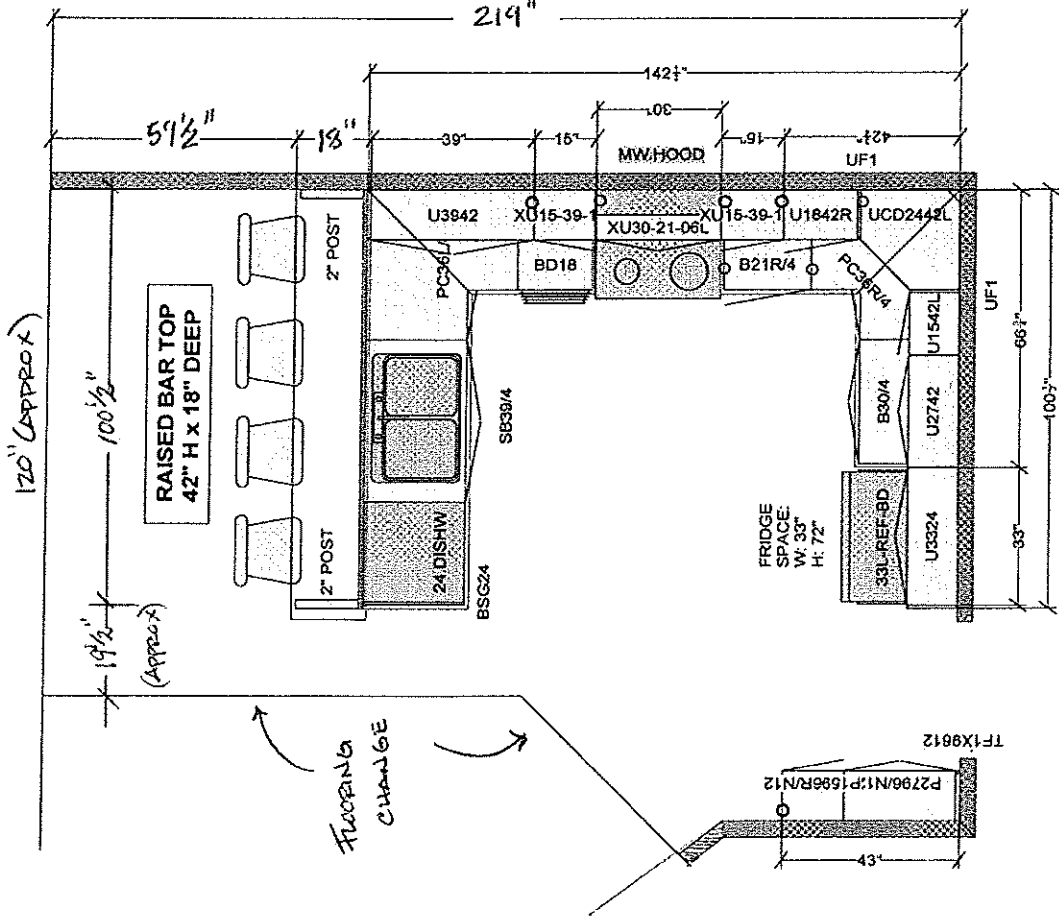

All dimensions, size designations given are subject to verification on job site and adjustment to fit job conditions.

CARTIER KITCHENS OTTAWA

DCR #78 SMS - Kitchen 2



2020
TECHNOLOGIES

DRAWN BY: LD
CARTIER KITCHENS OTTAWA

All

Drawing #: 1 | No Scale.

Designed: 11/22/2011
Printed: 11/24/2011



OPTION 2 KITCHEN - 3D VIEW #1

CUSTOMER APPROVAL

I have reviewed these drawings and understand the details of the layout and the Cartier Kitchens specifications.

Signature [Signature]
Date Jan. 24/12

Note: This drawing is an artistic interpretation of the general appearance of the design. It is not meant to be an exact rendition.




Designed: 11/22/2011
Printed: 11/24/2011

DESIGNED BY: LORI DISAVERIO,
DCR #78 SM5 - Kitchen 2

All

Drawing #: 1

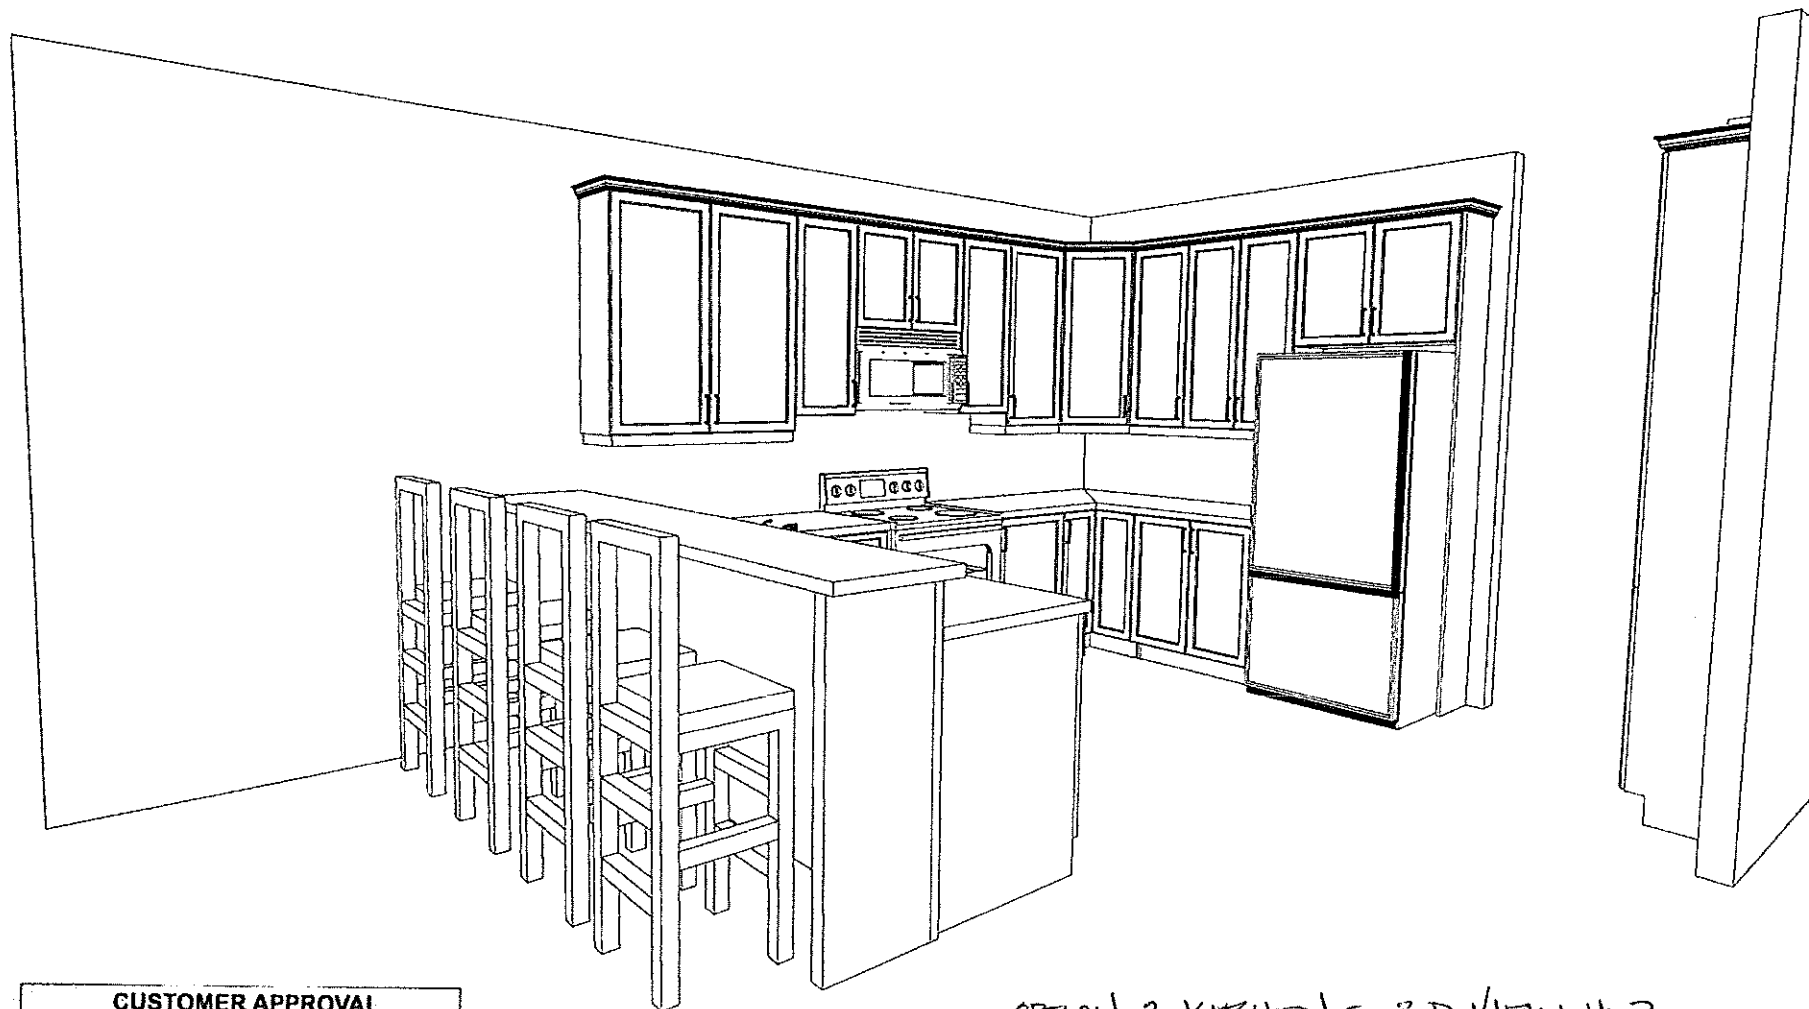

OPTION 2 KITCHEN - 3D VIEW # 2

CUSTOMER APPROVAL

I have reviewed these drawings and understand the details of the layout and the Cartier Kitchens specifications.

Signature *[Signature]*
Date Jan. 24 / 12

Note: This drawing is an artistic interpretation of the general appearance of the design. It is not meant to be an exact rendition.



Designed: 11/22/2011
Printed: 11/24/2011



DESIGNED BY: LORI DISAVERIO,
DCR #78 SM5 - Kitchen 2

All

Drawing #: 1



OPTION 2 KITCHEN - 3D VIEW #3

CUSTOMER APPROVAL

I have reviewed these drawings and understand the details of the layout and the Cartier Kitchens specifications.

Signature *Lori Disaverio*
Date Jan. 24/12

Note: This drawing is an artistic interpretation of the general appearance of the design. It is not meant to be an exact rendition.



Designed: 11/22/2011
Printed: 11/24/2011

DESIGNED BY: LORI DISAVERIO.
DCR #78 SM5 - Kitchen 2

All

Drawing #: 1